LLCHD HS000674

Application to Alter, Extend or Repair an Onsite Wastewater Treatment System

OCT 15 2012

HS000674

☐ Municipal Code 24.38 ☐ County Resolution Number 02-30

The undersigned hereby applies for a permit to: ☑ **ALTER** ☐ **EXTEND** ☐ **REPAIR** an existing wastewater treatment system, complying with appropriate Ordinance or Resolution, as marked above with drawings attached.

1. **Legal description of property:**
   Township 12 Range 5 1/4 _____ 1/4 NW Section 8
   Block _____ Lot 9 Addition _____
   Parcel ID 06 - 08 - 100 - 003 - 000 (i.e. 99-99-999-999-999)
   Street Address (no rural route) 12275 W. Little Salt rd. Valparaiso, NE 68065

2. **Property use:** ☑ residential ☐ commercial ☐ other use
   Number of bedrooms 3 Describe _____

3. **Type of Present Individual Disposal System** ☐ septic system ☑ lagoon ☐ other

4. **Description of proposed alteration, extension or repair** build new lagoon using 1 side of old lagoon

5. **Work to be done by:** ☐ owner ☑ contractor's name Lloyd Jakubec, Wayland Contracting.

6. **Estimated project:** a. Repair, replace, or minor extension with a cost less than $400 (no fee required).
   b. Total cost is greater than $400 (Return fee with this application)
   c. A permit is required if the use, operation, location, or type of system is changed

Print Name Jim Mitchell Address 12275 W Little Salt Rd Phone: 402-430-9761
Applicant Signature (owner or lessee) Kevin Jakubec for Jim Mitchell

Please contact LLCHD for the permit fee for this application
Fee must be included before the application will be processed. Incomplete information will delay processing

HEALTH DEPARTMENT USE ONLY

Date received 10/22/12 REVIEW: ☑ Approved ☐ Disapproved By: _____

Site visits
Date 10/17/12 By CD
Date ____/____/____ By _____
Date ____/____/____ By _____

Installation final written approval
Date ____/____/____ By _____

Return application to:
Lincoln-Lancaster County Health Department
Environmental Public Health Division
3140 "N" Street, Lincoln, NE 68510
Phone: 441-8643

Business Office Use Only

Received: Date: 10/22/12 Amount $190.00 Check No. 7987 Initials BH

Revised 3-09

10-23-2012 10:41:17

LLCHD HS000674

OCT 22 2012

D

Permit Number:

Lincoln-Lancaster County Health Department
Environmental Public Health Division
3140 "N" Street • Lincoln, NE 68510-1514
Phone: 402-441-8022

Onsite Wastewater Treatment System

As Built Plans & Specifications

Date 10-17-12 Legal Description NW 1/4 1/4 58-T12-R5 Lot 9 Section Township Range

Onsite System Location

Address (no rural route) 12275 W Little Salt City Valparaiso NE, Zip 68065

Owner Jim Mitchell Address same

A. Sewer Pipe

1. Material: SDR 26
   Diameter: 4 in.
2. Distance above basement floor: 12 in.
   or distance below basement floor: _____ in.
3. Distance between dwelling and septic tank: 100+ ft.
4. Number of clean-outs: 2-
5. Distances to: well or suction line 100 ft.
   stream 100 ft.
   pressure line 100 ft.
   property line 100 ft.

B. Septic Tank

☐ Label with Manufacturer, address and gallon capacity

1. Material: _____
   Number of compartments: _____
2. Capacity: _____ gal.
3. Factory built: ☐ Yes ☐ No
4. Manholes: Over inlet, diameter _____ in.
   Over outlet, diameter _____ in.
   Riser: ☐ above ☐ below grade _____ in.
5. Inlet: ☐ baffle ☐ tee ☐ 6" dia. inspection pipe
6. Outlet: ☐ baffle ☐ tee ☐ 6" dia. inspection pipe
7. Depth to top of tank, below unfinished grade: _____ in.
8. Distances to: Well or suction line _____ ft.
   Stream _____ ft.
   Pressure line _____ ft.
   Property line _____ ft.

C. ☐ Distribution Box ☐ Drop Boxes

(≥ 12" inspection opening) (removable lid to inspect)

1. Material: _____
   Number available outlets: _____
2. Factory built: ☐ Yes ☐ No
3. Distance from septic tank: _____ ft.

D. Drainfield Absorption


☐ Trench ☐ Bed ☐ Level Bottom


1. Type: ☐ Half rounds ☐ Perforated pipe ☐ Chambers
   Diameter or width: _____
   Number of distribution lines in bed _____
   Material: ☐ fiberglass ☐ plastic ☐ concrete
   ☐ other _____
2. Drainfield Laterals: Number _____
   Length of each line: _____ ft. _____ ft.
   _____ ft. _____ ft., _____ ft.
3. Drainfield dimensions: Width _____ ft.
   Distribution Pipe Slope _____ in/100 ft.
   Average depth _____ in
4. Filter material: _____
   Depth of material _____ in.
5. Distances to: Well or suction line _____ ft.
   Pressure line _____ ft.
   Property line _____ ft.
   House or building _____ ft.
   Lake or Stream _____ ft.

Complete As-Built drawing on the back fo this form.

Onsite Wastewater System Design (Example)

Indicate North with Arrow

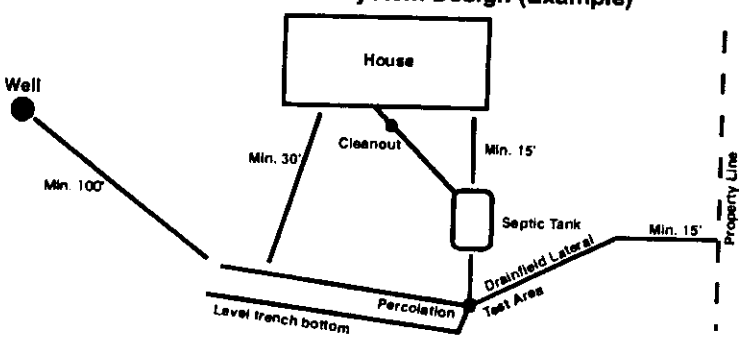

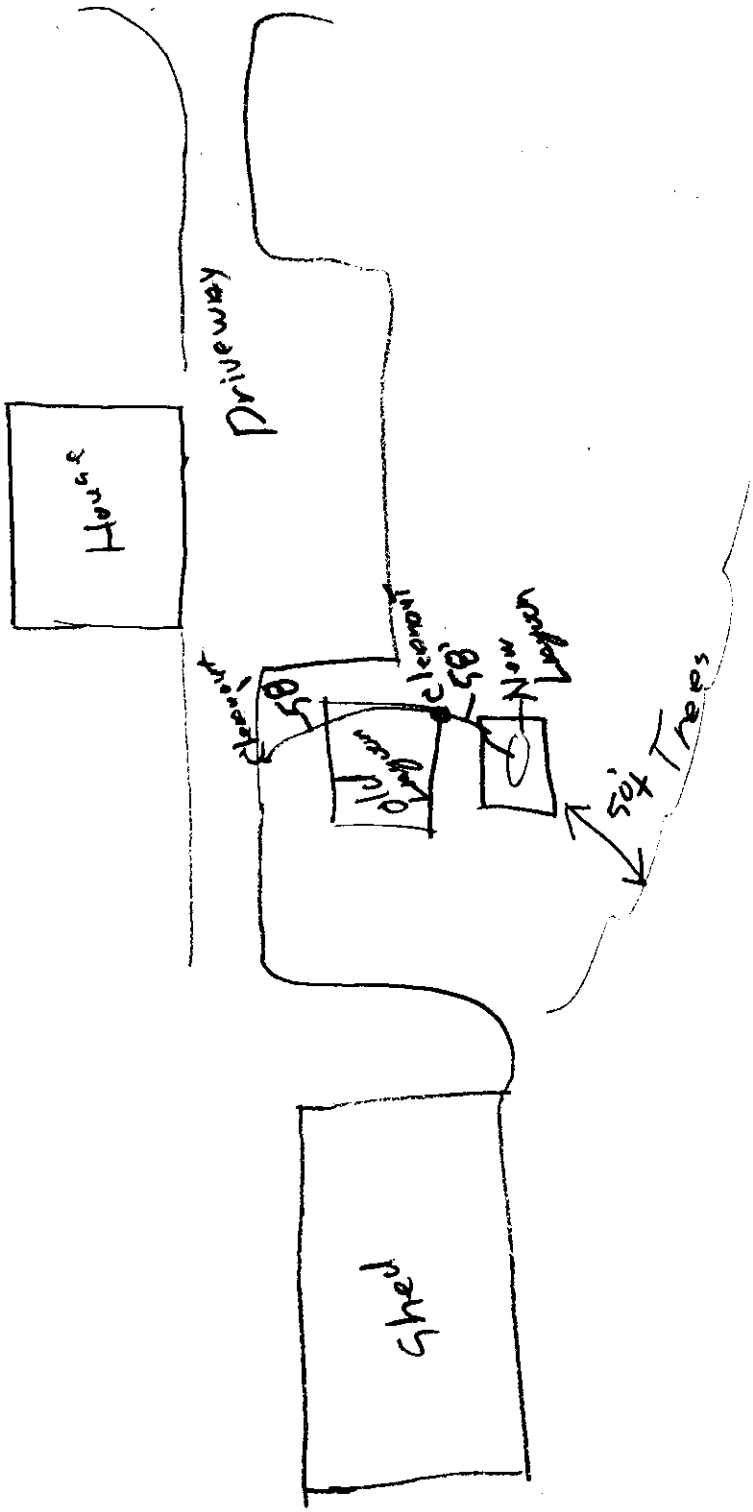

Raymond Contracting, Inc.
Lloyd J Jakoubek
13800 NW 70th St
Raymond, NE 68428
402-783-2663

Lincoln-Lancaster County Health Department
Environmental Public Health Division (402) 441-8027
3140 N Street Lincoln, NE 68510-1514

ON-SITE WASTE WATER SYSTEM
REPAIR PERMIT

No. HS000674

System Type:	LAGOON
Situs:	12275 W LITTLE SALT RD
Legal Description:	T12N-R05E-S08-Lot 9
Owner:	MITCHELL, JAMES H & DENISE A R 12275 W LITTLE SALT RD VALPARAISO NE 68065

Permit Fee:	$190.00
Total Fees:	$190.00
Issued:	10/22/2012
Expires	10/22/2013

Judith A Halstead

Judith A. Halstead, MS, Health Director


Dear Applicant:

The above document is your permit to repair an existing On-site Waste Water System at the location listed. Please contact this office once repairs are complete to obtain final approval before use.

Judith A Halstead

Judith A. Halstead, MS
Health Director

LLOYD JAKOUBEK

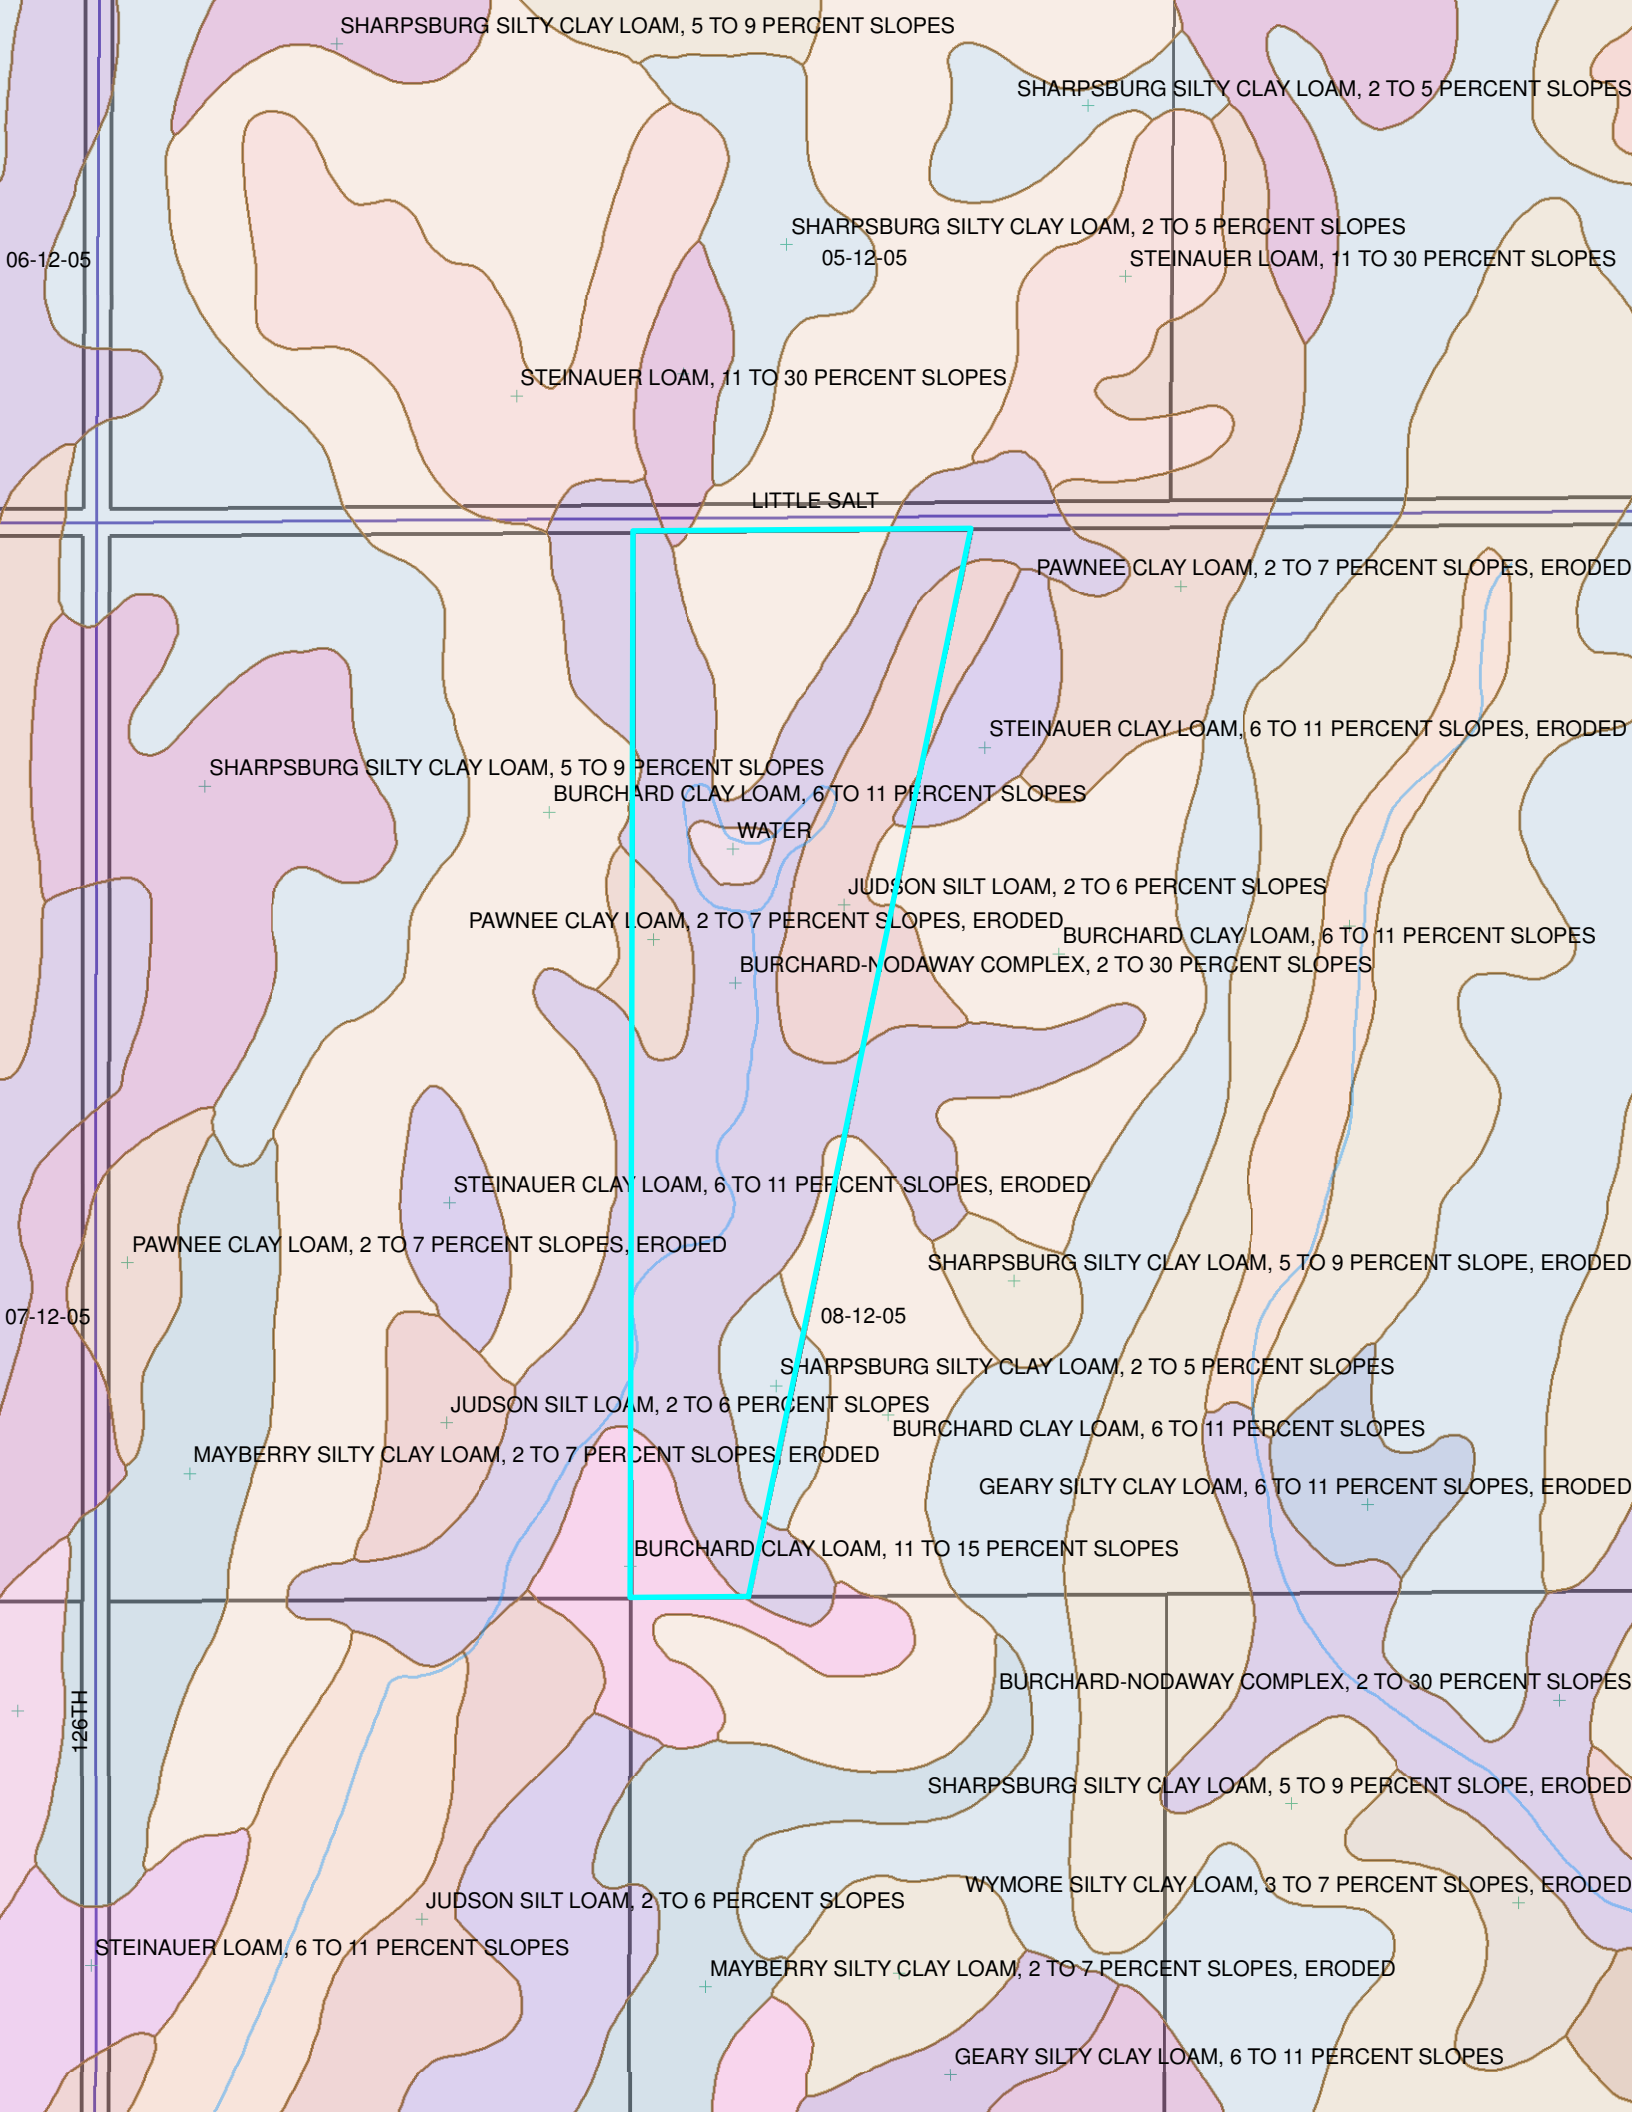
SHARPSBURG SILTY CLAY LOAM, 5 TO 9 PERCENT SLOPES
SHARPSBURG SILTY CLAY LOAM, 2 TO 5 PERCENT SLOPES
SHARPSBURG SILTY CLAY LOAM, 2 TO 5 PERCENT SLOPES
06-12-05
05-12-05
STEINAUER LOAM, 11 TO 30 PERCENT SLOPES
STEINAUER LOAM, 11 TO 30 PERCENT SLOPES
LITTLE SALT
PAWNEE CLAY LOAM, 2 TO 7 PERCENT SLOPES, ERODED
STEINAUER CLAY LOAM, 6 TO 11 PERCENT SLOPES, ERODED
SHARPSBURG SILTY CLAY LOAM, 5 TO 9 PERCENT SLOPES
BURCHARD CLAY LOAM, 6 TO 11 PERCENT SLOPES
WATER
JUDSON SILT LOAM, 2 TO 6 PERCENT SLOPES
PAWNEE CLAY LOAM, 2 TO 7 PERCENT SLOPES, ERODED
BURCHARD CLAY LOAM, 6 TO 11 PERCENT SLOPES
BURCHARD-NODAWAY COMPLEX, 2 TO 30 PERCENT SLOPES
STEINAUER CLAY LOAM, 6 TO 11 PERCENT SLOPES, ERODED
PAWNEE CLAY LOAM, 2 TO 7 PERCENT SLOPES, ERODED
SHARPSBURG SILTY CLAY LOAM, 5 TO 9 PERCENT SLOPE, ERODED
07-12-05
08-12-05
SHARPSBURG SILTY CLAY LOAM, 2 TO 5 PERCENT SLOPES
JUDSON SILT LOAM, 2 TO 6 PERCENT SLOPES
BURCHARD CLAY LOAM, 6 TO 11 PERCENT SLOPES
MAYBERRY SILTY CLAY LOAM, 2 TO 7 PERCENT SLOPES, ERODED
GEARY SILTY CLAY LOAM, 6 TO 11 PERCENT SLOPES, ERODED
BURCHARD CLAY LOAM, 11 TO 15 PERCENT SLOPES
BURCHARD-NODAWAY COMPLEX, 2 TO 30 PERCENT SLOPES
126TH
SHARPSBURG SILTY CLAY LOAM, 5 TO 9 PERCENT SLOPE, ERODED
WYMORE SILTY CLAY LOAM, 3 TO 7 PERCENT SLOPES, ERODED
JUDSON SILT LOAM, 2 TO 6 PERCENT SLOPES
STEINAUER LOAM, 6 TO 11 PERCENT SLOPES
MAYBERRY SILTY CLAY LOAM, 2 TO 7 PERCENT SLOPES, ERODED
GEARY SILTY CLAY LOAM, 6 TO 11 PERCENT SLOPES

Application to Alter, Extend or Repair an Onsite Wastewater Treatment System

OCT 15 2012

HS000674

☐ Municipal Code 24.38 ☐ County Resolution Number 02-30

SCANNED

The undersigned hereby applies for a permit to: ☒ **ALTER** ☐ **EXTEND** ☐ **REPAIR** an existing wastewater treatment system, complying with appropriate Ordinance or Resolution, as marked above with drawings attached.

1. **Legal description of property:**
   Township 12 Range 5 1/4 _____ 1/4 NW Section 8
   Block _____ Lot 9 Addition _____
   Parcel ID 06 - 08 - 100 - 003 - 000 (i.e. 99-99-999-999-999)
   Street Address (no rural route) 12275 W. Little Salt Rd. Valparaiso, NE 68065

2. **Property use:** ☒ residential ☐ commercial ☐ other use
   Number of bedrooms 3 Describe _____

3. **Type of Present Individual Disposal System** ☐ septic system ☒ lagoon ☐ other

4. **Description of proposed alteration, extension or repair** build new lagoon using 1 side of old lagoon

5. **Work to be done by:** ☐ owner ☒ contractor's name Lloyd Jakubek, Kay Land Contracting.

6. **Estimated project:**
   a. Repair, replace, or minor extension with a cost less than $400 (no fee required).
   b. Total cost is greater than $400 (Return fee with this application)
   c. A permit is required if the use, operation, location, or type of system is changed

Print Name Jim Mitchell Address 12275 W Little Salt Rd Phone: 402-784-2022 402-430-9261

Applicant Signature (owner or lessee) Kim Jakubek for Jim Mitchell

Please contact LLCHD for the permit fee for this application
Fee must be included before the application will be processed. Incomplete information will delay processing

---

HEALTH DEPARTMENT USE ONLY

Date received 10/22/12 REVIEW: ☑ Approved ☐ Disapproved By: _____

Site visits
Date 10/17/12 By CD
Date ____/____/____ By _____
Date ____/____/____ By _____

Installation final written approval
Date 7/8/13 By _____

Return application to:
Lincoln-Lancaster County Health Department
Environmental Public Health Division
3140 "N" Street, Lincoln, NE 68510
Phone: 441-8643

Business Office Use Only

Received: Date: 10/22/12 Amount $190.00 Check No. 7987 Initials BH

Revised 3-09

Lincoln-Lancaster County Health Department
Environmental Public Health Division
3140 "N" Street • Lincoln, NE 68510-1514
Phone: 402-441-8022

OCT 22 2012

D

Permit Number:

Onsite Wastewater Treatment System

As Built Plans & Specifications

Date 10-17-12 Legal Description NW 1/4 NW 1/4 Section 58 Township T12 Range R5 Lot 9

Onsite System Location

Address (no rural route) 12275 W Little Salt City Walpariso NE, Zip 68005

Owner Jim Mitchell Address same

A. Sewer Pipe

1. Material: SDR 26
   Diameter: 4 in.
2. Distance above basement floor: 12 in.
   or distance below basement floor: _____ in.
3. Distance between dwelling and septic tank: 100+ ft.
4. Number of clean-outs: 2-
5. Distances to: well or suction line 100 ft.
   stream 100 ft.
   pressure line 100 ft.
   property line 100 ft.

B. Septic Tank

☐ Label with Manufacturer, address and gallon capacity

1. Material: _____
   Number of compartments: _____
2. Capacity: _____ gal.
3. Factory built: ☐ Yes ☐ No
4. Manholes: Over inlet, diameter _____ in.
   Over outlet, diameter _____ in.
   Riser: ☐ above ☐ below grade _____ in.
5. Inlet: ☐ baffle ☐ tee ☐ 6" dia. inspection pipe
6. Outlet: ☐ baffle ☐ tee ☐ 6" dia. inspection pipe
7. Depth to top of tank, below unfinished grade: _____ in.
8. Distances to: Well or suction line _____ ft.
   Stream _____ ft.
   Pressure line _____ ft.
   Property line _____ ft.

C. ☐ Distribution Box ☐ Drop Boxes

(≥ 12" inspection opening) (removable lid to inspect)

1. Material: _____
   Number available outlets: _____
2. Factory built: ☐ Yes ☐ No
3. Distance from septic tank: _____ ft.

D. Drainfield Absorption


☐ Trench ☐ Bed ☐ Level Bottom


1. Type: ☐ Half rounds ☐ Perforated pipe ☐ Chambers
   Diameter or width: _____
   Number of distribution lines in bed _____
   Material: ☐ fiberglass ☐ plastic ☐ concrete
   ☐ other _____
2. Drainfield Laterals: Number _____
   Length of each line: _____ ft. _____ ft.
   _____ ft. _____ ft., _____ ft.
3. Drainfield dimensions: Width _____ ft.
   Distribution Pipe Slope _____ in/100 ft.
   Average depth _____ in
4. Filter material: _____
   Depth of material _____ in.
5. Distances to: Well or suction line _____ ft.
   Pressure line _____ ft.
   Property line _____ ft.
   House or building _____ ft.
   Lake or Stream _____ ft.

Complete As-Built drawing on the back fo this form.

Onsite Wastewater System Design (Example)

Indicate North with Arrow

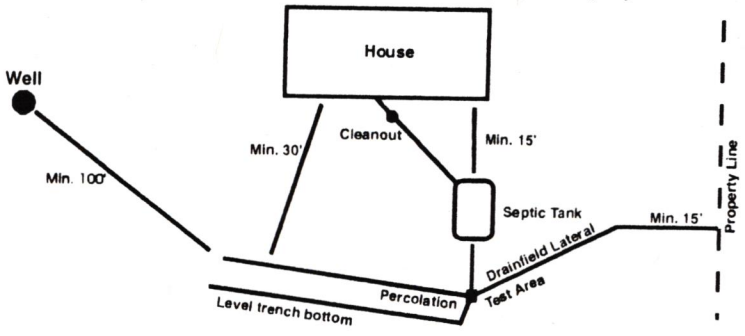

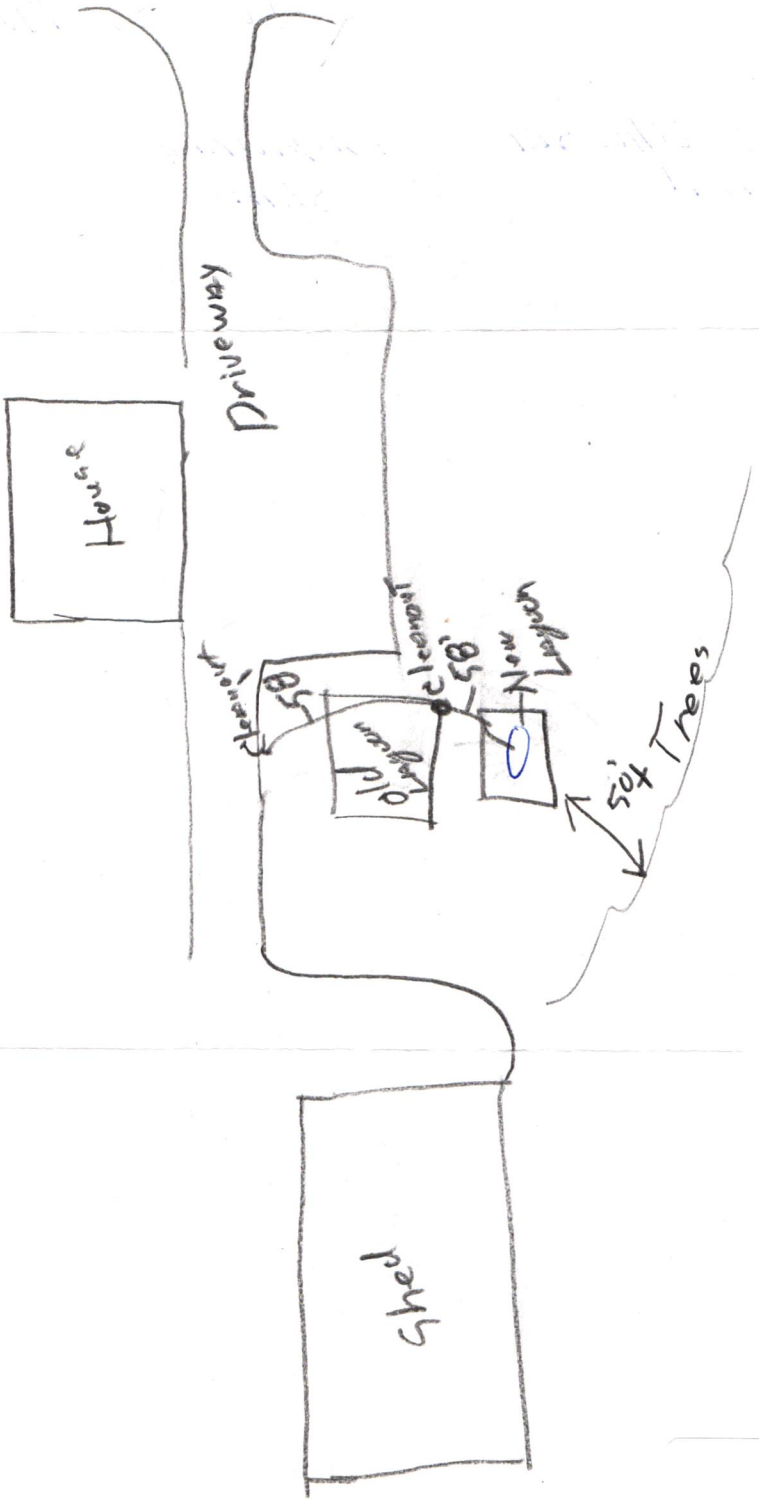

Raymond Contracting, Inc.
Lloyd J Jakoubek
13800 NW 70th St
Raymond, NE 68428
402-783-2663