Lincoln-Lancaster County Health Department
Environmental Public Health Division
3140 N Street • Lincoln NE 68510-1514
Phone: 402-441-8643

JAN 23 2013

A

Permit Number
HS000716

Onsite Wastewater Treatment System
Request for Site Clearance and Permit

Include Form B and C. Submit correct fee with this Application

3 acres or more required for: ❑ Septic System ❑ Lagoon ❑ Other (Refer to Form C)

The undersigned hereby requests site clearance and permit to construct a Wastewater Treatment System in conformance with appropriate regulations.

PLEASE PRINT OR TYPE

A. Onsite System Location

Address 4800 Stagecoach Road (no rural route) City Hickman, NE Zip 68372

Legal Description _____

1/4 1/4 Section Township Range Subdivison Addition Block Lot

Geographical Location (if known): Lat/Long: 40°36'40.39"N 96°39'19.75"W PID _____

B. Owner

Name Gale McNeil Signature _____

Address 4800 Stagecoach Road City/State/Zip Hickman NE 68372

Home Phone _____ Work Phone 402 525 7384

C. Certified Installer

Name: Blain Johnson Signature _____

Address 8533 E Hwy 41 City/State/Zip Adams NE 68301

Work Phone 416-2270

D. Engineer

❑ **Check and complete if engineer designed system** P.E. License Number: _____

Designer Name _____ Firm _____ Work Phone _____

E. This system will serve a

☒ Residential Dwelling Number of Bedrooms 3 Is there a Whirlpool Bathtub? ❑ Yes ☒ No Total Acres 3.5

❑ Commercial Establishment/Other Facility Specify _____ Design flow in gallons per day _____

Type of Wastewater ❑ Domestic ❑ Non-Domestic Well Permit Applied for ❑ Yes ❑ No ❑ Not Applicable

DO NOT WRITE BELOW THIS LINE

Approval Process ❑ Municipal Code 24.38 ❑ County Resolution No. 02-30

1. Health Department
Site visits _____
Date rec'd _____
Date frwd _____
ACTION ☒ Approved ❑ Disapproved
Signature _____

2. Supt. Bldg. Insp. or Village Clerk
Comments _____
Date rec'd _____
Date frwd _____
ACTION ❑ Approved ❑ Disapproved
Signature _____

3. City or County Engineer
Comments _____
Date rec'd _____
Date frwd _____
ACTION ❑ Approved ❑ Disapproved
Signature _____

Installation Final Written Approval
By _____

Date _____

Business Office Use Only
Date Received 2-4-13 Amount Paid 195.00
Received By BTTRL Cash/Check No. 6443

White - Health Department Yellow - Engineer Pink - Building & Safety

Form A Updated: 5/10

Lincoln-Lancaster County Health Department
Environmental Public Health Division
3140 "N" Street • Lincoln, NE 68510-1514
Phone: 402-441-8022


C

Permit Number:

Onsite Wastewater Treatment System

Preliminary Plan Specifications

Draw a plot plan showing onsite system sewer lines, drop of distribution boxes, tank, drainfields, percolation test holes, well, residence, direction of groundwater flow, property lines, and reserve area for replacement onsite system.

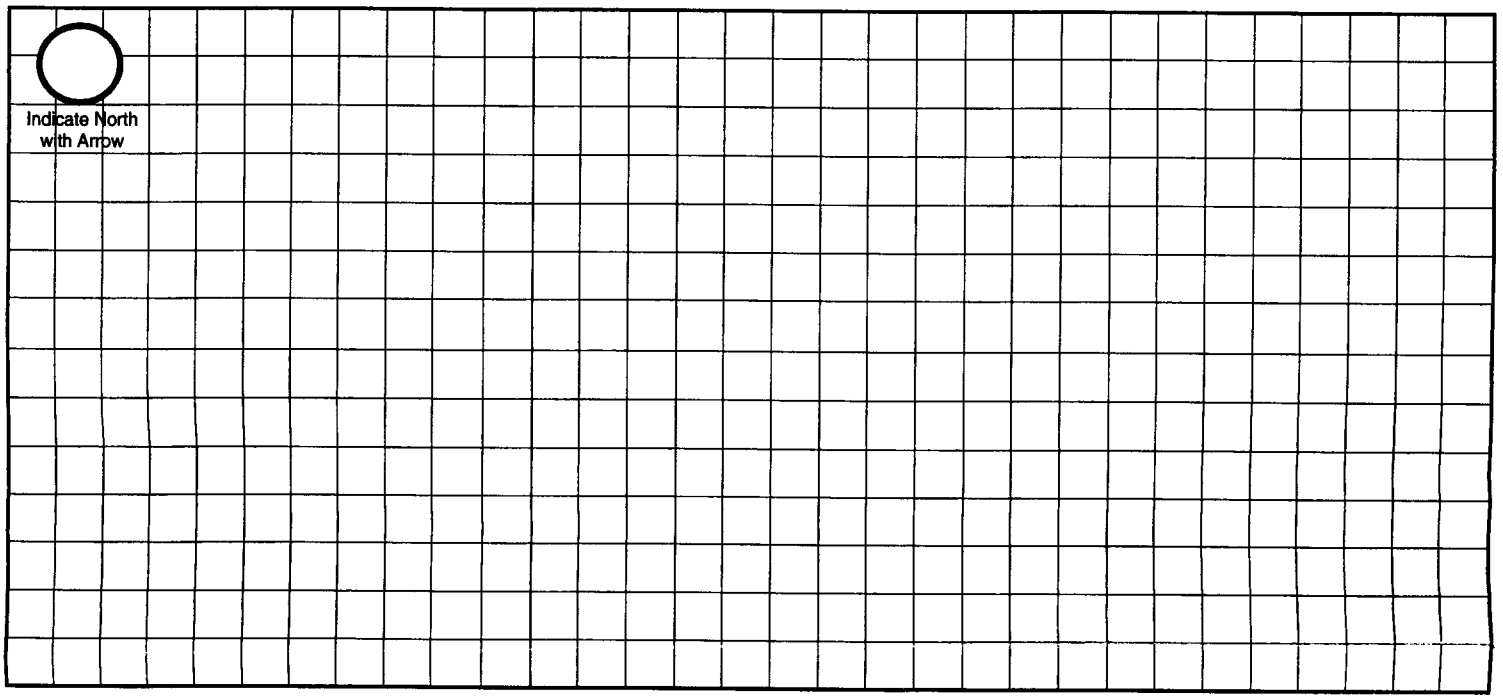

Approximate Scale: _____ft. = _____ **grid line/s**

A. Onsite System Location

Address (no rural route) 4900 Stagecoach Road City Hickman NE, Zip 68372

B. Proposed Septic Tank/s

Septic Tank Cap._____ gals Tank Material: ☐ Concrete ☐ Plastic ☐ Other_____ ☒ Lagoon(Max. seepage 1/8" per day)

C. Reserve Area for Replacement Onsite System

☐ Drainfield Absorption Area (percoloation test required) ☒ Lagoon

D. Drainfield Absorption System

Percolation Rate_____ (min/inch = mpi) No. of Bedrooms_____ Soil Type_____ Land Slope_____%

☐ Trench ☐ Bed ☐ Non-Standard (engineer designed and NDEQ approved Total Square feet of drainfield_____sq.ft.

Total length of laterals_____ Type of distribution: ☐ Perforated pipe ☐ Half-Round ☐ Chamber ☐ Other

No. of absorption trenches_____ Width_____ No. of drop boxes_____ Distrubtion Box_____

No. of absorption beds_____ Width_____ No of Distribution lines per bed_____

E. Setbacks Check the Boxes Below if the Required Setback has been Satisfied

Distance From	Private Well	Public Well	Surface Water	Gound Water	Pressure Water Lines	Property Lines	Foundations Yours	Foundations Neighbors	All Other Setbacks
Tank (ft)	50 ☐	500 ☐	50 ☐	NA ☐	25 ☐	20 ☐	15 ☐	25 ☐	☐
Field (ft)	100 ☐	500 ☐	50 ☐	4 ☐	30 ☐	20 ☐	30 ☐	40 ☐	☐
Lagoon (ft)	100 ☑	500 ☐	50 ☐	N/A ☐	30 ☑	50 ☑	100 ☑	200 ☐	☑

F. Required Signatures

Home Building Contractor_____ Date_____

Installer Blain Jonnson Date 1-22-2013

Lincoln-Lancaster County Health Department
Environmental Public Health Division
3140 "N" Street • Lincoln, NE 68510-1514
Phone: 402-441-8022

D

Permit Number:

Onsite Wastewater Treatment System

As Built Plans & Specifications

Date 1-22-2013 Legal Description _____ 1/4 1/4 Section Township Range

Onsite System Location

Address (no rural route) 4900 Stagecoach Road City Hickman NE, Zip 68372

Owner Gale McNeil Address 4900 Stagecoach Road

A. Sewer Pipe

1. Material: SDR26
   Diameter: 4" in.
2. Distance above basement floor: _____ in.
   or distance below basement floor: _____ in.
3. Distance between dwelling and septic tank: _____ ft.
4. Number of clean-outs: 4
5. Distances to: well or suction line 100'+ ft.
   stream _____ ft.
   pressure line _____ ft.
   property line 100'+ ft.

B. Septic Tank

☐ Label with Manufacturer, address and gallon capacity

1. Material: _____
   Number of compartments: _____
2. Capacity: _____ gal.
3. Factory built: ☐ Yes ☐ No
4. Manholes: Over inlet, diameter _____ in.
   Over outlet, diameter _____ in.
   Riser: ☐ above ☐ below grade _____ in.
5. Inlet: ☐ baffle ☐ tee ☐ 6" dia. inspection pipe
6. Outlet: ☐ baffle ☐ tee ☐ 6" dia. inspection pipe
7. Depth to top of tank, below unfinished grade: _____ in.
8. Distances to: Well or suction line _____ ft.
   Stream _____ ft.
   Pressure line _____ ft.
   Property line _____ ft.

C. ☐ Distribution Box ☐ Drop Boxes

(≥ 12" inspection opening) (removable lid to inspect)

1. Material: _____
   Number available outlets: _____
2. Factory built: ☐ Yes ☐ No
3. Distance from septic tank: _____ ft.

D. Drainfield Absorption


☐ Trench ☐ Bed ☐ Level Bottom

1. Type: ☐ Half rounds ☐ Perforated pipe _ ☐ Chambers
   Diameter or width: _____
   Number of distribution lines in bed _____
   Material: ☐ fiberglass ☐ plastic ☐ concrete
   ☐ other _____
2. Drainfield Laterals: Number _____
   Length of each line: _____ ft. _____ ft.
   _____ ft. _____ ft., _____ ft.
3. Drainfield dimensions: Width _____ ft.
   Distribution Pipe Slope _____ in/100 ft.
   Average depth _____ in
4. Filter material: _____
   Depth of material _____ in.
5. Distances to: Well or suction line _____ ft.
   Pressure line _____ ft.
   Property line _____ ft.
   House or building _____ ft.
   Lake or Stream _____ ft.


Complete As-Built drawing on the back fo this form.

Onsite Wastewater System Design (Example)

Indicate North with Arrow

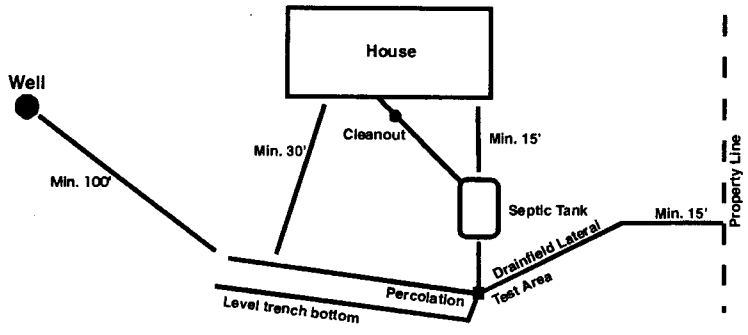

As Built Drawing

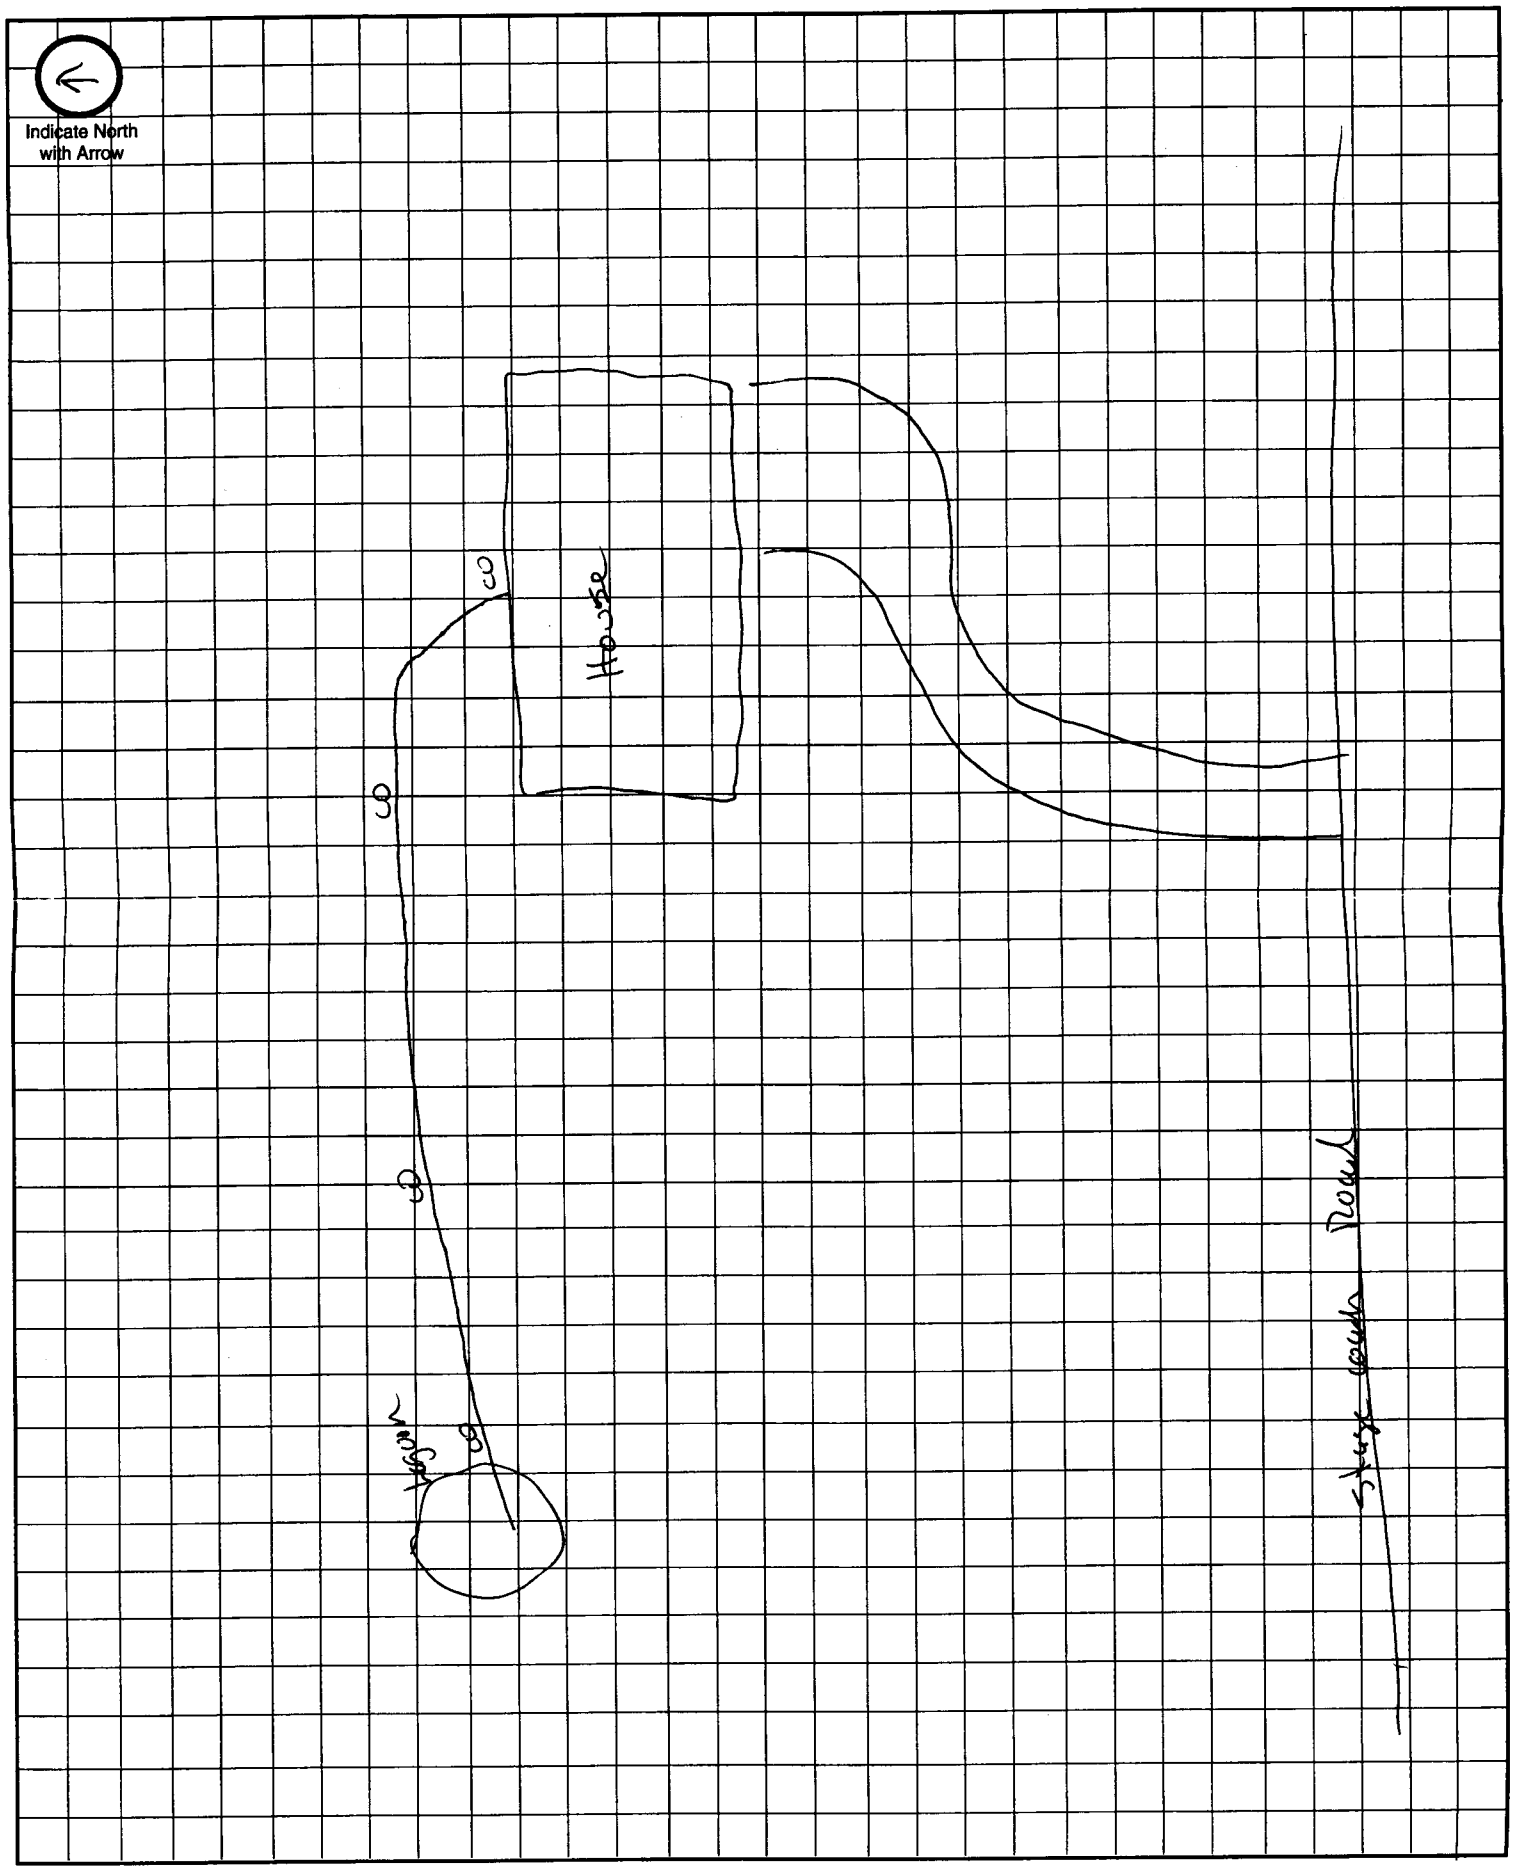

Approximate Scale: _____ft. = _____ grid line/s

Lincoln-Lancaster County Health Department
Environmental Public Health Division (402) 441-8027
3140 N Street Lincoln, Nebraska 68510-1514

ON-SITE WASTE WATER SYSTEM REPAIR PERMIT
No. HS000716

System Type: Lagoon

Situs: 4800 STAGECOACH RD, RURAL, NE

Issued: 2/7/2013

Expires: 2/7/2014

Description: S32, T8, R7, 6th Principal Meridian, LOT 6 SE

Owner: MCNEIL, GALE & CAROL J
4800 STAGECOACH RD
HICKMAN, NE 68372

Judith A Halstead

Judith A. Halstead, MS, Health Director

Dear Applicant:

The above document is your permit to repair an existing On-site Waste Water System at the location listed. Please contact this office once repair is complete to obtain final approval before use.

Judith A Halstead

Judith A. Halstead, MS
Health Director

BLAIN JOHNSON
8533 E HWY 41
ADAMS, NE 68301