Lincoln-Lancaster County Health Department
Environmental Public Health Division (402) 441-8027
3140 N Street Lincoln, Nebraska 68510-1514

ON-SITE WASTE WATER SYSTEM
CONSTRUCTION - INSTALLATION PERMIT
No. HS000719

System Type: Lagoon

Situs:

Issued: 2/20/2013

Expires: 2/20/2014

Description: S32, T8, R8, 6th Principal Meridian, LOT 17 SW

Owner: EBERT, K A
2228 S 57 ST LINCOLN, NE 68506

Judith A Halstead
Judith A. Halstead, MS, Health Director

Dear Applicant:

The above document is your permit to construct a new On-site Waste Water System at the location listed. Please contact this office once the sytem is complete in order to schedule a final inspection before use.

Judith A Halstead

Judith A. Halstead, MS
Health Director

RAYMOND CONTRACTING
13800 NW 70TH
RAYMOND, NE 68428

FEB 05 2013

Lincoln-Lancaster County Health Department
Environmental Public Health Division
3140 N Street • Lincoln NE 68510-1514
Phone: 402-441-8643

A

Permit Number
H5000719

Onsite Wastewater Treatment System
Request for Site Clearance and Permit

Include Form B and C.
Submit correct fee
with this Application

3 acres or more required for: ☐ Septic System ☒ Lagoon ☐ Other (Refer to Form C)

The undersigned hereby requests site clearance and permit to construct a Wastewater Treatment System in conformance with appropriate regulations.

PLEASE PRINT OR TYPE

A. Onsite System Location 19960 S 120th

Address Not yet available (no rural route) City Hickman, NE Zip 68372

Legal Description SW 32 8 8 17
1/4 1/4 Section Township Range Subdivison Addition Block Lot

Geographical Location (if known): Lat/Long: PID 21-32-300-013-000

B. Owner

Name Katie Ebert Signature

Address 2228 S 57th St City/State/Zip Lincoln, NE 68506

Home Phone 402-499-1652 Work Phone

. Certified Installer

Name: Lloyd Jakowlek, Raymond Contracting Signature Kim L. Jakowlek for Lloyd

Address 13760 NW 70th St City/State/Zip Raymond, NE 68428

Work Phone 402-783-2463 or 402-890-6009

D. Engineer ☐ Check and complete if engineer designed system P.E. License Number:

Designer Name Firm Work Phone

E. This system will serve a disposal-Yes

☒ Residential Dwelling Number of Bedrooms 3 Is there a Whirlpool Bathtub? ☒ Yes ☐ No Total Acres 19.38

☐ Commercial Establishment/Other Facility Specify Design flow in gallons per day

Type of Wastewater ☐ Domestic ☐ Non-Domestic Well Permit Applied for ☐ Yes ☐ No ☐ Not Applicable

DO NOT WRITE BELOW THIS LINE

Approval Process ☐ Municipal Code 24.38 ☐ County Resolution No. 02-30

1. Health Department
Site visits line + lagoon 7/22/13 Need fence
Date rec'd 2/11/13
Date frwd 2/11/13
ACTION ☐ Approved ☐ Disapproved
Signature

2. Supt. Bldg. Insp. or Village Clerk
Comments
Date rec'd 2-11-13
Date frwd 2-11-13
ACTION ☒ Approved ☐ Disapproved
Signature

3. City or County Engineer
Comments
Date rec'd 2-11-2013
Date frwd 2-11-2013
ACTION ☒ Approved ☐ Disapproved
Signature

Installation Final Written Approval
by
Date 9/11/13

Business Office Use Only
Date Received 2-15-13 Amount Paid 355.00
Received By BA Cash/Check No 8043

White - Health Department Yellow - Engineer Pink - Building & Safety

Form A Updated: 5/10

Lincoln-Lancaster County Health Department
Environmental Health Division
3140 "N" Street • Lincoln, NE 68510-1514
Phone: 402-441-8022


C

Permit Number:

Sewage Disposal System

Preliminary Plan Specifications

Draw a plot plan showing system location, lines, distribution box, tank and laterals, percolation test hole locations, well, residence, compass direction and property lines. Indicate on drawing if residence and well are existing or proposed.

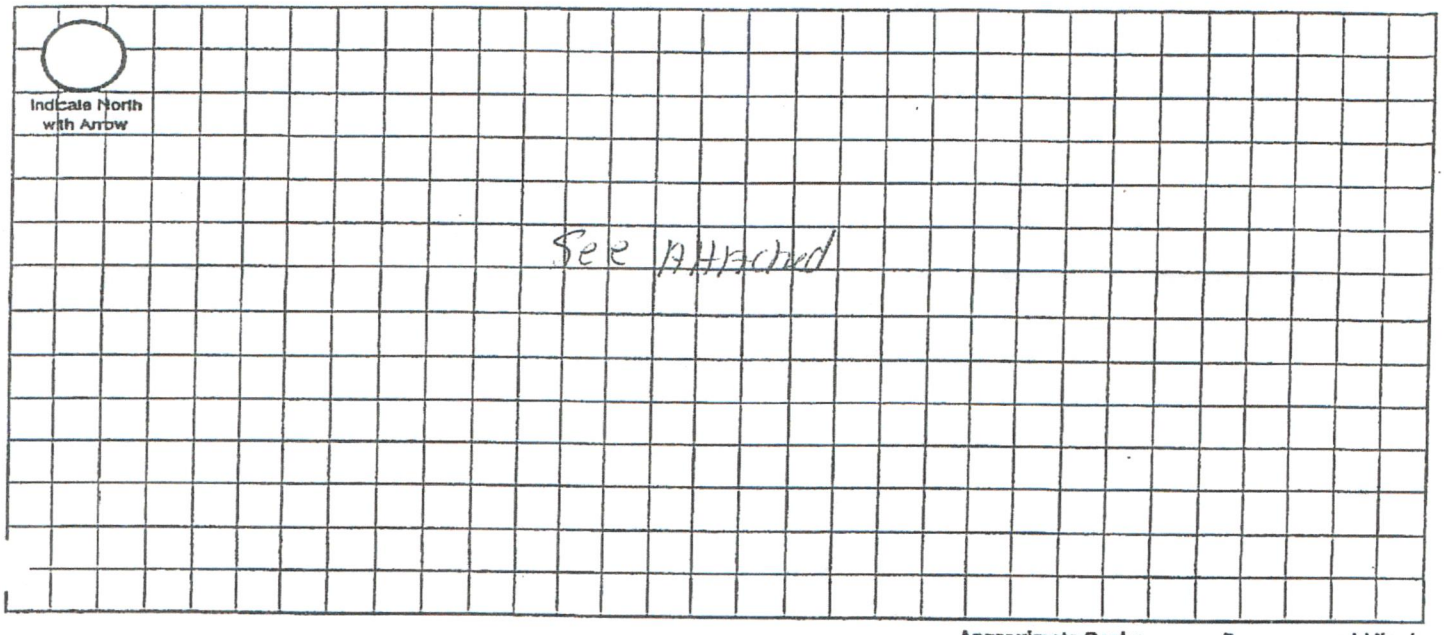

Approximate Scale: _____ ft. = _____ grid line/s

A. System Location (Indicate correct number and street)

Address (no rural route) _____ City _____ NE, Zip _____

B. Proposed Septic Tank/s

Tank Material: ☐ Concrete ☐ Plastic ☐ Other _____

C. Proposed Absorption System (See Form B for Percolation Information)

Percolation Rate _____ (min. per inch) Soil Type: _____ Land Slope: _____ %

Type of Absorption System: ☐ Trench ☐ Bed ☐ Other _____

Total Square Feet of Field Required: _____ sq. ft.

Type of Lateral: ☐ Half-Moon ☐ Perforated Pipe ☐ Other Lateral Material: _____

Capacity of Septic Tank _____ gals Number of Absorption Beds: _____ Number of Distribution Laterals per Bed _____

Total Length of Laterals _____ ft. Number of Trenches _____ Trench Width _____

D. Setbacks Check the Boxes Below if the Required Setback has been Satisfied


Distance From	Private Well	Public Well	Surface Water	Gound Water	Pressure Water Lines	Property Lines	Foundations Yours	Foundations Neighbors	All Other Setbacks
Tank (ft)	50 ☐	500 ☐	50 ☐	NA ☐	25 ☐	20 ☐	15 ☐	25 ☐	☐
Field (ft)	100 ☐	500 ☐	50 ☐	4 ☐	30 ☐	20 ☐	30 ☐	40 ☐	☐
Lagoon (ft)	100 ☒	500 ☒	50 ☒	N/A ☐	30 ☒	50 ☒	100 ☒	200 ☒	☒

E. Required Signatures



FORM 23-102 10-96

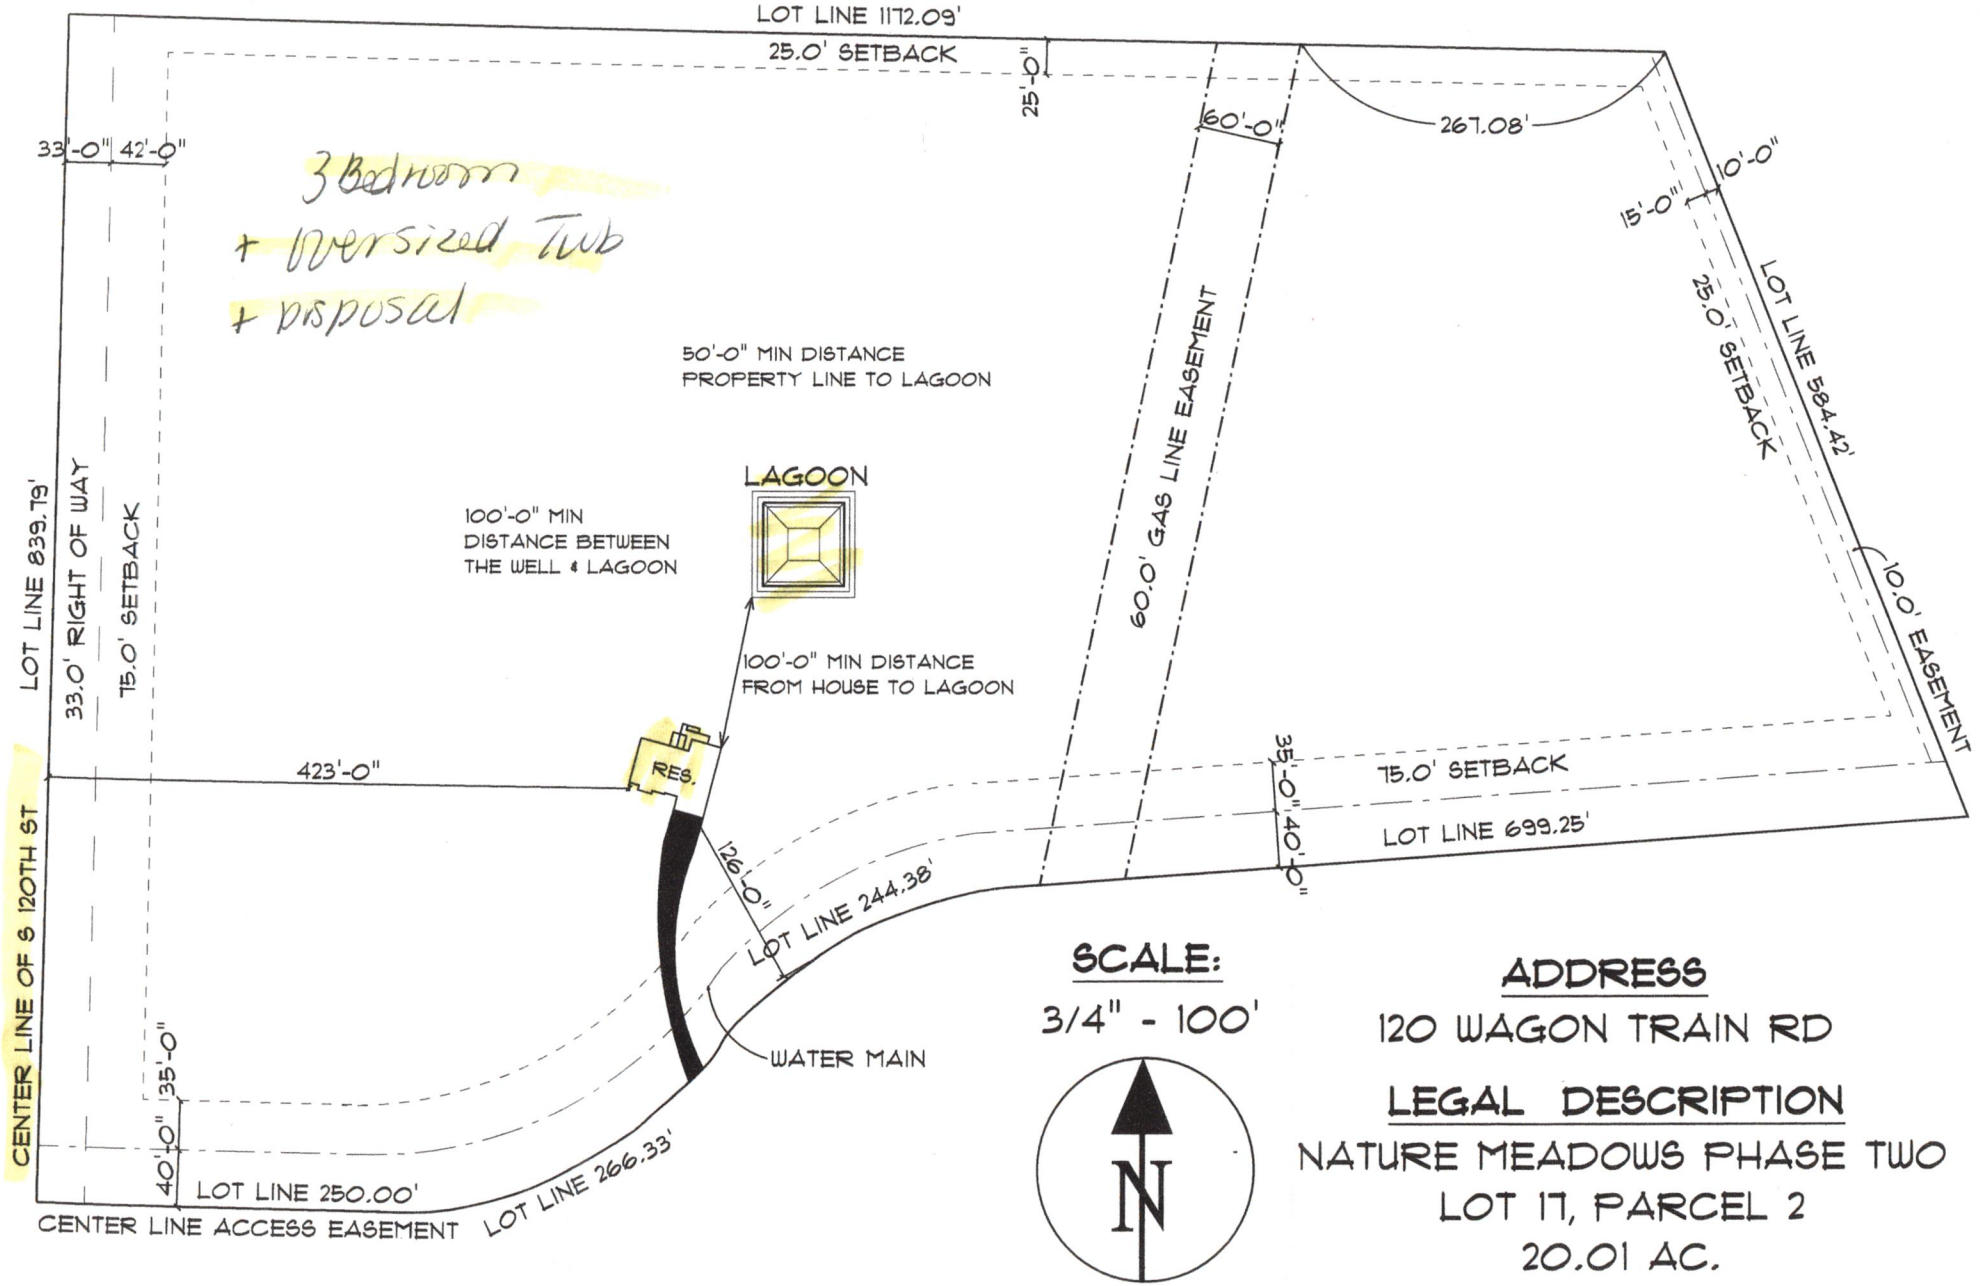

SCALE:

3/4" - 100'

N

ADDRESS

120 WAGON TRAIN RD

LEGAL DESCRIPTION

NATURE MEADOWS PHASE TWO
LOT 17, PARCEL 2
20.01 AC.

PID = 21-32-300-013-000

Lincoln-Lancaster County Health Department
Environmental Public Health Division
3140 "N" Street • Lincoln, NE 68510-1514
Phone: 402-441-8022

JUL 29 2013

D

Permit Number: HS600719

Onsite Wastewater Treatment System

As Built Plans & Specifications

Date 7/23/2013 Legal Description SW (1/4) 32 (1/4) - 8N (Section) - 8E (Township Range) Lot 17

Onsite System Location

Address (no rural route) 19960 S. 120th St City Hickman NE, Zip 68372

Owner Katie Ebert Address 2228 S. 57th St, Lincoln NE 68506

A. Sewer Pipe

1. Material: SDR 26
   Diameter: 4 in.
2. Distance above basement floor: _____ in.
   or distance below basement floor: 16 in.
3. Distance between dwelling and ~~septic tank~~ Lagoon: 130 ft.
4. ~~Number of clean-outs~~: 3
5. Distances to: well or suction line 100 ft.
   stream 100 ft.
   pressure line 100 ft.
   property line 100 ft.

B. Septic Tank

☐ Label with Manufacturer, address and gallon capacity

1. Material: _____
   Number of compartments: _____
2. Capacity: _____ gal.
3. Factory built: ☐ Yes ☐ No
4. Manholes: Over inlet, diameter _____ in.
   Over outlet, diameter _____ in.
   Riser: ☐ above ☐ below grade _____ in.
5. Inlet: ☐ baffle ☐ tee ☐ 6" dia. inspection pipe
6. Outlet: ☐ baffle ☐ tee ☐ 6" dia. inspection pipe
7. Depth to top of tank, below unfinished grade: _____ in.
8. Distances to: Well or suction line _____ ft.
   Stream _____ ft.
   Pressure line _____ ft.
   Property line _____ ft.

C. ☐ Distribution Box ☐ Drop Boxes

(≥ 12" inspection opening) (removable lid to inspect)

1. Material: _____
   Number available outlets: _____
2. Factory built: ☐ Yes ☐ No
3. Distance from septic tank: _____ ft.

D. Drainfield Absorption


☐ Trench ☐ Bed ☐ Level Bottom


1. Type: ☐ Half rounds ☐ Perforated pipe ☐ Chambers
   Diameter or width: _____
   Number of distribution lines in bed _____
   Material: ☐ fiberglass ☐ plastic ☐ concrete
   ☐ other _____
2. Drainfield Laterals: Number _____
   Length of each line: _____ ft. _____ ft.
   _____ ft. _____ ft., _____ ft.
3. Drainfield dimensions: Width _____ ft.
   Distribution Pipe Slope _____ in/100 ft.
   Average depth _____ in
4. Filter material: _____
   Depth of material _____ in.
5. Distances to: Well or suction line _____ ft.
   Pressure line _____ ft.
   Property line _____ ft.
   House or building _____ ft.
   Lake or Stream _____ ft.

Complete As-Built drawing on the back fo this form.

Indicate North with Arrow

Onsite Wastewater System Design (Example)

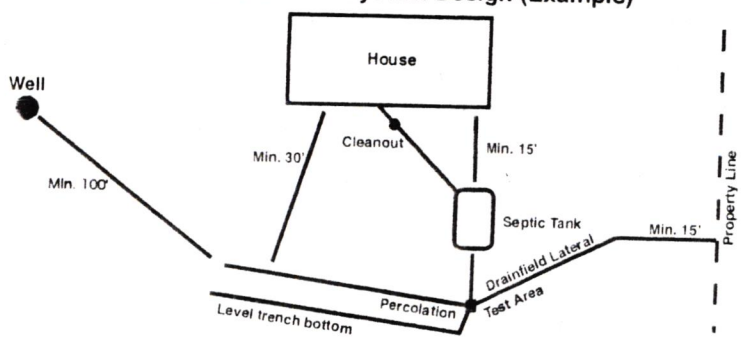

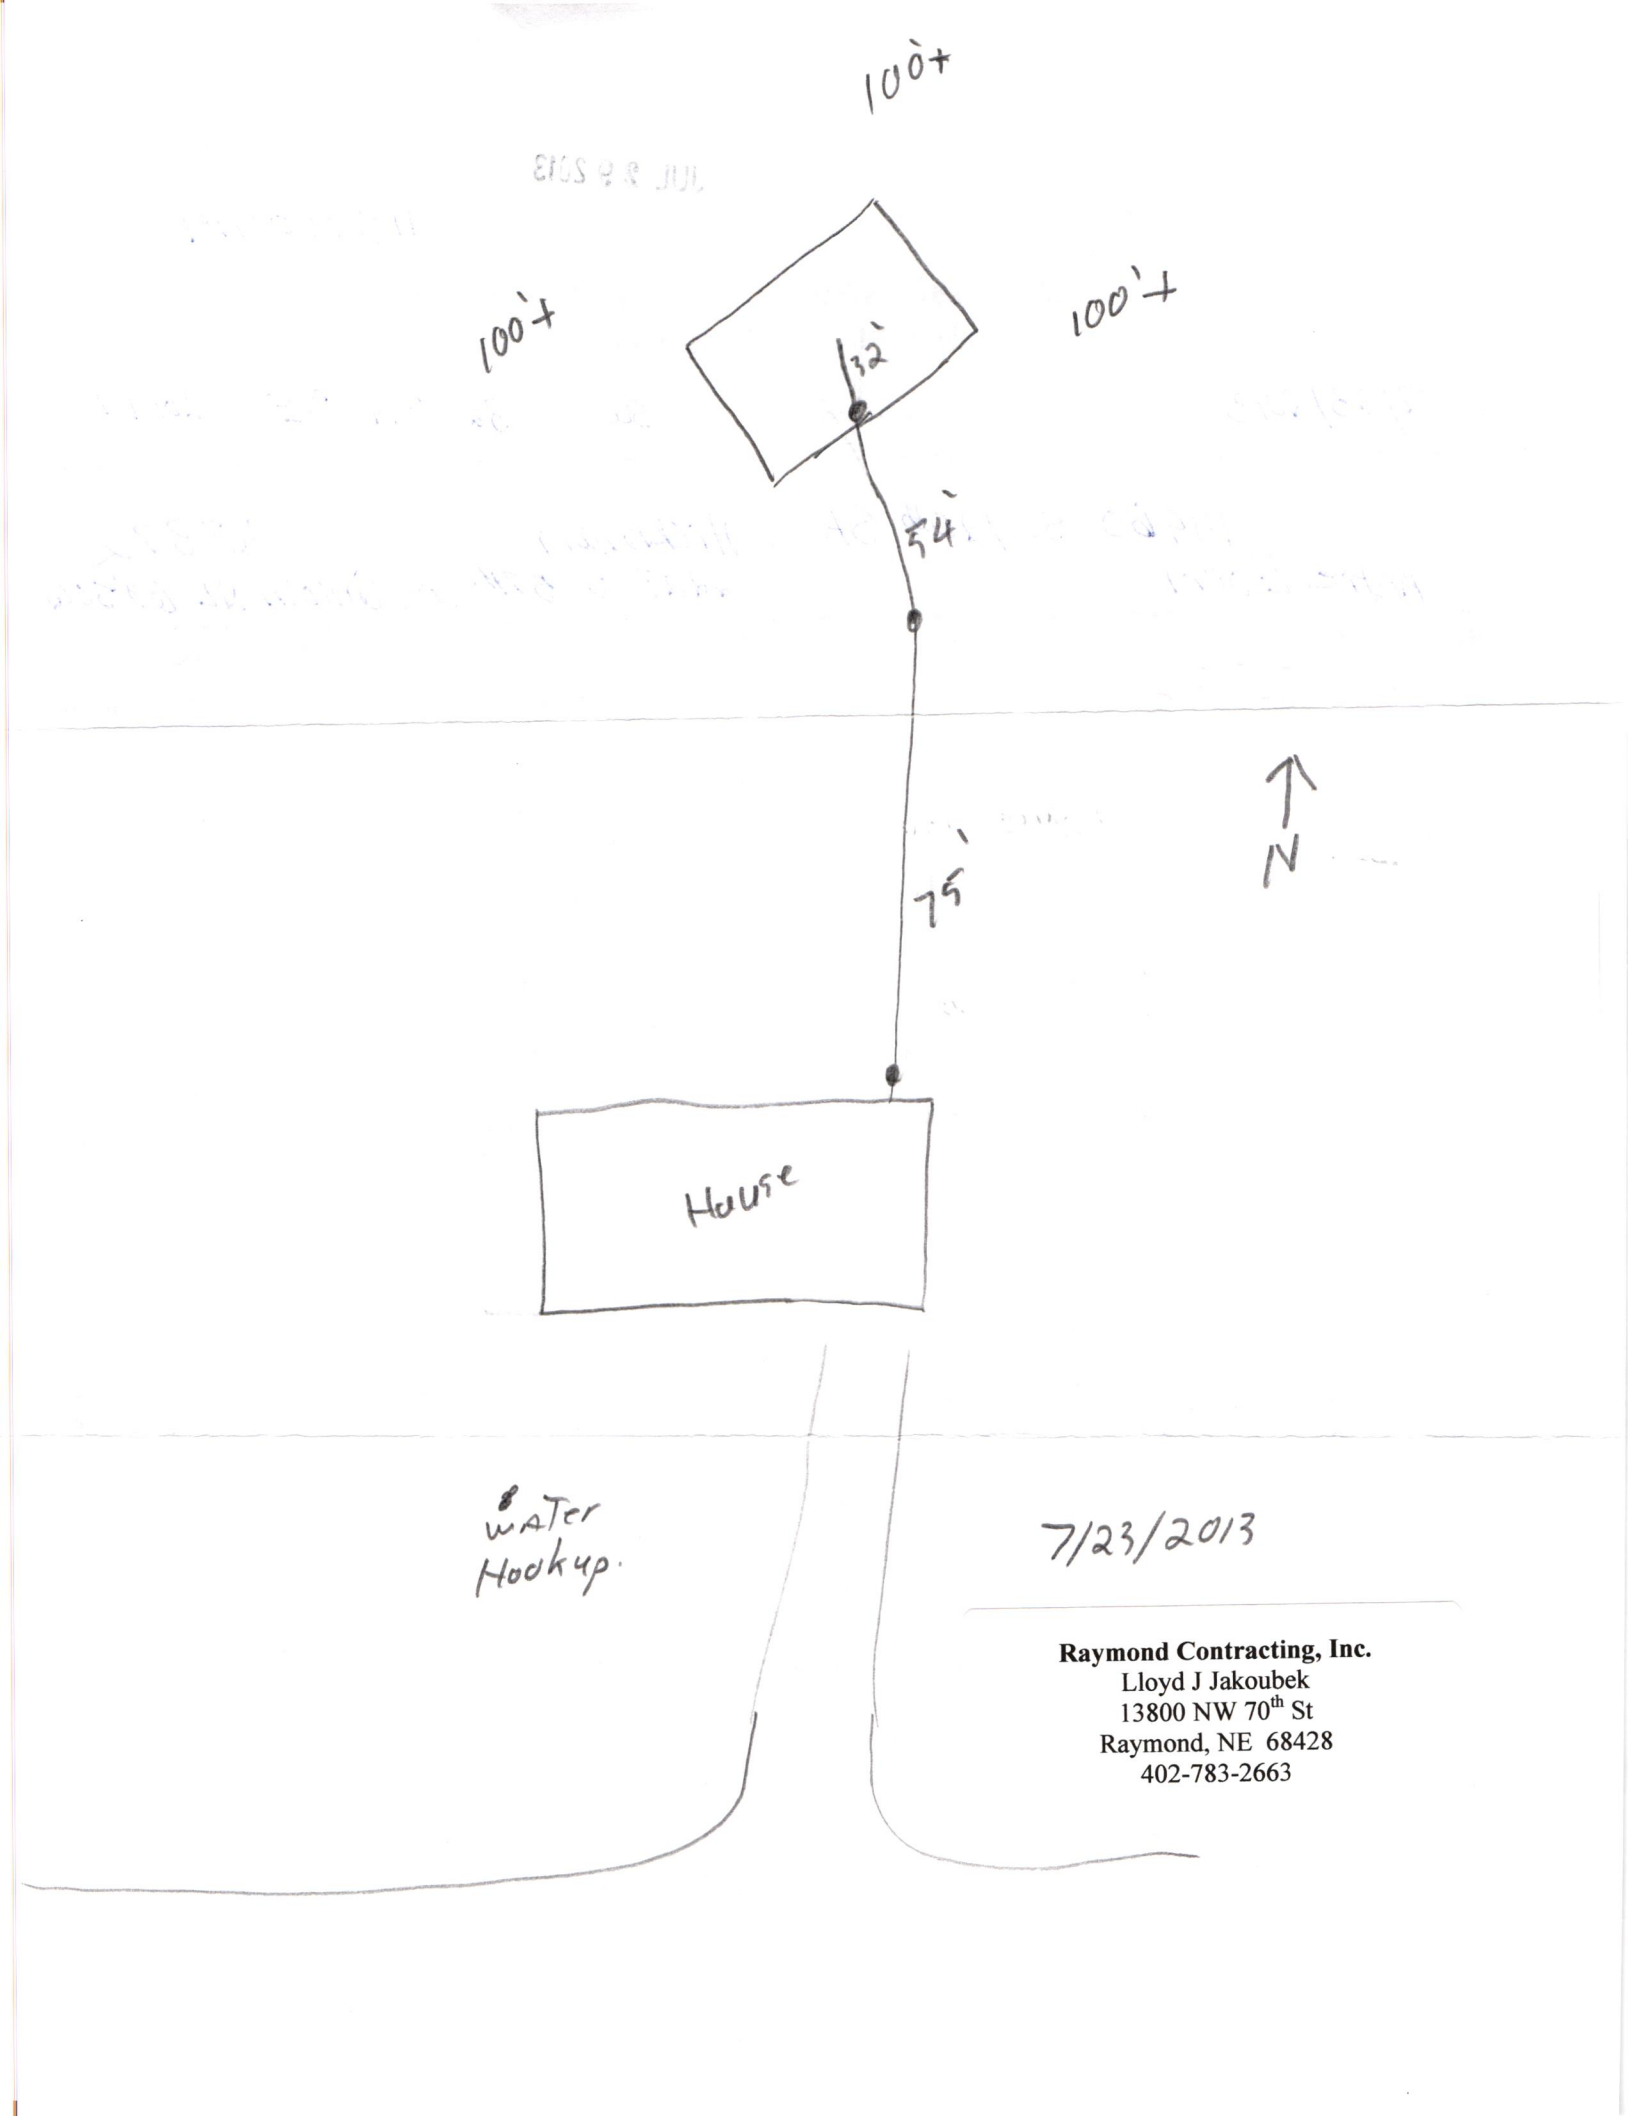

7/23/2013

Raymond Contracting, Inc.
Lloyd J Jakoubek
13800 NW 70th St
Raymond, NE 68428
402-783-2663