A per conv. w Lori 10/28

Lincoln-Lancaster County Health Department
Environmental Health Division
3140 "N" Street • Lincoln, NE 68510-1514
Phone: 402-441-8022

A

Permit Number:
#993802/03

Sewage Disposal System

Request for Site Clearance and Permit

Include Form B, Form C and Applicable Fees with this Application.

☐ Septic System ☒ Lagoon ☐ Other (Refer to Form C)

The undersigned hereby requests site clearance and permit to construct a Sewage Disposal System in conformance with appropriate resolution or ordinance, as described herein:

PLEASE PRINT OR TYPE

A. System Location (Indicate correct number and street)

Address 22333 SW 128 (no rural route) City Kramer NE, Zip

Legal Description 1/4 1/4 Section 7 Township 7 Range 5 Subdivision Addition Block Lot 2

Geographical Location (if known): Longitude Latitude

☑ Check if system mail address is not the same as the owner's address

B. Owner

Name Shane & Lori Oden Signature

Address 4930 Binkerthill Rd City/State/Zip Lincoln, NE 68521

☐ Check if owner designed system Home Phone (402)476-3150 Work Phone 435-8200 (Lori) 467-4602 (Shane)

C. Contractor

Name H.L. Muhlbach Const. Company Name Same

Address 14605 N. 56th St. City/State/Zip Lincoln, NE 68514

☐ Check if contractor designed system Work Phone 785-3815

D. Engineer/Installer ☐ Check and complete if engineer designed system

Designer Name H.L. Muhlbach Const. Firm Work Phone 785-3815

E. This System Will Serve a

☒ Residential Dwelling Number of Bedrooms 3 Is there a Whirlpool Bathtub YES (NO)

☐ Commercial Establishment/Other Facility Specify

Design flow in gallons per day Type of Wastewater: ☒ Domestic ☐ Non-Domestic.

DO NOT WRITE BELOW THIS LINE

Approval Process ☐ Municipal Code 24.38 ☑ County Resolution No. 2832

1. **Health Department** Date rec'd 10-28-99 Date frwd 10-28-99 **ACTION** ☑ Approved ☐ Disapproved Signature
2. **Supt. Bldg. Insp. or Village Clerk** Date rec'd 10/28/99 Date frwd **ACTION** ☑ Approved ☐ Disapproved Signature
3. **City or County Engineer** Date rec'd 10/24/99 Date frwd 10/24/99 **ACTION** ☑ Approved ☐ Disapproved Signature

12-20-99 jm Need to bid with endorsement NW ¼ of Sec

Installation Final Written Approval

By

Date 5/10/00

Business Office Use Only

Date Rec'd 10/28/99
Amt Paid 150
Rec'd By
Cash/Check No. 1184

FORM 23-100 10-96 White - Health Dept. Yellow - Engineer Pink - Bldg. Inspector

Lincoln-Lancaster County Health Department
Environmental Health Division
3140 "N" Street • Lincoln, NE 68510-1514
Phone: 402-441-8022

B

Permit Number: #99380203

Sewage Disposal System

Soil Absorption Test Data Report
Annex to Application

PLEASE PRINT OR TYPE

System Location (Indicate correct number and street)

Address _____ City _____ NE, Zip _____
(no rural route)

Owner Shane & Lori Oden Addresss 4930 Bunkerhill Rd Lincoln, NE 68521

Soil Type (SCS): _____ Percolation Rate: _____ min./inch

Date of Tests _____ to _____ Weather: Precipitation _____ Temperature _____

Percolation Test Data Table

A.	B.	C. D. E. F. Pre-Saturation Period				G. H. I. J. K. Percolation Readings					L. M. N. Results		
		Start		End		Start			End				
Hole No.	Hole Depth (in)	Date (Mo/Da)	Time (Hr/Min)	Date (Mo/Da)	Time (Hr/Min)	Date (Mo/Da)	Time (Hr/Min)	Water Lev (in.)	Date (Mo/Da)	Time (Hr/Min)	Elapsed Time (Min)	Water Level Drop (in)	Percolation Rates (Min/in)

Sum of Percolation Rates: _____
Average of Rates: _____
Rate Used for Calculation: _____

Person Conducting Percolation Tests

Name: _____
Phone: _____
Address _____

* Sealed lagoon will be constructed. *

DO NOT WRITE BELOW THIS LINE

Reviewing Action

Remarks _____

Signature of Reviewing Official _____ Date _____

FORM 23-101 10-96

Lincoln-Lancaster County Health Department
Environmental Health Division
3140 "N" Street • Lincoln, NE 68510-1514
Phone: 402-441-8022


C

Permit Number: #9938 02103

Sewage Disposal System

Preliminary Plan Specifications

Draw a plot plan showing system location, lines, distribution box, tank and laterals, percolation test hole locations, well, residence, compass direction and property lines. Indicate on drawing if residence and well are existing or proposed.

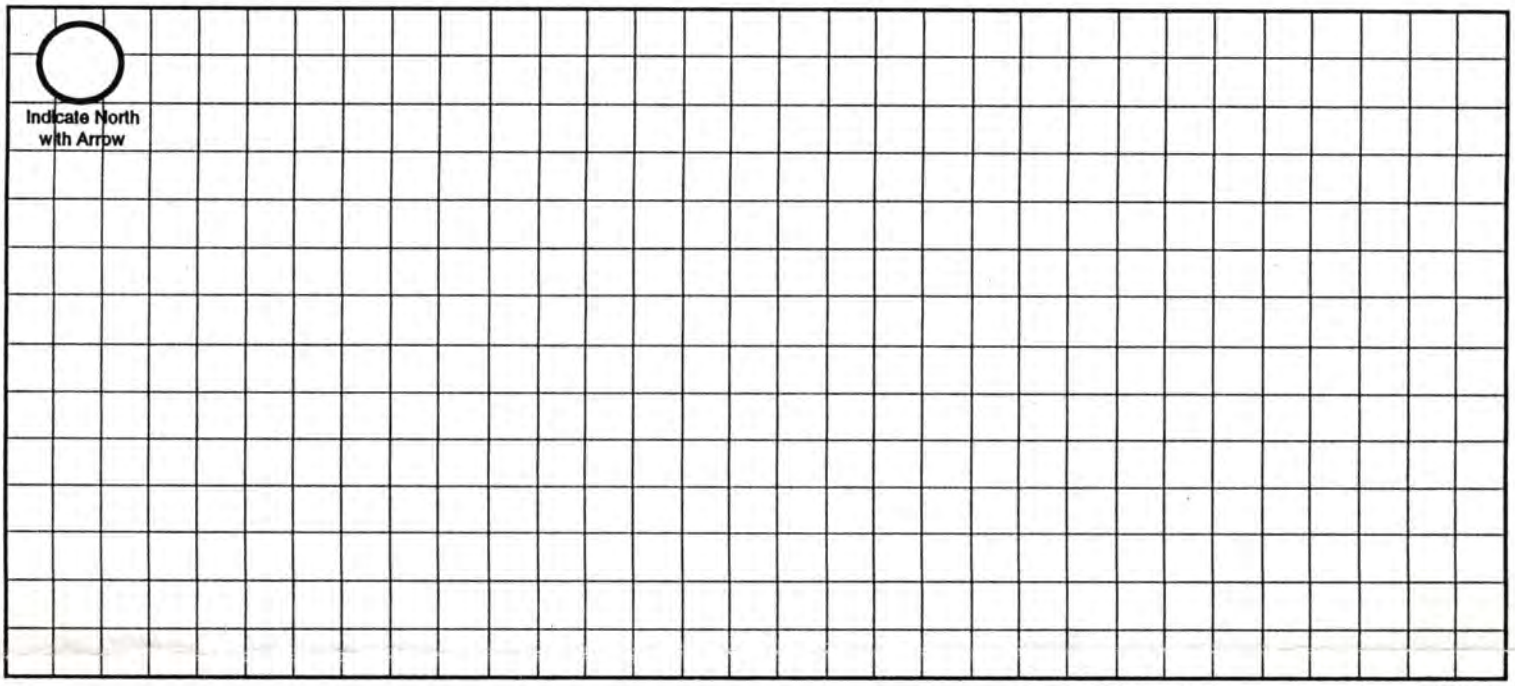

Approximate Scale: _____ ft. = _____ grid line/s

A. System Location (Indicate correct number and street)

Address (no rural route) _____ City _____ NE, Zip _____

B. Proposed Septic Tank/s

Tank Material: ☐ Concrete ☐ Plastic ☐ Other _____

C. Proposed Absorption System (See Form B for Percolation Information)

Percolation Rate _____ (min. per inch) Soil Type: _____ Land Slope: _____ %

Type of Absorption System: ☐ Trench ☐ Bed ☐ Other _____

Total Square Feet of Field Required: _____ sq. ft.

Type of Lateral: ☐ Half-Moon ☐ Perforated Pipe ☐ Other Lateral Material: _____

Capacity of Septic Tank _____ gals Number of Absorption Beds: _____ Number of Distribution Laterals per Bed _____

Total Length of Laterals _____ ft. Number of Trenches _____ Trench Width _____


D. Setbacks Check the Boxes Below if the Required Setback has been Satisfied

Distance From	Private Well	Public Well	Surface Water	Gound Water	Pressure Water Lines	Property Lines	Foundations Yours	Foundations Neighbors	All Other Setbacks
Tank (ft)	50 ☐	500 ☐	50 ☐	NA ☐	25 ☐	20 ☐	15 ☐	25 ☐	☐
Field (ft)	100 ☐	500 ☐	50 ☐	4 ☐	30 ☐	20 ☐	30 ☐	40 ☐	☐
Lagoon (ft)	100 ☒	500 ☐	50 ☒	N/A ☒	30 ☒	50 ☒	100 ☒	200 ☒	☐

E. Required Signatures


Home Building Contractor _____ Date 10-27-99

Installer Harry T. Muhlbach H.L. Muhlbach Constr Date 10-27-99

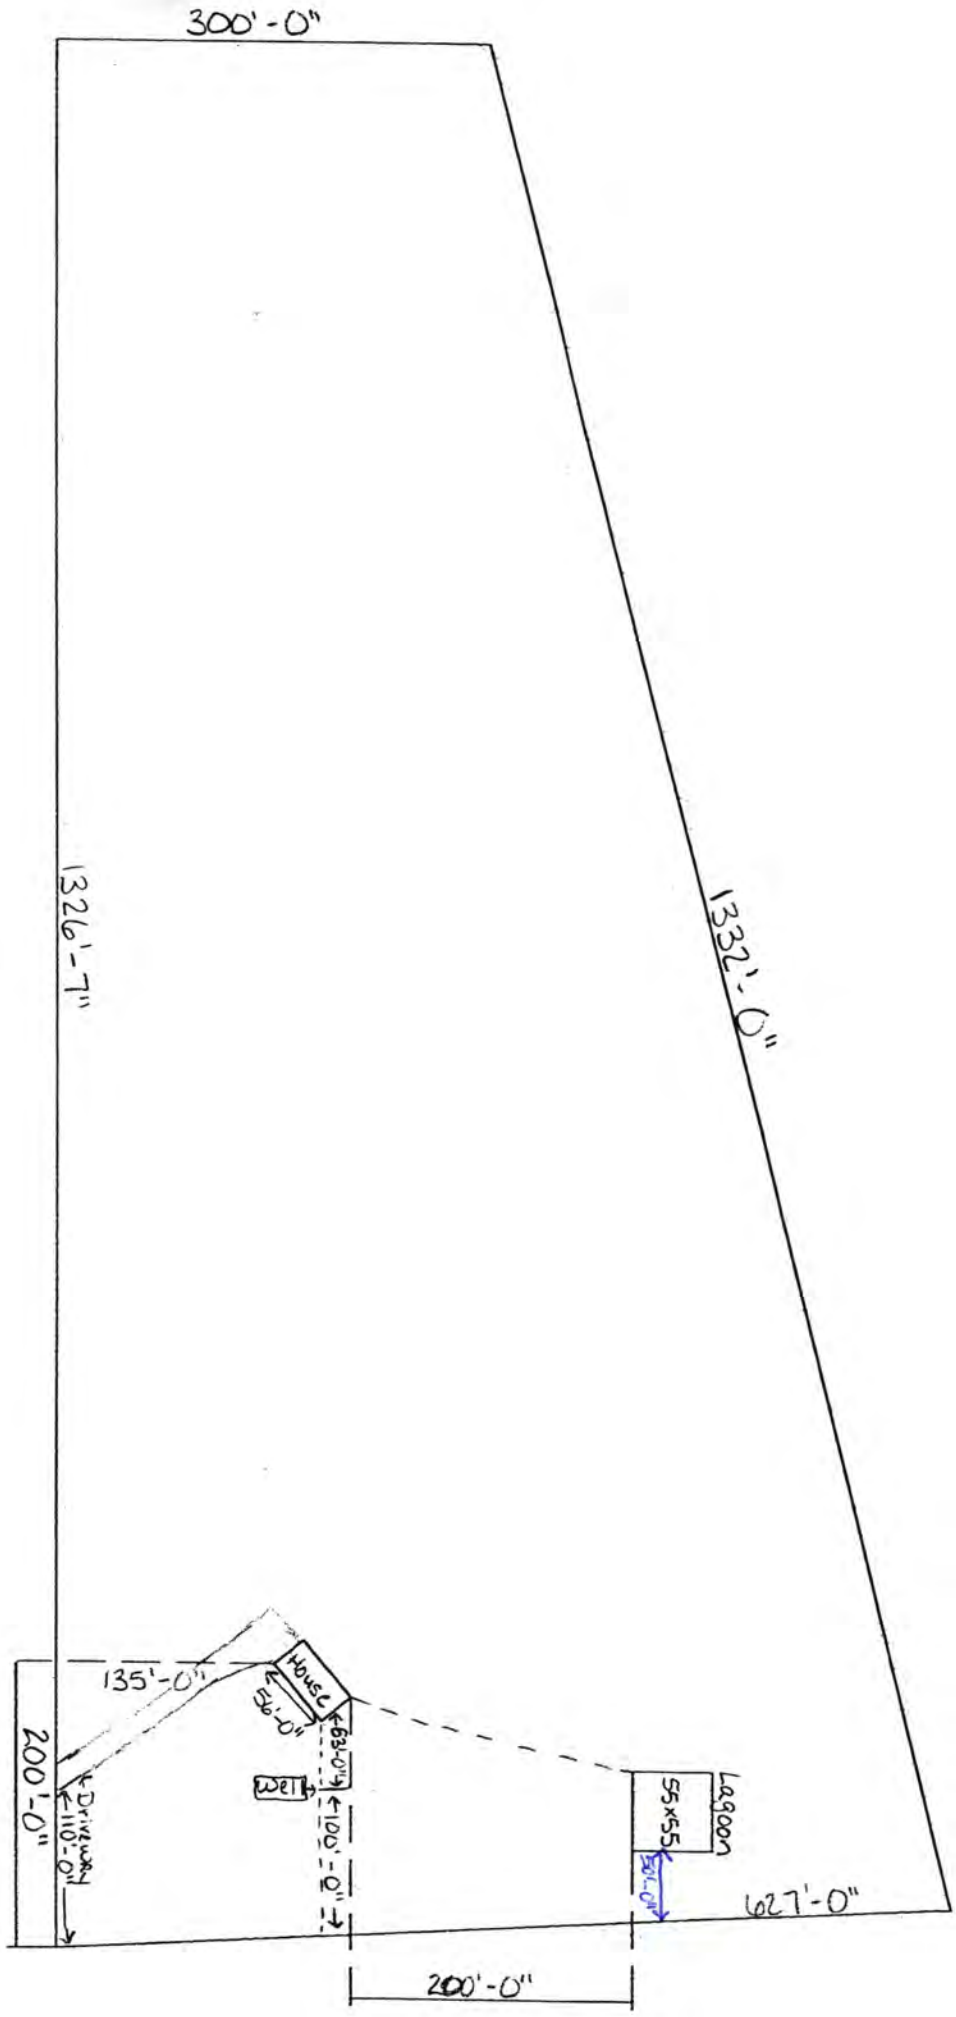
300'-0"
1326'-7"
1332'-0"
135'-0"
House
56'-0"
63'-0"
Well
Driveway
110'-0"
200'-0"
55x55
Lagoon
627'-0"
200'-0"

As Built Drawing

12-20-99

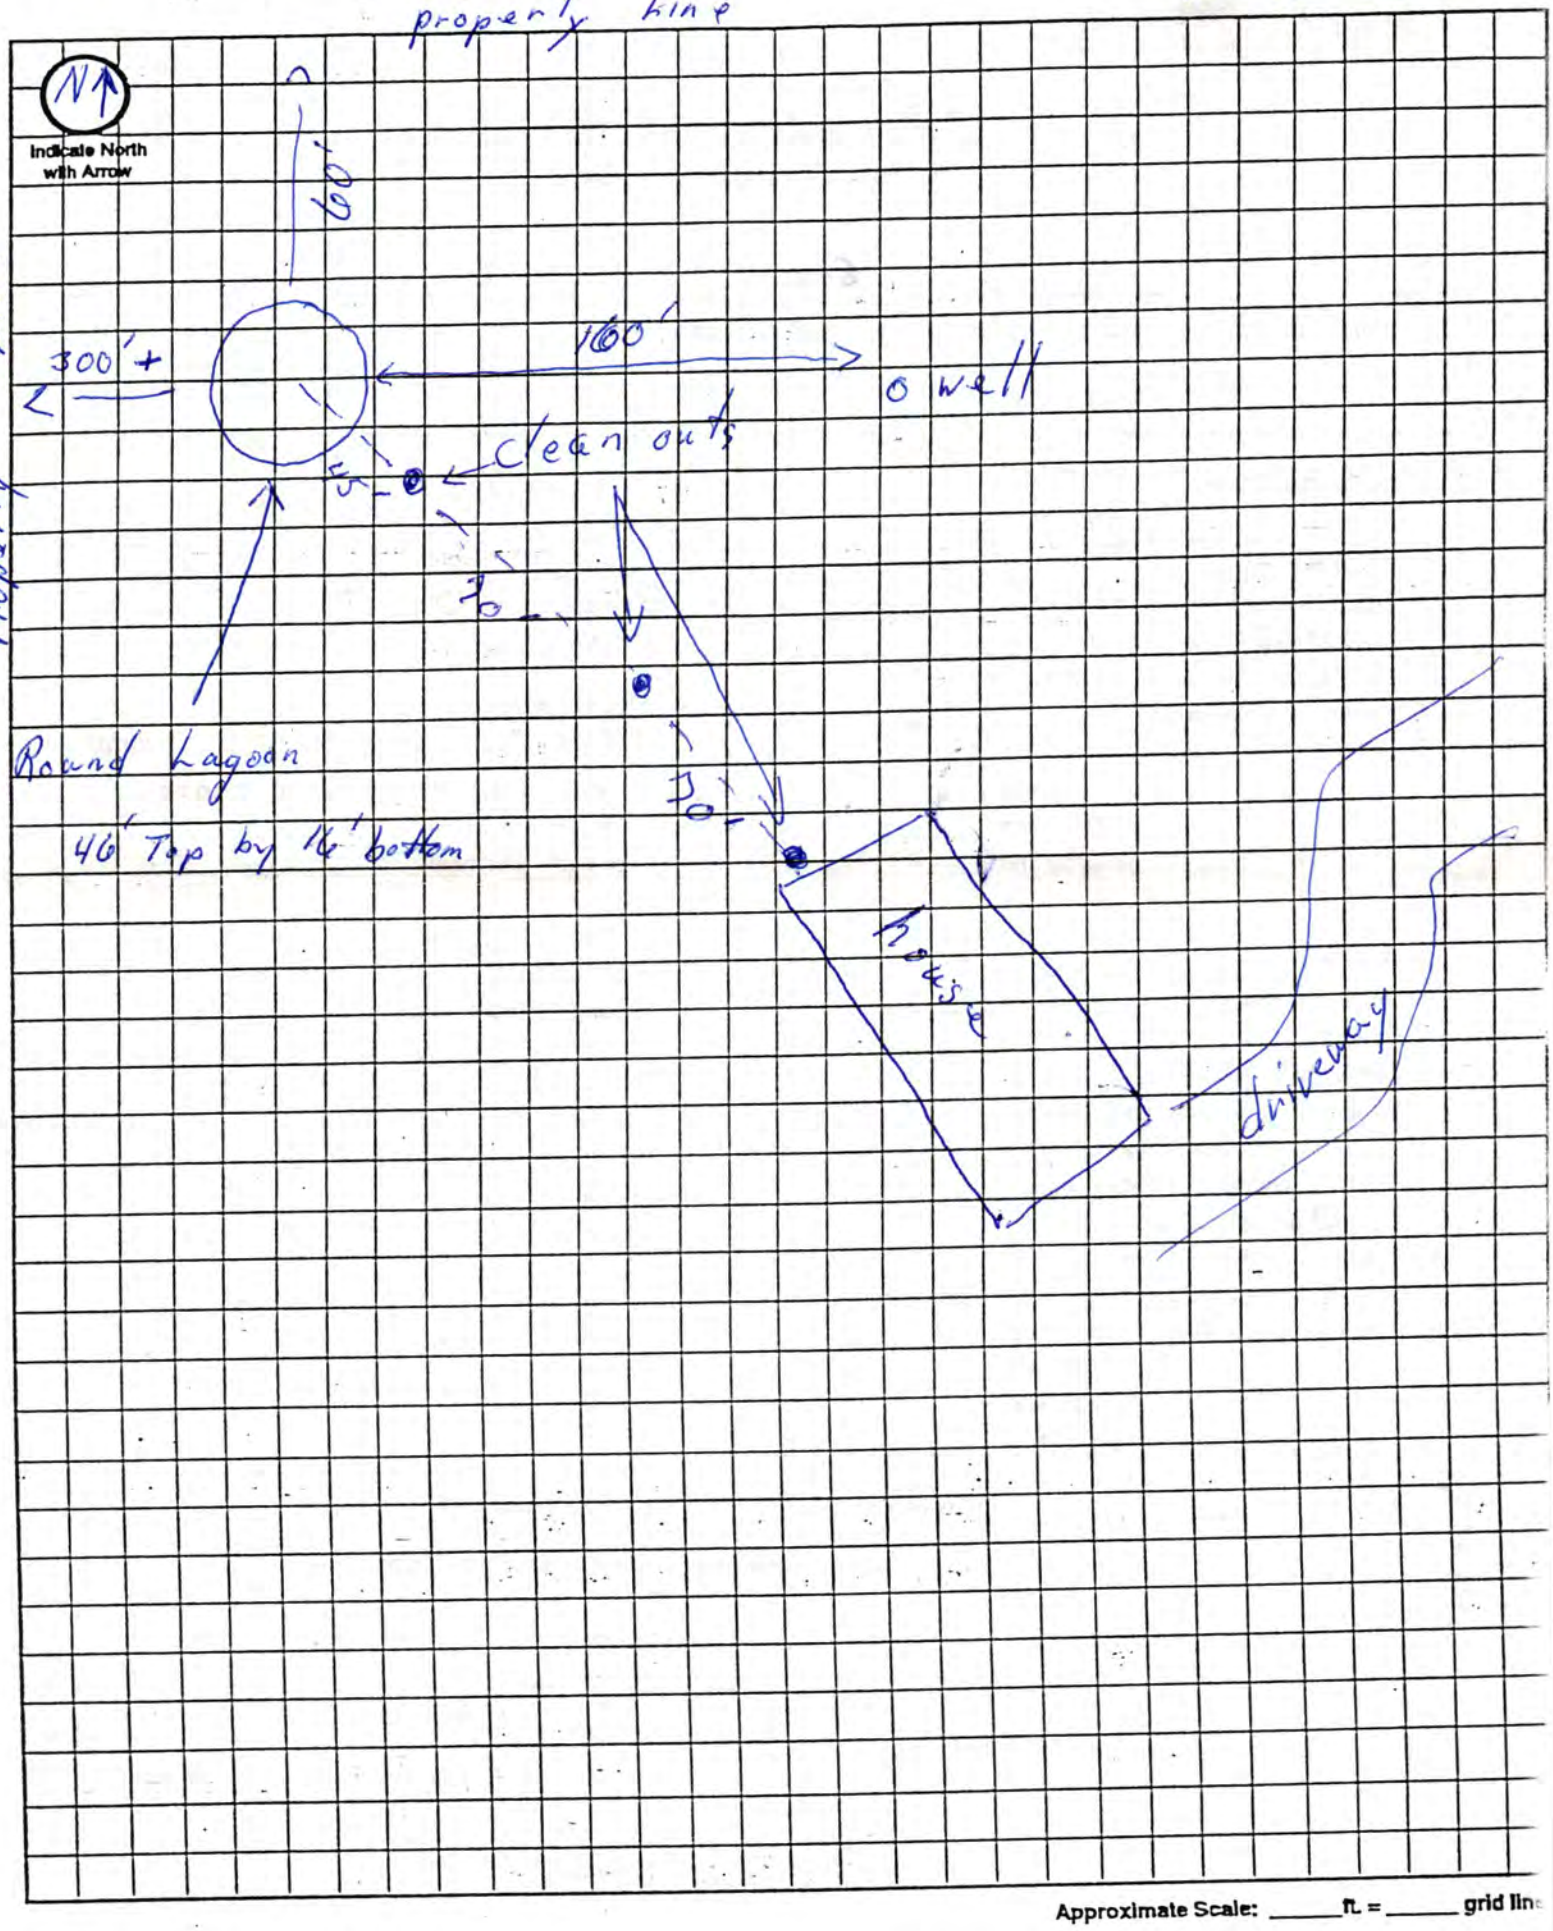

Approximate Scale: _____ ft. = _____ grid lin