Lincoln-Lancaster County Health Department
Environmental Health Division
3140 "N" Street • Lincoln, NE 68510-1514
Phone: 402-441-8022

RECEIVED SEP 23 2005

A

Permit Number: 05380310301

Sewage Disposal System

Request for Site Clearance and Permit

Include Form B, Form C and Applicable Fees with this Application.

☑ Septic System ☐ Lagoon ☐ Other (Refer to Form C)

PENDING PERCOLATION TEST

The undersigned hereby requests site clearance and permit to construct a Sewage Disposal System in conformance with appropriate resolution or ordinance, as described herein:

PLEASE PRINT OR TYPE

W > Stagecoach permit 5910

A. System Location (Indicate correct number and street)

Address 6161 Stagecoach Rd. (no rural route) City Hallam NE, Zip 68368

Legal Description Lot NE 1-7N 5E S.I.T.
1/4 1/4 Section Township Range Subdivision Addition Block Lot

Geographical Location (if known): Longitude _____ Latitude _____

☑ Check if system mail address is not the same as the owner's address

B. Owner

Name Debra L. Wendelin Signature Debra L Wendelin

Address BOX 23 City/State/Zip Martell, NE 68404

☐ Check if owner designed system Home Phone 402-794-6001 Work Phone 402-794-5375

C. Contractor

Name STAN KROESE Company Name DIRT WORKS PLUS INC

Address 7501 LEIGHTON City/State/Zip LINCOLN NE 68507

☑ Check if contractor designed system Work Phone 560 1208

D. Engineer/Installer ☐ Check and complete if engineer designed system

Designer Name _____ Firm _____ Work Phone _____

E. This System Will Serve a

☑ Residential Dwelling Number of Bedrooms 3 Is there a Whirlpool Bathtub YES (NO)

☐ Commercial Establishment/Other Facility Specify _____

Design flow in gallons per day _____ Type of Wastewater: ☑ Domestic ☐ Non-Domestic.

DO NOT WRITE BELOW THIS LINE

Approval Process

☐ Municipal Code 24.38 ☒ County Resolution No. 2832

1. **Health Department** Date rec'd 9/23/05 Date frwd 9/26/05 **ACTION** ☒ Approved ☐ Disapproved Signature Jerrold C. Hood
   10-24-05, on next time.
2. **Supt. Bldg. Insp. or Village Clerk** Date rec'd 9-26-05 Date frwd 9-26-05 **ACTION** ☒ Approved ☐ Disapproved Signature _____
3. **City or County Engineer** Date rec'd 09/26/2005 Date frwd _____ **ACTION** ☒ Approved ☐ Disapproved Signature _____

Installation Final Written Approval

By Doug Amen

Date 11/23/05

Business Office Use Only

Date Rec'd 09/23/05

Amt Paid 275.00

Rec'd By _____ Cash/Check No. 8138

FORM 23-100 10-96 White - Health Dept. Yellow - Engineer Pink - Bldg. Inspector

Lincoln-Lancaster County Health Department
Environmental Health Division
3140 "N" Street • Lincoln, NE 68510-1514
Phone: 402-441-8022


C

Permit Number: 053803/03

Sewage Disposal System
Preliminary Plan Specifications

SEP 23 2005

Draw a plot plan showing system location, lines, distribution box, tank and laterals, percolation test hole locations, well, residence, compass direction and property lines. Indicate on drawing if residence and well are existing or proposed.

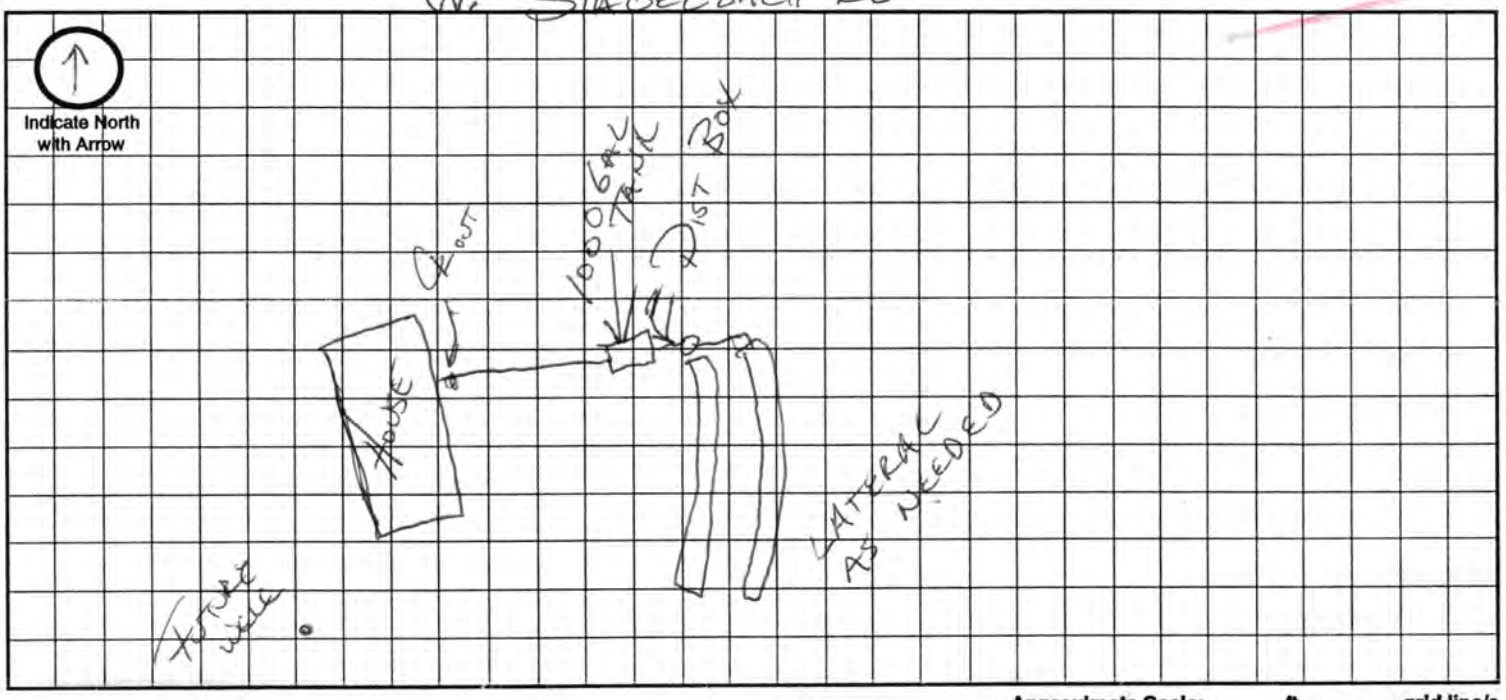

Approximate Scale: _____ ft. = _____ grid line/s

A. System Location (Indicate correct number and street)

Address (no rural route) 6861 W Stagecoach City Hallam NE, Zip 68368

B. Proposed Septic Tank/s

Tank Material: ☑ Concrete ☐ Plastic ☐ Other _____

C. Proposed Absorption System (See Form B for Percolation Information)

Percolation Rate _____ (min. per inch) Soil Type: _____ Land Slope: _____ %

Type of Absorption System: ☑ Trench ☐ Bed ☐ Other _____

Total Square Feet of Field Required: _____ sq. ft.

Type of Lateral: ☐ Half-Moon ☐ Perforated Pipe ☐ Other Lateral Material: _____

Capacity of Septic Tank 1000 gals Number of Absorption Beds: _____ Number of Distribution Laterals per Bed _____

Total Length of Laterals _____ ft. Number of Trenches _____ Trench Width 4

D. Setbacks Check the Boxes Below if the Required Setback has been Satisfied

Distance From	Private Well	Public Well	Surface Water	Gound Water	Pressure Water Lines	Property Lines	Foundations Yours	Foundations Neighbors	All Other Setbacks
Tank (ft)	50 ☑	500 ☑	50 ☑	NA ☑	25 ☑	20 ☑	15 ☑	25 ☑	☑
Field (ft)	100 ☑	500 ☑	50 ☑	4 ☑	30 ☑	20 ☑	30 ☑	40 ☑	☑
Lagoon (ft)	100 ☐	500 ☐	50 ☐	N/A ☐	30 ☐	50 ☐	100 ☐	200 ☐	☐


E. Required Signatures

Home Building Contractor ★ Debra L Woodcock Date 9-17-05

Installer _____ Date 9/22/05

FORM 23-102 10-96

As Built Drawing

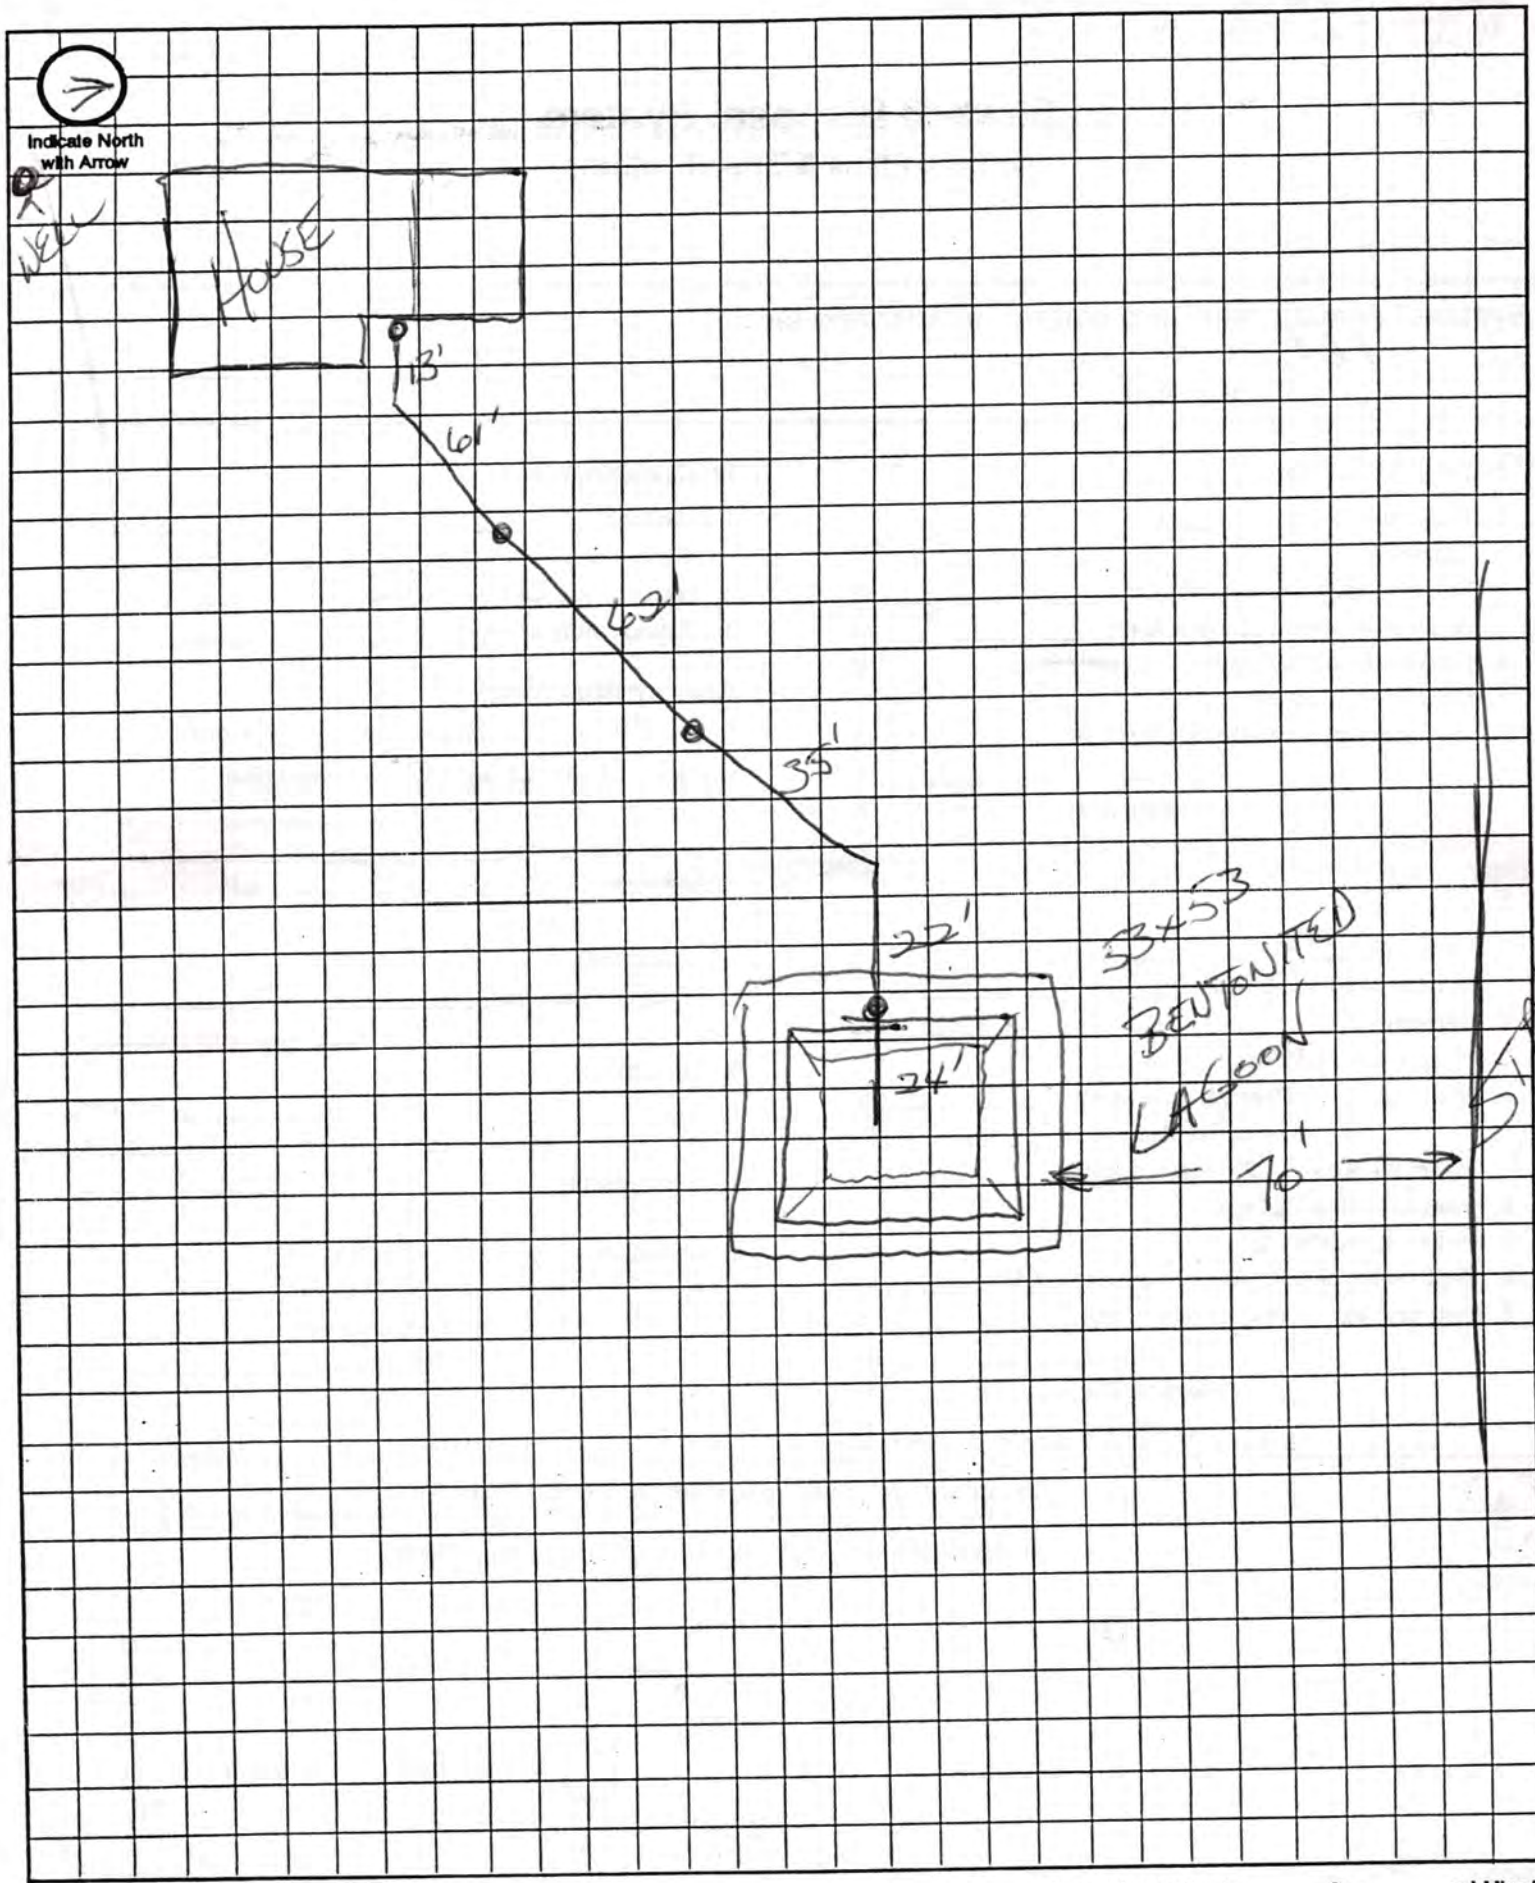

Approximate Scale: _____ ft. = _____ grid line/s

Lincoln-Lancaster County Health Department
Environmental Health Division
3140 "N" Street • Lincoln, NE 68510-1514
Phone: 402-441-8022

D

Permit Number:

1-7-5

Sewage Disposal System

As Built Plans & Specifications

Date 10/24/05 WENDLIN

System Location (Indicate correct number and street)

Address 6061 W STAGECOACH (no rural route) City _____ NE, Zip _____

A. Building Sewer

1. Material: CLS 160. Diameter: 4 in.
2. Distance above basement floor: _____ in.
   or distance below basement floor: 18 in.
3. Distance between dwelling and ~~septic tank~~ LAGOON: 193 ft.
4. Number of clean-outs: 4
5. Distances to: well or suction line 100+ ft.
   stream 100+ ft.
   pressure line 100+ ft.
   property line 100+ ft.

B. ~~Septic Tank~~

1. ~~Material:~~ _____
   Number of compartments: _____
2. Capacity: _____ gal.
3. Factory built: ☐ Yes ☐ No
4. Manholes: Over inlet, diameter _____ in.
   Over outlet, diameter _____ in.
   Riser: ☐ above ☐ below grade _____ in.
5. Inlet: ☐ baffle ☐ tee
6. Outlet: ☐ baffle ☐ tee
7. Depth to top of tank, below unfinished grade: _____ in.
8. Distances to: Well or suction line _____ ft.
   Stream _____ ft.
   Pressure line _____ ft.
   Property line _____ ft.

C. ~~Distribution~~ Box

1. Material: _____
   Number available outlets: _____
2. Factory built: ☐ Yes ☐ No
3. Distance from septic tank: _____ ft.

D. Absorption Field


(Provide as-built drawings on back of this form)

1. Type: ☐ Half rounds ☐ Perforated pipe
   Diameter of half round: _____
   or perforated pipe: _____
   Material: ☐ fiberglass ☐ plastic ☐ concrete ☐ other _____
2. Lateral lines: Number _____
   Length of each line: _____ ft. _____ ft.
   _____ ft. _____ ft., _____ ft.
3. Trench dimensions: Width _____ ft.
   Slope _____ in/100 ft.
   Average depth _____ in
4. Filter material: _____
   Depth of material _____ in.
5. Distances to: Well or suction line _____ ft.
   Stream _____ ft.
   Pressure line _____ ft.
   Property line _____ ft.

Complete "As Built" drawing on back of this form.

Indicate North with Arrow

Individual Sewage System Design (Example)

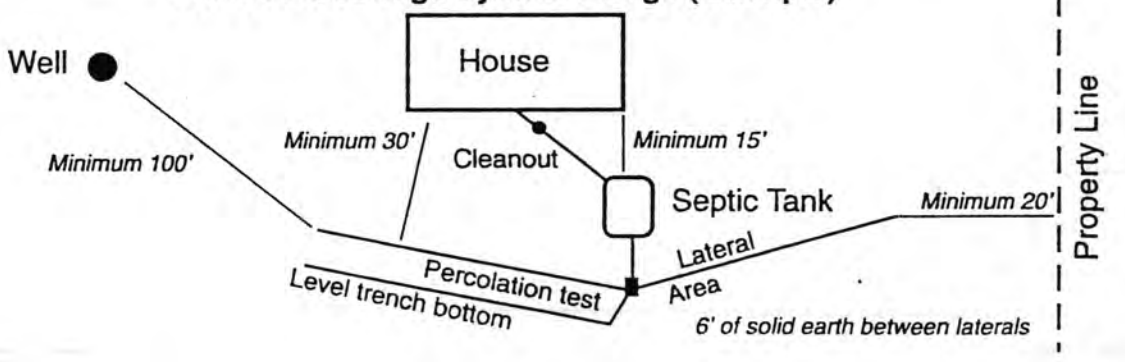

FORM 23-103 10-96