**Lincoln-Lancaster County Health Department**
Environmental Health Division
3140 "N" Street • Lincoln, NE 68510-1514
Phone: 402-441-8022

**A**

Permit Number: 013802402

# Sewage Disposal System

## Request for Site Clearance and Permit

**Include Form B, Form C and Applicable Fees with this Application.**

☐ Septic System ☒ Lagoon ☐ Other (Refer to Form C)

The undersigned hereby requests site clearance and permit to construct a Sewage Disposal System in conformance with appropriate resolution or ordinance, as described herein:

**PLEASE PRINT OR TYPE**

### A. System Location (Indicate correct number and street)

Address 23250 S.W. 114TH (no rural route) City CRETE NE, Zip NE 68333

Legal Description LOT 8, 13.14, SW 1/4 9 - T7N R5E
(1/4 1/4 Section Township Range Subdivision Addition Block Lot)

Geographical Location (if known): Longitude _____ Latitude _____

☐ Check if system mail address is not the same as the owner's address

### B. Owner

Name RUTH & ROBERT MISCHNICK Signature _____

Address 23250 S.W. 114TH City/State/Zip CRETE NE. 68333

☐ Check if owner designed system Home Phone _____ Work Phone _____

### C. Contractor

Name GERALD STERNS Company Name STERNS CONST

Address _____ City/State/Zip BENNET NEBR

☑ Check if contractor designed system Work Phone 782-6245 - 450-0744

### D. Engineer/Installer ☐ Check and complete if engineer designed system

Designer Name _____ Firm _____ Work Phone _____

### E. This System Will Serve a

☑ Residential Dwelling Number of Bedrooms 2 Is there a Whirlpool Bathtub YES (NO)

☐ Commercial Establishment/Other Facility Specify _____

Design flow in gallons per day _____ Type of Wastewater: ☑ Domestic ☐ Non-Domestic.

***DO NOT WRITE BELOW THIS LINE***

### Approval Process ☐ Municipal Code 24.38 ☒ County Resolution No. 2832

1. **Health Department** Date rec'd 11/15/01 Date frwd 11/16/01 ACTION ☒ Approved ☐ Disapproved Signature Jerrold C. Hood
2. **Supt. Bldg. Insp. or Village Clerk** Date rec'd 11/16/01 Date frwd _____ ACTION ☑ Approved ☐ Disapproved Signature _____ NO DEVELOPMENT IN FLOOD PLAIN.
3. **City or County Engineer** – Drawing received Need fence 11/15/01 O.C. Date rec'd 11/16/01 Date frwd 11/16/01 ACTION ☒ Approved ☐ Disapproved Signature _____

### Installation Final Written Approval

By _____

Date 12/11/01

***Business Office Use Only***
Date Rec'd 11/15/01
Amt Paid 200.00
Rec'd By _____ Cash/Check No. 8853

FORM 23-100 10-96 White - Health Dept. Yellow - Engineer Pink - Bldg. Inspector

As built


C D

**Lincoln-Lancaster County Health Department**
Environmental Health Division
3140 "N" Street • Lincoln, NE 68510-1514
Phone: 402-441-8022

Permit Number: 0138024402

# Sewage Disposal System
## Preliminary Plan Specifications

Draw a plot plan showing system location, lines, distribution box, tank and laterals, percolation test hole locations, well, residence, compass direction and property lines. Indicate on drawing if residence and well are existing or proposed.

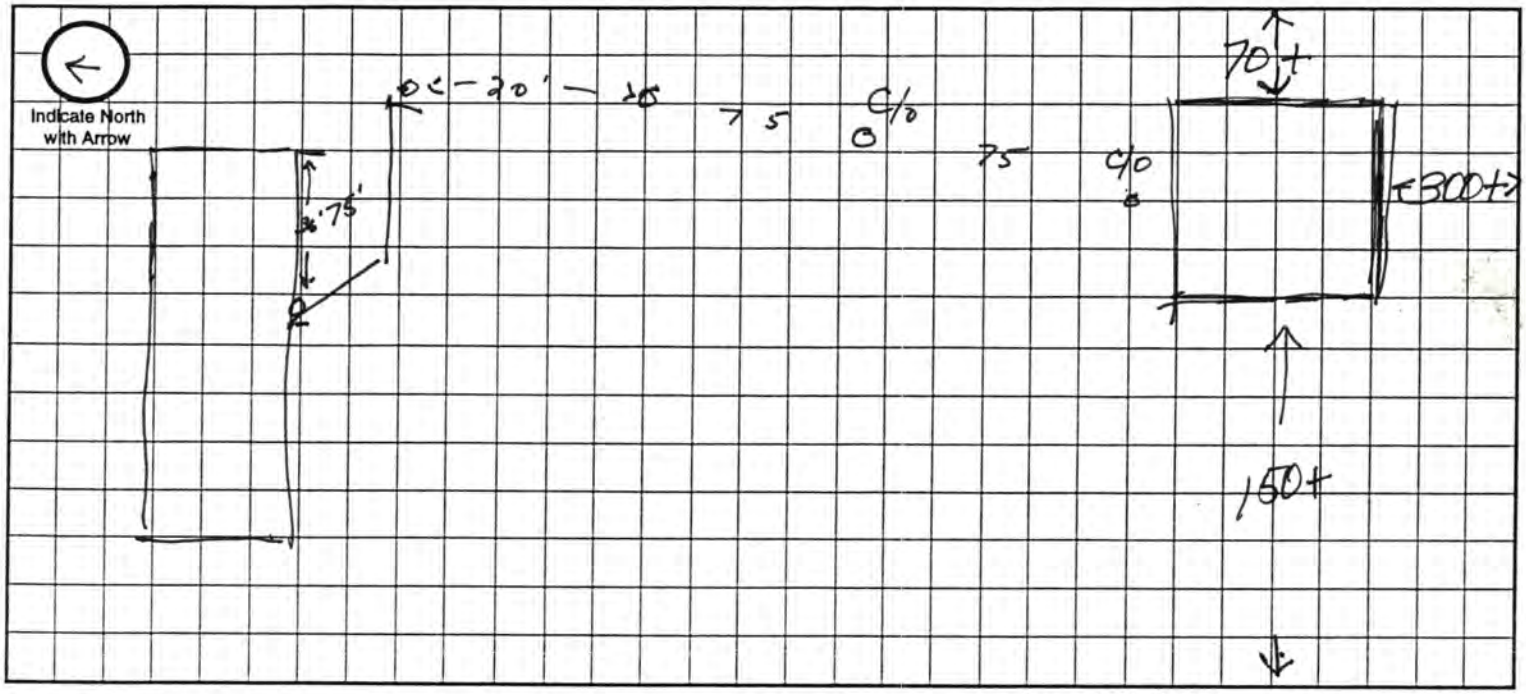


**Approximate Scale:** _____ ft. = _____ grid line/s

## A. System Location (Indicate correct number and street)

Address (no rural route) _____ City _____ NE, Zip _____

## B. Proposed Septic Tank/s

Tank Material: ☐ Concrete ☐ Plastic ☐ Other _____

## C. Proposed Absorption System (See Form B for Percolation Information)

Percolation Rate _____ (min. per inch) Soil Type: _____ Land Slope: _____ %

Type of Absorption System: ☐ Trench ☐ Bed ☐ Other _____

Total Square Feet of Field Required: _____ sq. ft.

Type of Lateral: ☐ Half-Moon ☐ Perforated Pipe ☐ Other Lateral Material: _____

Capacity of Septic Tank _____ gals Number of Absorption Beds: _____ Number of Distribution Laterals per Bed _____

Total Length of Laterals _____ ft. Number of Trenches _____ Trench Width _____

## D. Setbacks Check the Boxes Below if the Required Setback has been Satisfied

| Distance From | Private Well | Public Well | Surface Water | Gound Water | Pressure Water Lines | Property Lines | Foundations Yours | Foundations Neighbors | All Other Setbacks |
|---|---|---|---|---|---|---|---|---|---|
| Tank (ft) | 50 ☐ | 500 ☐ | 50 ☐ | NA ☐ | 25 ☐ | 20 ☐ | 15 ☐ | 25 ☐ | ☐ |
| Field (ft) | 100 ☐ | 500 ☐ | 50 ☐ | 4 ☐ | 30 ☐ | 20 ☐ | 30 ☐ | 40 ☐ | ☐ |
| Lagoon (ft) | 100 ☐ | 500 ☐ | 50 ☐ | N/A ☐ | 30 ☐ | 50 ☐ | 100 ☐ | 200 ☐ | ☐ |

## E. Required Signatures

Home Building Contractor PRE-BUILT Date _____

Installer _____ Date _____

Lincoln-Lancaster County Health Department
Environmental Health Division
3140 "N" Street • Lincoln, NE 68510-1514
Phone: 402-441-8022

**D**

Permit Number:

# Sewage Disposal System

## As Built Plans & Specifications

Date _____

**System Location (Indicate correct number and street)**

Address _____ City _____ NE, Zip _____
(no rural route)

### A. Building Sewer

1. Material: 4" Sch 40 P.V.C.
   Diameter: 4" in.
2. Distance above basement floor: _____ in.
   or distance below basement floor: 18" in.
3. Distance between dwelling and septic tank: _____ ft.
4. Number of clean-outs: #5
5. Distances to: well or suction line 40' ft.
   stream _____ ft.
   pressure line _____ ft.
   property line _____ ft.

### B. Septic Tank

1. Material: _____
   Number of compartments: _____
2. Capacity: _____ gal.
3. Factory built: ☐ Yes ☐ No
4. Manholes: Over inlet, diameter _____ in.
   Over outlet, diameter _____ in.
   Riser: ☐ above ☐ below grade _____ in.
5. Inlet: ☐ baffle ☐ tee
6. Outlet: ☐ baffle ☐ tee
7. Depth to top of tank, below unfinished grade: _____ in.
8. Distances to: Well or suction line _____ ft.
   Stream _____ ft.
   Pressure line _____ ft.
   Property line _____ ft.

### C. Distribution Box

1. Material: _____
   Number available outlets: _____
2. Factory built: ☐ Yes ☐ No
3. Distance from septic tank: _____ ft.

### D. Absorption Field


*(Provide as-built drawings on back of this form)*

1. Type: ☐ Half rounds ☐ Perforated pipe
   Diameter of half round: _____
   or perforated pipe: _____
   Material: ☐ fiberglass ☐ plastic ☐ concrete
   ☐ other _____
2. Lateral lines: Number _____
   Length of each line: _____ ft. _____ ft.
   _____ ft. _____ ft., _____ ft.
3. Trench dimensions: Width _____ ft.
   Slope _____ in/100 ft.
   Average depth _____ in
4. Filter material: _____
   Depth of material _____ in.
5. Distances to: Well or suction line _____ ft.
   Stream _____ ft.
   Pressure line _____ ft.
   Property line _____ ft.

Indicate North with Arrow

**Complete "As Built" drawing on back of this form.**

**Individual Sewage System Design (Example)**

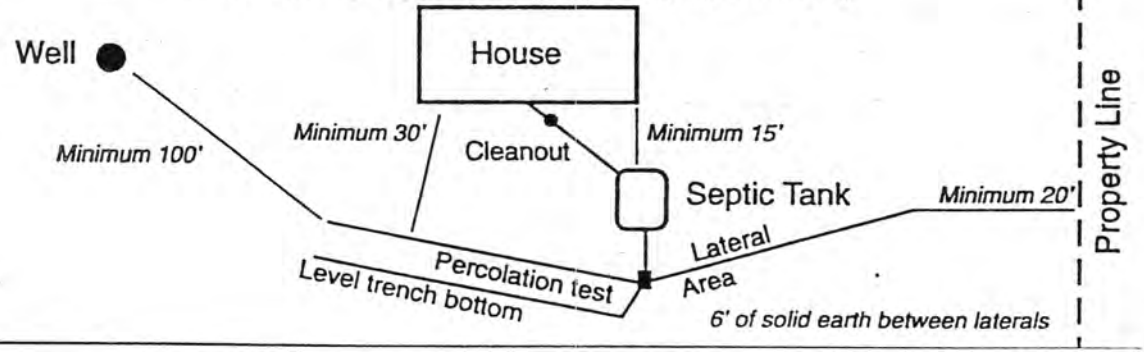


FORM 23-103 10-96