Lincoln/Lancaster County Health Department
Environmental Public Health Division
3140 N Street • Lincoln NE 68510-1514
Phone: 402-441-8022

SCANNED

A

Permit Number HS000105

Onsite Wastewater Treatment System Request for Site Clearance and Permit

Include Form B and C. Submit correct fee with this Application

3 acres or more required for: ☐ Septic System ☒ Lagoon ☐ Other (Refer to Form C)

The undersigned hereby requests site clearance and permit to construct a Wastewater Treatment System in conformance with appropriate regulations.

PLEASE PRINT OR TYPE

A. Onsite System Location

Address 27233 S.W. 29th (no rural route) City Hallam, NE Zip

Legal Description NE 1/4 1/4 29 Section 7 Township 6 Range (IRT NE1/4 of Section 29 Parcel 1 Subdivison Addition Block Lot

Geographical Location (if known): Longitude: Latitude:

☐ Check if system mail address is not the same as the owner's address Total Acres:

B. Owner

Name Gaylen DeVries Signature X

Address 305 W. 8th City/State/Zip Cortland NE, 68331

☐ Check if owner designed system Home Phone 798-7333 Work Phone 432-5799

C. Contractor

Name: Company Name NE. Dirtworks

Address City/State/Zip 7500 Panama Rd. Hickman NE 68372

☐ Check if contractor designed system Work Phone 792-0085

D. Engineer/Installer ☐ Check and complete if engineer designed system

Designer Name Dave Pruss Firm Ne. Dirtworks Work Phone 402-792-0085

E. This system will serve a

☒ Residential Dwelling Number of Bedrooms 3 Is there a Whirlpool Bathtub? ☐ Yes ☑ No

☐ Commercial Establishment/Other Facility Specify Design flow in gallons per day

Type of Wastewater ☐ Domestic ☐ Non-Domestic Well Permit Applied for ☐ Yes ☐ No ☐ Not Applicable

DO NOT WRITE BELOW THIS LINE

Approval Process ☐ Municipal Code 24.38 ☐ County Resolution No. 02-30

1. Health Department Date rec'd ACTION ☐ Approved ☐ Disapproved
Site visits Date frwd Signature

2. Supt. Bldg. Insp. or Village Clerk Date rec'd ACTION ☐ Approved ☐ Disapproved
Comments Date frwd Signature

3. City or County Engineer Date rec'd ACTION ☐ Approved ☐ Disapproved
Comments 5/29/08 Date frwd Signature
Use a lagoon with 54 ft from property line

Installation Final Written Approval
By
Date 9/30/08


Business Office Use Only
Date Received 5/21/08 Amount Paid 305.00
Received By Cash/Check No. 8976

White - Health Department Yellow - Engineer Pink - Building & Safety

Form A Updated: 5-07

As Built Drawing

Galen ~~Det~~
DeVries

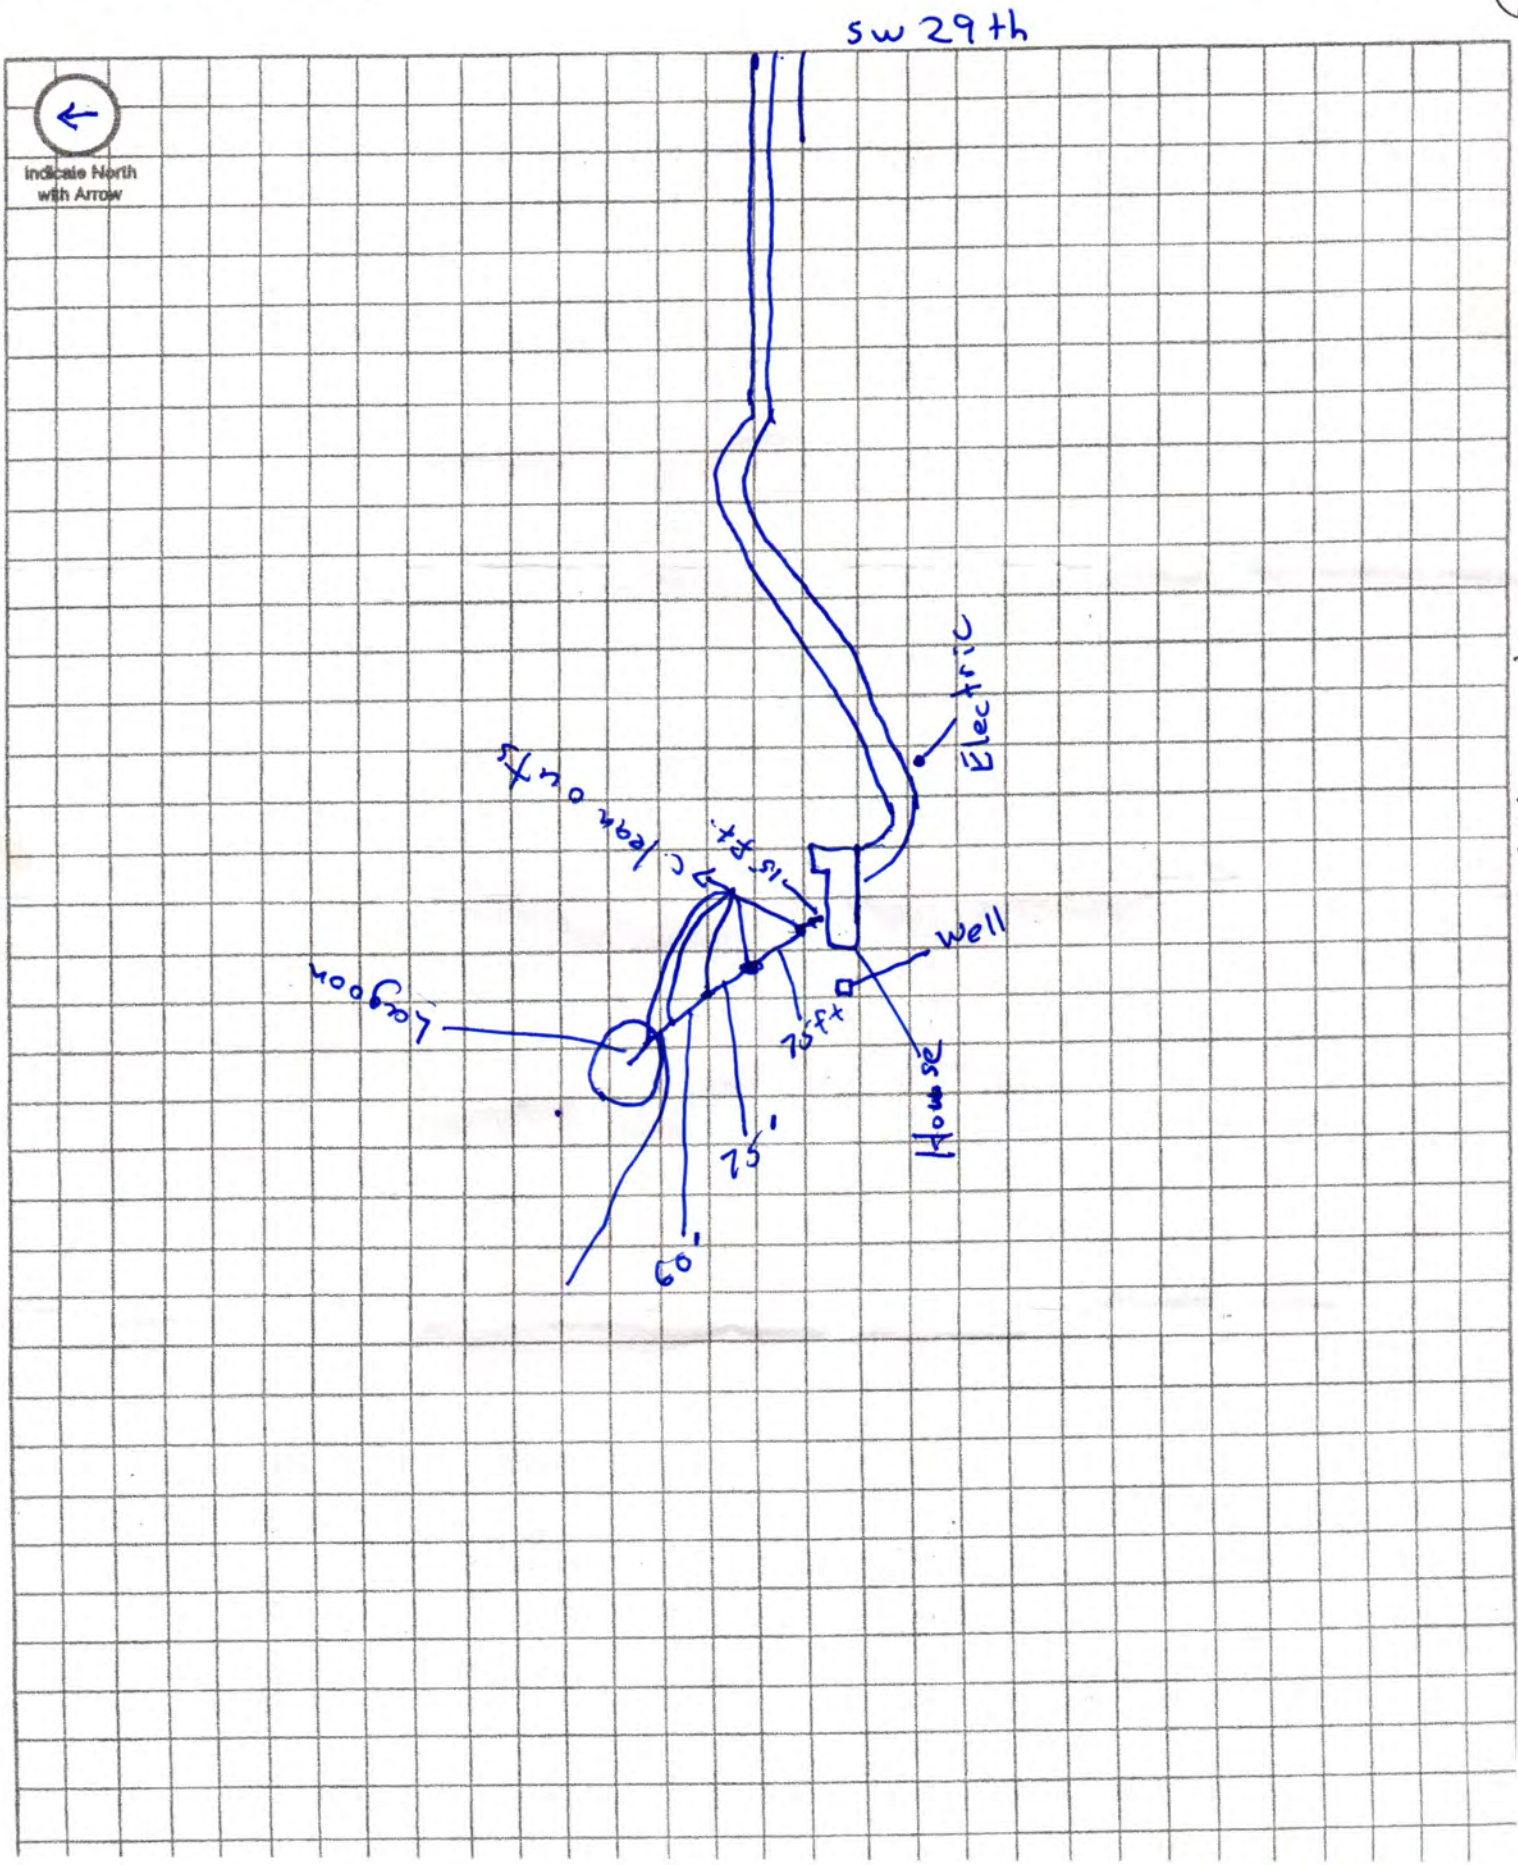

Hallam Rd.