# Lincoln-Lancaster County Health Department

ENVIRONMENTAL HEALTH DIVISION
3140 N STREET · LINCOLN, NE 68510-1514 (402) 441-8000

Permit

SEWAGE INSTALLATION
LAGOON

Establishment

JOHN DAUBER
T7N R7E SEC 15 QTR SE
S 1/2 OF SE 1/4 LOT 22IT
7600 PRINCETON RD-FIRTH

Permittee

JOHN DAUBER
546 CHESTNUT ST
HICKMAN NE 68372

Permit # 01380240501

Issued 11/27/01
Expires 05/27/02
Revenue Code 3157

FEES: $200.00

TOTAL: $200.00

Bruce D. Dart

Bruce D. Dart, Health Director

• POST IN A PROMINENT PLACE • NOT TRANSFERABLE

000274

NOV 2 7 2001

A

**Lincoln-Lancaster County Health Department**
Environmental Health Division
3140 "N" Street • Lincoln, NE 68510-1514
Phone: 402-441-8022

Permit Number: 013802405

# Sewage Disposal System

## Request for Site Clearance and Permit

**Include Form B, Form C and Applicable Fees with this Application.**

☐ Septic System ☑ Lagoon ☐ Other (Refer to Form C)

The undersigned hereby requests site clearance and permit to construct a Sewage Disposal System in conformance with appropriate resolution or ordinance, as described herein:

**PLEASE PRINT OR TYPE**

### A. System Location (Indicate correct number and street)

Address 7600 Princeton Road (no rural route) City Firth NE, Zip NE 68358

Legal Description S ½ SE ¼ 15 7N 7 East 6th PM — 1/4 1/4 Section Township Range Subdivision Addition Block Lot 22 I.T.

Geographical Location (if known): Longitude _____ Latitude _____

☑ Check if system mail address is not the same as the owner's address

### B. Owner

Name John Dauber Signature _____

Address 546 Chestnut City/State/Zip Hickman NE 68372

☐ Check if owner designed system Home Phone 402 792 3135 Work Phone 402 791 5333

### C. Contractor

Name Paul Meints Company Name Meints Construction

Address 2791 E Aspen RD City/State/Zip Cortland NE 68331

☐ Check if contractor designed system Work Phone 402 798 7607

### D. Engineer/Installer ☐ Check and complete if engineer designed system

Designer Name _____ Firm _____ Work Phone _____

### E. This System Will Serve a

☑ Residential Dwelling Number of Bedrooms 4 Is there a Whirlpool Bathtub (YES) NO

☐ Commercial Establishment/Other Facility Specify _____

Design flow in gallons per day _____ Type of Wastewater: ☑ Domestic ☐ Non-Domestic.

***DO NOT WRITE BELOW THIS LINE***

### Approval Process ☐ Municipal Code 24.38 ☒ County Resolution No. 2832

1. **Health Department** Date rec'd 11/27/01 Date frwd 11/29/01 ACTION ☒ Approved ☐ Disapproved Signature Jerrold C. Wood
2. **Supt. Bldg. Insp. or Village Clerk** Date rec'd 11/29/01 Date frwd 11/29/01 ACTION ☒ Approved ☐ Disapproved Signature _____
3. **City or County Engineer** Date rec'd 11-29-01 Date frwd 11-29-01 ACTION ☒ Approved ☐ Disapproved Signature _____

3/19/02 Need fences, signs, drawing, etc. J.C.H.

### Installation Final Written Approval

By Jerrold C. Wood R.E.H.S.

Date MAY 28, 2002

***Business Office Use Only***

Date Rec'd 11/29/01

Amt Paid 200.00

Rec'd By _____ Cash/Check No. 7401

FORM 23-100 10-96 White - Health Dept. Yellow - Engineer Pink - Bldg. Inspector

NOV 2 7 2001

B

Permit Number: 013802405

Lincoln-Lancaster County Health Department
Environmental Health Division
3140 "N" Street • Lincoln, NE 68510-1514
Phone: 402-441-8022

# Sewage Disposal System

## Soil Absorption Test Data Report

## Annex to Application

PLEASE PRINT OR TYPE

### System Location (Indicate correct number and street)

Address 7600 Princeton Road (no rural route) City Firth NE, Zip 68358

Owner John Dauber Addresss 546 Chestnut Hickman NE 68372

Soil Type (SCS): _____ Percolation Rate: _____ min./inch

Date of Tests _____ to _____ Weather: Precipitation _____ Temperature _____

## Percolation Test Data Table

| A. | B. | C. D. E. F. Pre-Saturation Period | | | | G. H. I. J. K. Percolation Readings | | | | | L. M. N. Results | | |
|---|---|---|---|---|---|---|---|---|---|---|---|---|---|
| | | Start | | End | | Start | | | End | | | | |
| Hole No. | Hole Depth (in) | Date (Mo/Da) | Time (Hr/Min) | Date (Mo/Da) | Time (Hr/Min) | Date (Mo/Da) | Time (Hr/Min) | Water Lev (in.) | Date (Mo/Da) | Time (Hr/Min) | Elapsed Time (Min) | Water Level Drop (in) | Percolation Rates (Min/in) |
| | | | | | | | | | | | | | |
| | | | | | | | | | | | | | |
### Person Conducting Percolation Tests

Name: _____

Phone: _____

Address _____

_____

Sum of Percolation Rates: _____

Average of Rates: _____

Rate Used for Calculation: _____

Lagoon System to be lined with Bentonite no perc test done

DO NOT WRITE BELOW THIS LINE

### Reviewing Action

Remarks _____

_____

_____

Signature of Reviewing Official _____ Date _____

FORM 23-101 10-96

NOV 2 7 2001

C

**Lincoln-Lancaster County Health Department**
Environmental Health Division
3140 "N" Street • Lincoln, NE 68510-1514
Phone: 402-441-8022

Permit Number: 013B02405

# Sewage Disposal System
## Preliminary Plan Specifications

Draw a plot plan showing system location, lines, distribution box, tank and laterals, percolation test hole locations, well, residence, compass direction and property lines. Indicate on drawing if residence and well are existing or proposed.




Approximate Scale: _____ ft. = _____ grid line/s

## A. System Location (Indicate correct number and street)

Address (no rural route) 7600 Princeton Road City Firth NE, Zip 68358

## B. Proposed Septic Tank/s

Tank Material: ☐ Concrete ☐ Plastic ☑ Other Lagoon

## C. Proposed Absorption System (See Form B for Percolation Information)

Percolation Rate _____ (min. per inch) Soil Type: _____ Land Slope: _____ %

Type of Absorption System: ☐ Trench ☐ Bed ☐ Other _____

Total Square Feet of Field Required: _____ sq. ft.

Type of Lateral: ☐ Half-Moon ☐ Perforated Pipe ☐ Other Lateral Material: _____

Capacity of Septic Tank _____ gals Number of Absorption Beds: _____ Number of Distribution Laterals per Bed _____

Total Length of Laterals _____ ft. Number of Trenches _____ Trench Width _____

## D. Setbacks Check the Boxes Below if the Required Setback has been Satisfied

| Distance From | Private Well | Public Well | Surface Water | Gound Water | Pressure Water Lines | Property Lines | Foundations Yours | Foundations Neighbors | All Other Setbacks |
|---|---|---|---|---|---|---|---|---|---|
| Tank (ft) | 50 ☐ | 500 ☐ | 50 ☐ | NA ☐ | 25 ☐ | 20 ☐ | 15 ☐ | 25 ☐ | ☐ |
| Field (ft) | 100 ☐ | 500 ☐ | 50 ☐ | 4 ☐ | 30 ☐ | 20 ☐ | 30 ☐ | 40 ☐ | ☐ |
| Lagoon (ft) | 100 ☑ | 500 ☑ | 50 ☑ | N/A ☐ | 30 ☑ | 50 ☑ | 100 ☑ | 200 ☑ | ☐ |

## E. Required Signatures

Home Building Contractor Paul Mentz Date 11-20-01

Installer _____ Date _____

FORM 23-102 10-96

MAY 2 0 2002

D

Lincoln-Lancaster County Health Department
Environmental Health Division
3140 "N" Street • Lincoln, NE 68510-1514
Phone: 402-441-8022

Permit Number: 013802405

# Sewage Disposal System

## As Built Plans & Specifications

Date MAY 17th 2002

**System Location (Indicate correct number and street)**

Address 7600 Princeton RD (no rural route) City Firth NE, Zip 68358

## A. Building Sewer

1. Material: PVC 1120 160 PSI
   Diameter: 4" in.
2. Distance above basement floor: - in.
   or distance below basement floor: 18 in.
3. Distance between dwelling and septic tank: 225 ft.
4. Number of clean-outs: 5
5. Distances to: well or suction line 325 ft.
   stream - ft.
   pressure line - ft.
   property line 310 ft.

## B. Septic Tank

1. Material: _____
   Number of compartments: _____
2. Capacity: _____ gal.
3. Factory built: ☐ Yes ☐ No
4. Manholes: Over inlet, diameter _____ in.
   Over outlet, diameter _____ in.
   Riser: ☐ above ☐ below grade _____ in.
5. Inlet: ☐ baffle ☐ tee
6. Outlet: ☐ baffle ☐ tee
7. Depth to top of tank, below unfinished grade: _____ in.
8. Distances to: Well or suction line _____ ft.
   Stream _____ ft.
   Pressure line _____ ft.
   Property line _____ ft.

## C. Distribution Box

1. Material: _____
   Number available outlets: _____
2. Factory built: ☐ Yes ☐ No
3. Distance from septic tank: _____ ft.

## D. Absorption Field


*(Provide as-built drawings on back of this form)*

1. Type: ☐ Half rounds ☐ Perforated pipe
   Diameter of half round: _____
   or perforated pipe: _____
   Material: ☐ fiberglass ☐ plastic ☐ concrete
   ☐ other _____
2. Lateral lines: Number _____
   Length of each line: _____ ft. _____ ft.
   _____ ft. _____ ft., _____ ft.
3. Trench dimensions: Width _____ ft.
   Slope _____ in/100 ft.
   Average depth _____ in
4. Filter material: _____
   Depth of material _____ in.
5. Distances to: Well or suction line _____ ft.
   Stream _____ ft.
   Pressure line _____ ft.
   Property line _____ ft.

Indicate North with Arrow


**Complete "As Built" drawing on back of this form.**

**Individual Sewage System Design (Example)**

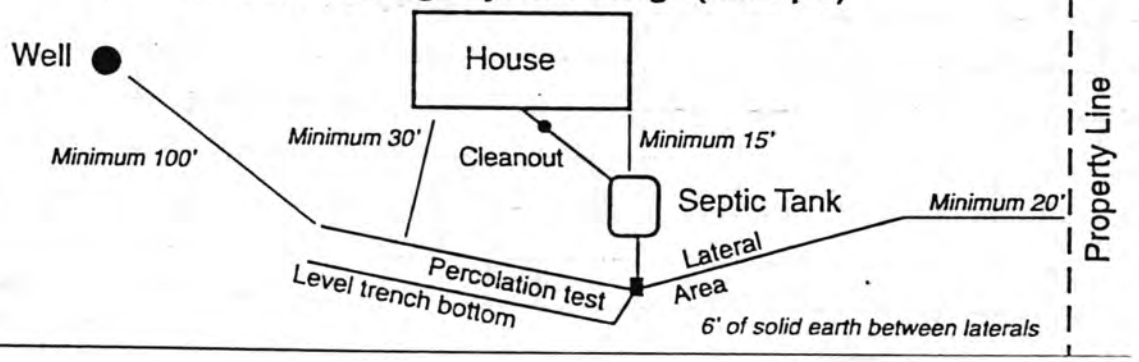


FORM 23-103 10-96

NOV 2 7 2001

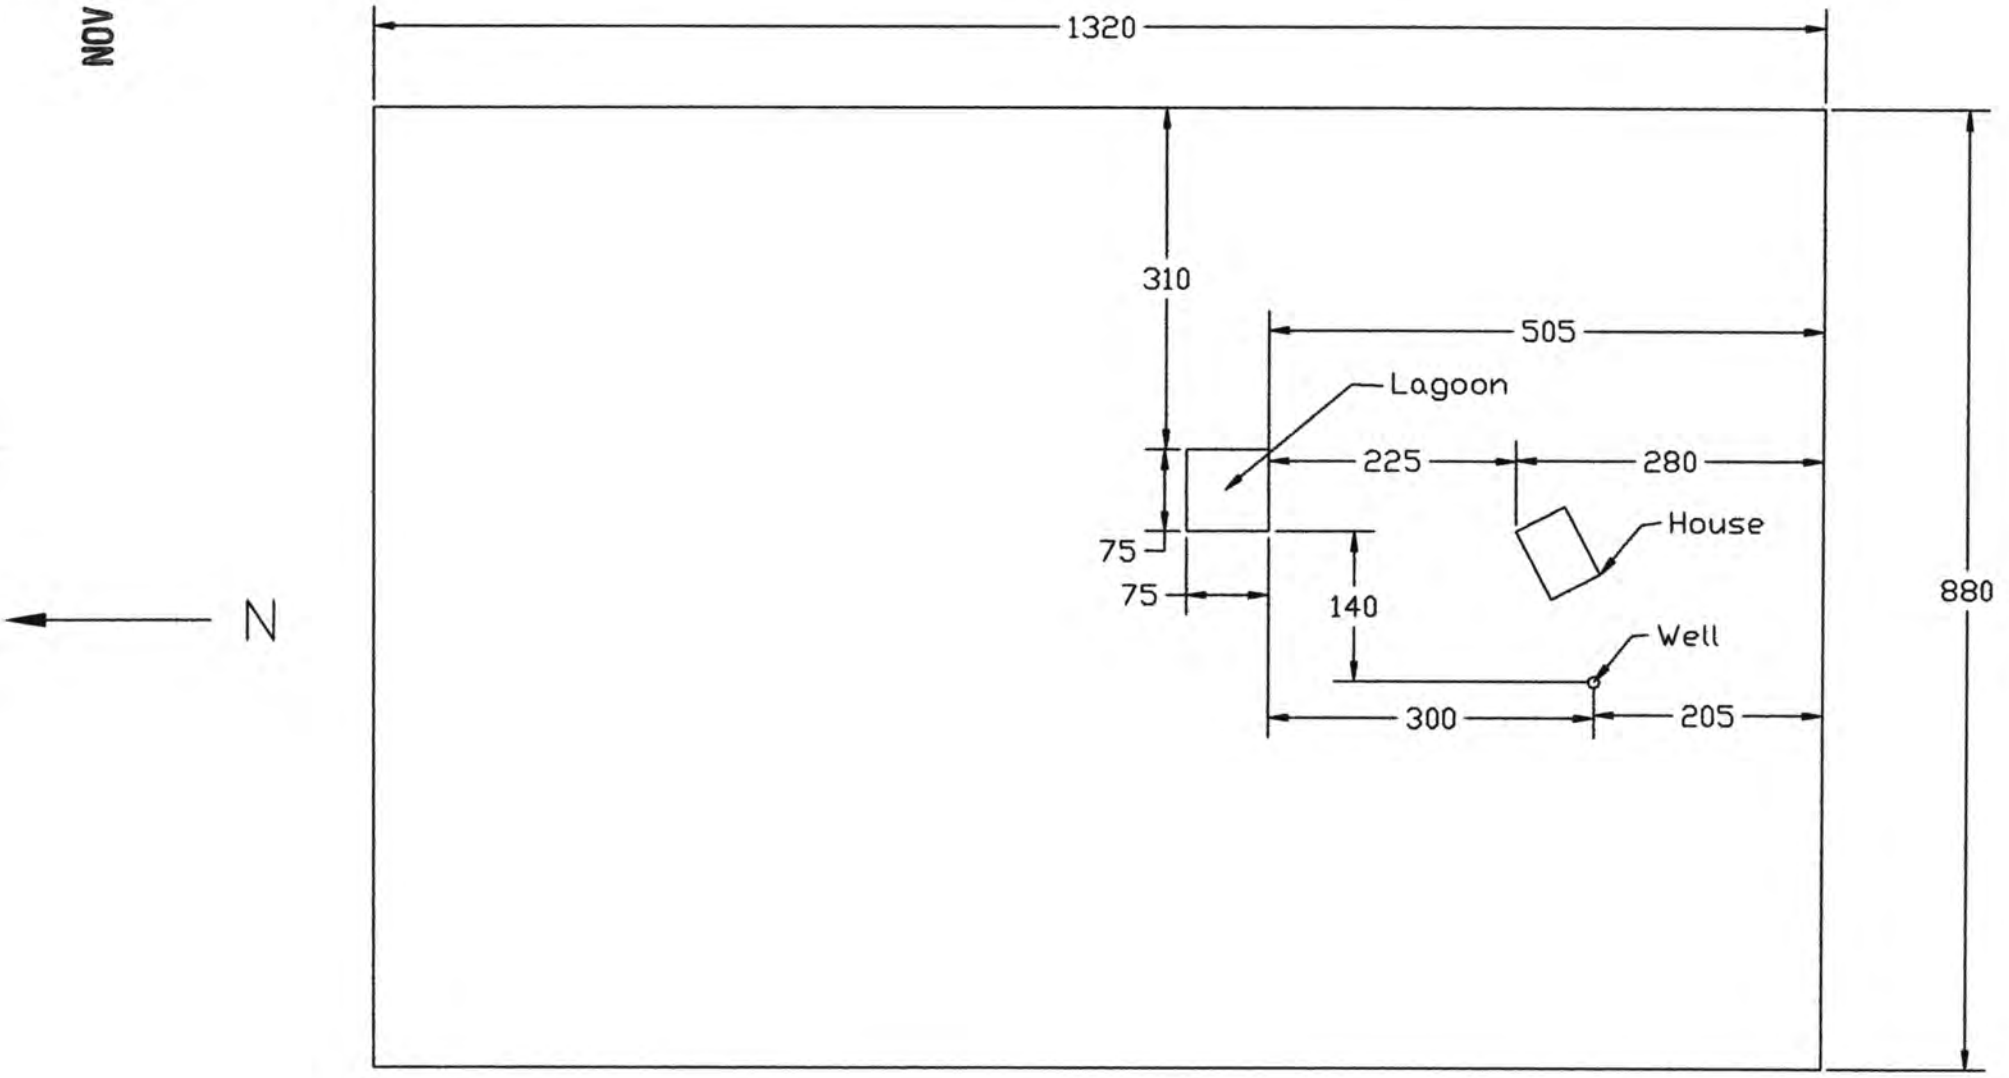


Property is aprox. 1320'x 880

1" = 180'

Princeton Road