LINCOLN-LANCASTER COUNTY HEALTH DEPARTMENT

3140 "N" STREET
NON TRANSFERABLE

ENVIRONMENTAL HEALTH DIVISION
Lincoln, NE 68510-1514
PERMIT

(402) 441-8000

Permit
SEWAGE INSTALLATION
LAGOON

No. 98380190501

Issued 12/04/98
Expires 06/04/99
Revenue Code 3157

FEES: $150.00

PAID

TOTAL $150.00

Establishment
EDWIN F WEYAND
T7N R7E SEC 17 QTR NW
24000 S 44 ST

Permittee
EDWIN F WEYAND
5601 S 73 ST
LINCOLN NE 68516-4320

Issued By Health Director
Lincoln-Lancaster County Health Department

008362

THIS LICENSE OR PERMIT IS ISSUED SUBJECT TO REVOCATION AS PROVIDED BY LAW "POST IN A PROMINENT PLACE"

Lincoln-Lancaster County Health Department
Environmental Health Division
3140 "N" Street • Lincoln, NE 68510-1514
Phone: 402-441-8022

A

Permit Number: 983801905

Sewage Disposal System

Request for Site Clearance and Permit

Include Form B, Form C and Applicable Fees with this Application.

☐ Septic System ☒ Lagoon ☐ Other (Refer to Form C)

The undersigned hereby requests site clearance and permit to construct a Sewage Disposal System in conformance with appropriate resolution or ordinance, as described herein:

PLEASE PRINT OR TYPE

A. System Location (Indicate correct number and street)

Address 24000 So 44th (no rural route) City LANCASTER County. NE, Zip

Legal Description NW1/4 17 7N 7E of the 6th P.M. 50 ACRES SEE ATTACHED
1/4 1/4 Section Township Range Subdivision Addition Block Lot

Geographical Location (if known): Longitude Latitude

☒ Check if system mail address is not the same as the owner's address

B. Owner

Name ED WEYAND Signature Edwin J. Weyand

Address 5601 So 73 City/State/Zip Lincoln NE

☐ Check if owner designed system Home Phone 483-6672 Work Phone 436-1074 (NORMA)

C. Contractor

Name JEFF MANN Company Name MANN CUSTOMS Inc.

Address 3121 So 6th Suite B City/State/Zip LINCOLN, NE, 68502.

☐ Check if contractor designed system Work Phone 423 5386

D. Engineer/Installer ☐ Check and complete if engineer designed system

Designer Name Firm Work Phone

E. This System Will Serve a

☒ Residential Dwelling Number of Bedrooms 3 Is there a Whirlpool Bathtub (YES) NO

☐ Commercial Establishment/Other Facility Specify

Design flow in gallons per day Type of Wastewater: ☒ Domestic ☐ Non-Domestic.

DO NOT WRITE BELOW THIS LINE

Approval Process ☐ Municipal Code 24.38 ☒ County Resolution No. 2832

1. **Health Department** Date rec'd 12/3/98 Date frwd 12/3/98 ACTION ☒ Approved ☐ Disapproved Signature Jerold C. Hood
2. **Supt. Bldg. Insp. or Village Clerk** Date rec'd 12.3.98 Date frwd 12.3.98 ACTION ☒ Approved ☐ Disapproved Signature TK
3. **City or County Engineer** Date rec'd 12-7-98 Date frwd 12-7-98 ACTION ☒ Approved ☐ Disapproved Signature

12-3-98 Line + clearances OK JN 12-15 APPD OK - NO FENCING

Installation Final Written Approval

By

Date 12/20/00

Business Office Use Only
Date Rec'd 12/03/98
Amt Paid 150 ck
Rec'd By LS Cash/Check No. 17119

FORM 23-100 10-96 White - Health Dept. Yellow - Engineer Pink - Bldg. Inspector


Lincoln-Lancaster County Health Department
Environmental Health Division
3140 "N" Street • Lincoln, NE 68510-1514
Phone: 402-441-8022

C

Permit Number: 98380 1905

Sewage Disposal System
Preliminary Plan Specifications

Draw a plot plan showing system location, lines, distribution box, tank and laterals, percolation test hole locations, well, residence, compass direction and property lines. Indicate on drawing if residence and well are existing or proposed.

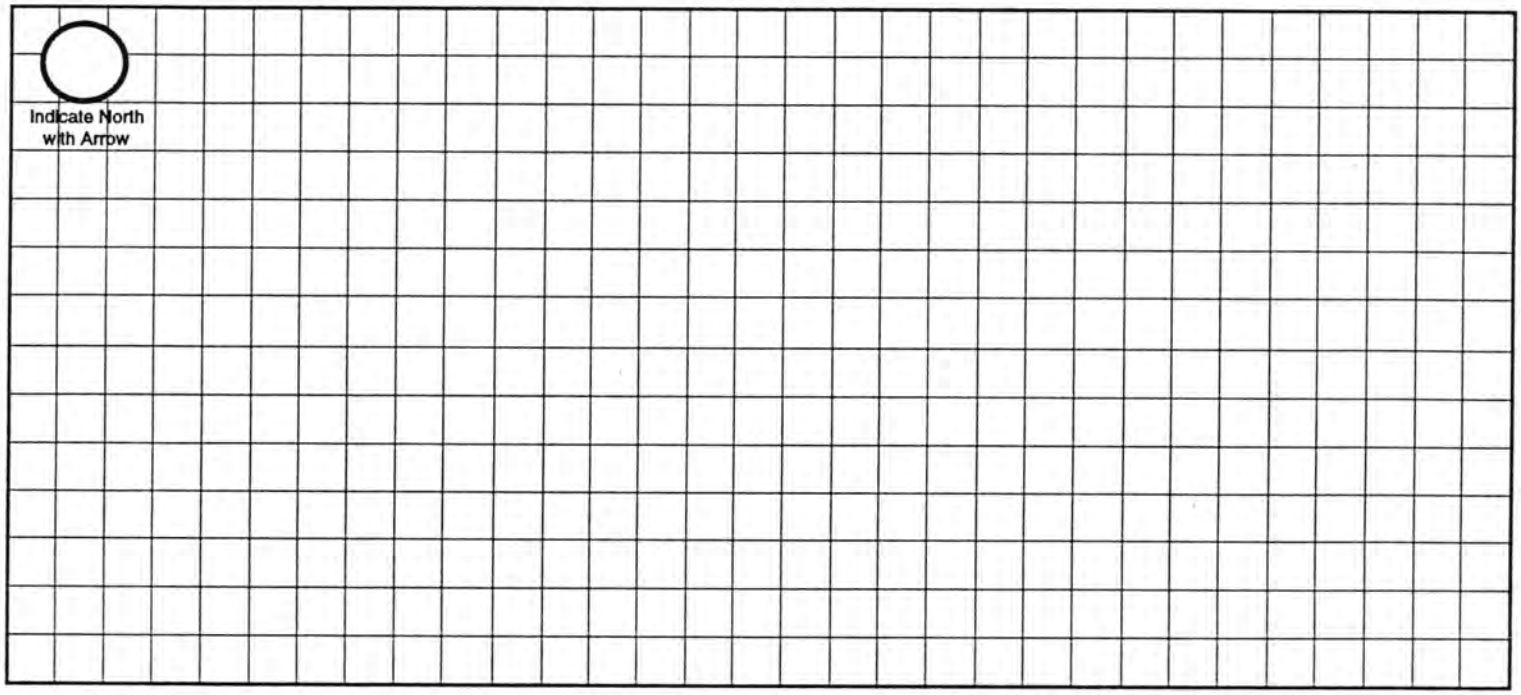

Approximate Scale: _____ ft. = _____ grid line/s

A. System Location (Indicate correct number and street)

Address (no rural route) 24000 So. 44 City _____ NE, Zip _____

B. ~~Proposed~~ Septic Tank/s

Tank Material: ☐ Concrete ☐ Plastic ☐ Other _____

C. Proposed Absorption System (See Form B for Percolation Information)

Percolation Rate _____ (min. per inch) Soil Type: _____ Land Slope: _____ %

Type of Absorption System: ☐ Trench ☐ Bed ☐ Other _____

Total Square Feet of Field Required: _____ sq. ft.

Type of Lateral: ☐ Half-Moon ☐ Perforated Pipe ☐ Other Lateral Material: _____

Capacity of Septic Tank _____ gals Number of Absorption Beds: _____ Number of Distribution Laterals per Bed _____

Total Length of Laterals _____ ft. Number of Trenches _____ Trench Width _____

D. Setbacks Check the Boxes Below if the Required Setback has been Satisfied

Distance From	Private Well	Public Well	Surface Water	Gound Water	Pressure Water Lines	Property Lines	Foundations Yours	Foundations Neighbors	All Other Setbacks
Tank (ft)	50 ☐	500 ☐	50 ☐	NA ☐	25 ☐	20 ☐	15 ☐	25 ☐	☐
Field (ft)	100 ☐	500 ☐	50 ☐	4 ☐	30 ☐	20 ☐	30 ☐	40 ☐	☐
Lagoon (ft)	100 ☒	500 ☒	50 ☒	N/A ☒	30 ☒	50 ☒	100 ☒	200 ☐	☒

E. Required Signatures

X Home Building Contractor _____ Date 12-2-98

Installer Larry Schwarck Date 12-1-98

FORM 23-102 10-96

Survey Record

PREPARED BY
L & S SURVEYING
R.R.1 BOX 254 CRETE, NE 68333
(402) 826-3876

N

SCALE: 1" = 400'


FIELD NOTES SECTION 17, T7N, R7E

SW Corner, NW¼-Found Aluminum Cap 4" below surface.

32.98' East to Iron Pipe.
31.37' West to top center of Iron Pipe.
45.66' SW to R.H. Nail in SE face of Corner Fence Post.

SE Corner, NW¼-Found Grey Stone.

3.3' SW to R.H. Nail in NW face of 12" Ash.
14.4' West to R.H. Nail in North face of Fence Post.
9.7' North to R.H. Nail in East face of Fence Post.

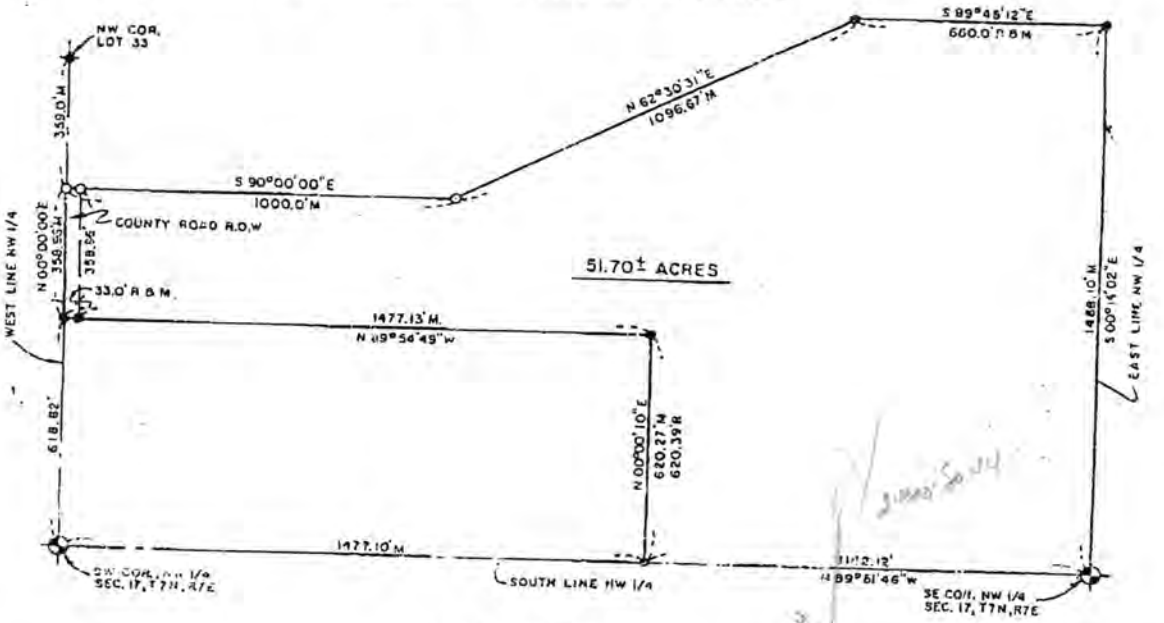

LEGAL DESCRIPTION

That portion of Lot 33 of Irregular Tracts located in the NW¼ of Section 17, T7N, R7E of the 6th P.M., Lancaster County, Nebraska, described as follows:

Beginning at the SW Corner of said Lot 33, said point being 618.82 feet north of the SW Corner of said NW¼; thence N00°00'00"E on the west line of said NW¼, 358.96 feet; thence on a new course of S90°00'00"E, 1000.0 feet; thence on a new course of N62°30'31"E, 1096.67 feet to a corner 660.0 feet west of the east line of said NW¼; thence on the existing boundary lines of said Lot 33 on the following described courses; thence S89°48'12"E parallel with the north line of said NW¼, 660.0 feet to the east line of said NW¼, said point being 1150.0 feet south of the NE Corner of said NW¼; thence S00°14'02"E on the east line of said NW¼, 1488.10 feet to the SE Corner of said NW¼; thence N89°51'46"W on the south line of said NW¼, 1162.12 feet; thence N00°00'10"E, 620.27 feet; thence N89°54'49"W, 1477.13 feet to the point of beginning. Containing 51.70 acres, more or less.


NEBRASKA REGISTERED LS-469 LAND SURVEYOR LESLIE J. SIEDSCHLAG

SURVEYOR'S CERTIFICATE

I, Leslie J. Siedschlag, a Registered Land Surveyor in the State of Nebraska, hereby certify that this survey was made under my direct supervision on November 1, 1995 and that all dimensions shown are in feet and decimals of a foot and are correct to the best of my knowledge and belief.

Leslie J. Siedschlag, Nebraska L.S. No. 469

LEGEND
- Corners Found
- Corners Found
- Corners Set (⅝" Iron Bar)
- Temporary Point
- Recorded Distance

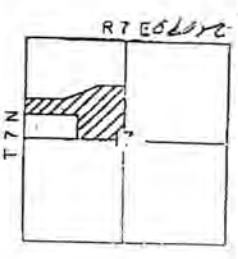

DRAWN BY: Dick DATE: 11-1-95

DEC 2 1 1998

D

Lincoln-Lancaster County Health Department
Environmental Health Division
3140 "N" Street • Lincoln, NE 68510-1514
Phone: 402-441-8022

Permit Number:

Sewage Disposal System

As Built Plans & Specifications

Date 12-4-98

System Location (Indicate correct number and street)

Address 24000 So 44th (no rural route) City Lincoln NE, Zip

A. Building Sewer

1. Material: class 160
   Diameter: _____ in.
2. Distance above basement floor: _____ in.
   or distance below basement floor: 16 in.
3. Distance between dwelling and septic tank: 412 ft.
4. Number of clean-outs: 5
5. Distances to: well or suction line _____ ft.
   stream _____ ft.
   pressure line _____ ft.
   property line _____ ft.

B. ~~Septic Tank~~ Lagoon

1. Material: _____
   Number of compartments: _____
2. Capacity: _____ gal.
3. Factory built: ☐ Yes ☐ No
4. Manholes: Over inlet, diameter _____ in.
   Over outlet, diameter _____ in.
   Riser: ☐ above ☐ below grade _____ in.
5. Inlet: ☐ baffle ☐ tee
6. Outlet: ☐ baffle ☐ tee
7. Depth to top of tank, below unfinished grade: _____ in.
8. Distances to: Well or suction line _____ ft.
   Stream _____ ft.
   Pressure line _____ ft.
   Property line _____ ft.

C. Distribution Box

1. Material: _____
   Number available outlets: _____
2. Factory built: ☐ Yes ☐ No
3. Distance from septic tank: _____ ft.

D. Absorption Field


(Provide as-built drawings on back of this form)

1. Type: ☐ Half rounds ☐ Perforated pipe
   Diameter of half round: _____
   or perforated pipe: _____
   Material: ☐ fiberglass ☐ plastic ☐ concrete
   ☐ other _____
2. Lateral lines: Number _____
   Length of each line: _____ ft. _____ ft.
   _____ ft. _____ ft., _____ ft.
3. Trench dimensions: Width _____ ft.
   Slope _____ in/100 ft.
   Average depth _____ in
4. Filter material: _____
   Depth of material _____ in.
5. Distances to: Well or suction line _____ ft.
   Stream _____ ft.
   Pressure line _____ ft.
   Property line _____ ft.

Complete "As Built" drawing on back of this form.


Indicate North with Arrow

Individual Sewage System Design (Example)

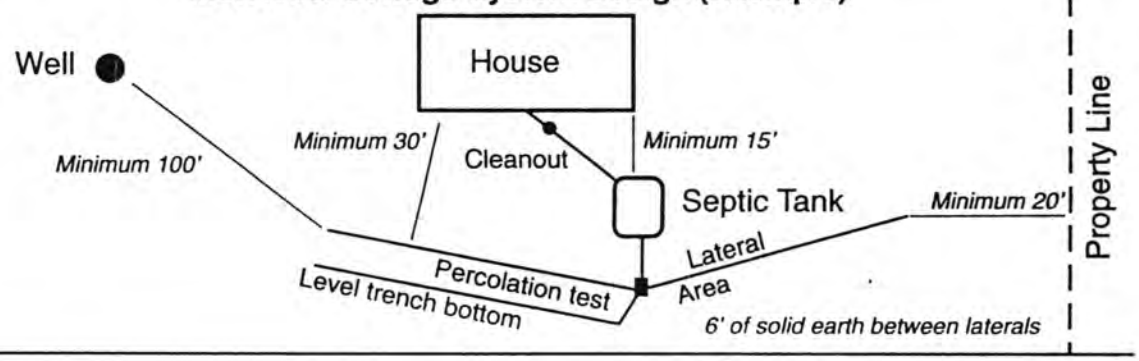


FORM 23-103 10-96

As Built Drawing by Larry Schwaeke for Mann Customs

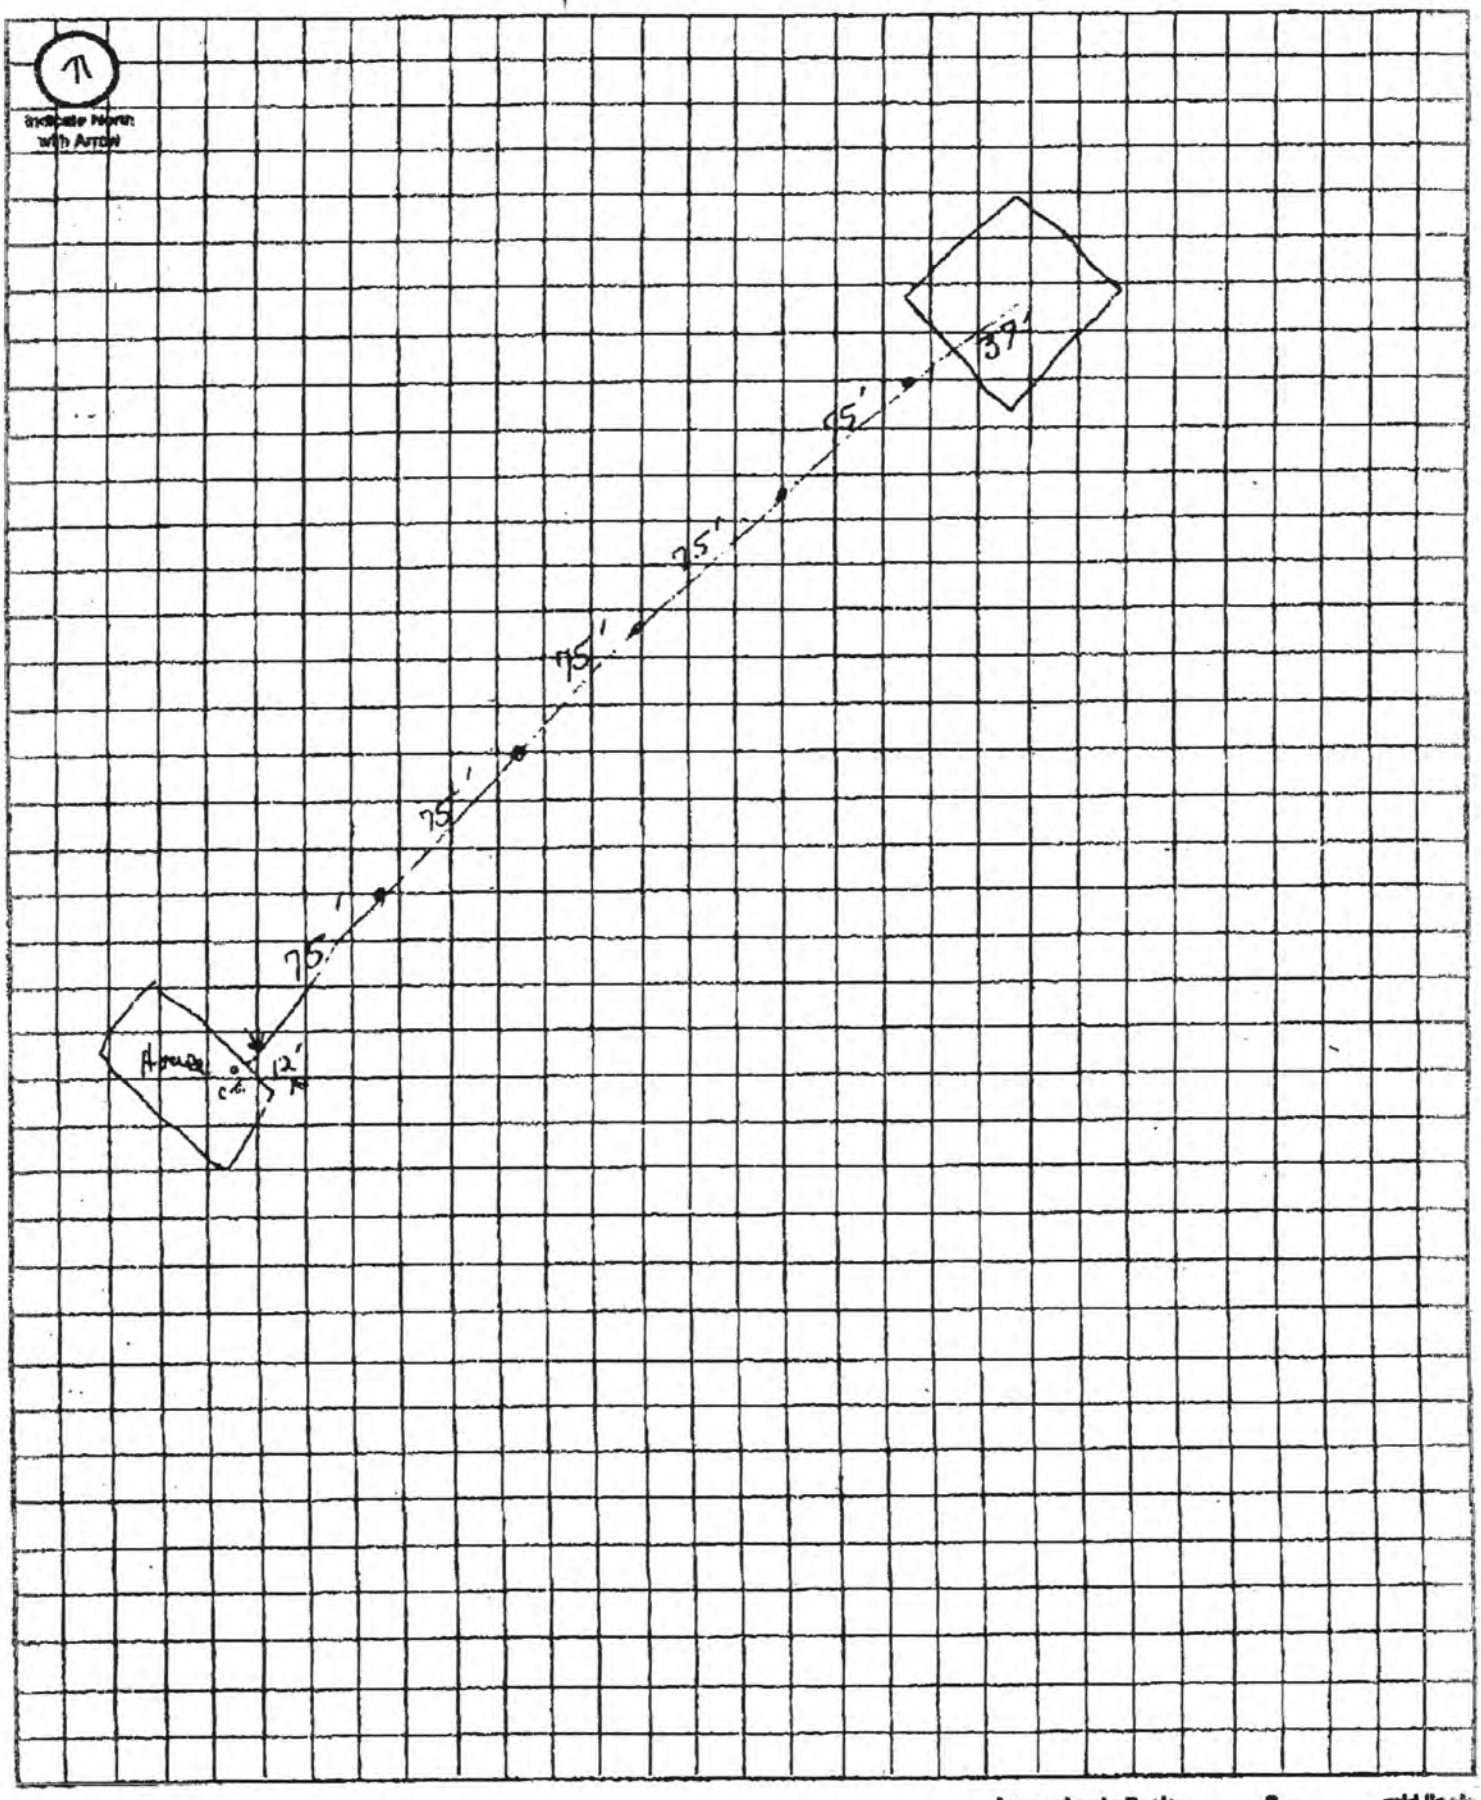

Approximate Scale: _____ ft. = _____ grid lines

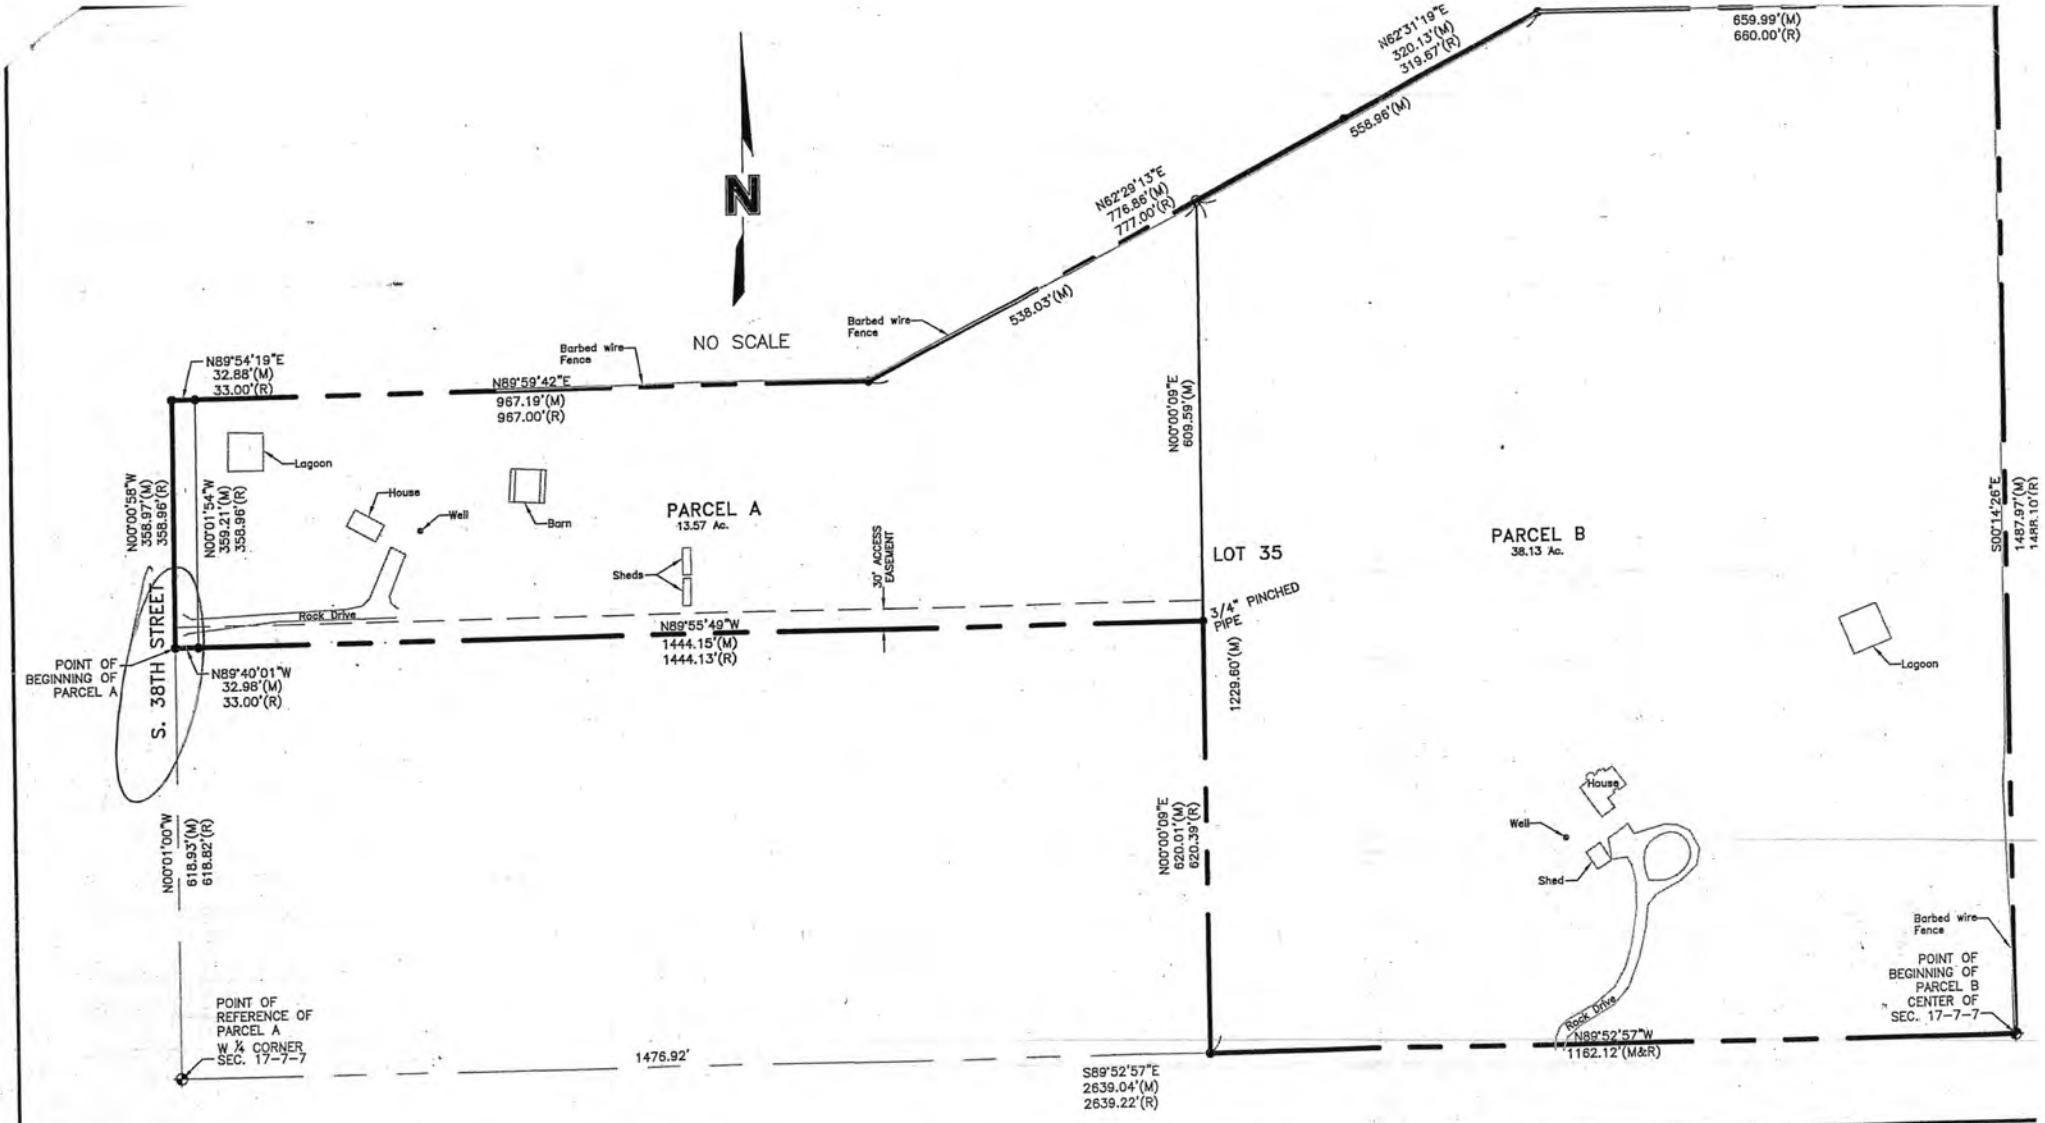

EDC
Engineering Design Consultants
Civil Design ▪ Land Planning
Site Development ▪ Surveying
2200 Fletcher Ave. Suite 102, Lincoln NE 68521
402-438-4014 ▪ Fax 402-438-4026
4650 S. 132nd St. Omaha, NE 68137
402-614-0434 ▪ Fax 402-614-6508

LOT 35, NW 1/4 SEC. 17, T7N, R7E

EXISTING CONDITIONS SURVEY

LANCASTER COUNTY, NEBRASKA

Drawn By: NLP
Dwg.: boundary
Date: 10/06/04

SHEET
1 OF 1