# Lincoln-Lancaster County Health Department

ENVIRONMENTAL HEALTH DIVISION

3140 N STREET · LINCOLN, NE 68510-1514 (402) 441-8000

Permit
SEWAGE INSTALLATION
LAGOON

Permit # 02380254601

Issued 10/11/02
Expires 04/11/03
Revenue Code 3157

Establishment
RICK & CHRISTY SUEVERKRUEPP
T7N R7E SEC 23
IRONHORSE ACRES-1ST LOT 8
IRONHORSE ACRES-LOT 8

FEES: $200.00

Permittee
RICK & CHRISTY SUEVERKRUEPP
2701 S 35 ST
LINCOLN NE 68506

TOTAL: $200.00

Bruce D. Dart

Bruce D. Dart, Health Director

• POST IN A PROMINENT PLACE • NOT TRANSFERABLE

003010

**Lincoln-Lancaster County Health Department**
Environmental Health Division
3140 "N" Street • Lincoln, NE 68510-1514
Phone: 402-441-8022

**A**

Permit Number: 023802546 01

# Sewage Disposal System

## Request for Site Clearance and Permit

**Include Form B, Form C and Applicable Fees with this Application.**

☐ Septic System ☑ Lagoon ☐ Other (Refer to Form C)

The undersigned hereby requests site clearance and permit to construct a Sewage Disposal System in conformance with appropriate resolution or ordinance, as described herein:

**PLEASE PRINT OR TYPE**

### A. System Location (Indicate correct number and street)

Address 23959 IRONHORSE COURT (IRONHORSE ACRES Lot 8) City FIRTH NE, Zip 68358
(no rural route)

Legal Description 23 7N 7E IRONHORSE ACRES 8
1/4 1/4 Section Township Range Subdivision Addition Block Lot

Geographical Location (if known): Longitude _____ Latitude _____

☑ Check if system mail address is not the same as the owner's address

### B. Owner

Name Rick & Christy Sueverkruepp Signature Rick Christy Sueverkruepp

Address 2701 S. 35th St. City/State/Zip Lincoln, NE.

☐ Check if owner designed system Home Phone 484-8489 Work Phone _____

### C. Contractor

Name LEONARD HARPER Company Name HARPER WELL & PLUMBING INC

Address 220 7th St City/State/Zip P.O Box 15 Adams NE 68301

☐ Check if contractor designed system Work Phone 402-432-2204

### D. Engineer/Installer ☐ Check and complete if engineer designed system

Designer Name _____ Firm _____ Work Phone _____

### E. This System Will Serve a

☑ Residential Dwelling Number of Bedrooms 3 Is there a Whirlpool Bathtub YES (NO)

☐ Commercial Establishment/Other Facility Specify _____

Design flow in gallons per day _____ Type of Wastewater: ☑ Domestic ☐ Non-Domestic.

***DO NOT WRITE BELOW THIS LINE***

### Approval Process ☐ Municipal Code 24.38 ☒ County Resolution No. 2832

1. **Health Department** Date rec'd 10/11/02 Date frwd 10/11/02 ACTION ☒ Approved ☐ Disapproved Signature Gerrold C. Hood
2. **Supt. Bldg. Insp. or Village Clerk** Date rec'd 10/11/02 Date frwd 10/11/02 ACTION ☒ Approved ☐ Disapproved Signature _____
3. **City or County Engineer** Date rec'd 10/11/02 Date frwd 10/11/02 ACTION ☒ Approved ☐ Disapproved Signature _____

8/25/03 3/13/03 ~~Need Drawing, forms, etc.~~ J.G.H.

### Installation Final Written Approval

By Gerrold C. Hood R.E.H.S.

Date FEBRUARY 10, 2004

***Business Office Use Only***

Date Rec'd 10/11/02
Amt Paid 200.00
Rec'd By _____ ~~Cash~~/Check No. 2651

FORM 23-100 10-96 White - Health Dept. Yellow - Engineer Pink - Bldg. Inspector

Lincoln-Lancaster County Health Department
Environmental Health Division
3140 "N" Street • Lincoln, NE 68510-1514
Phone: 402-441-8022

**B**

Permit Number: 023802546

# Sewage Disposal System

## Soil Absorption Test Data Report

## Annex to Application

PLEASE PRINT OR TYPE

### System Location (Indicate correct number and street)

Address Iron Horse Acres Lot 8 (no rural route) City Firth NE, Zip 68358

Owner _____ Addresss _____

Soil Type (SCS): _____ Percolation Rate: _____ min./inch

Date of Tests _____ to _____ Weather: Precipitation _____ Temperature _____

## Percolation Test Data Table

| A. | B. | C. D. E. F. Pre-Saturation Period | | | | G. H. I. J. K. Percolation Readings | | | | | L. M. N. Results | | |
|---|---|---|---|---|---|---|---|---|---|---|---|---|---|
| | | Start | | End | | Start | | | End | | | | |
| Hole No. | Hole Depth (in) | Date (Mo/Da) | Time (Hr/Min) | Date (Mo/Da) | Time (Hr/Min) | Date (Mo/Da) | Time (Hr/Min) | Water Lev (in.) | Date (Mo/Da) | Time (Hr/Min) | Elapsed Time (Min) | Water Level Drop (in) | Percolation Rates (Min/in) |
| | | | | | | | | | | | | | |
| | | | | | | | | | | | | | |
| | | Will Put Bentonite In Bottom of Lagoon | | | | | | | | | | | |
| | | | | | | | | | | | | | |
| | | | | | | | | | | | | | |
### Person Conducting Percolation Tests

Name: _____

Phone: _____

Address _____

_____

Sum of Percolation Rates: _____

Average of Rates: _____

Rate Used for Calculation: _____

DO NOT WRITE BELOW THIS LINE

### Reviewing Action

Remarks _____

_____

_____

Signature of Reviewing Official _____ Date _____

FORM 23-101 10-96


**Lincoln-Lancaster County Health Department**
Environmental Health Division
3140 "N" Street • Lincoln, NE 68510-1514
Phone: 402-441-8022

**C**

Permit Number: 023802546

# Sewage Disposal System
## Preliminary Plan Specifications

Draw a plot plan showing system location, lines, distribution box, tank and laterals, percolation test hole locations, well, residence, compass direction and property lines. Indicate on drawing if residence and well are existing or proposed.

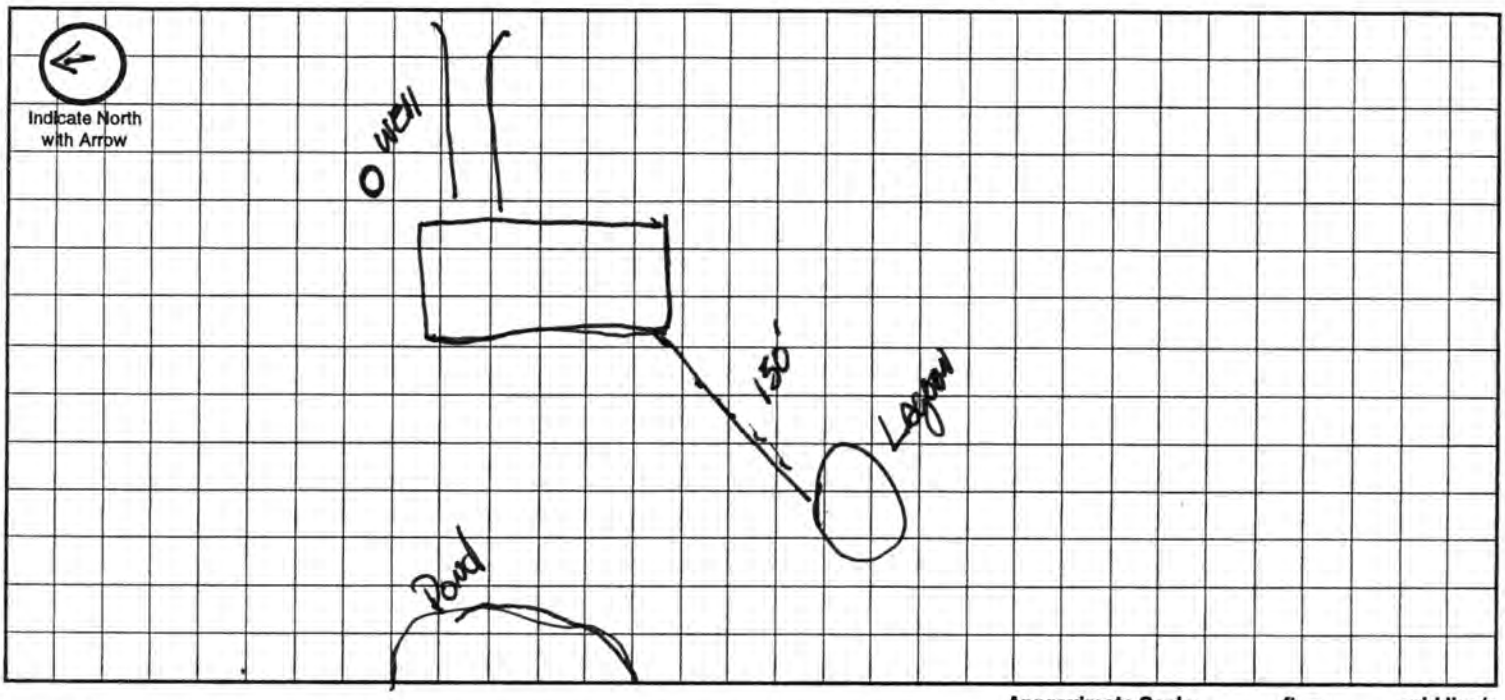


**Approximate Scale:** _____ ft. = _____ grid line/s

## A. System Location (Indicate correct number and street)

Address (no rural route) 1800 Horse Acres Lot 8 City Firth NE, Zip 68358

## B. Proposed Septic Tank/s

Tank Material: ☐ Concrete ☐ Plastic ☐ Other _____

## C. Proposed Absorption System (See Form B for Percolation Information)

Percolation Rate _____ (min. per inch) Soil Type: _____ Land Slope: _____ %

Type of Absorption System: ☐ Trench ☐ Bed ☐ Other _____

Total Square Feet of Field Required: _____ sq. ft.

Type of Lateral: ☐ Half-Moon ☐ Perforated Pipe ☐ Other Lateral Material: _____

Capacity of Septic Tank _____ gals Number of Absorption Beds: _____ Number of Distribution Laterals per Bed _____

Total Length of Laterals _____ ft. Number of Trenches _____ Trench Width _____

## D. Setbacks Check the Boxes Below if the Required Setback has been Satisfied

| Distance From | Private Well | Public Well | Surface Water | Gound Water | Pressure Water Lines | Property Lines | Foundations Yours | Foundations Neighbors | All Other Setbacks |
|---|---|---|---|---|---|---|---|---|---|
| Tank (ft) | 50 ☐ | 500 ☐ | 50 ☐ | NA ☐ | 25 ☐ | 20 ☐ | 15 ☐ | 25 ☐ | ☐ |
| Field (ft) | 100 ☐ | 500 ☐ | 50 ☐ | 4 ☐ | 30 ☐ | 20 ☐ | 30 ☐ | 40 ☐ | ☐ |
| Lagoon (ft) | 100 ☐ | 500 ☐ | 50 ☐ | N/A ☐ | 30 ☐ | 50 ☐ | 100 ☐ | 200 ☐ | ☐ |

## E. Required Signatures

Home Building Contractor R&D Custom Homes Donna Youngerd Date 10-1-02

Installer Hayden Well & Plumbing Inc Date 10/11/02

FORM 23-102 10-96

Lincoln-Lancaster County Health Department
Environmental Health Division
3140 "N" Street • Lincoln, NE 68510-1514
Phone: 402-441-8022

**D**

Permit Number:

# Sewage Disposal System

## As Built Plans & Specifications

Date _____

**System Location (Indicate correct number and street)**

Address IRON HORSE (no rural route) City Firth NE, Zip 68358

## A. Building Sewer

1. Material: PVC
   Diameter: 4" in.
2. Distance ~~above~~ basement floor: [redacted] in.
   or distance below basement floor: 2 FT in.
3. Distance between dwelling and septic tank: _____ ft.
4. Number of clean-outs: _____
5. Distances to: well or suction line 100' ft.
   stream _____ ft.
   pressure line _____ ft.
   property line _____ ft.

## B. Septic Tank

1. Material: _____
   Number of compartments: _____
2. Capacity: _____ gal.
3. Factory built: ☐ Yes ☐ No
4. Manholes: Over inlet, diameter _____ in.
   Over outlet, diameter _____ in.
   Riser: ☐ above ☐ below grade _____ in.
5. Inlet: ☐ baffle ☐ tee
6. Outlet: ☐ baffle ☐ tee
7. Depth to top of tank, below unfinished grade: _____ in.
8. Distances to: Well or suction line _____ ft.
   Stream _____ ft.
   Pressure line _____ ft.
   Property line _____ ft.

## C. Distribution Box

1. Material: _____
   Number available outlets: _____
2. Factory built: ☐ Yes ☐ No
3. Distance from septic tank: _____ ft.

## D. Absorption Field


*(Provide as-built drawings on back of this form)*

1. Type: ☐ Half rounds ☐ Perforated pipe
   Diameter of half round: _____
   or perforated pipe: _____
   Material: ☐ fiberglass ☐ plastic ☐ concrete
   ☐ other _____
2. Lateral lines: Number _____
   Length of each line: _____ ft. _____ ft.
   _____ ft. _____ ft., _____ ft.
3. Trench dimensions: Width _____ ft.
   Slope _____ in/100 ft.
   Average depth _____ in
4. Filter material: _____
   Depth of material _____ in.
5. Distances to: Well or suction line _____ ft.
   Stream _____ ft.
   Pressure line _____ ft.
   Property line _____ ft.

**Complete "As Built" drawing on back of this form.**

Indicate North with Arrow

### Individual Sewage System Design (Example)

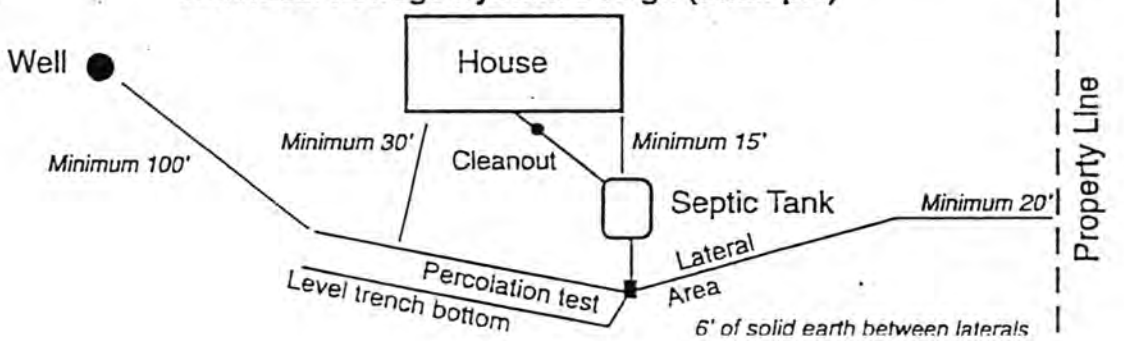

Lincoln-Lancaster County Health Department
Environmental Health Division
3140 "N" Street • Lincoln, NE 68510-1514
Phone: 402-441-8022

**D**

Permit Number:

# Sewage Disposal System

## As Built Plans & Specifications

Date 9/17/03

**System Location (Indicate correct number and street)**

Address Iron Horse (no rural route) City Firth NE, Zip

## A. Building Sewer

1. Material: PVC
   Diameter: 4" in.
2. Distance above basement floor: _____ in.
   or distance below basement floor: 12 in.
3. Distance between dwelling and septic tank: _____ ft.
4. Number of clean-outs: 4
5. Distances to: well or suction line 300 ft.
   stream _____ ft.
   pressure line _____ ft.
   property line _____ ft.

## B. Septic Tank

1. Material: _____
   Number of compartments: _____
2. Capacity: _____ gal.
3. Factory built: ☐ Yes ☐ No
4. Manholes: Over inlet, diameter _____ in.
   Over outlet, diameter _____ in.
   Riser: ☐ above ☐ below grade _____ in.
5. Inlet: ☐ baffle ☐ tee
6. Outlet: ☐ baffle ☐ tee
7. Depth to top of tank, below unfinished grade: _____ in.
8. Distances to: Well or suction line _____ ft.
   Stream _____ ft.
   Pressure line _____ ft.
   Property line _____ ft.

## C. Distribution Box

1. Material: _____
   Number available outlets: _____
2. Factory built: ☐ Yes ☐ No
3. Distance from septic tank: _____ ft.

## D. Absorption Field


*(Provide as-built drawings on back of this form)*

1. Type: ☐ Half rounds ☐ Perforated pipe
   Diameter of half round: _____
   or perforated pipe: _____
   Material: ☐ fiberglass ☐ plastic ☐ concrete
   ☐ other _____
2. Lateral lines: Number _____
   Length of each line: _____ ft. _____ ft.
   _____ ft. _____ ft., _____ ft.
3. Trench dimensions: Width _____ ft.
   Slope _____ in/100 ft.
   Average depth _____ in
4. Filter material: _____
   Depth of material _____ in.
5. Distances to: Well or suction line _____ ft.
   Stream _____ ft.
   Pressure line _____ ft.
   Property line _____ ft.

**Complete "As Built" drawing on back of this form.**


Indicate North with Arrow

### Individual Sewage System Design (Example)

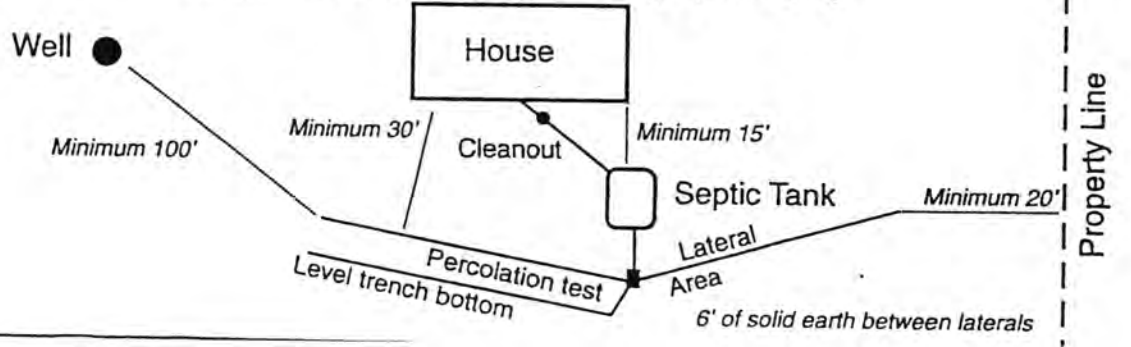


FORM 23-103 10-96

# As Built Drawing

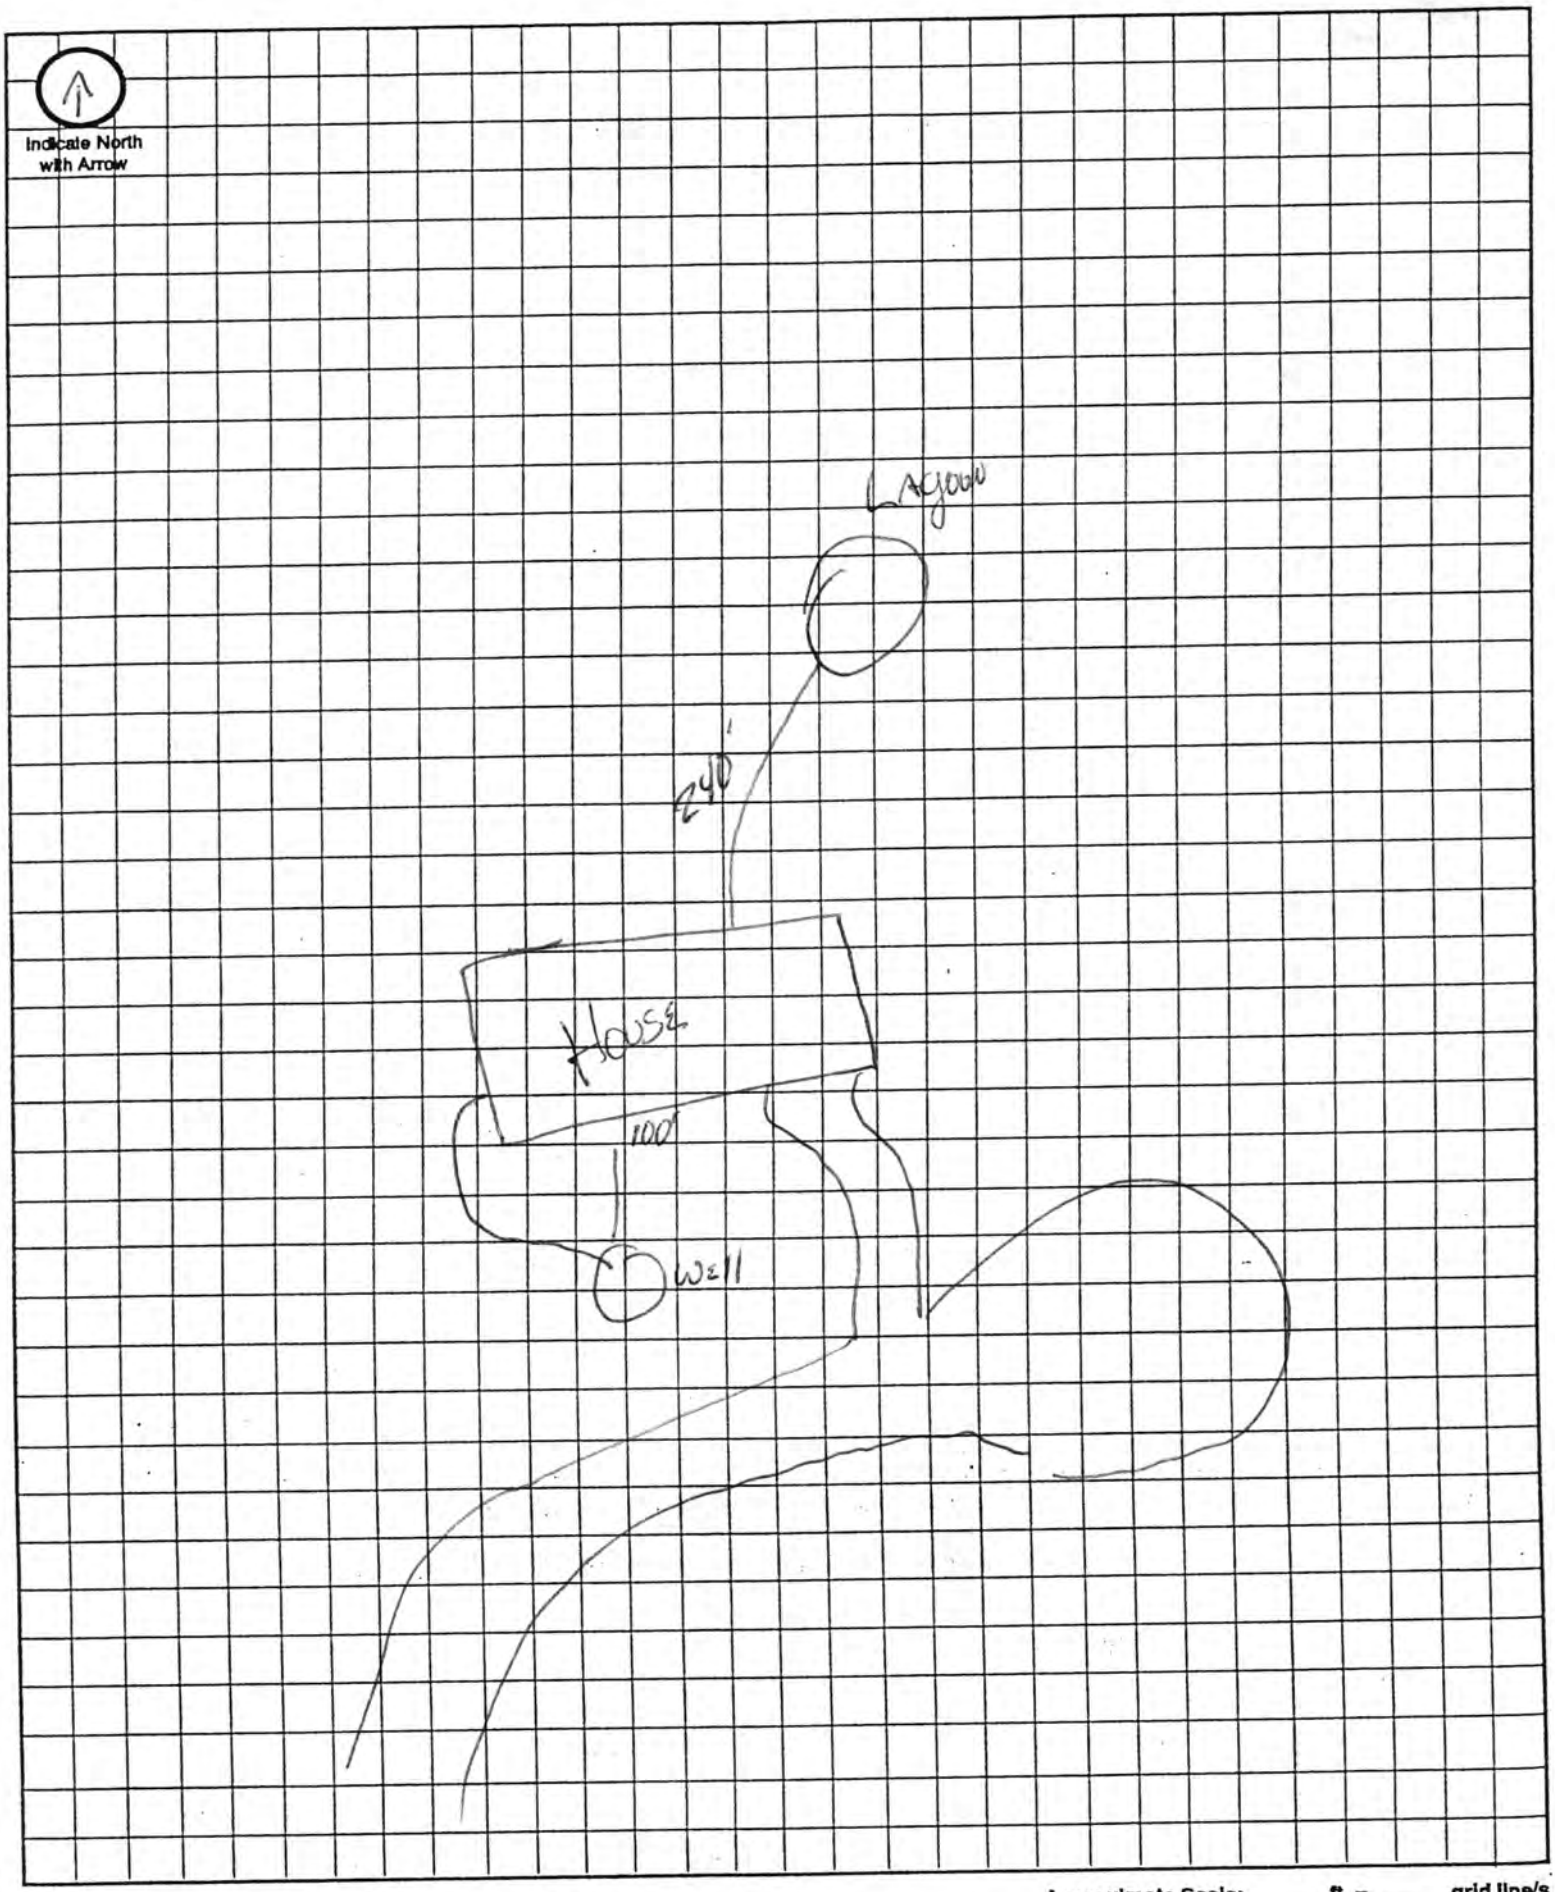


Approximate Scale: _____ ft. = _____ grid line/s