Lincoln-Lancaster County Health Department

ENVIRONMENTAL PUBLIC HEALTH DIVISION

3140 N STREET · LINCOLN, NE 68510-1514

002872

(402) 441-8000

Permit SEWAGE INSTALLATION
LAGOON

Permit # 03380267601

Issued 07/20/03
Expires 01/20/04
Revenue Code 3157

Establishment ANDERSON HOMES INC
T7N R7E SEC 26
HILLTOP ESTS BLK 2 LOT 2
8240 CARLSON CT-FIRTH

FEES: $200.00

Permittee ANDERSON HOMES INC
BOX 30842
LINCOLN NE 68503

TOTAL: $200.00

Bruce D. Dart

Bruce D. Dart, Health Director

EPH COPY

Lincoln-Lancaster County Health Department
Environmental Health Division
3140 "N" Street • Lincoln, NE 68510-1514
Phone: 402-441-8022

AUG 0 4 2003

A

Permit Number: 033802674

Sewage Disposal System

Request for Site Clearance and Permit

Include Form B, Form C and Applicable Fees with this Application.

☐ Septic System ☒ Lagoon ☐ Other (Refer to Form C)

The undersigned hereby requests site clearance and permit to construct a Sewage Disposal System in conformance with appropriate resolution or ordinance, as described herein:

PLEASE PRINT OR TYPE

A. System Location (Indicate correct number and street)

Address 8240 CARLSON CT. City FIRTH NE, Zip NEBR.

Legal Description NW¼ (no rural route) 26-7-7 LOT 2, BLOCK 2, HILLTOP ESTATES 2 2
1/4 1/4 Section Township Range Subdivision Addition Block Lot

Geographical Location (if known): Longitude _____ Latitude _____

☒ Check if system mail address is not the same as the owner's address

B. Owner

Name ANDERSON HOMES, Inc Signature Scott Anderson

Address BOX 30842 City/State/Zip LINCOLN NE 68503

☐ Check if owner designed system Home Phone 432-0415 Work Phone 432-0415

C. Contractor

Name JOHNS PLUMBING CO. Company Name _____

Address 1730 S. 6TH ST. City/State/Zip LINCOLN NE

☐ Check if contractor designed system Work Phone 475-2599

D. Engineer/Installer ☐ Check and complete if engineer designed system

Designer Name _____ Firm _____ Work Phone _____

E. This System Will Serve a

☒ Residential Dwelling Number of Bedrooms 3 Is there a Whirlpool Bathtub YES (NO)

☐ Commercial Establishment/Other Facility Specify _____

Design flow in gallons per day _____ Type of Wastewater: ☒ Domestic ☐ Non-Domestic.

DO NOT WRITE BELOW THIS LINE

Approval Process ☐ Municipal Code 24.38 ☒ County Resolution No. 2832

1. **Health Department** Date rec'd 7-20-03 Date frwd 7-22-03 ACTION ☒ Approved ☐ Disapproved Signature Ron Mayer
2. **Supt. Bldg. Insp. or Village Clerk** Date rec'd 7-30-03 Date frwd 7-30-03 ACTION ☒ Approved ☐ Disapproved Signature Mike Hoffer
3. **City or County Engineer** Date rec'd 8-5-03 Date frwd 8-5-03 ACTION ☒ Approved ☐ Disapproved Signature Dan Nolte

8/5/03 Need gate locked + sign ~~M.E.H.~~ C.H.

Installation Final Written Approval

By Jerrold C. Hood R.E.H.S.

Date FEBRUARY 3, 2004

Business Office Use Only
Date Rec'd 07/22/03
Amt Paid 200.00
Rec'd By JS ~~Cash~~/Check No. 10359

FORM 23-100 10-96 White - Health Dept. Yellow - Engineer Pink - Bldg. Inspector


Lincoln-Lancaster County Health Department
Environmental Health Division
3140 "N" Street • Lincoln, NE 68510-1514
Phone: 402-441-8022

C

Permit Number: 033802676

Sewage Disposal System
Preliminary Plan Specifications

Draw a plot plan showing system location, lines, distribution box, tank and laterals, percolation test hole locations, well, residence, compass direction and property lines. Indicate on drawing if residence and well are existing or proposed.

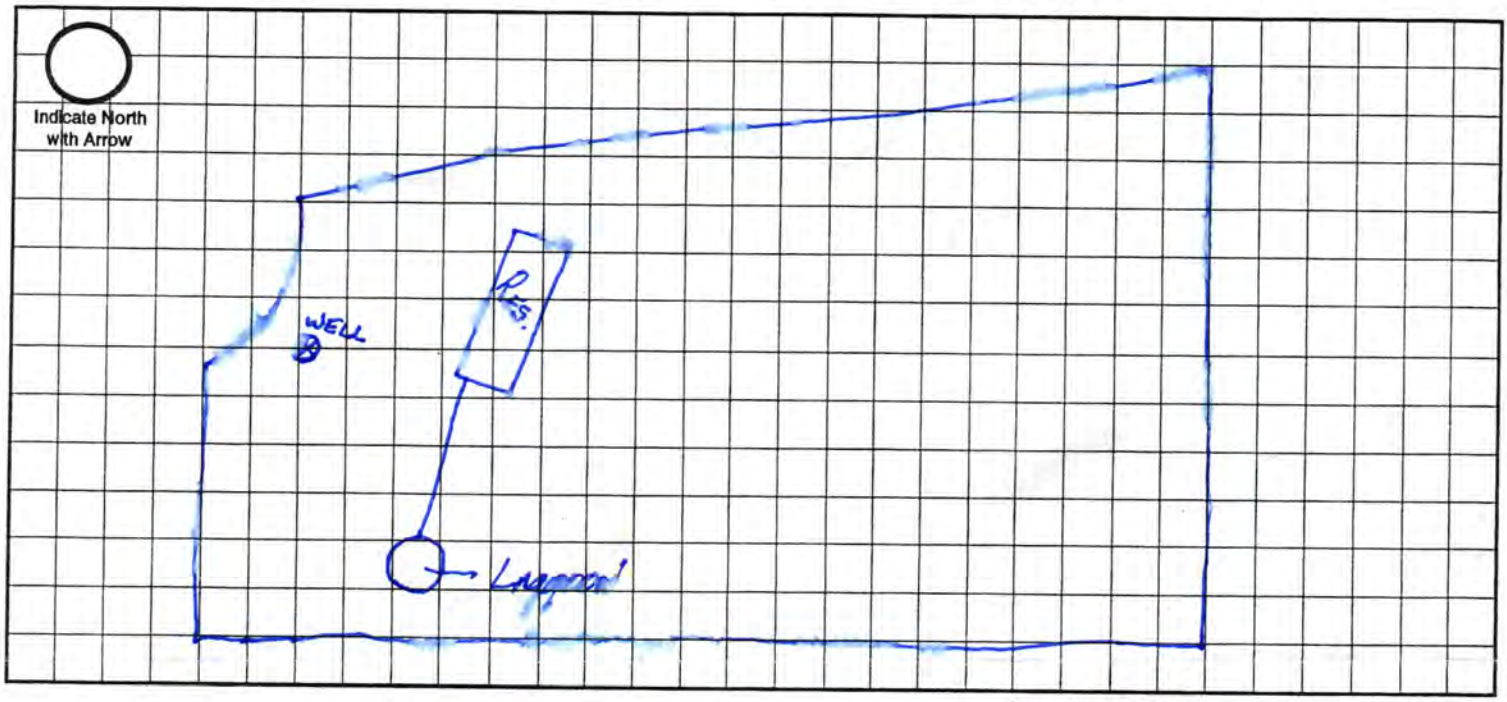

Approximate Scale: _____ ft. = _____ grid line/s

A. System Location (Indicate correct number and street)

Address (no rural route) 8240 CARL J Cir. City ~~Lincoln~~ FIRTH, NEBR. NE, Zip _____

B. Proposed Septic Tank/s

Tank Material: ☐ Concrete ☐ Plastic ☒ Other Lagoon Lagoon must be sealed so that no more than 1/8" seepage per day.

C. Proposed Absorption System (See Form B for Percolation Information)

Percolation Rate _____ (min. per inch) Soil Type: _____ Land Slope: _____ %

Type of Absorption System: ☐ Trench ☐ Bed ☐ Other _____

Total Square Feet of Field Required: _____ sq. ft.

Type of Lateral: ☐ Half-Moon ☐ Perforated Pipe ☐ Other Lateral Material: _____

Capacity of Septic Tank _____ gals Number of Absorption Beds: _____ Number of Distribution Laterals per Bed _____

Total Length of Laterals _____ ft. Number of Trenches _____ Trench Width _____

D. Setbacks Check the Boxes Below if the Required Setback has been Satisfied

Distance From	Private Well	Public Well	Surface Water	Gound Water	Pressure Water Lines	Property Lines	Foundations Yours	Foundations Neighbors	All Other Setbacks
Tank (ft)	50 ☐	500 ☐	50 ☐	NA ☐	25 ☐	20 ☐	15 ☐	25 ☐	☐
Field (ft)	100 ☐	500 ☐	50 ☐	4 ☐	30 ☐	20 ☐	30 ☐	40 ☐	☐
Lagoon (ft)	100 ☐	500 ☐	50 ☐	N/A ☐	30 ☐	50 ☐	100 ☐	200 ☐	☐

E. Required Signatures

Home Building Contractor _____ Date 7-30-03

Installer _____ Date 7-21-03

FORM 23-102 10-96

Lincoln-Lancaster County Health Department
Environmental Health Division
3140 "N" Street • Lincoln, NE 68510-1514
Phone: 402-441-8022

D

Permit Number: 033802676

Sewage Disposal System

As Built Plans & Specifications

Date 7-20-03

System Location (Indicate correct number and street)

Address 8240 CARLSON CT. (no rural route) City FIRTH NE, Zip NEBR.

A. Building Sewer

1. Material: PVC SCHEDULE 40
   Diameter: 4" in.
2. Distance above basement floor: 36 in.
   or distance below basement floor: — in.
3. Distance between dwelling and septic tank: — ft.
4. Number of clean-outs: 3
5. Distances to: well or suction line 200 ft.
   stream — ft.
   pressure line 200 ft.
   property line 60 ft.

B. Septic Tank

1. Material: _____
   Number of compartments: _____
2. Capacity: _____ gal.
3. Factory built: ☐ Yes ☐ No
4. Manholes: Over inlet, diameter _____ in.
   Over outlet, diameter _____ in.
   Riser: ☐ above ☐ below grade _____ in.
5. Inlet: ☐ baffle ☐ tee
6. Outlet: ☐ baffle ☐ tee
7. Depth to top of tank, below unfinished grade: _____ in.
8. Distances to: Well or suction line _____ ft.
   Stream _____ ft.
   Pressure line _____ ft.
   Property line _____ ft.

C. Distribution Box

1. Material: _____
   Number available outlets: _____
2. Factory built: ☐ Yes ☐ No
3. Distance from septic tank: 0 ft.

D. Absorption Field


(Provide as-built drawings on back of this form)

1. Type: ☐ Half rounds ☐ Perforated pipe
   Diameter of half round: _____
   or perforated pipe: _____
   Material: ☐ fiberglass ☐ plastic ☐ concrete
   ☐ other _____
2. Lateral lines: Number _____
   Length of each line: _____ ft. _____ ft.
   _____ ft. _____ ft., _____ ft.
3. Trench dimensions: Width _____ ft.
   Slope _____ in/100 ft.
   Average depth _____ in
4. Filter material: _____
   Depth of material _____ in.
5. Distances to: Well or suction line _____ ft.
   Stream _____ ft.
   Pressure line _____ ft.
   Property line _____ ft.

Complete "As Built" drawing on back of this form.

Indicate North with Arrow

Individual Sewage System Design (Example)

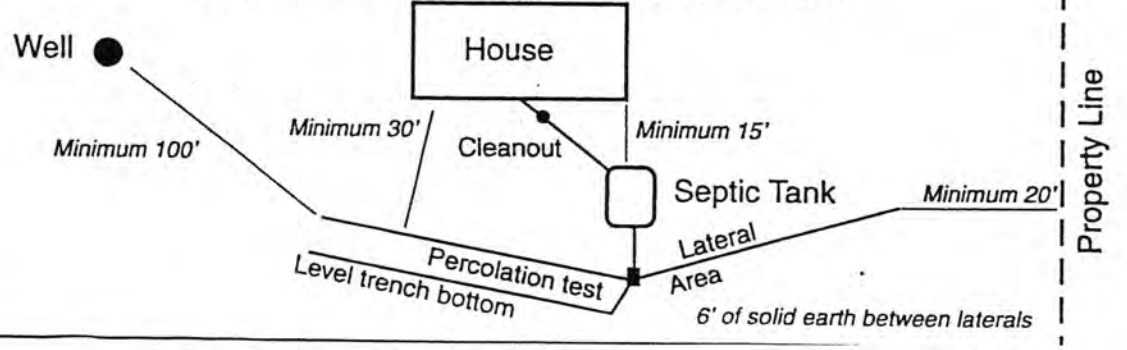

FORM 23-103 10-96

Lincoln-Lancaster County Health Department
Environmental Health Division
3140 "N" Street • Lincoln, NE 68510-1514
Phone: 402-441-8022

D

Permit Number:

Sewage Disposal System

As Built Plans & Specifications

Date 4-10-03

System Location (Indicate correct number and street)

Address 8240 Carlson Rd. (no rural route) City Firth NE, Zip

A. Building Sewer

1. Material: PVC
   Diameter: 4 in.
2. Distance above basement floor: 48 in.
   or distance below basement floor: _____ in.
3. Distance between dwelling and septic tank: _____ ft.
4. Number of clean-outs: 3
5. Distances to: well or suction line 100 + ft.
   stream _____ ft.
   pressure line _____ ft.
   property line _____ ft.

B. Septic Tank

1. Material: _____
   Number of compartments: _____
2. Capacity: _____ gal.
3. Factory built: ☐ Yes ☐ No
4. Manholes: Over inlet, diameter _____ in.
   Over outlet, diameter _____ in.
   Riser: ☐ above ☐ below grade _____ in.
5. Inlet: ☐ baffle ☐ tee
6. Outlet: ☐ baffle ☐ tee
7. Depth to top of tank, below unfinished grade: _____ in.
8. Distances to: Well or suction line _____ ft.
   Stream _____ ft.
   Pressure line _____ ft.
   Property line _____ ft.

C. Distribution Box

1. Material: _____
   Number available outlets: _____
2. Factory built: ☐ Yes ☐ No
3. Distance from septic tank: _____ ft.

D. Absorption Field


(Provide as-built drawings on back of this form)

1. Type: ☐ Half rounds ☐ Perforated pipe
   Diameter of half round: _____
   or perforated pipe: _____
   Material: ☐ fiberglass ☐ plastic ☐ concrete
   ☐ other _____
2. Lateral lines: Number _____
   Length of each line: _____ ft. _____ ft.
   _____ ft. _____ ft., _____ ft.
3. Trench dimensions: Width _____ ft.
   Slope _____ in/100 ft.
   Average depth _____ in
4. Filter material: _____
   Depth of material _____ in.
5. Distances to: Well or suction line _____ ft.
   Stream _____ ft.
   Pressure line _____ ft.
   Property line _____ ft.

Complete "As Built" drawing on back of this form.


Indicate North with Arrow

Individual Sewage System Design (Example)

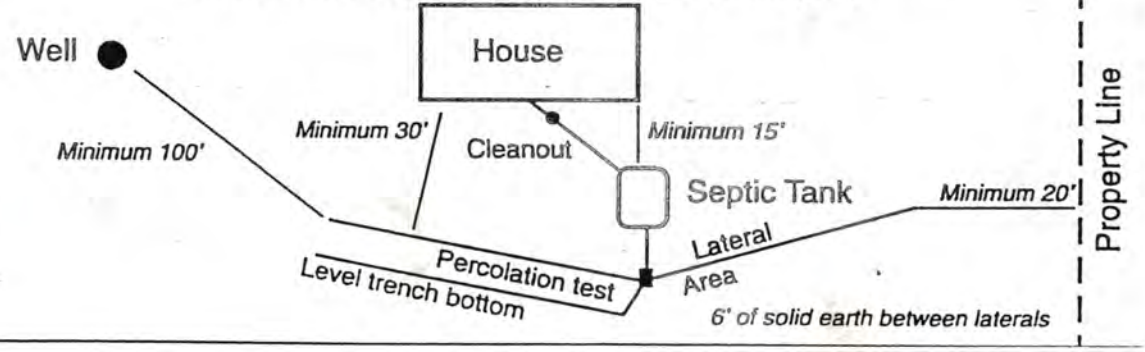

FORM 23-103 10-96


As Built Drawing

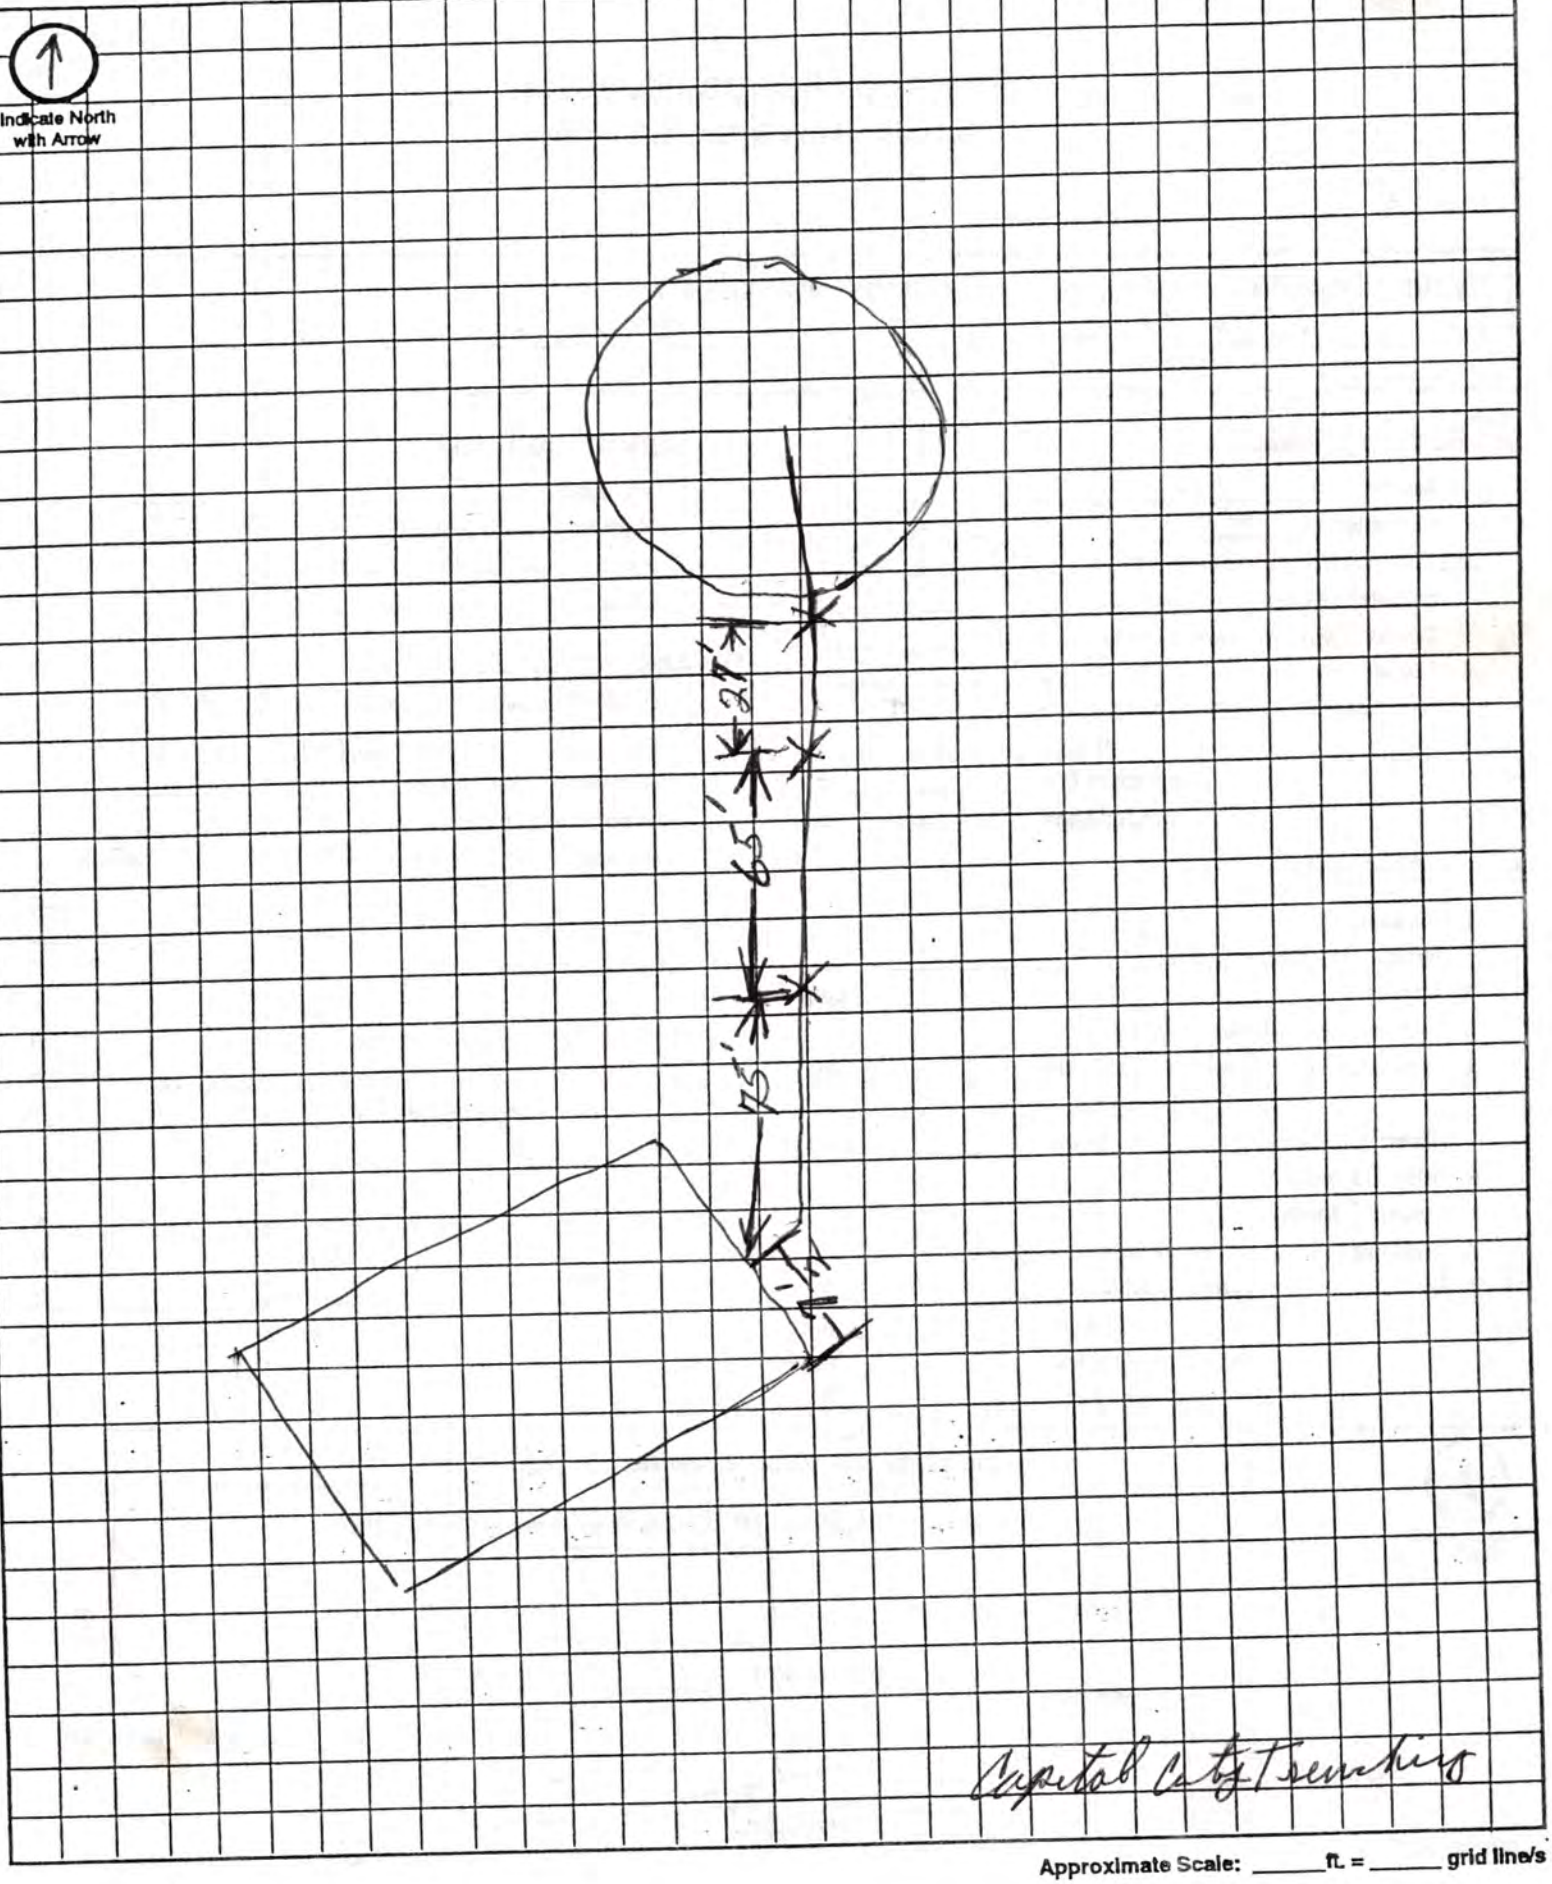

Approximate Scale: _____ ft. = _____ grid line/s

As Built Drawing


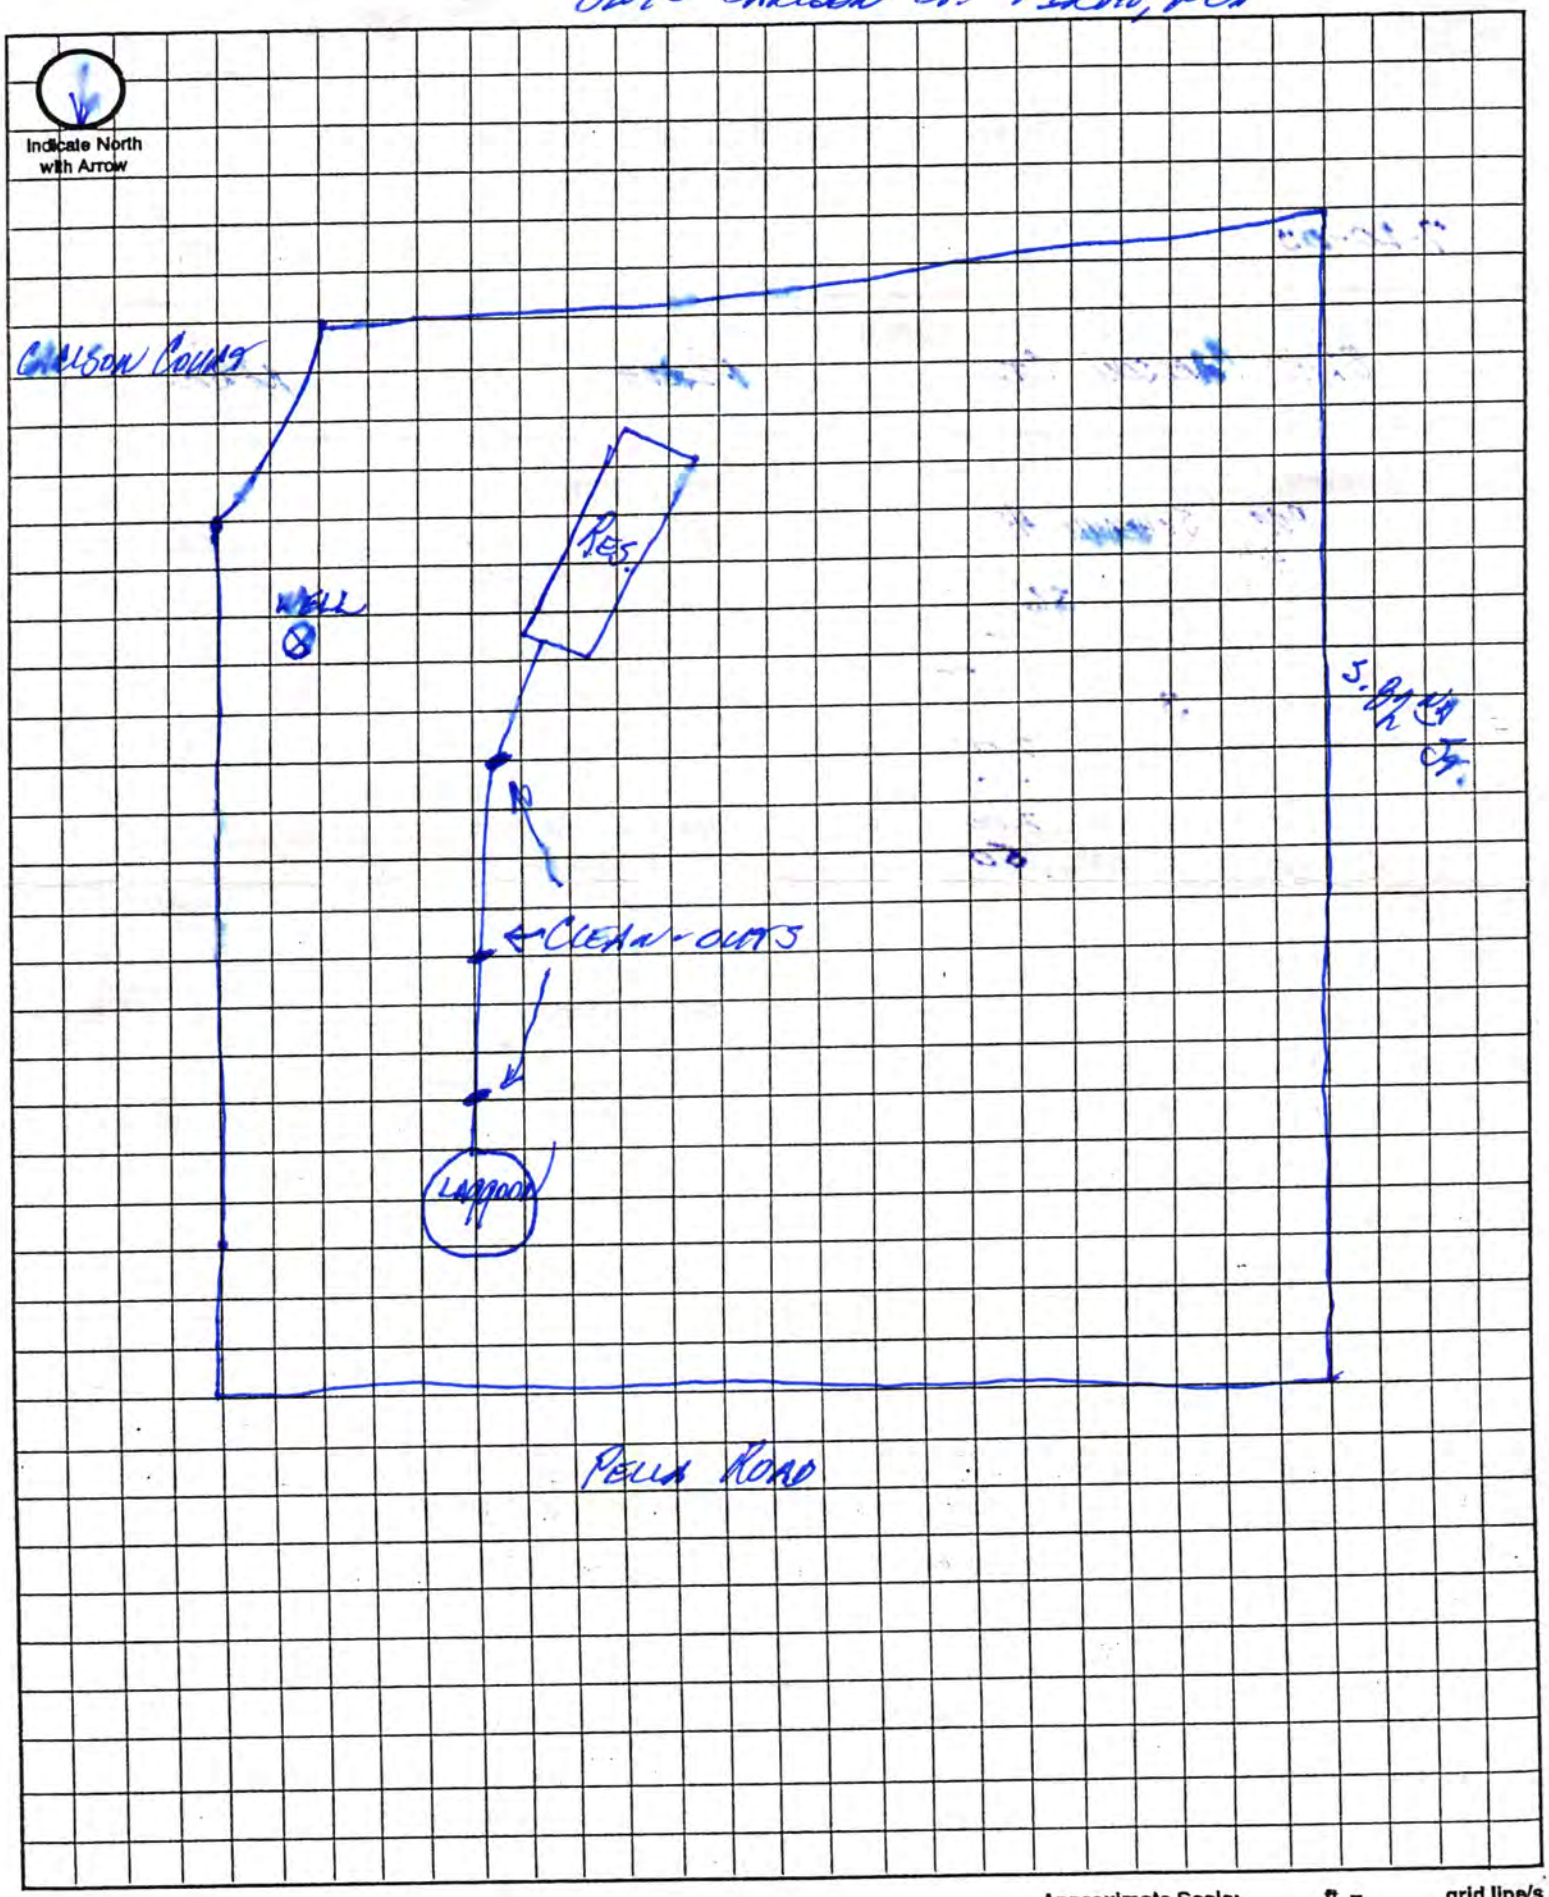

Approximate Scale: _____ ft. = _____ grid line/s