LINCOLN-LANCASTER COUNTY HEALTH DEPARTMENT

ENVIRONMENTAL HEALTH DIVISION

3140 "N" STREET
Lincoln, NE 68510-1514
(402) 441-8000

NON TRANSFERABLE

PERMIT

Permit
SEWAGE INSTALLATION
LAGOON

No. 98380186701

Issued 10/13/98
Expires 04/13/99
Revenue Code 3157

PAID

FEES: $150.00

Establishment
DOUGLAS WIESKAMP
T7N R8E SEC 8 QTR NW
12301 PANAMA RD-HICKMAN

Permittee
DOUGLAS WIESKAMP
804 RUSSELL CIR
FIRTH NE 68358

TOTAL $150.00

Issued By Health Director
Lincoln-Lancaster County Health Department

008191

THIS LICENSE OR PERMIT IS ISSUED SUBJECT TO REVOCATION AS PROVIDED BY LAW "POST IN A PROMINENT PLACE"

Lincoln-Lancaster County Health Department
Environmental Health Division
3140 "N" Street • Lincoln, NE 68510-1514
Phone: 402-441-8022

A

Permit Number: 98380186?

Sewage Disposal System

Request for Site Clearance and Permit

Include Form B, Form C and Applicable Fees with this Application.

☐ Septic System ☒ Lagoon ☐ Other (Refer to Form C)

The undersigned hereby requests site clearance and permit to construct a Sewage Disposal System in conformance with appropriate resolution or ordinance, as described herein:

PLEASE PRINT OR TYPE

A. System Location (Indicate correct number and street)

Address 12301 Panama Road (no rural route) City Hickman NE, Zip 68372

Legal Description NW [redacted] 8 - 7N 8E 10 I.T.
1/4 1/4 Section Township Range Subdivision Addition Block Lot

Geographical Location (if known): Longitude _____ Latitude _____

☒ Check if system mail address is not the same as the owner's address

B. Owner

Name Douglas + Patti Wieskamp Signature Douglas Wieskamp Patti Wieskamp

Address 809 Russell Circle City/State/Zip Firth, NE 68358

☐ Check if owner designed system Home Phone 791-5383 Work Phone 791-5580

C. Contractor

Name Dave Vogt Company Name Vogt T+T Construction

Address _____ City/State/Zip _____

☒ Check if contractor designed system Work Phone _____

D. Engineer/Installer ☐ Check and complete if engineer designed system

Designer Name _____ Firm _____ Work Phone _____

E. This System Will Serve a

☒ Residential Dwelling Number of Bedrooms 4 Is there a Whirlpool Bathtub (YES) NO

☐ Commercial Establishment/Other Facility Specify _____

Design flow in gallons per day _____ Type of Wastewater: ☐ Domestic ☐ Non-Domestic.

DO NOT WRITE BELOW THIS LINE

Approval Process ☐ Municipal Code 24.38 ☒ County Resolution No. 2832

1. **Health Department** Date rec'd 10/12/98 Date frwd 10/12/98 **ACTION** ☒ Approved ☐ Disapproved Signature Gerrold C. Hood
2. **Supt. Bldg. Insp. or Village Clerk** Date rec'd 10/12/98 Date frwd 10/12/98 **ACTION** ☒ Approved ☐ Disapproved Signature _____
3. **City or County Engineer** Date rec'd 10/12/98 Date frwd 10/12/98 **ACTION** ☒ Approved ☐ Disapproved Signature _____

Installation Final Written Approval

By J Dave

Date 5-10-99

Business Office Use Only

Date Rec'd 10/12/98

Amt Paid 150 ck

Rec'd By _____ Cash/Check No. 7424

FORM 23-100 10-96 White - Health Dept. Yellow - Engineer Pink - Bldg. Inspector


Lincoln-Lancaster County Health Department
Environmental Health Division
3140 "N" Street • Lincoln, NE 68510-1514
Phone: 402-441-8022

C

Permit Number: 98380 1867

Sewage Disposal System
Preliminary Plan Specifications

Draw a plot plan showing system location, lines, distribution box, tank and laterals, percolation test hole locations, well, residence, compass direction and property lines. Indicate on drawing if residence and well are existing or proposed.

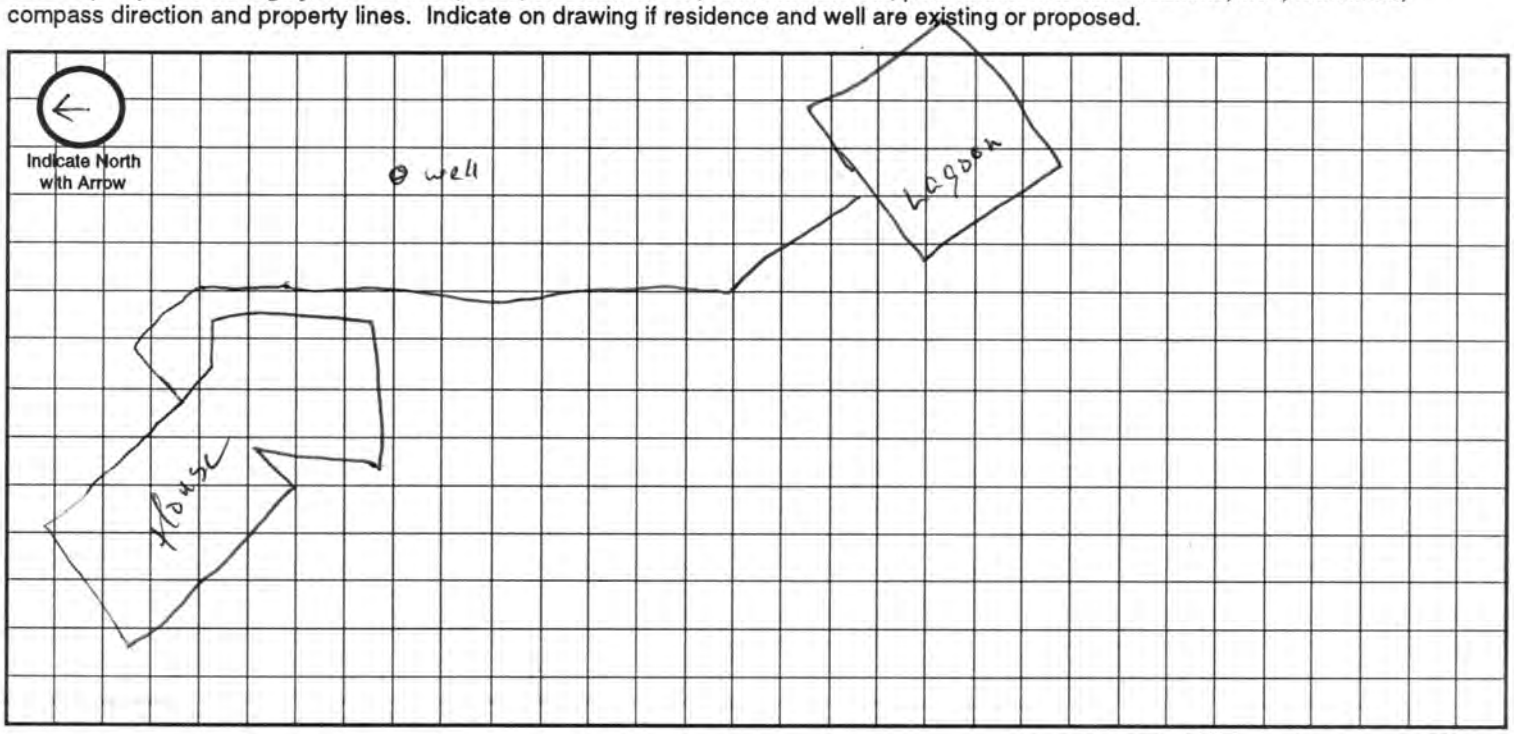

Approximate Scale: _____ ft. = _____ grid line/s

A. System Location (Indicate correct number and street)


B. Proposed Septic Tank/s

Tank Material: ☐ Concrete ☐ Plastic ☐ Other Lagoon

C. Proposed Absorption System (See Form B for Percolation Information)

Percolation Rate _____ (min. per inch) Soil Type: _____ Land Slope: _____ %

Type of Absorption System: ☐ Trench ☐ Bed ☐ Other _____

Total Square Feet of Field Required: _____ sq. ft.

Type of Lateral: ☐ Half-Moon ☐ Perforated Pipe ☐ Other Lateral Material: _____

Capacity of Septic Tank _____ gals Number of Absorption Beds: _____ Number of Distribution Laterals per Bed _____

Total Length of Laterals _____ ft. Number of Trenches _____ Trench Width _____

D. Setbacks Check the Boxes Below if the Required Setback has been Satisfied

Distance From	Private Well	Public Well	Surface Water	Gound Water	Pressure Water Lines	Property Lines	Foundations Yours	Foundations Neighbors	All Other Setbacks
Tank (ft)	50 ☐	500 ☐	50 ☐	NA ☐	25 ☐	20 ☐	15 ☐	25 ☐	☐
Field (ft)	100 ☐	500 ☐	50 ☐	4 ☐	30 ☐	20 ☐	30 ☐	40 ☐	☐
Lagoon (ft)	100 ☒	500 ☒	50 ☒	N/A ☒	30 ☒	50 ☒	100 ☒	200 ☒	☒

E. Required Signatures

Home Building Contractor _____ Date _____

Installer _____ Date 9-10-98

FORM 23-102 10-96

Lincoln-Lancaster County Health Department
Environmental Health Division
3140 "N" Street • Lincoln, NE 68510-1514
Phone: 402-441-8022

D

Permit Number: 98380187

Sewage Disposal System

As Built Plans & Specifications

Date 11-30-98

System Location (Indicate correct number and street)


A. Building Sewer

1. Material: PVC
   Diameter: 4 in.
2. Distance above basement floor: _____ in.
   or distance below basement floor: 24 in.
3. Distance between dwelling and ~~septic tank~~: _____ ft.
4. Number of clean-outs: 7 Lagoon
5. Distances to: well or suction line 379 ft.
   stream NA ft.
   pressure line 8 ft.
   property line 100+ ft.

B. Septic Tank

1. Material: _____
   Number of compartments: _____
2. Capacity: _____ gal.
3. Factory built: ☐ Yes ☐ No
4. Manholes: Over inlet, diameter _____ in.
   Over outlet, diameter _____ in.
   Riser: ☐ above ☐ below grade _____ in.
5. Inlet: ☐ baffle ☐ tee
6. Outlet: ☐ baffle ☐ tee
7. Depth to top of tank, below unfinished grade: _____ in.
8. Distances to: Well or suction line _____ ft.
   Stream _____ ft.
   Pressure line _____ ft.
   Property line _____ ft.

C. Distribution Box

1. Material: _____
   Number available outlets: _____
2. Factory built: ☐ Yes ☐ No
3. Distance from septic tank: _____ ft.

D. Absorption Field


(Provide as-built drawings on back of this form)

1. Type: ☐ Half rounds ☐ Perforated pipe
   Diameter of half round: _____
   or perforated pipe: _____
   Material: ☐ fiberglass ☐ plastic ☐ concrete
   ☐ other _____
2. Lateral lines: Number _____
   Length of each line: _____ ft. _____ ft.
   _____ ft. _____ ft., _____ ft.
3. Trench dimensions: Width _____ ft.
   Slope _____ in/100 ft.
   Average depth _____ in
4. Filter material: _____
   Depth of material _____ in.
5. Distances to: Well or suction line _____ ft.
   Stream _____ ft.
   Pressure line _____ ft.
   Property line _____ ft.

Indicate North with Arrow


Complete "As Built" drawing on back of this form.

Individual Sewage System Design (Example)

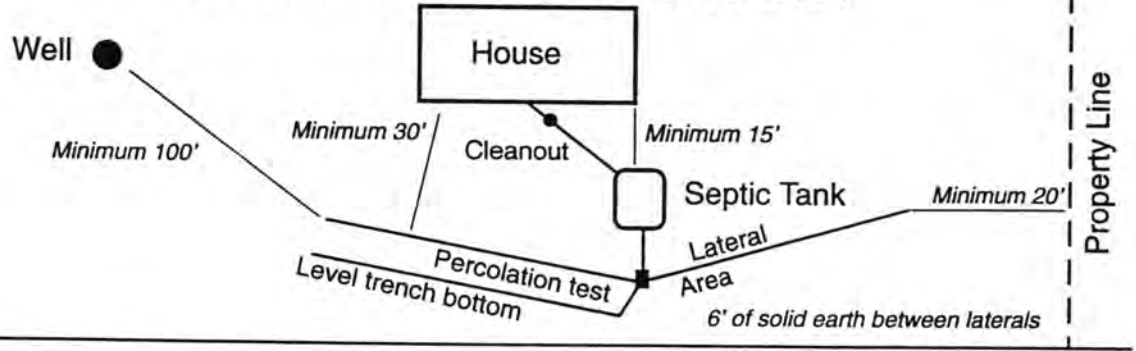

FORM 23-103 10-96

As Built Drawing

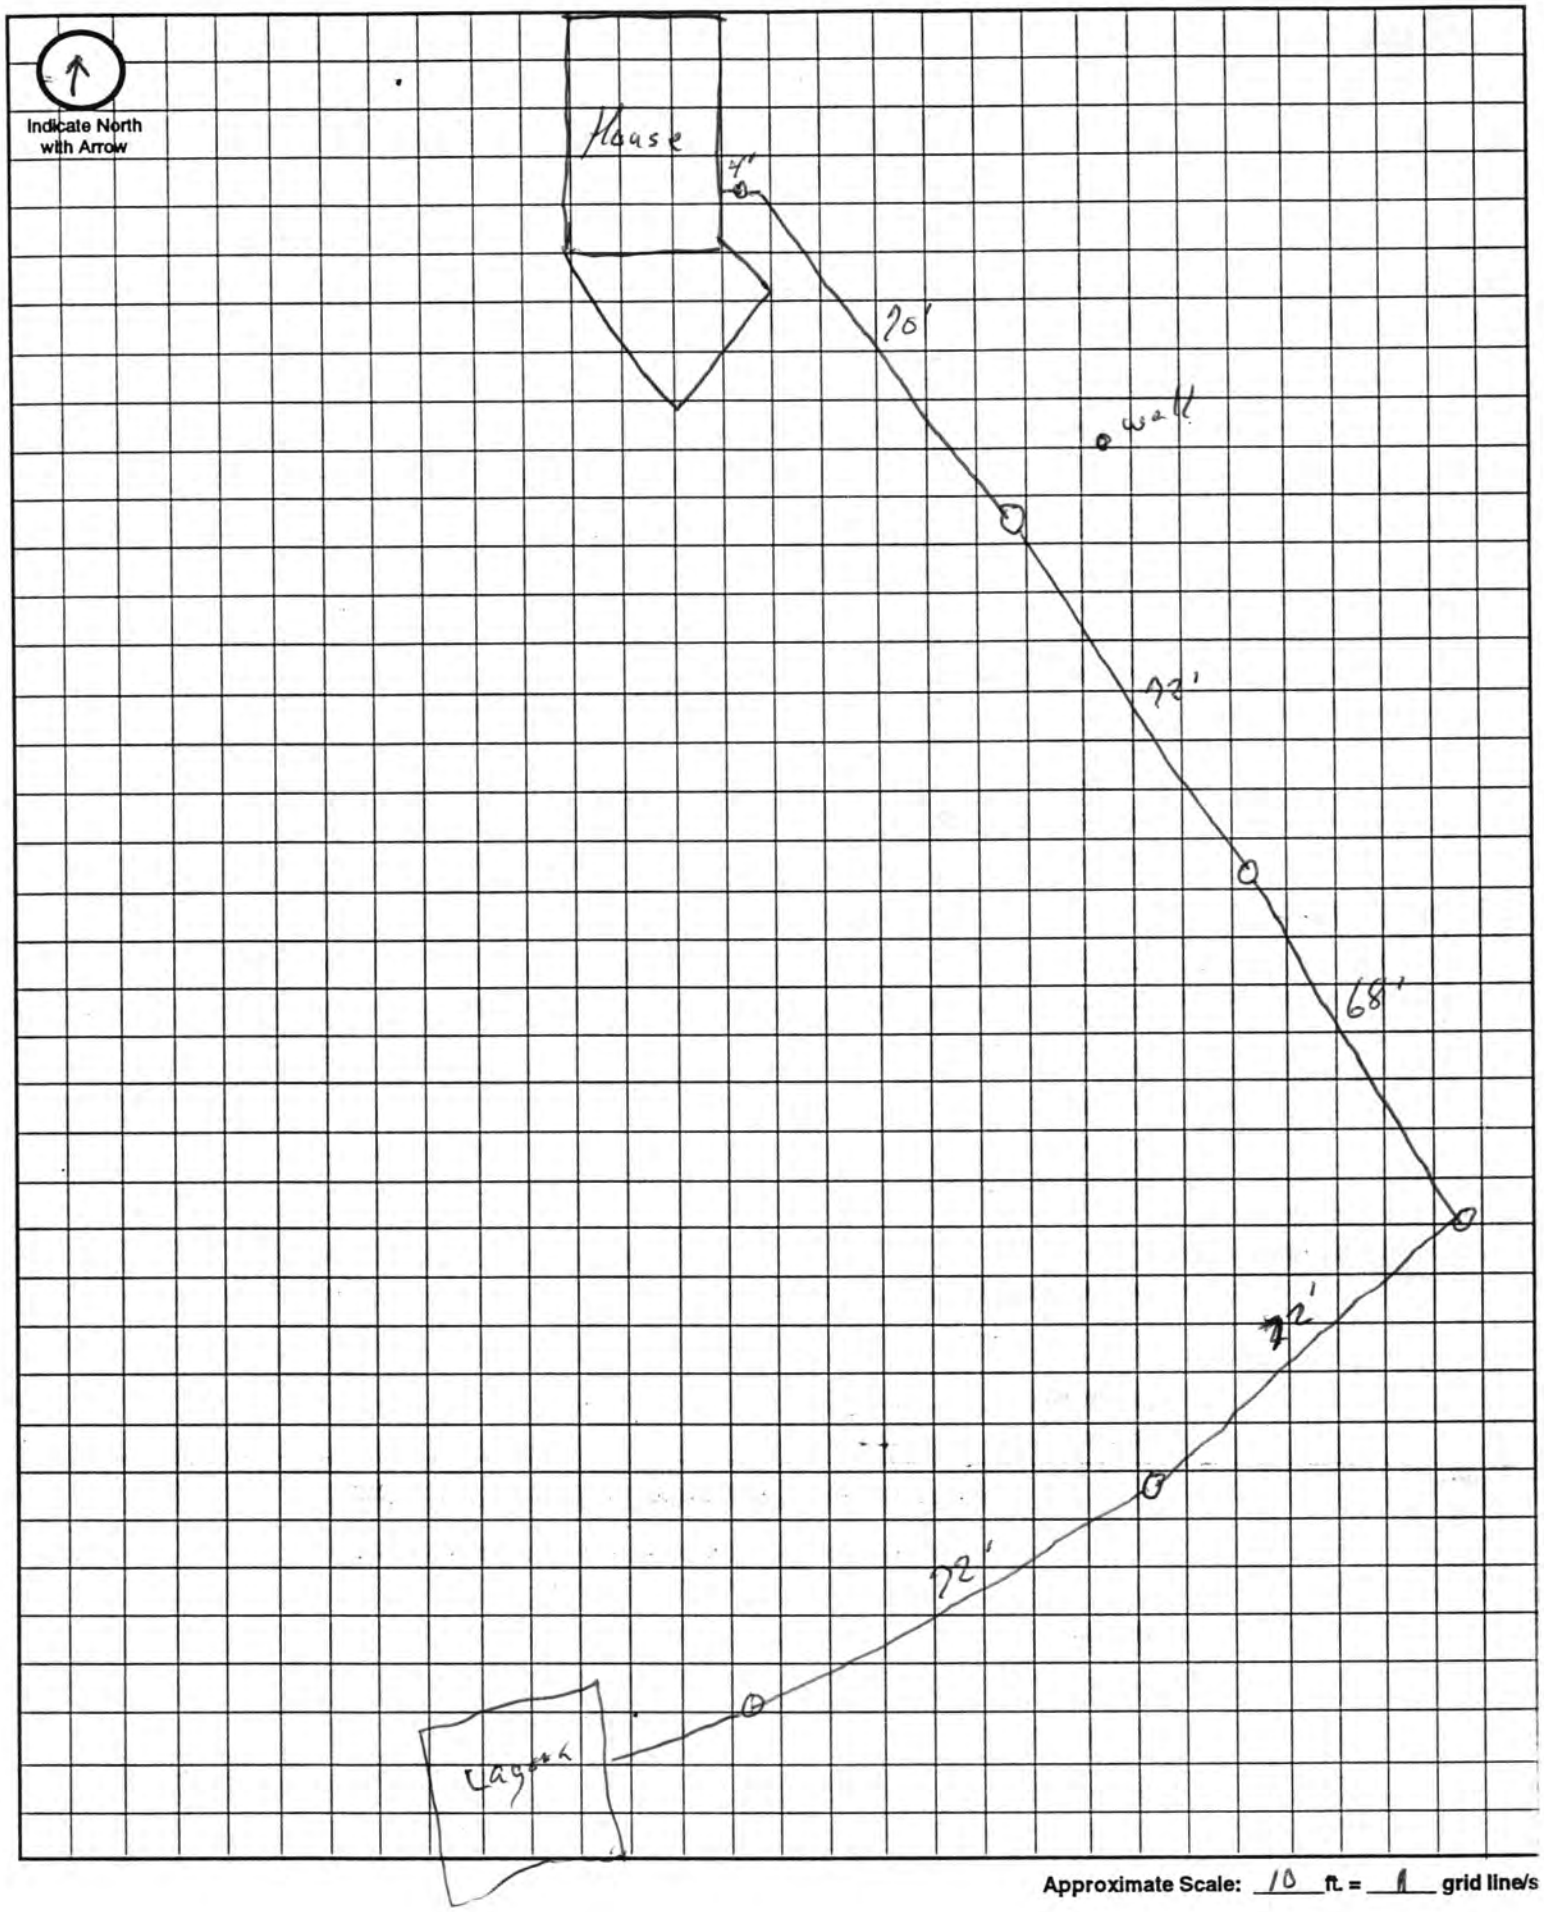

Approximate Scale: 10 ft. = 1 grid line/s