Lincoln-Lancaster County Health Department

ENVIRONMENTAL PUBLIC HEALTH DIVISION

3140 N STREET · LINCOLN, NE 68510-1514

007955

(402) 441-8000

Permit: SEWAGE INSTALLATION
LAGOON

Permit # 05380305301

Issued 07/01/05
Expires 07/01/06
Revenue Code 3157

Establishment:
CLARE WUNDERLICH
T8N R6E SEC 13 QTR NE
N 1/2 OF NE 1/4
2361 WITTSTRUCK RD-ROCA

FEES: $200.00

Permittee:
CLARE WUNDERLICH
2361 WITTSTRUCK RD
ROCA NE 68430

TOTAL: $200.00

Bruce D. Dart

Bruce D. Dart, Health Director

EPH COPY

Lincoln-Lancaster County Health Department
Environmental Health Division
3140 "N" Street • Lincoln, NE 68510-1514
Phone: 402-441-8022

A

Permit Number: 05380305301

Sewage Disposal System

Request for Site Clearance and Permit

Include Form B, Form C and Applicable Fees with this Application.

☐ Septic System ☑ Lagoon ☐ Other (Refer to Form C)

The undersigned hereby requests site clearance and permit to construct a Sewage Disposal System in conformance with appropriate resolution or ordinance, as described herein:

PLEASE PRINT OR TYPE

A. System Location (Indicate correct number and street)

Address 2361 WITTSTRUCK (no rural route) City ROCA NE, Zip 68430

Legal Description N NE 13 8-N 6-E — — —

Lincoln-Lancaster County Health Department
Environmental Health Division
3140 "N" Street • Lincoln, NE 68510-1514
Phone: 402-441-8022


C

Permit Number:

Sewage Disposal System

Preliminary Plan Specifications

Draw a plot plan showing system location, lines, distribution box, tank and laterals, percolation test hole locations, well, residence, compass direction and property lines. Indicate on drawing if residence and well are existing or proposed.

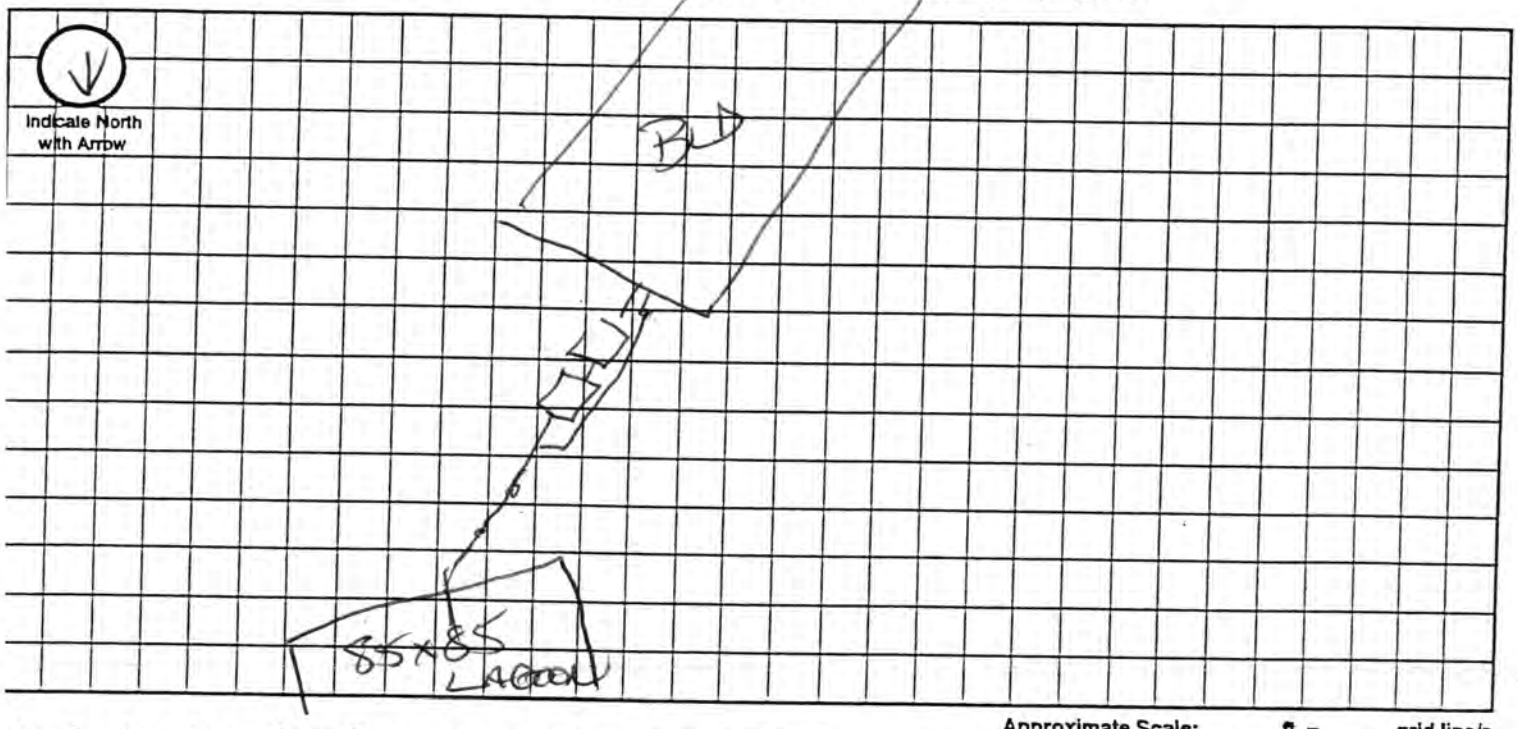

Approximate Scale: _____ ft. = _____ grid line/s

A. System Location (Indicate correct number and street)


B. Proposed Septic Tank/s

Tank Material: ☐ Concrete ☐ Plastic ☐ Other _____

C. Proposed Absorption System (See Form B for Percolation Information)

Percolation Rate _____ (min. per inch) Soil Type: _____ Land Slope: _____ %

Type of Absorption System: ☐ Trench ☐ Bed ☐ Other _____

Total Square Feet of Field Required: _____ sq. ft.

Type of Lateral: ☐ Half-Moon ☐ Perforated Pipe ☐ Other Lateral Material: _____

Capacity of Septic Tank _____ gals Number of Absorption Beds: _____ Number of Distribution Laterals per Bed _____

Total Length of Laterals _____ ft. Number of Trenches _____ Trench Width _____

D. Setbacks Check the Boxes Below if the Required Setback has been Satisfied

Distance From	Private Well	Public Well	Surface Water	Gound Water	Pressure Water Lines	Property Lines	Foundations Yours	Foundations Neighbors	All Other Setbacks
Tank (ft)	50 ☐	500 ☐	50 ☐	NA ☐	25 ☐	20 ☐	15 ☐	25 ☐	☐
Field (ft)	100 ☐	500 ☐	50 ☐	4 ☐	30 ☐	20 ☐	30 ☐	40 ☐	☐
Lagoon (ft)	100 ☑	500 ☑	50 ☑	N/A ☑	30 ☑	50 ☑	100 ☑	200 ☑	☑

E. Required Signatures

Home Building Contractor _____ Date 6/27/05

Installer _____ Date 6/27/05

RM 23-102 10-96

Lincoln-Lancaster County Health Department
Environmental Health Division
3140 "N" Street • Lincoln, NE 68510-1514
Phone: 402-441-8022

D

Permit Number:

Sewage Disposal System

As Built Plans & Specifications

Date 6/30/05 WUNDEROSA WINERY

System Location (Indicate correct number and street)

Address 2361 WITTSTRUCK (no rural route) City ROCA NE, Zip 68430

A. Building Sewer

1. Material: CLS 1600
   Diameter: 4 in.
2. Distance above basement floor: _____ in.
   or distance below basement floor: 24 in.
3. Distance between dwelling and ~~septic tank~~ LAGOON 200 ft.
4. Number of clean-outs: 6 EA
5. Distances to: well or suction line 100+ ft.
   stream 100+ ft.
   pressure line 100+ ft.
   property line 100+ ft.

B. Septic Tank

1. Material: CONC
   Number of compartments: _____
2. Capacity: 2 - 1250 gal.
3. Factory built: ☑ Yes ☐ No
4. Manholes: Over inlet, diameter _____ in.
   Over outlet, diameter _____ in.
   Riser: ☑ above ☐ below grade 6 in.
5. Inlet: ☑ baffle ☐ tee
6. Outlet: ☑ baffle ☐ tee
7. Depth to top of tank, below unfinished grade: 12 in.
8. Distances to: Well or suction line 100+ ft.
   Stream 100+ ft.
   Pressure line 100+ ft.
   Property line 100+ ft.

C. Distribution Box

1. Material: _____
   Number available outlets: _____
2. Factory built: ☐ Yes ☐ No
3. Distance from septic tank: _____ ft.

D. Absorption Field


(Provide as-built drawings on back of this form)

1. Type: ☐ Half rounds ☐ Perforated pipe
   Diameter of half round: _____
   or perforated pipe: _____
   Material: ☐ fiberglass ☐ plastic ☐ concrete
   ☐ other _____
2. Lateral lines: Number _____
   Length of each line: _____ ft. _____ ft.
   _____ ft. _____ ft., _____ ft.
3. Trench dimensions: Width _____ ft.
   Slope _____ in/100 ft.
   Average depth _____ in
4. Filter material: _____
   Depth of material _____ in.
5. Distances to: Well or suction line _____ ft.
   Stream _____ ft.
   Pressure line _____ ft.
   Property line _____ ft.


Indicate North with Arrow

Complete "As Built" drawing on back of this form.

Individual Sewage System Design (Example)

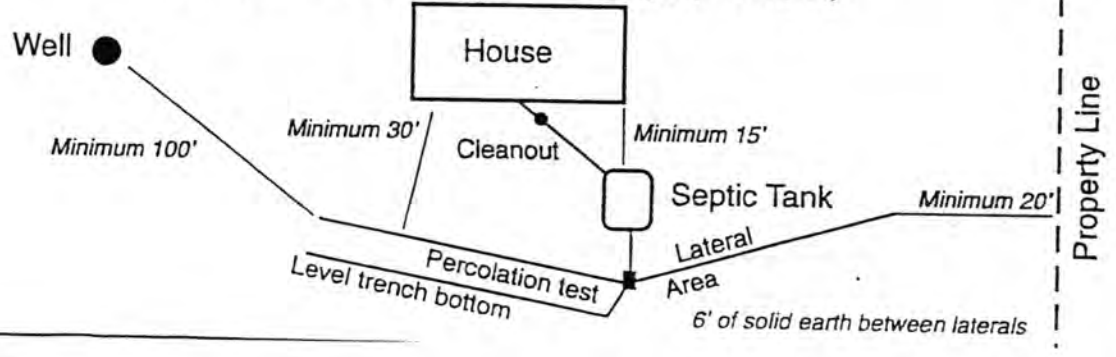

As Built Drawing

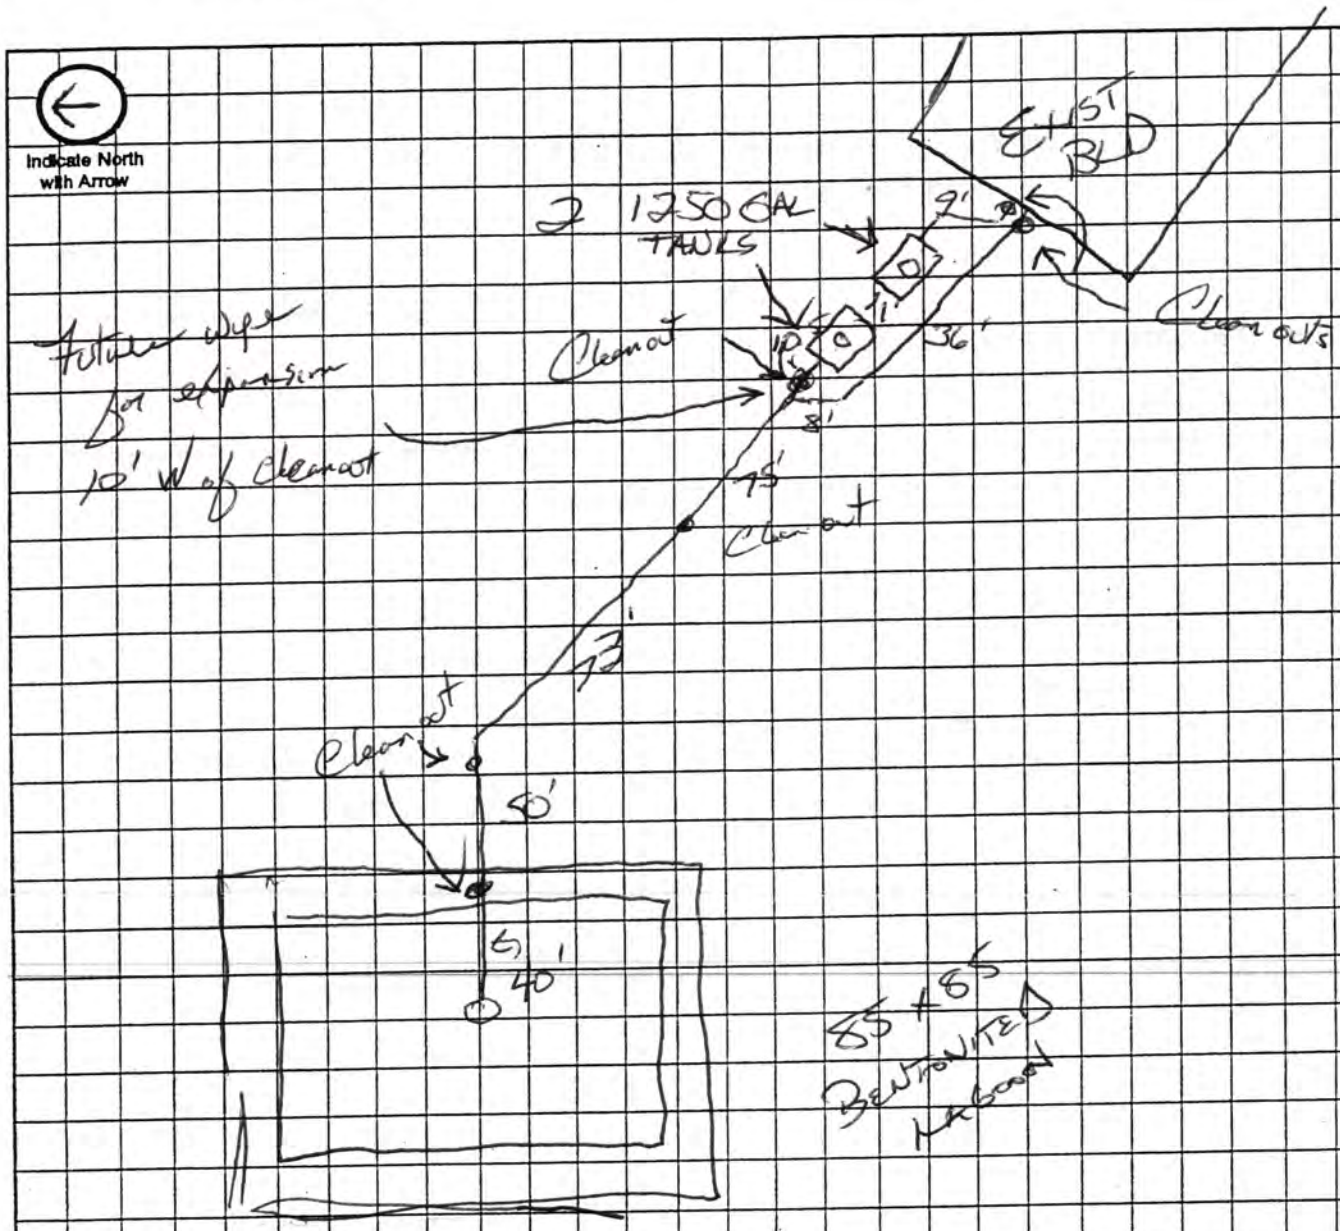

248' 4" CLS 160

WINERY IS SERVED BY RURAL WATER

2 - 1250 GAL TANKS ARE TO CATCH THE SLOT DRAIN INSIDE

Approximate Scale: _____ ft. = _____ grid line/s