Lincoln-Lancaster County Health Department
Environmental Health Division
3140 "N" Street • Lincoln, NE 68510-1514
Phone: 402-441-8022

D

Permit Number:

Sewage Disposal System
As Built Plans & Specifications

Date _____

System Location (Indicate correct number and street)
Address 18100 Hickman Rd. (no rural route) City Bennet NE, Zip 68317

A. Building Sewer
1. Material: Sch. 40 PVC
   Diameter: 4 in.
2. Distance above basement floor: _____ in.
   or distance below basement floor: 12 in.
3. Distance between dwelling and septic tank: 70 ft.
4. Number of clean-outs: 1
5. Distances to: well or suction line 100+ ft.
   stream — ft.
   pressure line 40 ft.
   property line 100+ ft.

B. Septic Tank
1. Material: Concrete
   Number of compartments: 3
2. Capacity: 1250 gal.
3. Factory built: ☑ Yes ☐ No
4. Manholes: Over inlet, diameter — in.
   Over outlet, diameter — in.
   Riser: ☑ above ☐ below grade 6 in.
5. Inlet: ☑ baffle ☐ tee
6. Outlet: ☑ baffle ☐ tee
7. Depth to top of tank, below unfinished grade: 6 in.
8. Distances to: Well or suction line 100+ ft.
   Stream — ft.
   Pressure line 100+ ft.
   Property line 100+ ft.


C. Distribution Box
1. Material: Plastic
   Number available outlets: 5
2. Factory built: ☑ Yes ☐ No
3. Distance from septic tank: 10 ft.

D. Absorption Field
(Provide as-built drawings on back of this form)
1. Type: ☐ Half rounds ☑ Perforated pipe
   Diameter of half round: _____
   or perforated pipe: 4"
   Material: ☐ fiberglass ☑ plastic ☐ concrete
   ☐ other _____
2. Lateral lines: Number 4
   Length of each line: 100 ft. 100 ft.
   100 ft. 60 ft., _____ ft.
3. Trench dimensions: Width 3 ft.
   Slope 1 in/100 ft.
   Average depth 30 in
4. Filter material: Road Gravel
   Depth of material 12 in.
5. Distances to: Well or suction line 100+ ft.
   Stream — ft.
   Pressure line 100+ ft.
   Property line 100+ ft.

Complete "As Built" drawing on back of this form.

Indicate North with Arrow

Individual Sewage System Design (Example)

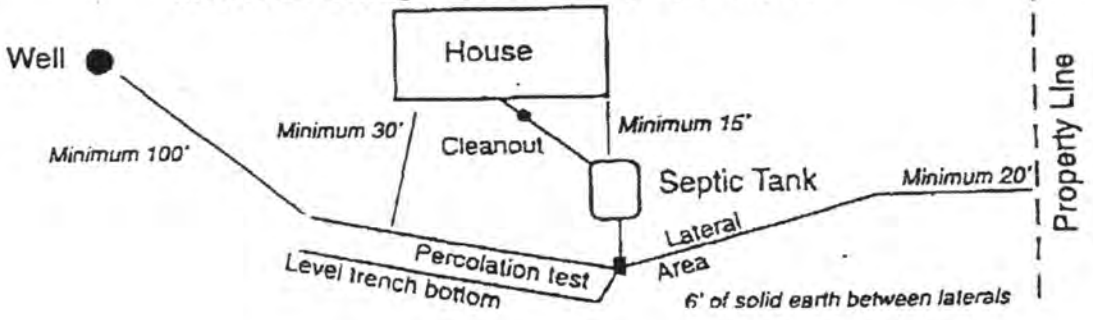

As Built Drawing

