# LINCOLN-LANCASTER COUNTY HEALTH DEPARTMENT

ENVIRONMENTAL HEALTH DIVISION

2200 St. Marys Ave Lincoln, NE 68502-3785 (402) 471-8000

NON TRANSFERABLE

## P E R M I T

Permit
SEWAGE INSTALLATION

No. 92380092901

Issued 11/03/92
Expires 05/03/93
Revenue Code 18754

Establishment
HEINRICH CONSTRUCTION
T11N R28 SEC 5
LOT 8
12600 MILL ROAD

FEES: $150.00

TOTAL $150.00

Permittee
HEINRICH CONSTRUCTION
2601 S 58 ST
APT #13
LINCOLN NE 68506

Issued By M. Jane Ford
Health Director

THIS LICENSE OR PERMIT IS ISSUED SUBJECT TO REVOCATION AS PROVIDED BY LAW
"POST IN A PROMINENT PLACE"

FORM 20103-0477
REQUEST FOR SITE CLEARANCE AND PERMIT
FOR INDIVIDUAL SEWAGE DISPOSAL SYSTEM
City Ordinance No. 9150 ☐
County Resolution No. 2832 ☒

LINCOLN-LANCASTER COUNTY HEALTH DEPARTMENT
Division of Environmental Health
2200 St. Marys Avenue
Lincoln, Nebraska 68502
Phone: 471-7800

A

FILING FEE: $_____

FILE NO._____

DATE: 10-26-92

The undersigned hereby requests SITE CLEARANCE and PERMIT to construct an Individual Sewage Disposal System in conformance with appropriate resolution or ordinance, as described herein:

1. Legal description of property: Twp. 8N ; Range 7E ; Section 1 ; Block _____ : Lot _____ : Addition _____
   Street Address 110th & Saltillo Road, County — East ½ of N.E. Qtr

2. Property Use: Residential ☒ ; Commercial ☐ ; Other Use ☒
   No. of Bedrooms 3 . Describe FARM (80 ACRES) + or —

3. Type of Individual Sewage Disposal System: Septic Tank ☐ ; Other ☒ LAGOON

4. Distance to public sewer: miles _____ ft.

No village or city jurisdiction

Heimich Construction
Signature of Applicant (Owner or Lessee)

2601 S 58th #13 Lincoln Ne 68506
Address 488-9223

(Do not write below this double line) MARTIN Dye Residence

1. Health Department: Date Rec'd. 10/30/92. Date Frwd. 10/30/92. ACTION: Approved ☒ Disapproved ☐ Signature: Jerrold C. Hood

2. Supt. Bldg. Insp.: or Village Clerk: Date Rec'd. _____. Date Frwd. _____. ACTION: Approved ☒ Disapproved ☐ Signature: [illegible]

3. City or County Engineer: Date Rec'd. 10-30-92 Date Frwd. 10-30-92. ACTION: Approved ☐ Disapproved ☐ Signature: [illegible]

REMARKS OR REASONS FOR DISAPPROVAL Need Fence Bentonite etc 11-10-92

Site Visits:
Date: 11-10-92 by: P.D
Date: _____ by: _____
Date: _____ by: _____

White: Health Dept. Copy
Yellow: Engineers Copy
Pink: Bldg. Inspector's Copy

INSTALLATION FINAL WRITTEN APPROVAL
Date: [redacted] By: Paul Prutzman

Rec'd 10-29-92 #155641 $150.00

FORM 23-43

FORM 20102-0477
PRELIMINARY PLANS & SPECIFICATIONS FOR SEWAGE DISPOSAL SYSTEM (Annex to Application)
City Ordinance No. 9150 ☐
County Resolution No. 2832 ☐


LINCOLN-LANCASTER COUNTY HEALTH DEPARTMENT
Division of Environmental Health
2200 St. Marys Avenue
Lincoln, Nebraska 68502
Phone: 471-7800

**C**

Sketch of property showing Percolation Test hole locations, well, residence, direction and property line.

FILE NO._____

Indicate on sketch if residence and well are exisiting or proposed.

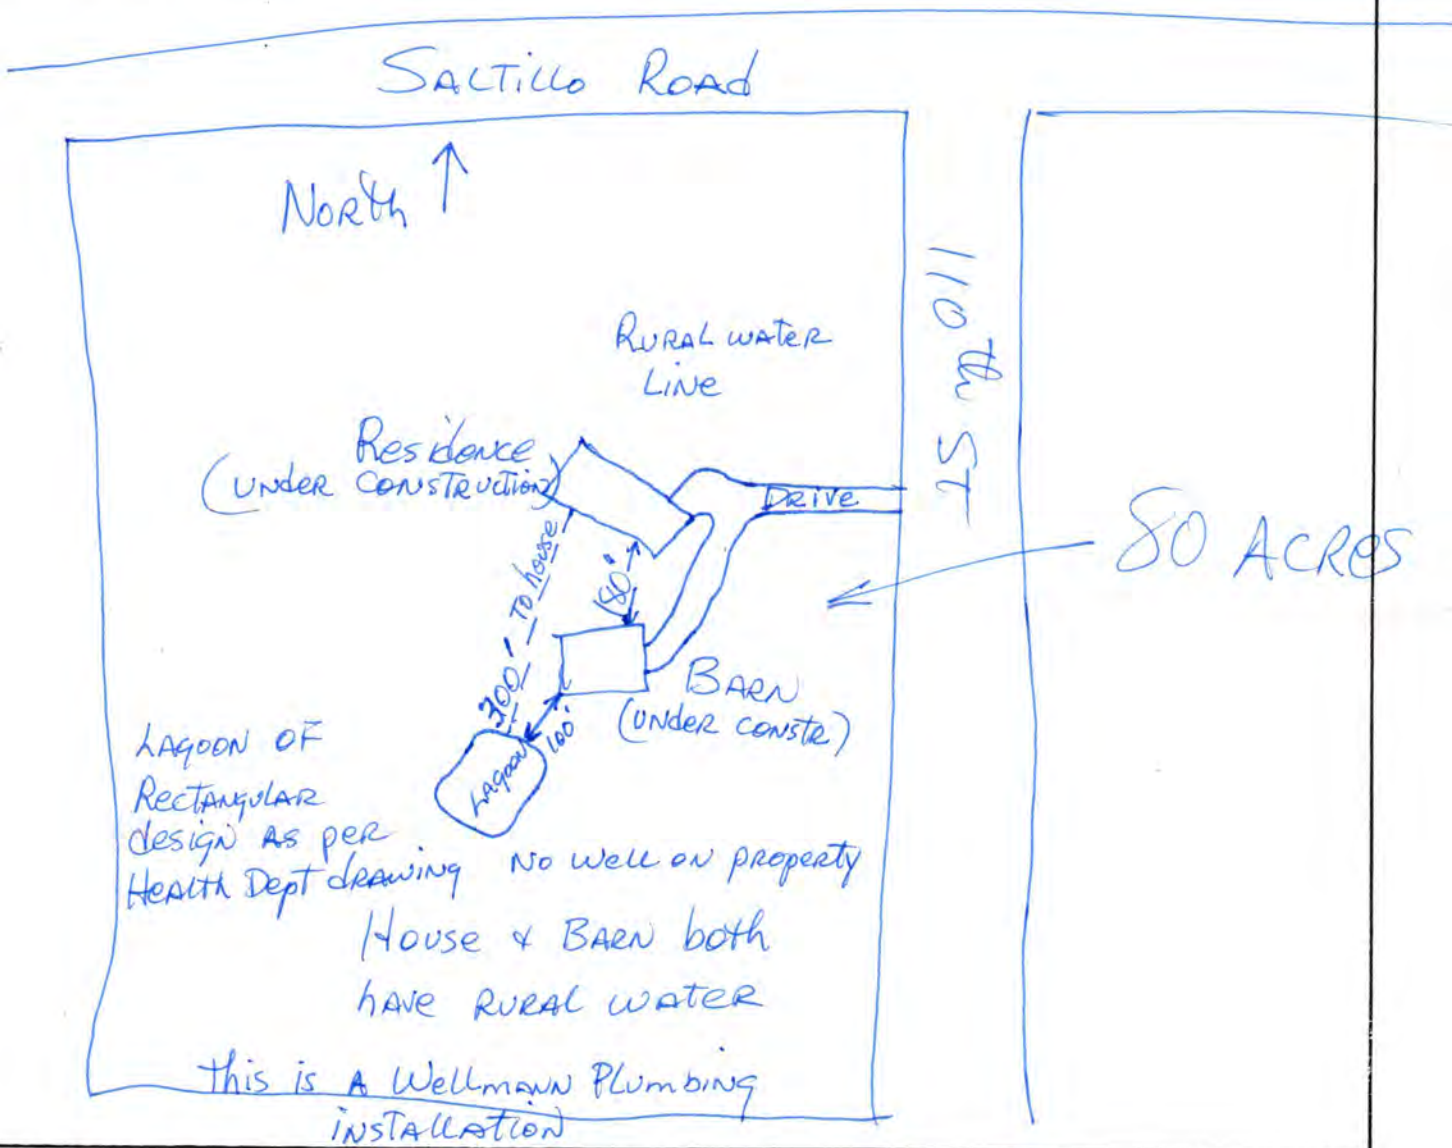


REVIEWING ACTION

Remarks :_____

_____

Date:_____

Minimum Design Requirement
1. Capacity of Septic Tank_____gals.
2. Total Length of Laterals_____ft.
3. With a Trench Width of_____in.
4. Total Area of Lateral needed____sq.ft.


_____
Signature of Reviewing Official

Wellmann Plumbing

110th & Saltillo

Heinrich Const.

Dye Residence

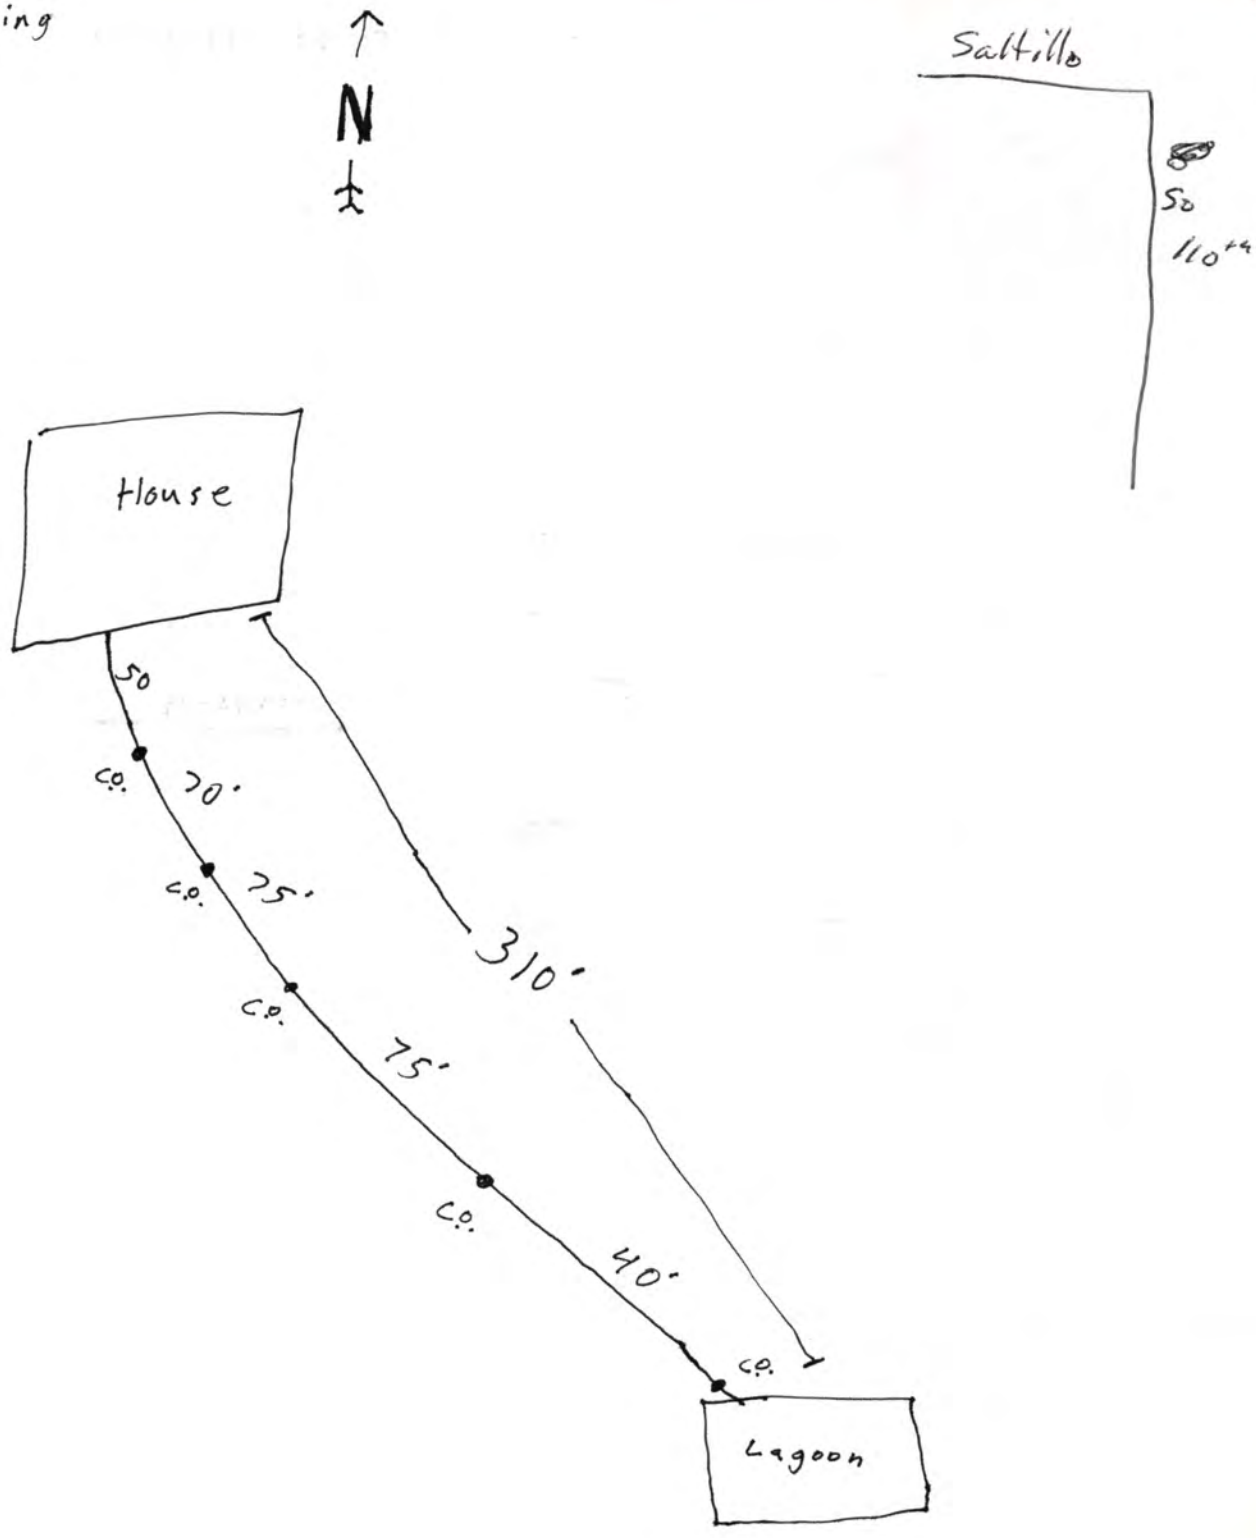

50 70 75 75 40

FORM 20104-0477
PLANS & SPECIFICATIONS FOR SEWAGE DISPOSAL SYSTEM (Annex to Application)
City Ordinance No. 9150 ☐
County Resolution No. 2832 ☐

LINCOLN-LANCASTER COUNTY HEALTH DEPARTMENT
Division of Environmental Health
2200 St. Marys Avenue
Lincoln, Nebraska 68502
Phone: 471-7800

D

DATE: 11-10-92

FILE NO. _____


SPECIFICATIONS AS BUILT

A. BUILDING SEWER:
1. Material Scheduled 40; Diameter 4 in.
2. Distance above basement floor _____ in., or below basement floor 12 in.
3. Distance between dwelling and septic tank ____ ft.
4. Number of clean-outs 5.
5. Distances to:
Well or Suction Line _____ ft.; Stream _____ ft.; Pressure Line 75 ft.; Property Line 700 ft.

B. SEPTIC TANK:
1. Material ____; No. of compartments _____.
2. Capacity _____ gals.;
3. Factory Built: Yes ☐ No ☐
(Company _____)
4. Manholes: Over Inlet; diam. _____ in.
Over Outlet; diam. _____ in.
Riser Above ☐ Below ☐ Grade ____ in.
5. Inlet: Baffle ☐ ; or Tee ☐
6. Outlet: Baffle ☐ ; or Tee ☐
7. Depth of top of tank below finished grade _____ in.
8. Distances to:
Well or Suction Line _____ ft.; Stream _____ ft.; Pressure Line _____ ft.; Property Line _____ ft.

C. DISTRIBUTION BOX:
1. Material _____; Number - available outlets _____.
2. Factory Built: Yes ☐ No ☐
(Company _____)
3. Distance from Septic Tank _____ ft.

D. ~~ABSORPTION FIELD~~ Lagoon: (Provide as built drawings on back of this form)
1. Type: Half Rounds ☐ Perforated Pipe ☐
Diameter of Half Round _____ or Perforated Pipe _____.
Material: fiberglass ☐ ; plastic ☐ ; concrete ☐ ; other _____.
2. Lateral Lines:
Number ___; Length of each line _____, _____, _____, _____, _____ ft.;
Total length of laterals _____ ft.;
Distance between lateral lines ____ ft.
3. Trench dimensions: Width _____ ft.; Slope _____ in/100 ft.; Average Depth _____ in.
4. Filter Material: _____,
Depth of Material _____ in.
5. Distances to:
Well or Suction Line _____ ft.; Stream _____ ft.; Pressure Line _____ ft.; Property Line _____ ft.

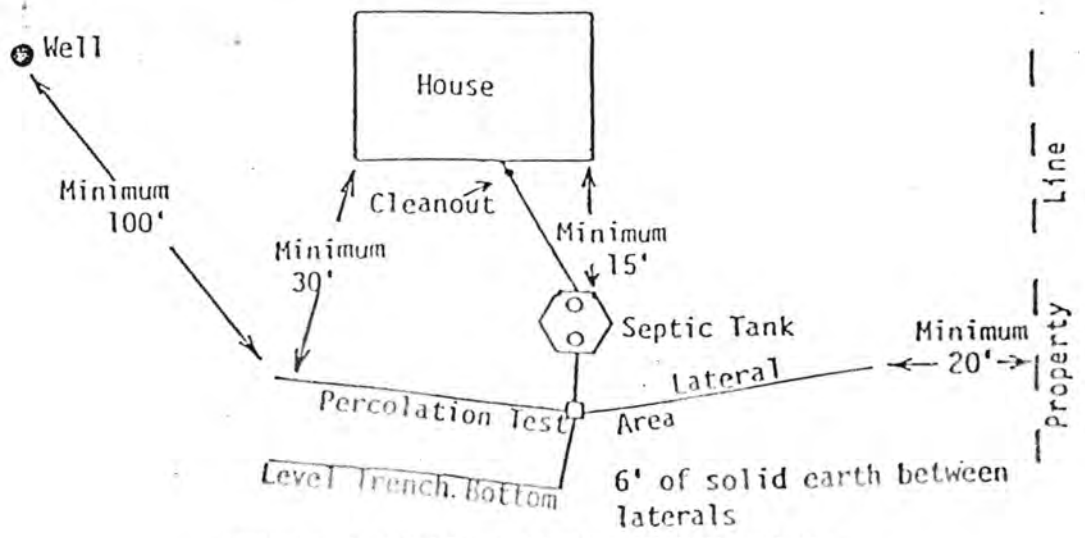


TYPICAL INDIVIDUAL SEWAGE SYSTEM DESIGN

# LINCOLN-LANCASTER COUNTY HEALTH DEPARTMENT

ENVIRONMENTAL HEALTH DIVISION

2200 St. Marys Ave Lincoln, NE 68502-3785 (402) 471-8000

NON TRANSFERABLE

## P E R M I T

Permit
SEWAGE INSTALLATION

No. 92380092901

Issued 11/03/92
Expires 05/03/93
Revenue Code 18754

Establishment
HEINRICH CONSTRUCTION
T11N R28 SEC 5
LOT 8
12600 MILL ROAD

FEES: $150.00

TOTAL $150.00

Permittee
HEINRICH CONSTRUCTION
2601 S 58 ST
APT #13
LINCOLN NE 68506

Issued By M. Jane Ford
Health Director

THIS LICENSE OR PERMIT IS ISSUED SUBJECT TO REVOCATION AS PROVIDED BY LAW
"POST IN A PROMINENT PLACE"

FORM 20103-0477
REQUEST FOR SITE CLEARANCE AND PERMIT
FOR INDIVIDUAL SEWAGE DISPOSAL SYSTEM
City Ordinance No. 9150 ☐
County Resolution No. 2832 ☒

LINCOLN-LANCASTER COUNTY HEALTH DEPARTMENT
Division of Environmental Health
2200 St. Marys Avenue
Lincoln, Nebraska 68502
Phone: 471-7800

A

FILING FEE: $_____

FILE NO._____

DATE: 10-26-92

The undersigned hereby requests SITE CLEARANCE and PERMIT to construct an Individual Sewage Disposal System in conformance with appropriate resolution or ordinance, as described herein:

1. Legal description of property: Twp. 8N ; Range 7E ; Section 1 ; Block _____ : Lot _____ : Addition _____
   Street Address 110th & Saltillo Road, County — East ½ of N.E. Qtr

2. Property Use: Residential ☒ ; Commercial ☐ ; Other Use ☒
   No. of Bedrooms 3 . Describe FARM (80 ACRES) + or —

3. Type of Individual Sewage Disposal System: Septic Tank ☐ ; Other ☒ LAGOON

4. Distance to public sewer: miles _____ ft.

No village or city jurisdiction

Heimich Construction
Signature of Applicant (Owner or Lessee)

2601 S 58th #13 Lincoln Ne 68506
Address 488-9223

(Do not write below this double line) MARTIN Dye Residence

1. Health Department: Date Rec'd. 10/30/92. Date Frwd. 10/30/92. ACTION: Approved ☒ Disapproved ☐ Signature: Jerrold C. Hood

2. Supt. Bldg. Insp.: or Village Clerk: Date Rec'd. _____. Date Frwd. _____. ACTION: Approved ☒ Disapproved ☐ Signature: [illegible]

3. City or County Engineer: Date Rec'd. 10-30-92 Date Frwd. 10-30-92. ACTION: Approved ☐ Disapproved ☐ Signature: [illegible]

REMARKS OR REASONS FOR DISAPPROVAL Need Fence Bentonite etc 11-10-92

Site Visits:
Date: 11-10-92 by: P.D
Date: _____ by: _____
Date: _____ by: _____

White: Health Dept. Copy
Yellow: Engineers Copy
Pink: Bldg. Inspector's Copy

INSTALLATION FINAL WRITTEN APPROVAL
Date: [redacted] By: Paul Prutzman

Rec'd 10-29-92 #155641 $150.00

FORM 23-43

FORM 20102-0477
PRELIMINARY PLANS & SPECIFICATIONS FOR SEWAGE DISPOSAL SYSTEM (Annex to Application)
City Ordinance No. 9150 ☐
County Resolution No. 2832 ☐


LINCOLN-LANCASTER COUNTY HEALTH DEPARTMENT
Division of Environmental Health
2200 St. Marys Avenue
Lincoln, Nebraska 68502
Phone: 471-7800

**C**

Sketch of property showing Percolation Test hole locations, well, residence, direction and property line.

FILE NO._____

Indicate on sketch if residence and well are exisiting or proposed.

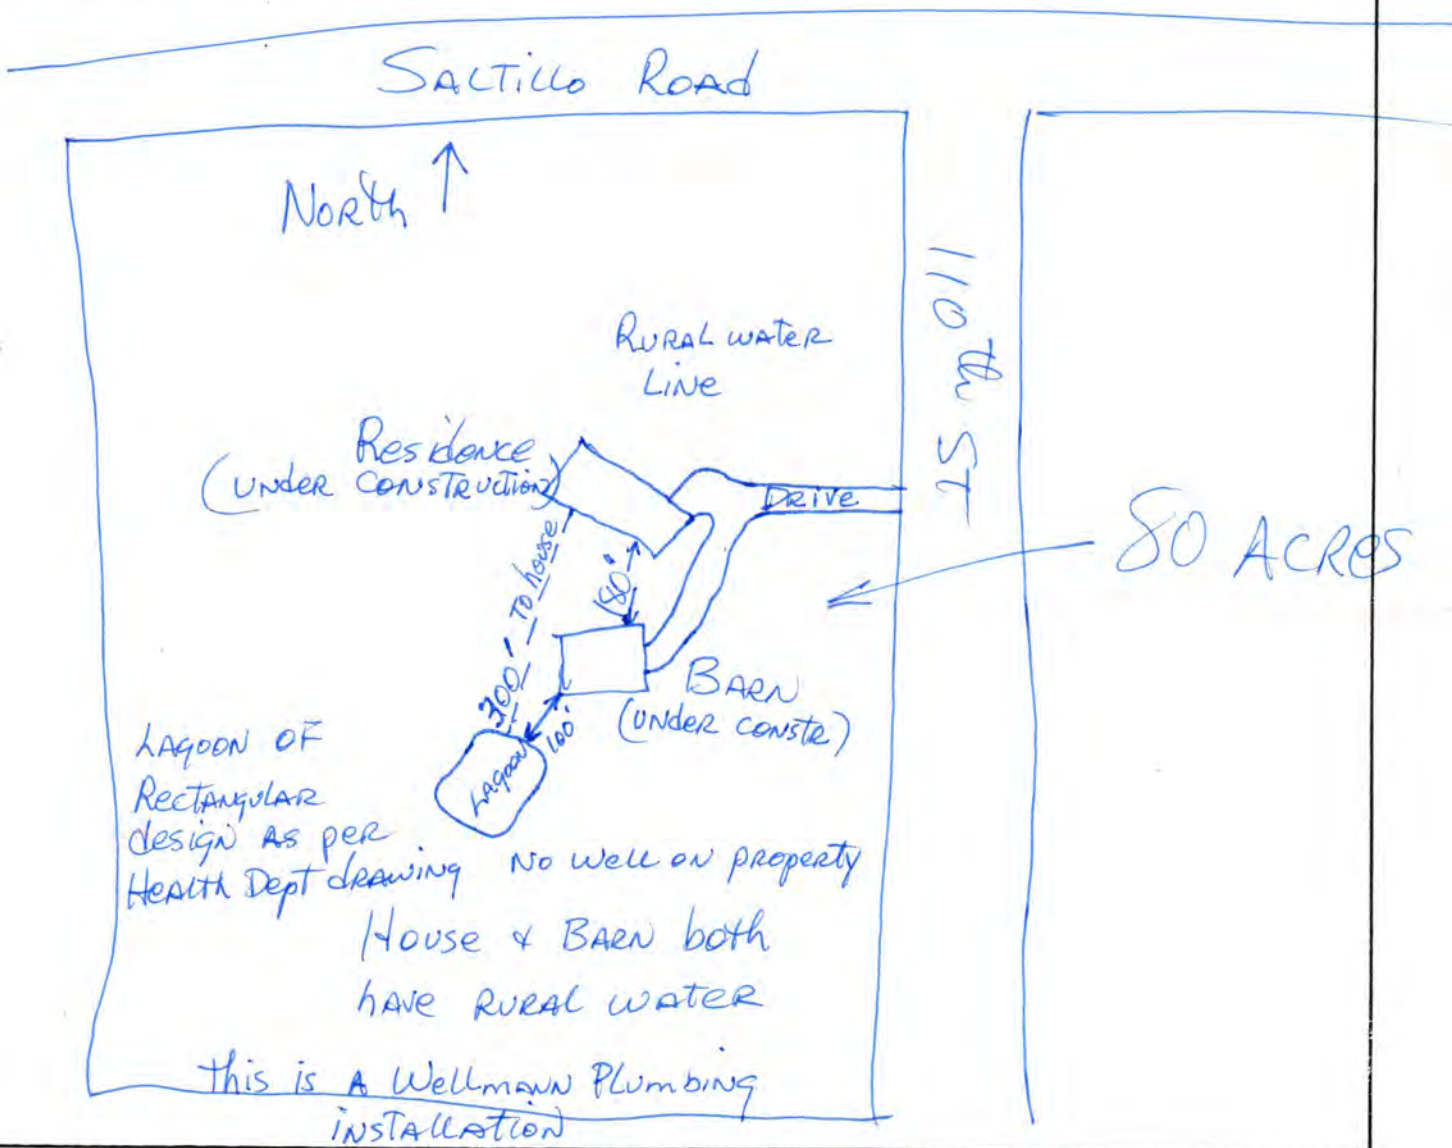


REVIEWING ACTION

Remarks :_____

_____

Date:_____

Minimum Design Requirement
1. Capacity of Septic Tank_____gals.
2. Total Length of Laterals_____ft.
3. With a Trench Width of_____in.
4. Total Area of Lateral needed____sq.ft.


_____
Signature of Reviewing Official

Wellmann Plumbing

110th & Saltillo

Heinrich Const.

Dye Residence

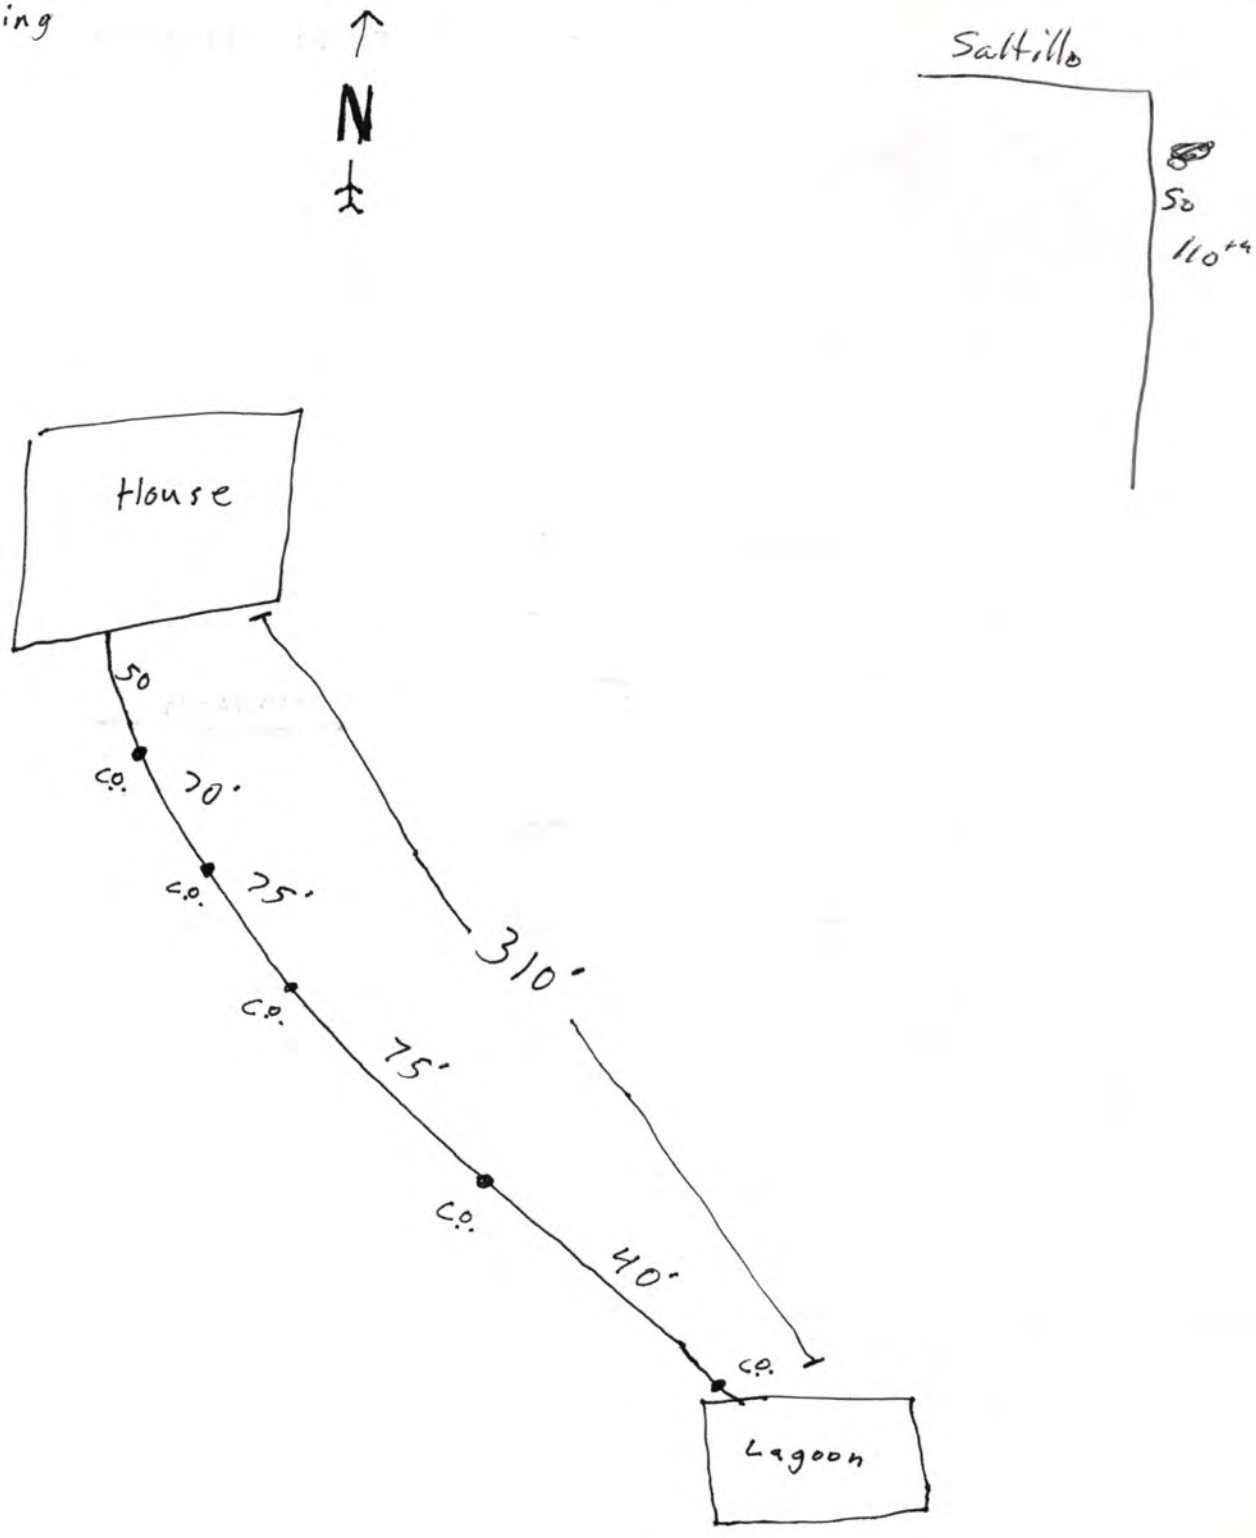

50 70 75 75 40

FORM 20104-0477
PLANS & SPECIFICATIONS FOR SEWAGE DISPOSAL SYSTEM (Annex to Application)
City Ordinance No. 9150 ☐
County Resolution No. 2832 ☐

LINCOLN-LANCASTER COUNTY HEALTH DEPARTMENT
Division of Environmental Health
2200 St. Marys Avenue
Lincoln, Nebraska 68502
Phone: 471-7800

D

DATE: 11-10-92

FILE NO. _____


SPECIFICATIONS AS BUILT

A. BUILDING SEWER:
1. Material Scheduled 40; Diameter 4 in.
2. Distance above basement floor _____ in., or below basement floor 12 in.
3. Distance between dwelling and septic tank ____ ft.
4. Number of clean-outs 5.
5. Distances to:
Well or Suction Line _____ ft.; Stream _____ ft.; Pressure Line 75 ft.; Property Line 700 ft.

B. SEPTIC TANK:
1. Material ____; No. of compartments _____.
2. Capacity _____ gals.;
3. Factory Built: Yes ☐ No ☐
(Company _____)
4. Manholes: Over Inlet; diam. _____ in.
Over Outlet; diam. _____ in.
Riser Above ☐ Below ☐ Grade ____ in.
5. Inlet: Baffle ☐ ; or Tee ☐
6. Outlet: Baffle ☐ ; or Tee ☐
7. Depth of top of tank below finished grade _____ in.
8. Distances to:
Well or Suction Line _____ ft.; Stream _____ ft.; Pressure Line _____ ft.; Property Line _____ ft.

C. DISTRIBUTION BOX:
1. Material _____; Number - available outlets _____.
2. Factory Built: Yes ☐ No ☐
(Company _____)
3. Distance from Septic Tank _____ ft.

D. ~~ABSORPTION FIELD~~ Lagoon: (Provide as built drawings on back of this form)
1. Type: Half Rounds ☐ Perforated Pipe ☐
Diameter of Half Round _____ or Perforated Pipe _____.
Material: fiberglass ☐ ; plastic ☐ ; concrete ☐ ; other _____.
2. Lateral Lines:
Number ___; Length of each line _____, _____, _____, _____, _____ ft.;
Total length of laterals _____ ft.;
Distance between lateral lines ____ ft.
3. Trench dimensions: Width _____ ft.; Slope _____ in/100 ft.; Average Depth _____ in.
4. Filter Material: _____,
Depth of Material _____ in.
5. Distances to:
Well or Suction Line _____ ft.; Stream _____ ft.; Pressure Line _____ ft.; Property Line _____ ft.

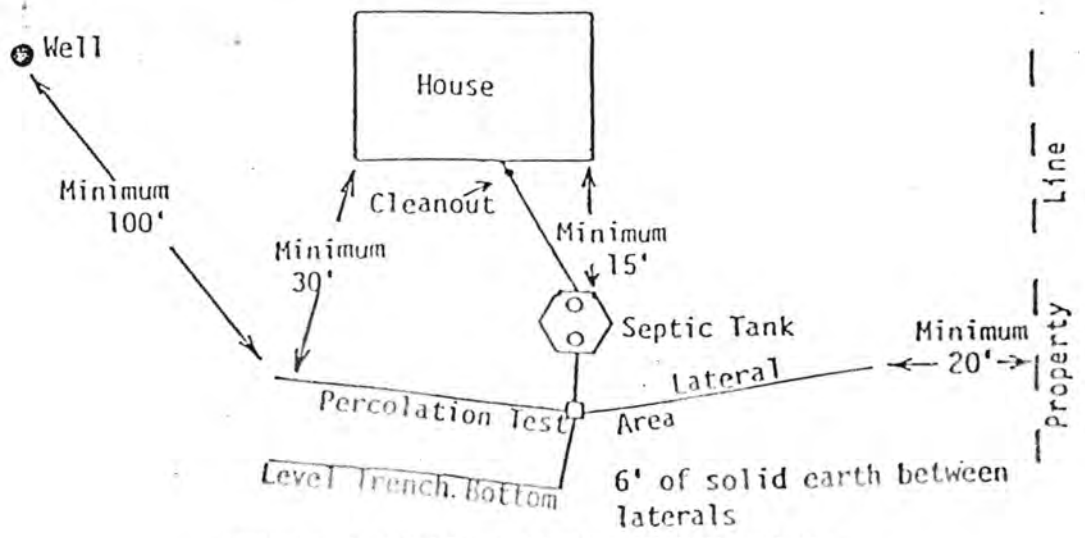


TYPICAL INDIVIDUAL SEWAGE SYSTEM DESIGN