Lincoln-Lancaster County Health Department

ENVIRONMENTAL HEALTH DIVISION
3140 N STREET · LINCOLN, NE 68510-1514 (402) 441-8000

Permit

SEWAGE INSTALLATION
LAGOON

Permit # 00380218801

Issued 05/17/00
Expires 11/17/00
Revenue Code 3157

Establishment

MARILYN KUSTER
T8N R7E SEC 13 QTR SW
SE 1/4 OF SW 1/4
9900 ROCA RD--ROCA

FEES: $150.00

Permitee

MARILYN KUSTER
9900 ROCA RD
ROCA NE 68430

TOTAL: $150.00

Leon F. Vinci, MPH, Health Director

• POST IN A PROMINENT PLACE • NOT TRANSFERABLE

013131

Lincoln-Lancaster County Health Department
Environmental Health Division
3140 "N" Street • Lincoln, NE 68510-1514
Phone: 402-441-8022

A

Permit Number: 003802/00

Sewage Disposal System

Request for Site Clearance and Permit

Include Form B, Form C and Applicable Fees with this Application.

☐ Septic System ☒ Lagoon ☐ Other (Refer to Form C)

The undersigned hereby requests site clearance and permit to construct a Sewage Disposal System in conformance with appropriate resolution or ordinance, as described herein:

PLEASE PRINT OR TYPE

A. System Location (Indicate correct number and street)

Address 9900 Roca Rd. (no rural route) City Roca NE, Zip 68430

Legal Description SE ¼ of SW ¼ Section 13 Township 8N Range 7E Subdivision ____ Addition ____ Block ____ Lot ____

Geographical Location (if known): Longitude ____ Latitude ____

☐ Check if system mail address is not the same as the owner's address

B. Owner

Name Marilyn Kuster Signature ____

Address 9900 Roca Rd. City/State/Zip Roca, Ne 68430

☐ Check if owner designed system Home Phone ____ Work Phone ____

C. Contractor

Name Brad Southwick Company Name Southwick Sewer & Drain

Address 17201 S. 172nd St City/State/Zip Hickman, Ne 68372

☐ Check if contractor designed system Work Phone 430-7606

D. Engineer/Installer ☐ Check and complete if engineer designed system

Designer Name ____ Firm ____ Work Phone ____

E. This System Will Serve a

☒ Residential Dwelling Number of Bedrooms 2 Is there a Whirlpool Bathtub YES (NO)

☐ Commercial Establishment/Other Facility Specify ____

Design flow in gallons per day ____ Type of Wastewater: ☐ Domestic ☐ Non-Domestic.

DO NOT WRITE BELOW THIS LINE

Approval Process ☐ Municipal Code 24.38 ☒ County Resolution No. 2832

1. **Health Department** Date rec'd 5/16/00 Date frwd 5/17/00 ACTION ☒ Approved ☐ Disapproved Signature Jerrold C. Hood
2. **Supt. Bldg. Insp. or Village Clerk** Date rec'd ____ Date frwd ____ ACTION ☐ Approved ☐ Disapproved Signature ____
3. **City or County Engineer** Date rec'd ____ Date frwd ____ ACTION ☐ Approved ☐ Disapproved Signature ____

5/17/00 Need ~~drawing~~, fence, etc. f.c.#

Installation Final Written Approval

By Jerrold C. Hood

Date DECEMBER 4, 2000

Business Office Use Only

Date Rec'd 05/17/00

Amt Paid 150 ck

Rec'd By ____ Cash/Check No. 3916

FORM 23-100 10-96 White - Health Dept. Yellow - Engineer Pink - Bldg. Inspector


Lincoln-Lancaster County Health Department
Environmental Health Division
3140 "N" Street • Lincoln, NE 68510-1514
Phone: 402-441-8022

C

Permit Number: 00380216B

Sewage Disposal System
Preliminary Plan Specifications

Draw a plot plan showing system location, lines, distribution box, tank and laterals, percolation test hole locations, well, residence, compass direction and property lines. Indicate on drawing if residence and well are existing or proposed.

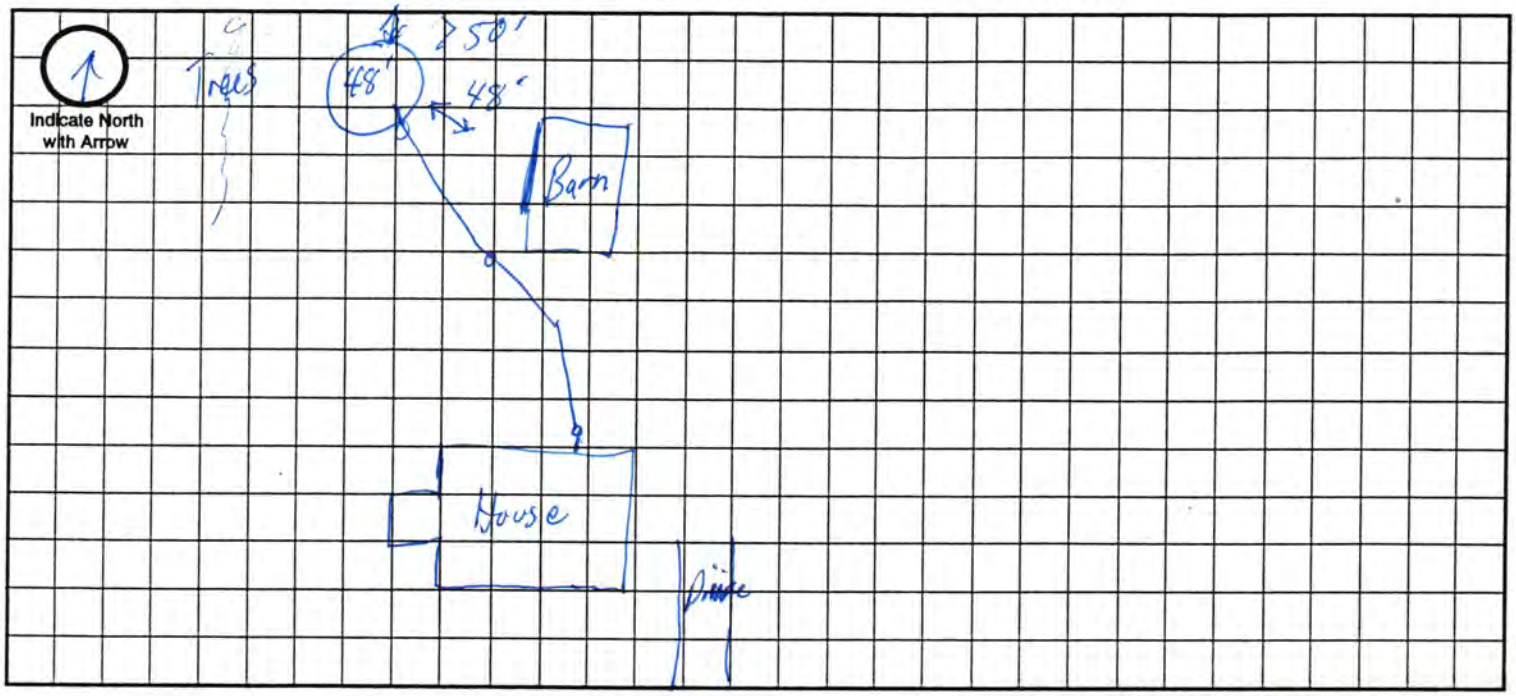

Approximate Scale: _____ ft. = _____ grid line/s

A. System Location (Indicate correct number and street)

Address (no rural route) 9900 Roca Road City Roca NE, Zip 68430

B. Proposed Septic Tank/s

Tank Material: ☐ Concrete ☐ Plastic ☐ Other _____

C. Proposed Absorption System (See Form B for Percolation Information)

Percolation Rate _____ (min. per inch) Soil Type: _____ Land Slope: _____ %

Type of Absorption System: ☐ Trench ☐ Bed ☐ Other _____

Total Square Feet of Field Required: _____ sq. ft.

Type of Lateral: ☐ Half-Moon ☐ Perforated Pipe ☐ Other Lateral Material: _____

Capacity of Septic Tank _____ gals Number of Absorption Beds: _____ Number of Distribution Laterals per Bed _____

Total Length of Laterals _____ ft. Number of Trenches _____ Trench Width _____

D. Setbacks Check the Boxes Below if the Required Setback has been Satisfied

Distance From	Private Well	Public Well	Surface Water	Gound Water	Pressure Water Lines	Property Lines	Foundations Yours	Foundations Neighbors	All Other Setbacks
Tank (ft)	50 ☐	500 ☐	50 ☐	NA ☐	25 ☐	20 ☐	15 ☐	25 ☐	☐
Field (ft)	100 ☐	500 ☐	50 ☐	4 ☐	30 ☐	20 ☐	30 ☐	40 ☐	☐
Lagoon (ft)	100 ☒	500 ☒	50 ☒	N/A ☐	30 ☒	50 ☒	100 ☒	200 ☒	☒

E. Required Signatures

Home Building Contractor EXISTING Date _____

Installer Brad Smith Date 5-16-00

FORM 23-102 10-96

Lincoln-Lancaster County Health Department
Environmental Health Division
3140 "N" Street • Lincoln, NE 68510-1514
Phone: 402-441-8022

D

Permit Number: 003802188

Sewage Disposal System

As Built Plans & Specifications

Date 5-18-00

System Location (Indicate correct number and street)

Address 9900 Roca Rd. (no rural route) City Roca NE, Zip 68430

A. Building Sewer

1. Material: Sch 40 PVC
   Diameter: 4 in.
2. Distance above basement floor: 42 in.
   or distance below basement floor: _____ in.
3. Distance between dwelling and septic tank: Lagoon 189' ft.
4. Number of clean-outs: 4
5. Distances to: well or suction line > 50 ft.
   stream > 50 ft.
   pressure line > 50 ft.
   property line > 50 ft.

B. Septic Tank

1. Material: _____
   Number of compartments: _____
2. Capacity: _____ gal.
3. Factory built: ☐ Yes ☐ No
4. Manholes: Over inlet, diameter _____ in.
   Over outlet, diameter _____ in.
   Riser: ☐ above ☐ below grade _____ in.
5. Inlet: ☐ baffle ☐ tee
6. Outlet: ☐ baffle ☐ tee
7. Depth to top of tank, below unfinished grade: _____ in.
8. Distances to: Well or suction line _____ ft.
   Stream _____ ft.
   Pressure line _____ ft.
   Property line _____ ft.

C. Distribution Box

1. Material: _____
   Number available outlets: _____
2. Factory built: ☐ Yes ☐ No
3. Distance from septic tank: _____ ft.

D. Absorption Field


(Provide as-built drawings on back of this form)

1. Type: ☐ Half rounds ☐ Perforated pipe
   Diameter of half round: _____
   or perforated pipe: _____
   Material: ☐ fiberglass ☐ plastic ☐ concrete
   ☐ other _____
2. Lateral lines: Number _____
   Length of each line: _____ ft. _____ ft.
   _____ ft. _____ ft., _____ ft.
3. Trench dimensions: Width _____ ft.
   Slope _____ in/100 ft.
   Average depth _____ in
4. Filter material: _____
   Depth of material _____ in.
5. Distances to: Well or suction line _____ ft.
   Stream _____ ft.
   Pressure line _____ ft.
   Property line _____ ft.

Complete "As Built" drawing on back of this form.


Indicate North with Arrow

Individual Sewage System Design (Example)

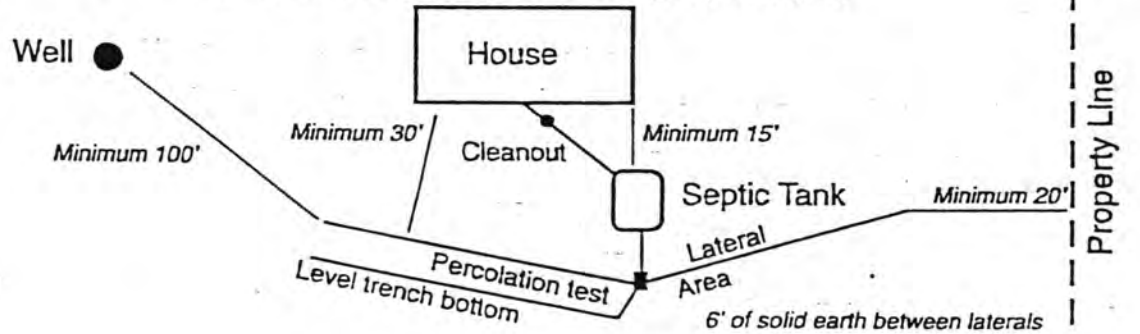

FORM 23-103 10-96

As Built Drawing

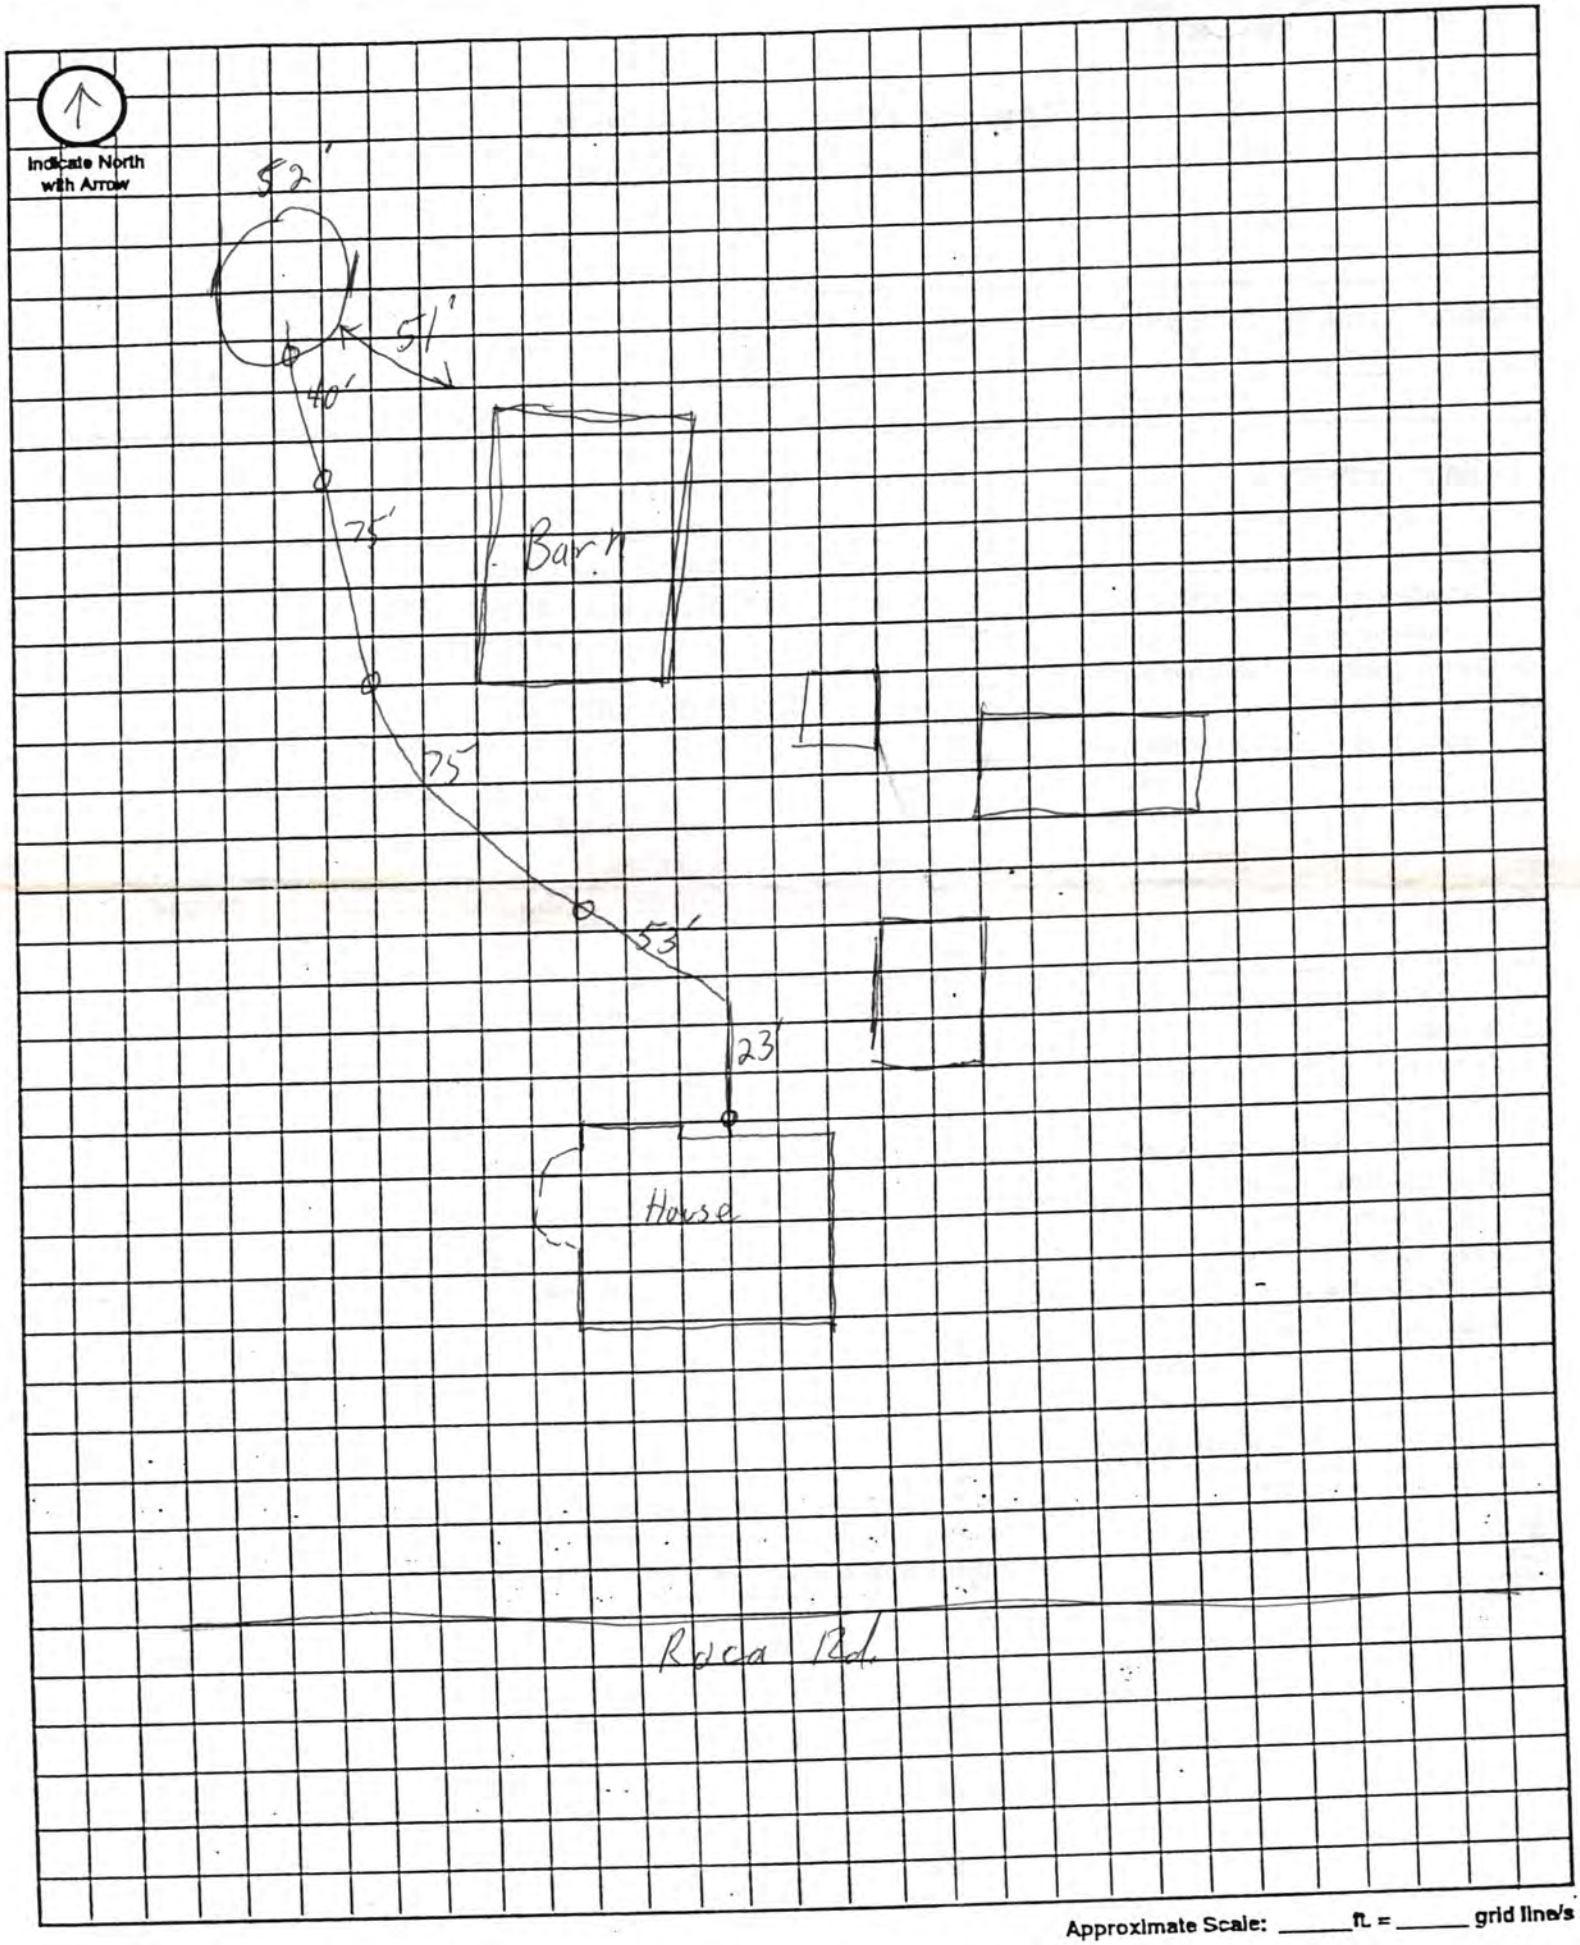

Approximate Scale: _____ ft. = _____ grid line/s