LINCOLN-LANCASTER COUNTY HEALTH DEPARTMENT

ENVIRONMENTAL HEALTH DIVISION

2200 St. Marys Ave Lincoln, NE 68502-3785 (402) 441-8000

NON TRANSFERABLE

PERMIT

Permit
SEWAGE INSTALLATION

No. 94380116901

Issued 05/24/94
Expires 11/24/94
Revenue Code 18754

Establishment
DENNIS FREY
T8N R7E SEC 27
LOT 31
17601 S 82 STREET

FEES: $150.00

TOTAL $150.00

Permittee
DENNIS FREY
RR0001
BOX 0088A
HICKMAN NE 68372

Issued By M. Jane Ford
Health Director

THIS LICENSE OR PERMIT IS ISSUED SUBJECT TO REVOCATION AS PROVIDED BY LAW
"POST IN A PROMINENT PLACE"

RECEIVED MAY 24 1994

FORM 20103-0477
REQUEST FOR SITE CLEARANCE AND PERMIT
FOR INDIVIDUAL SEWAGE DISPOSAL SYSTEM
City Ordinance No. 9150 ☐
County Resolution No. 2832 ☒

LINCOLN-LANCASTER COUNTY HEALTH DEPARTMENT
Division of Environmental Health
2200 St. Marys Avenue
Lincoln, Nebraska 68502
Phone: 471-7800

A

FILING FEE: $_____

FILE NO._____

DATE: 5-13-94

The undersigned hereby requests SITE CLEARANCE and PERMIT to construct an Individual Sewage Disposal System in conformance with appropriate resolution or ordinance, as described herein:

1. Legal description of property: Twp. 8N ; Range 7E ; Section 27 ;
   Block _____ : Lot 31 : Addition _____
   Street Address 17651 S. 82nd

2. Property Use: Residential ☒ ; Commercial ☐ Other Use ☐
   No. of Bedrooms 3 . Describe _____

3. Type of Individual Sewage Disposal System: Septic Tank ☐ ; Other ☒ Lagoon

4. Distance to public sewer: _____ ft.

Ronnie Jay Do.
Signature of Applicant (Owner or Lessee)

RT#1 Box 88A Nickman NE 6832
Address

(Do not write below this double line)

1. Health Department: Date Rec'd. 5/13/94 . Date Frwd. _____ . ACTION: Approved ☒ Disapproved ☐ Signature: Jerrold C. Rodd

2. Supt. Bldg. Insp.: or Village Clerk: Date Rec'd. 5-19-94 . Date Frwd. 5-23-94 . ACTION: Approved ☒ Disapproved ☐ Signature: Annette Pool

3. City or County Engineer: Date Rec'd. 5-24-94 . Date Frwd. 5-24-94 . ACTION: Approved ☒ Disapproved ☐ Signature: Larry V. Burell

REMARKS OR REASONS FOR DISAPPROVAL _____

Site Visits:
Date: 6/15/94 by: L.a.C.H. Need fence & drawing.
Date: 8-23-94 by: _____
Date: _____ by: _____

INSTALLATION FINAL WRITTEN APPROVAL
Date: 8-24-94 By: Paul Hoffman

White: Health Dept. Copy
Yellow: Engineers Copy
Pink: Bldg. Inspector's Copy

FORM 23-43

FORM 20104-0477
PLANS & SPECIFICATIONS FOR SEWAGE DISPOSAL SYSTEM (Annex to Application)
City Ordinance No. 9150 ☐
County Resolution No. 2832 ☑

LINCOLN-LANCASTER COUNTY HEALTH DEPARTMENT
Division of Environmental Health
2200 St. Marys Avenue
Lincoln, Nebraska 68502
Phone: 471-7800

D

DATE: 10-13-94

FILE NO. _____

Lagoon


SPECIFICATIONS AS BUILT

A. BUILDING SEWER:
1. Material PVC ; Diameter 4 in.
2. Distance above basement floor _____ in., or below basement floor _____ in.
3. Distance between dwelling and septic tank _____ ft.
4. Number of clean-outs 2 .
5. Distances to:
Well or Suction Line _____ ft.; Stream _____ ft.; Pressure Line _____ ft.; Property Line _____ ft.

B. SEPTIC TANK:
1. Material _____ ; No. of compartments _____ .
2. Capacity _____ gals.;
3. Factory Built: Yes ☐ No ☐
(Company _____)
4. Manholes: Over Inlet; diam. _____ in.
Over Outlet; diam. _____ in.
Riser Above ☐ Below ☐ Grade _____ in.
5. Inlet: Baffle ☐ ; or Tee ☐
6. Outlet: Baffle ☐ ; or Tee ☐
7. Depth of top of tank below finished grade _____ in.
8. Distances to:
Well or Suction Line _____ ft.; Stream _____ ft.; Pressure Line _____ ft.; Property Line _____ ft.

C. DISTRIBUTION BOX:
1. Material _____ ; Number - available outlets _____ .
2. Factory Built: Yes ☐ No ☐
(Company _____)
3. Distance from Septic Tank _____ ft.

D. ABSORPTION FIELD: (Provide as built drawings on back of this form)
1. Type: Half Rounds ☐ Perforated Pipe ☐
Diameter of Half Round _____ or Perforated Pipe _____ .
Material: fiberglass ☐ ; plastic ☐ ; concrete ☐ ; other _____ .
2. Lateral Lines:
Number ___ ; Length of each line _____, _____, _____, _____, _____ ft.;
Total length of laterals _____ ft.;
Distance between lateral lines _____ ft.
3. Trench dimensions: Width _____ ft.;
Slope _____ in/100 ft.; Average Depth _____ in.
4. Filter Material: _____
Depth of Material _____ in.
5. Distances to:
Well or Suction Line _____ ft.; Stream _____ ft.; Pressure Line _____ ft.; Property Line _____ ft.

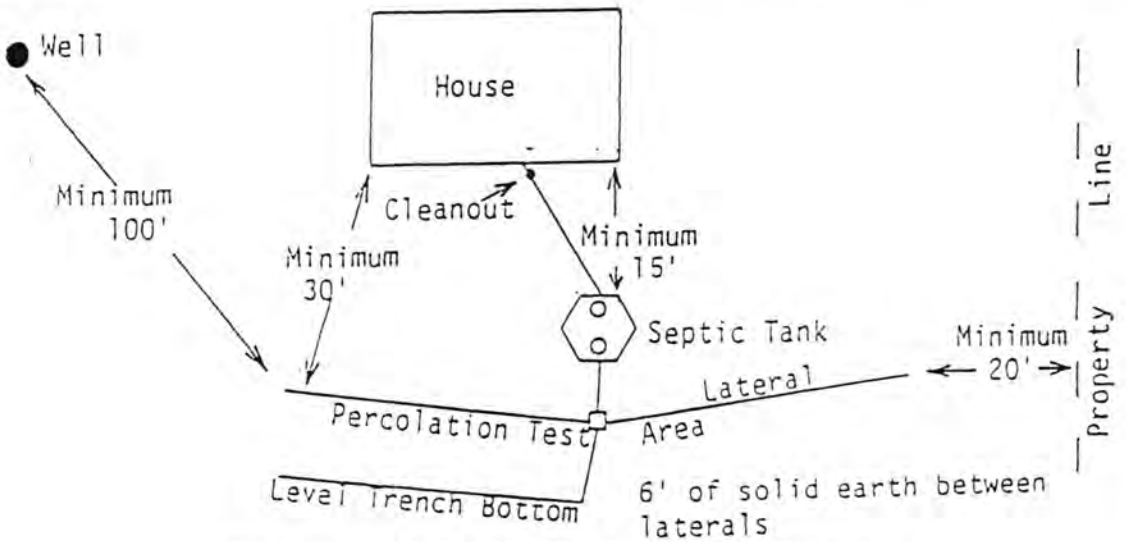



TYPICAL INDIVIDUAL SEWAGE SYSTEM DESIGN

THIS PLAT IS INTENDED TO SHOW AS ACCURATELY AS POSSIBLE THE RELATIONSHIP OF PARCELS BUT IS NOT INTENDED TO BE CONSTRUED AS SURVEY ACCURATE IN ANY MANNER.

SEC. 27-T.8 N.-R.7 E.

SALTILLO

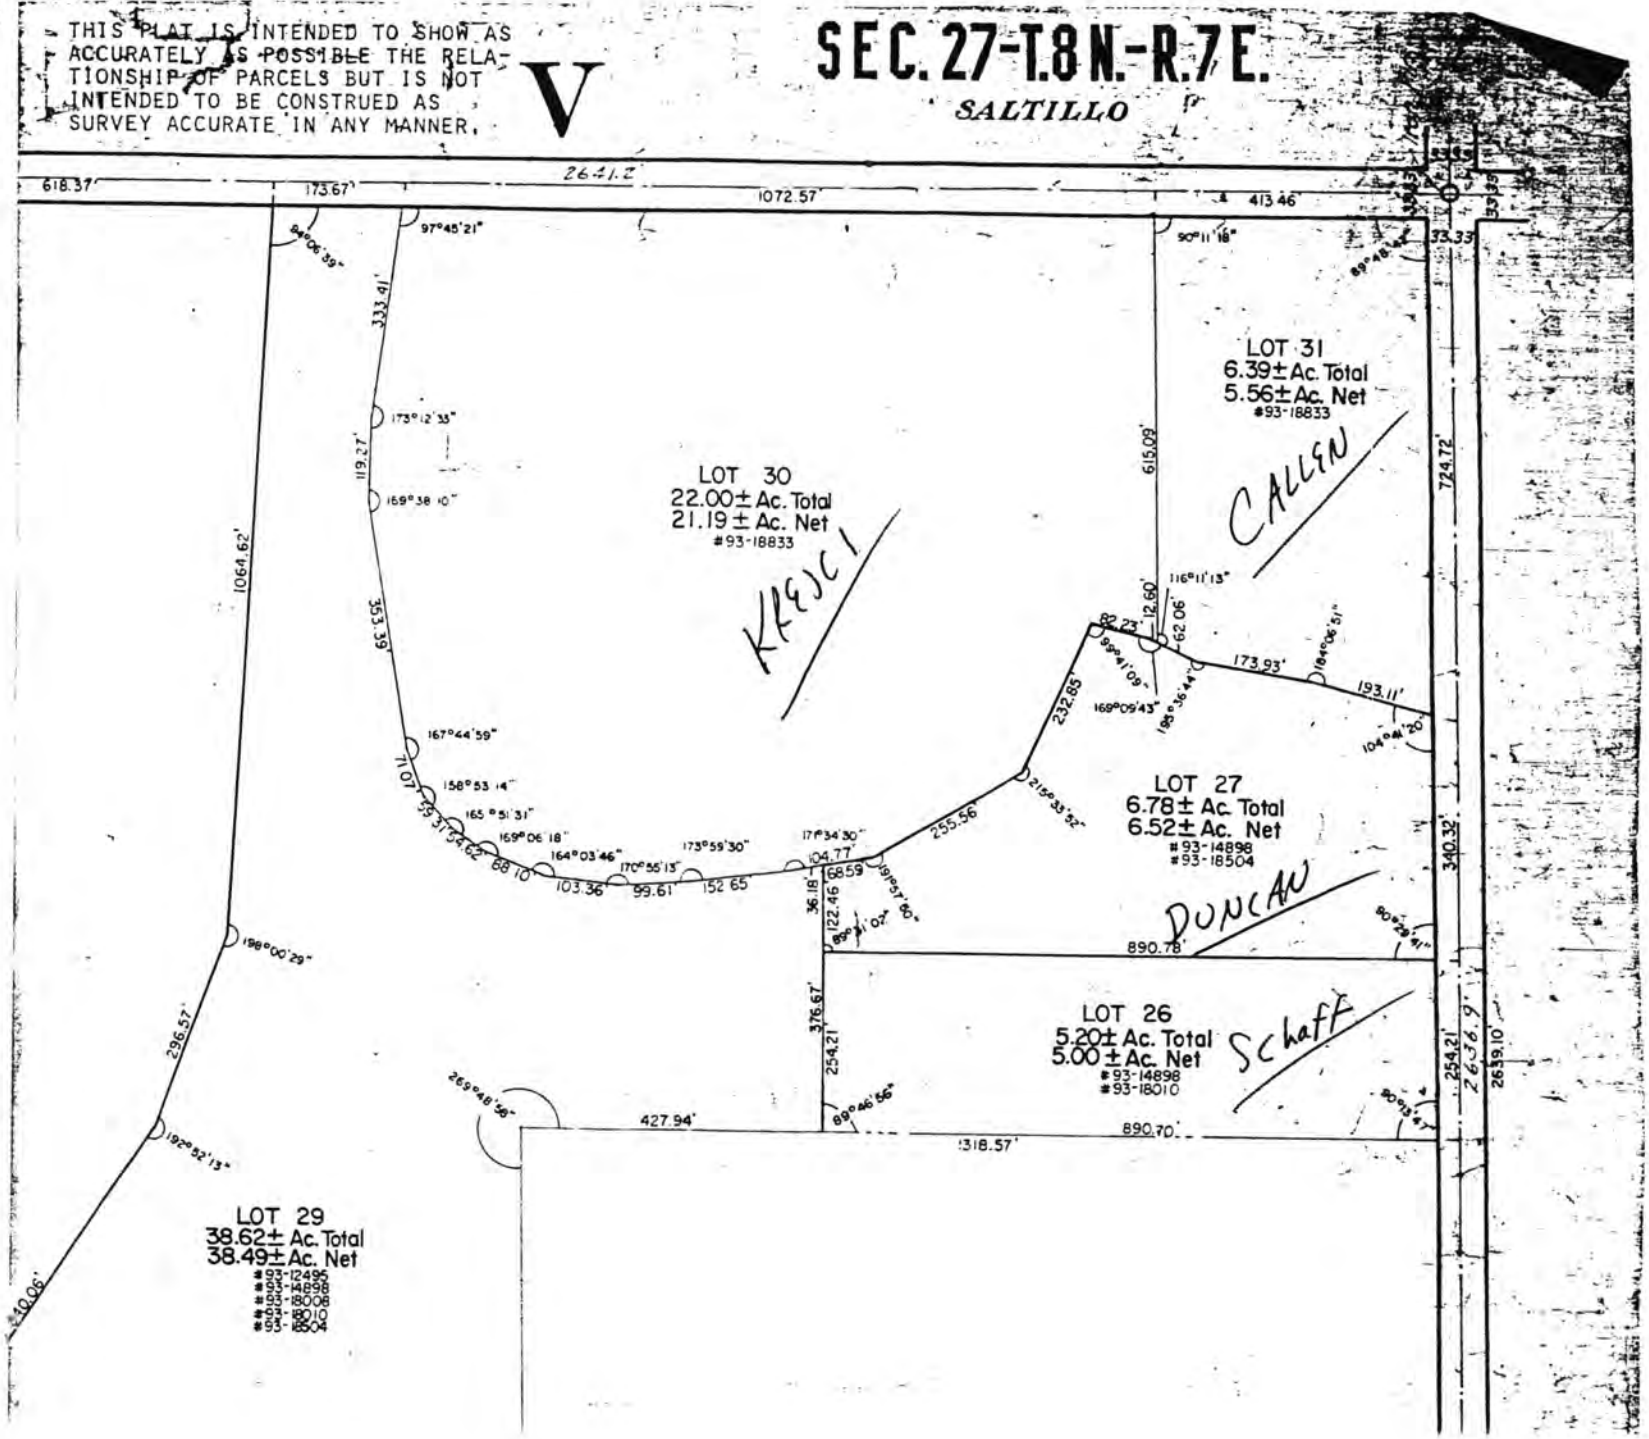

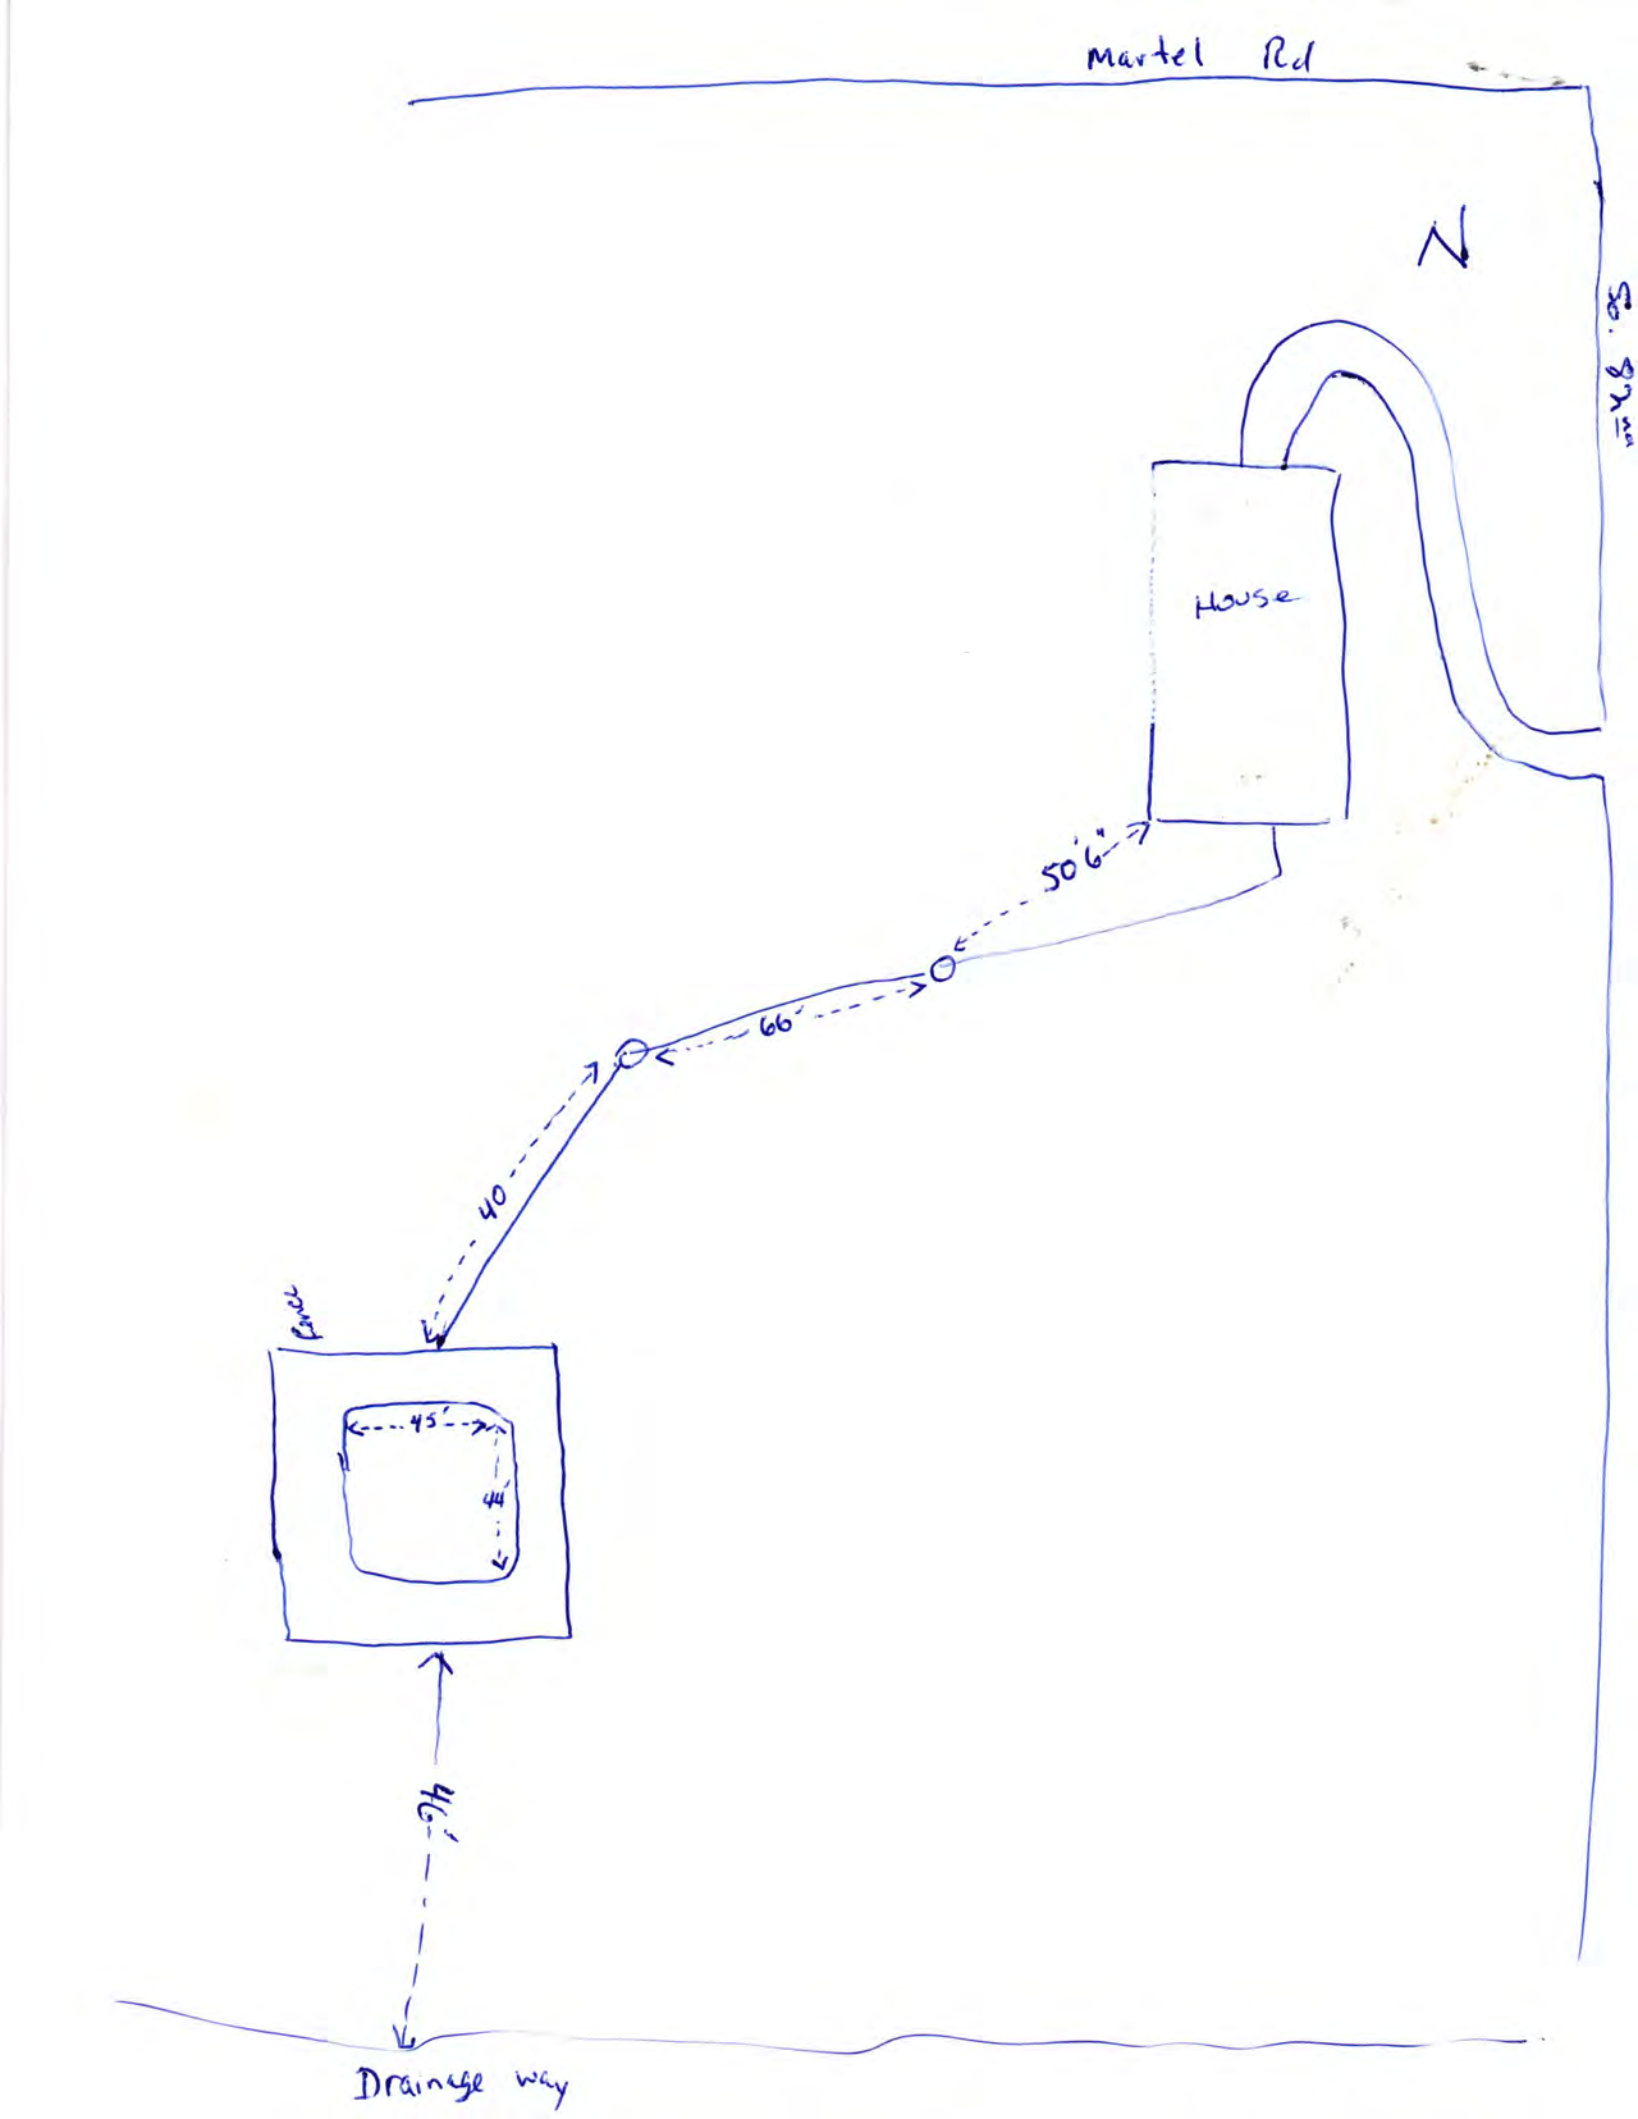
Martel Rd
N
House
50'6"
66'
40'
Fence
45'
46'
46'
Drainage way