LINCOLN-LANCASTER COUNTY HEALTH DEPARTMENT

3140 "N" STREET
ENVIRONMENTAL HEALTH DIVISION
Lincoln, NE 68510-1514
(402) 441-8000

NON TRANSFERABLE

PERMIT

Permit No. 98380181801

SEWAGE INSTALLATION
LAGOON

Issued 08/06/98
Expires 02/06/99
Revenue Code 3157

Establishment

KEN HOLM
T8N R7E SEC 30 QTR NW
NW QTR OF NW QTR
2501 MARTELL RD-ROCA

FEES: $150.00

PAID

TOTAL $150.00

Permittee

KEN HOLM
2501 MARTELL RD
ROCA NE 68430-9788

Issued By Health Director
Lincoln-Lancaster County Health Department

007934

THIS LICENSE OR PERMIT IS ISSUED SUBJECT TO REVOCATION AS PROVIDED BY LAW "POST IN A PROMINENT PLACE"

Lincoln-Lancaster County Health Department
Environmental Health Division
3140 "N" Street • Lincoln, NE 68510-1514
Phone: 402-441-8022

A

Permit Number:

Sewage Disposal System

Request for Site Clearance and Permit

Include Form B, Form C and Applicable Fees with this Application.

☐ Septic System ☒ Lagoon ☐ Other (Refer to Form C)

The undersigned hereby requests site clearance and permit to construct a Sewage Disposal System in conformance with appropriate resolution or ordinance, as described herein:

PLEASE PRINT OR TYPE

A. System Location (Indicate correct number and street)

Address 2501 Martell Rd or ~~RR 5 Box 55~~ (no rural route) City Roca NE, Zip 68~~30~~ 430

Legal Description NW (1/4) NW (1/4) 30 (Section) 8N (Township) 7E (Range) Subdivision Addition Block Lot

Geographical Location (if known): Longitude _____ Latitude _____

☐ Check if system mail address is not the same as the owner's address

B. Owner

Name Ken Holm Signature _____

Address 2501 Martell Rd. City/State/Zip Roca Ne 68~~30~~ 430

☐ Check if owner designed system Home Phone 792-2312 Work Phone _____

C. Contractor

Name Brad Southwick Company Name Southwick Sewer & Drain

Address 17201 So 72 City/State/Zip Hickman, Ne 68372

☐ Check if contractor designed system Work Phone 402 430-7606

D. Engineer/Installer ☐ Check and complete if engineer designed system

Designer Name _____ Firm _____ Work Phone _____

E. This System Will Serve a

☒ Residential Dwelling Number of Bedrooms 3 Is there a Whirlpool Bathtub YES (NO)

☐ Commercial Establishment/Other Facility Specify _____

Design flow in gallons per day_____ Type of Wastewater: ☐ Domestic ☐ Non-Domestic.

DO NOT WRITE BELOW THIS LINE

Approval Process ☐ Municipal Code 24.38 ☒ County Resolution No. 2832

1. **Health Department** Date rec'd 8/5/98 Date frwd 8/5/98 **ACTION** ☒ Approved ☐ Disapproved Signature Jerrold C. Hood
2. **Supt. Bldg. Insp. or Village Clerk** Date rec'd _____ Date frwd _____ **ACTION** ☐ Approved ☐ Disapproved Signature _____
3. **City or County Engineer** Date rec'd _____ Date frwd _____ **ACTION** ☐ Approved ☐ Disapproved Signature _____

8/5/98 J.C.H 4/19/99 Lower up system missing J.C.H

Installation Final Written Approval

By Jerrold C. Hood R.E.H.S.

Date JUNE 4, 1999

Business Office Use Only

Date Rec'd 8/5/98

Amt Paid $150.00

Rec'd By CW Cash/Check No. 3107

FORM 23-100 10-96 White - Health Dept. Yellow - Engineer Pink - Bldg. Inspector

Lincoln-Lancaster County Health Department
Environmental Health Division
3140 "N" Street • Lincoln, NE 68510-1514
Phone: 402-441-8022


C

Permit Number:

Sewage Disposal System

Preliminary Plan Specifications

Draw a plot plan showing system location, lines, distribution box, tank and laterals, percolation test hole locations, well, residence, compass direction and property lines. Indicate on drawing if residence and well are existing or proposed.

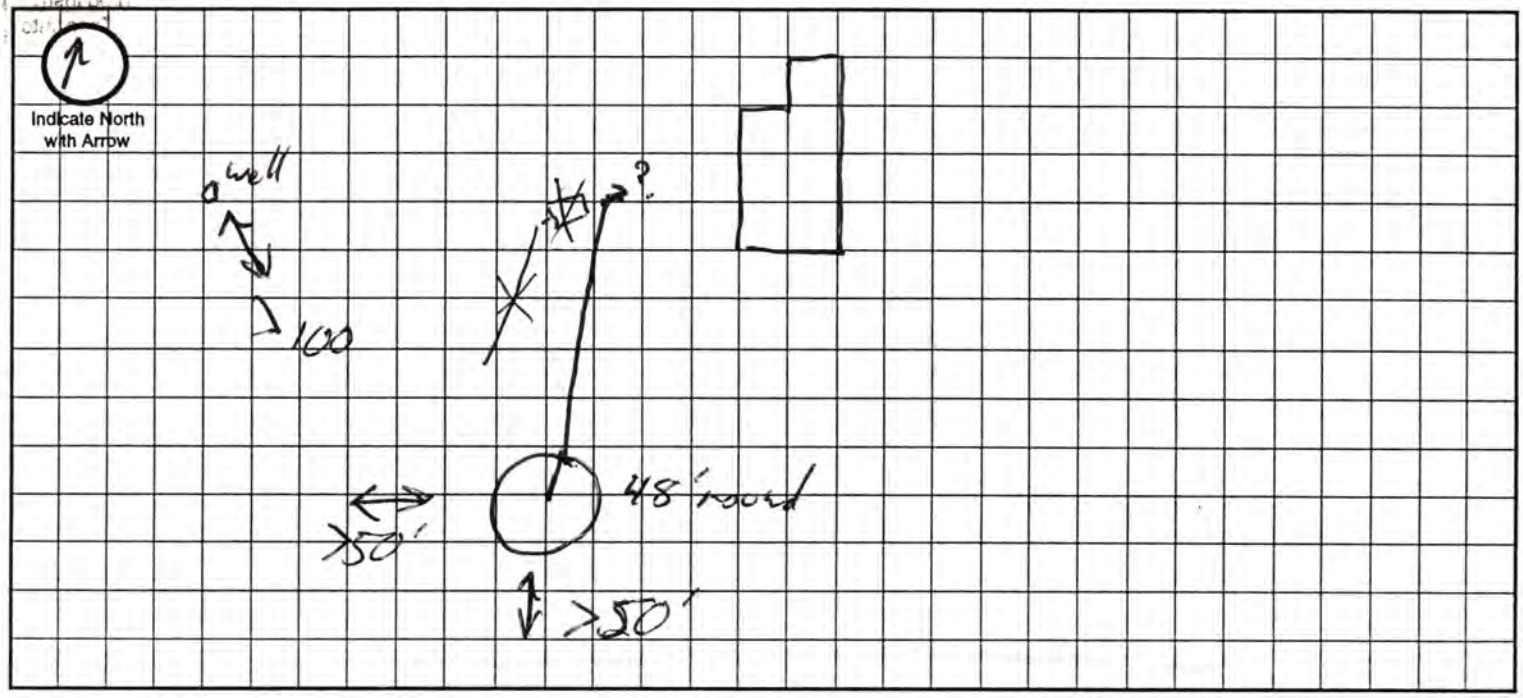

Approximate Scale: _____ ft. = _____ grid line/s

A. System Location (Indicate correct number and street)

Address (no rural route) 2501 Martell Rd / 17500 So 25 City Roca NE, Zip 68430

B. Proposed Septic Tank/s

Tank Material: ☐ Concrete ☐ Plastic ☐ Other _____

C. Proposed Absorption System (See Form B for Percolation Information)

Percolation Rate _____ (min. per inch) Soil Type: _____ Land Slope: _____ %

Type of Absorption System: ☐ Trench ☐ Bed ☐ Other _____

Total Square Feet of Field Required: _____ sq. ft.

Type of Lateral: ☐ Half-Moon ☐ Perforated Pipe ☐ Other Lateral Material: _____

Capacity of Septic Tank _____ gals Number of Absorption Beds: _____ Number of Distribution Laterals per Bed _____

Total Length of Laterals _____ ft. Number of Trenches _____ Trench Width _____

D. Setbacks Check the Boxes Below if the Required Setback has been Satisfied

Distance From	Private Well	Public Well	Surface Water	Gound Water	Pressure Water Lines	Property Lines	Foundations Yours	Foundations Neighbors	All Other Setbacks
Tank (ft)	50 ☐	500 ☐	50 ☐	NA ☐	25 ☐	20 ☐	15 ☐	25 ☐	☐
Field (ft)	100 ☐	500 ☐	50 ☐	4 ☐	30 ☐	20 ☐	30 ☐	40 ☐	☐
Lagoon (ft)	100 ☐	500 ☐	50 ☐	N/A ☐	30 ☐	50 ☐	100 ☐	200 ☐	☐

E. Required Signatures

Home Building Contractor Existing Home Date _____

Installer Bud Smith Date 8-5-98

FORM 23-102 10-96

Lincoln-Lancaster County Health Department
Environmental Health Division
3140 "N" Street • Lincoln, NE 68510-1514
Phone: 402-441-8022

D

Permit Number:

Sewage Disposal System

As Built Plans & Specifications

Date 8-5-98

System Location (Indicate correct number and street)

Address 2501 Mantell Rd/12500 S. 25 (no rural route) City Roca NE, Zip 68430

A. Building Sewer

1. Material: Sch 40 PVC
   Diameter: 4 in.
2. Distance above basement floor: _____ in.
   or distance below basement floor: _____ in.
3. Distance between dwelling and septic tank: _____ ft.
4. Number of clean-outs: _____
5. Distances to: well or suction line > 50 ft.
   stream > 20 ft.
   pressure line _____ ft.
   property line > 5 ft.

B. Septic Tank

1. Material: _____
   Number of compartments: _____
2. Capacity: _____ gal.
3. Factory built: ❑ Yes ❑ No
4. Manholes: Over inlet, diameter _____ in.
   Over outlet, diameter _____ in.
   Riser: ❑ above ❑ below grade _____ in.
5. Inlet: ❑ baffle ❑ tee
6. Outlet: ❑ baffle ❑ tee
7. Depth to top of tank, below unfinished grade: _____ in.
8. Distances to: Well or suction line _____ ft.
   Stream _____ ft.
   Pressure line _____ ft.
   Property line _____ ft.

C. Distribution Box

1. Material: _____
   Number available outlets: _____
2. Factory built: ❑ Yes ❑ No
3. Distance from septic tank: _____ ft.

D. Absorption Field


(Provide as-built drawings on back of this form)

1. Type: ❑ Half rounds ❑ Perforated pipe
   Diameter of half round: _____
   or perforated pipe: _____
   Material: ❑ fiberglass ❑ plastic ❑ concrete
   ❑ other _____
2. Lateral lines: Number _____
   Length of each line: _____ ft. _____ ft.
   _____ ft. _____ ft., _____ ft.
3. Trench dimensions: Width _____ ft.
   Slope _____ in/100 ft.
   Average depth _____ in
4. Filter material: _____
   Depth of material _____ in.
5. Distances to: Well or suction line _____ ft.
   Stream _____ ft.
   Pressure line _____ ft.
   Property line _____ ft.

Indicate North with Arrow

Complete "As Built" drawing on back of this form.

Individual Sewage System Design (Example)

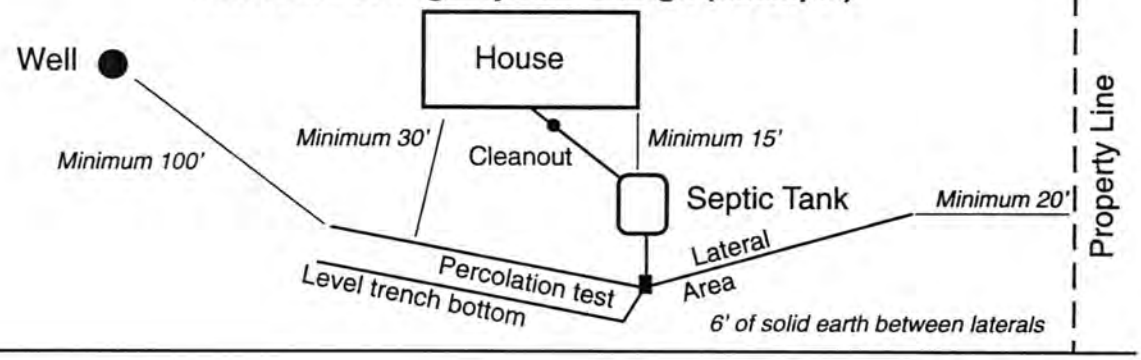

FORM 23-103 10-96

Lincoln-Lancaster County Health Department
Environmental Health Division
3140 "N" Street • Lincoln, NE 68510-1514
Phone: 402-441-8022

D

Permit Number:

Sewage Disposal System

As Built Plans & Specifications

Date 8-5-98

System Location (Indicate correct number and street)

Address 2501 Mantell Rd/17500 So 25 (no rural route) City Roca NE, Zip 68430

A. Building Sewer

1. Material: Sch 40 PVC
   Diameter: 4 in.
2. Distance above basement floor: _____ in.
   or distance below basement floor: _____ in.
3. Distance between dwelling and septic tank: _____ ft.
4. Number of clean-outs: _____
5. Distances to: well or suction line > 50 ft.
   stream > 20 ft.
   pressure line _____ ft.
   property line > 5 ft.

B. Septic Tank

1. Material: _____
   Number of compartments: _____
2. Capacity: _____ gal.
3. Factory built: ❑ Yes ❑ No
4. Manholes: Over inlet, diameter _____ in.
   Over outlet, diameter _____ in.
   Riser: ❑ above ❑ below grade _____ in.
5. Inlet: ❑ baffle ❑ tee
6. Outlet: ❑ baffle ❑ tee
7. Depth to top of tank, below unfinished grade: _____ in.
8. Distances to: Well or suction line _____ ft.
   Stream _____ ft.
   Pressure line _____ ft.
   Property line _____ ft.

C. Distribution Box

1. Material: _____
   Number available outlets: _____
2. Factory built: ❑ Yes ❑ No
3. Distance from septic tank: _____ ft.

D. Absorption Field


(Provide as-built drawings on back of this form)

1. Type: ❑ Half rounds ❑ Perforated pipe
   Diameter of half round: _____
   or perforated pipe: _____
   Material: ❑ fiberglass ❑ plastic ❑ concrete
   ❑ other _____
2. Lateral lines: Number _____
   Length of each line: _____ ft. _____ ft.
   _____ ft. _____ ft., _____ ft.
3. Trench dimensions: Width _____ ft.
   Slope _____ in/100 ft.
   Average depth _____ in
4. Filter material: _____
   Depth of material _____ in.
5. Distances to: Well or suction line _____ ft.
   Stream _____ ft.
   Pressure line _____ ft.
   Property line _____ ft.

Indicate North with Arrow


Complete "As Built" drawing on back of this form.

Individual Sewage System Design (Example)

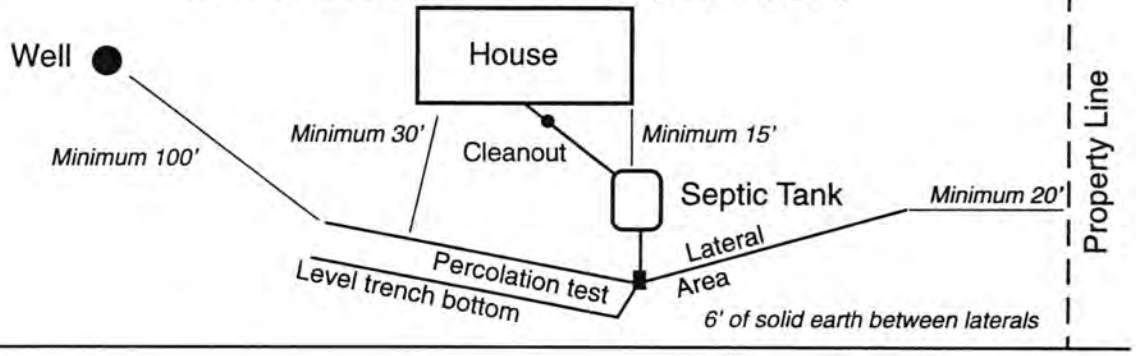

FORM 23-103 10-96

As Built Drawing

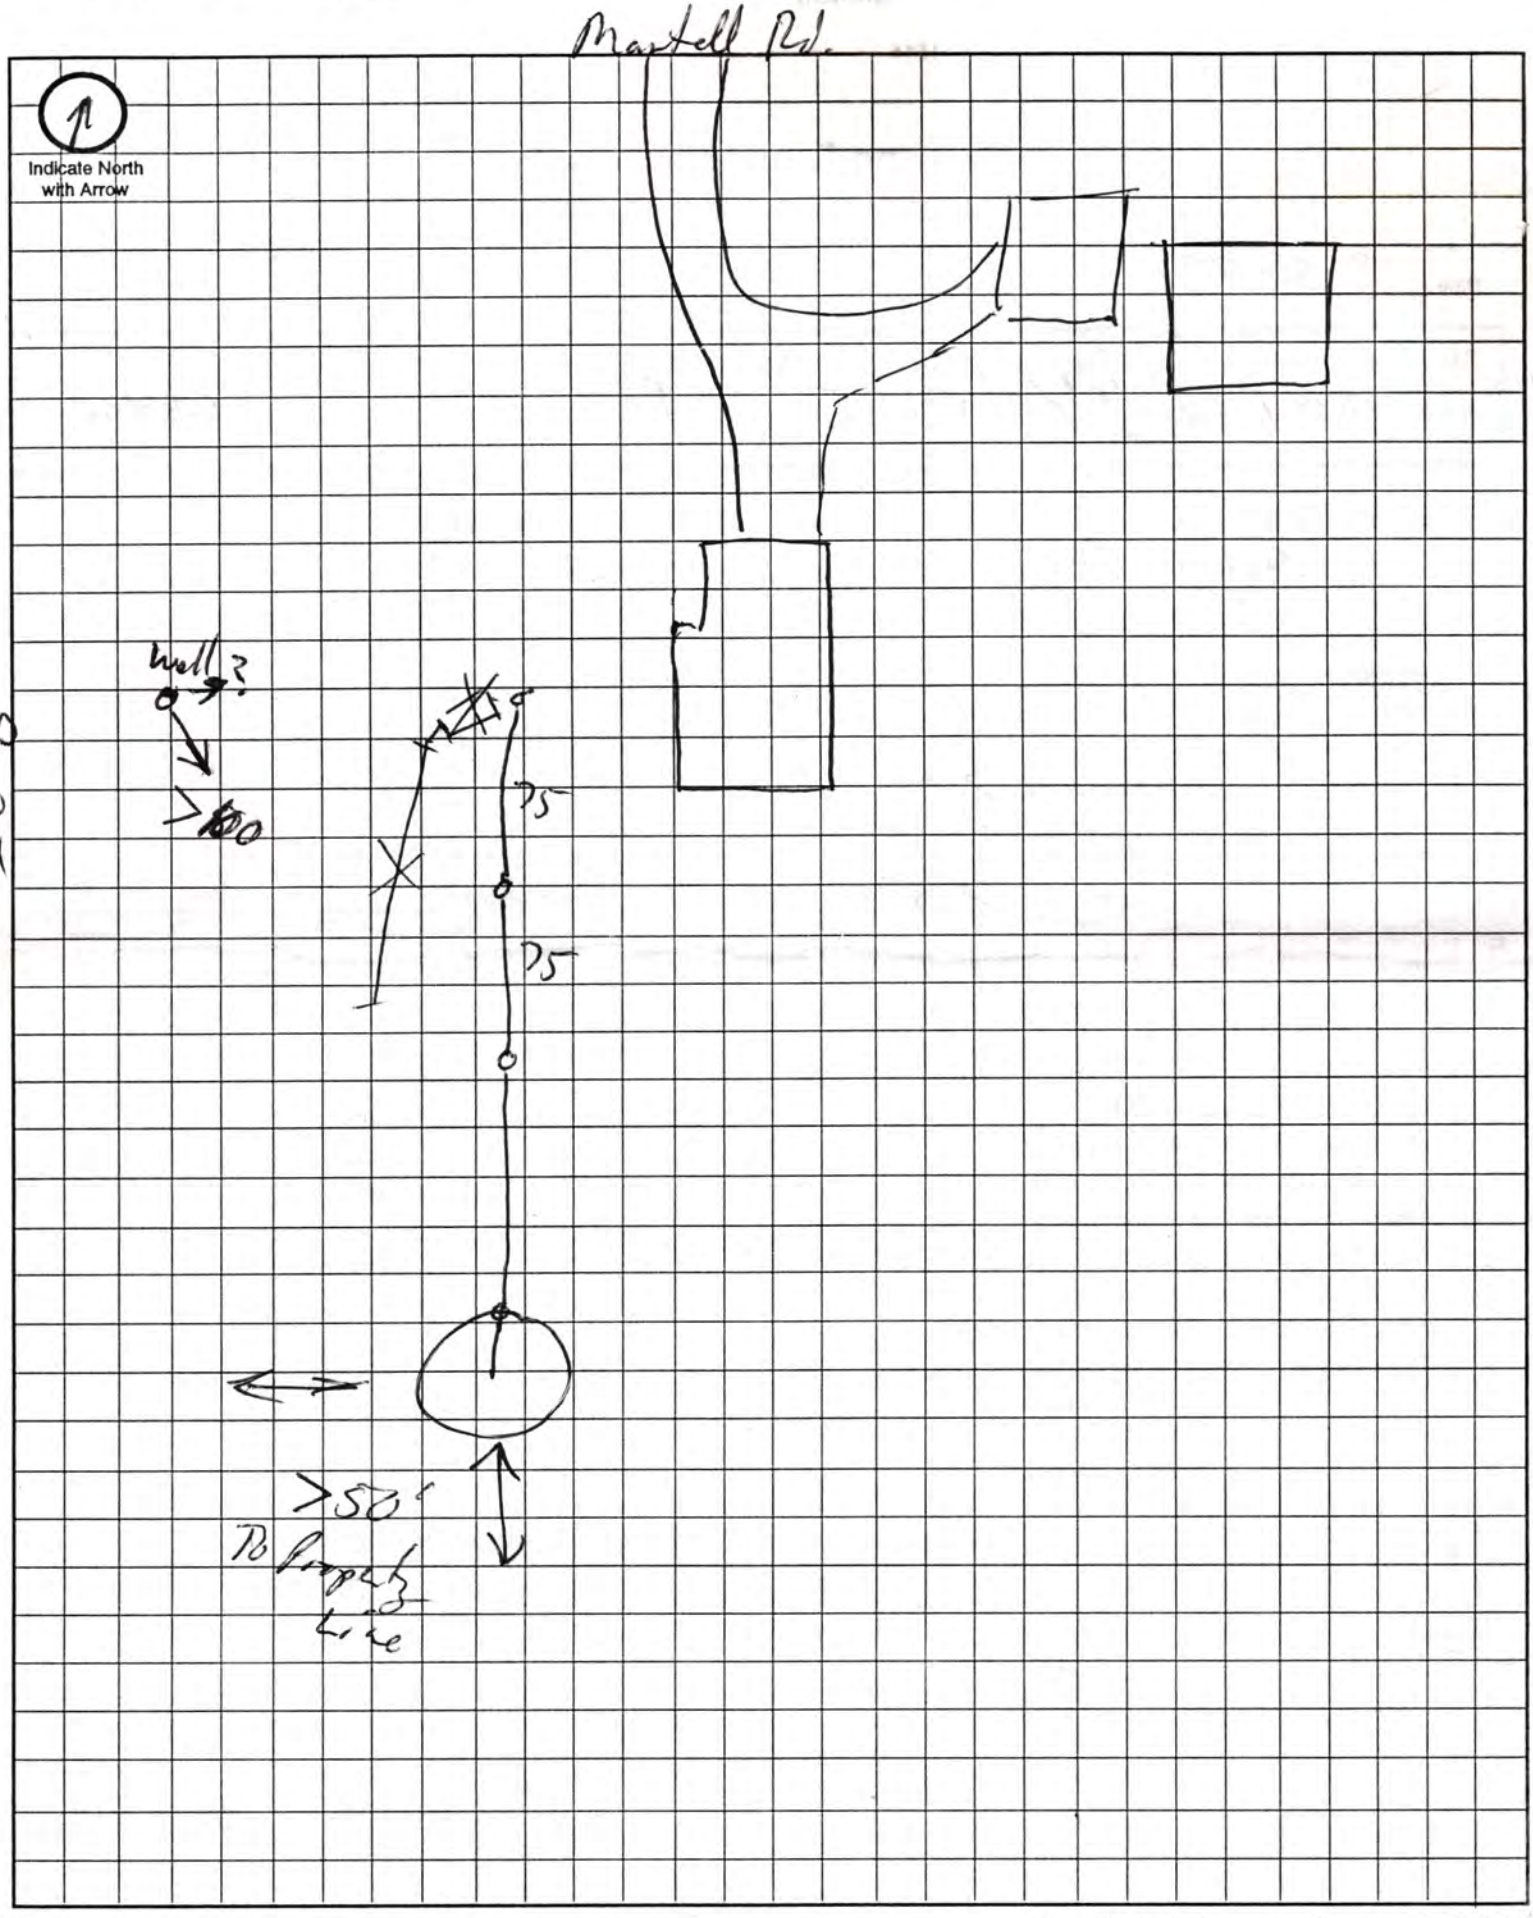

Approximate Scale: _____ft. = _____ grid line/s