Lincoln-Lancaster County Health Department

ENVIRONMENTAL HEALTH DIVISION

3140 N STREET · LINCOLN, NE 68510-1514 (402) 441-8000

Permit

SEWAGE SYSTEM REPAIR
SEPTIC REPAIR

Permit # 02390071301

Issued 01/14/02
Expires 07/14/02
Revenue Code 3157

Establishment

JIM STEWART
T8N R7E SEC 2
8405 SALTILLO RD

FEES: $100.00

Permittee

JIM STEWART
8405 SALTILLO RD
LINCOLN NE 68516-9341

TOTAL: $100.00

Bruce D. Dart

Bruce D. Dart, Health Director

• POST IN A PROMINENT PLACE • NOT TRANSFERABLE

000539

Lincoln-Lancaster County Health Department
Environmental Health Division
3140 "N" Street • Lincoln, NE 68510-1514
Phone: 402-441-8022

RECEIVED
JAN 14 2002

A

Permit Number: 02300713

Sewage Disposal System

Request for Site Clearance and Permit

Include Form B, Form C and Applicable Fees with this Application.

☒ Septic System ☐ Lagoon ☐ Other (Refer to Form C)

The undersigned hereby requests site clearance and permit to construct a Sewage Disposal System in conformance with appropriate resolution or ordinance, as described herein:

PLEASE PRINT OR TYPE

A. System Location (Indicate correct number and street)

Address 8405 Saltillo (no rural route) City Lincoln NE, Zip _____

Legal Description _____ 2 8N 7E _____
1/4 1/4 Section Township Range Subdivision Addition Block Lot

Geographical Location (if known): Longitude _____ Latitude _____

☐ Check if system mail address is not the same as the owner's address

B. Owner

Name Jim Stewart Signature _____

Address 8405 Saltillo City/State/Zip Lincoln Ne.

☐ Check if owner designed system Home Phone 423-5676 Work Phone _____

C. Contractor

Name Gary Daharsh Sr Company Name Daharsh Excv

Address 7703, 154 Rd City/State/Zip Cearland Ne 68360

☐ Check if contractor designed system Work Phone _____

D. Engineer/Installer ☐ Check and complete if engineer designed system

Designer Name _____ Firm _____ Work Phone _____

E. This System Will Serve a

☒ Residential Dwelling Number of Bedrooms 3 Is there a Whirlpool Bathtub YES (NO)

☐ Commercial Establishment/Other Facility Specify _____

Design flow in gallons per day _____ Type of Wastewater: ☒ Domestic ☐ Non-Domestic.

DO NOT WRITE BELOW THIS LINE

Approval Process ☐ Municipal Code 24.38 ☒ County Resolution No. 2832

1. **Health Department** Date rec'd 1/14/02 Date frwd 1/22/02 ACTION ☒ Approved ☐ Disapproved Signature Jerrold C. Hood
2. **Supt. Bldg. Insp. or Village Clerk** Date rec'd _____ Date frwd _____ ACTION ☐ Approved ☐ Disapproved Signature _____
3. **City or County Engineer** Date rec'd _____ Date frwd _____ ACTION ☐ Approved ☐ Disapproved Signature _____

1/11/01 WRONG Repair FEE. J.C.H. OTHER WISE. OK.

Installation Final Written Approval

By Jerrold C. Hood R.E.H.S.

Date _____

Business Office Use Only

Date Rec'd 01/14/02 $100.00 Paid
Amt Paid 200.00 Refund 1896
Rec'd By es Cash/Check No. 1895

FORM 23-100 10-96 White - Health Dept. Yellow - Engineer Pink - Bldg. Inspector

Lincoln-Lancaster County Health Department
Environmental Health Division
3140 "N" Street • Lincoln, NE 68510-1514
Phone: 402-441-8022


C

Permit Number: 023900713

Sewage Disposal System

Preliminary Plan Specifications

Draw a plot plan showing system location, lines, distribution box, tank and laterals, percolation test hole locations, well, residence, compass direction and property lines. Indicate on drawing if residence and well are existing or proposed.

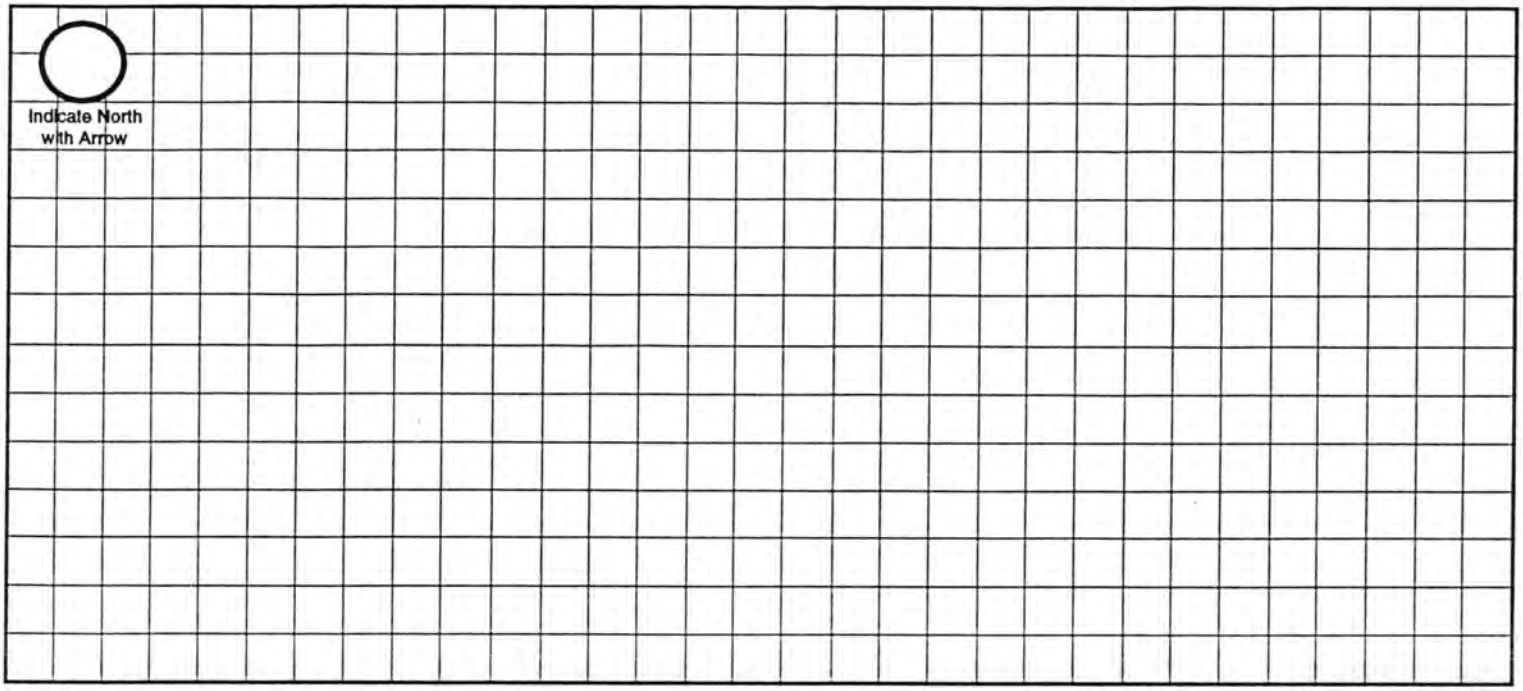

Approximate Scale: _____ ft. = _____ grid line/s

A. System Location (Indicate correct number and street)

Address (no rural route) 8405 Saltillo City Lincoln NE, Zip _____

B. Proposed Septic Tank/s

Tank Material: ☑ Concrete ☐ Plastic ☐ Other _____

C. Proposed Absorption System (See Form B for Percolation Information)

Percolation Rate _____ (min. per inch) Soil Type: _____ Land Slope: _____ %

Type of Absorption System: ☑ Trench ☐ Bed ☐ Other _____

Total Square Feet of Field Required: _____ sq. ft.

Type of Lateral: ☐ Half-Moon ☐ Perforated Pipe ☐ Other Lateral Material: _____

Capacity of Septic Tank 1000 gals Number of Absorption Beds: _____ Number of Distribution Laterals per Bed _____

Total Length of Laterals _____ ft. Number of Trenches _____ Trench Width _____

D. Setbacks Check the Boxes Below if the Required Setback has been Satisfied


Distance From	Private Well	Public Well	Surface Water	Gound Water	Pressure Water Lines	Property Lines	Foundations Yours	Foundations Neighbors	All Other Setbacks
Tank (ft)	50 ☐	500 ☐	50 ☐	NA ☐	25 ☐	20 ☐	15 ☐	25 ☐	☐
Field (ft)	100 ☐	500 ☐	50 ☐	4 ☐	30 ☐	20 ☐	30 ☐	40 ☐	☐
Lagoon (ft)	100 ☐	500 ☐	50 ☐	N/A ☐	30 ☐	50 ☐	100 ☐	200 ☐	☐

E. Required Signatures

Home Building Contractor _____ Date _____

Installer _____ Date _____

As Built Drawing

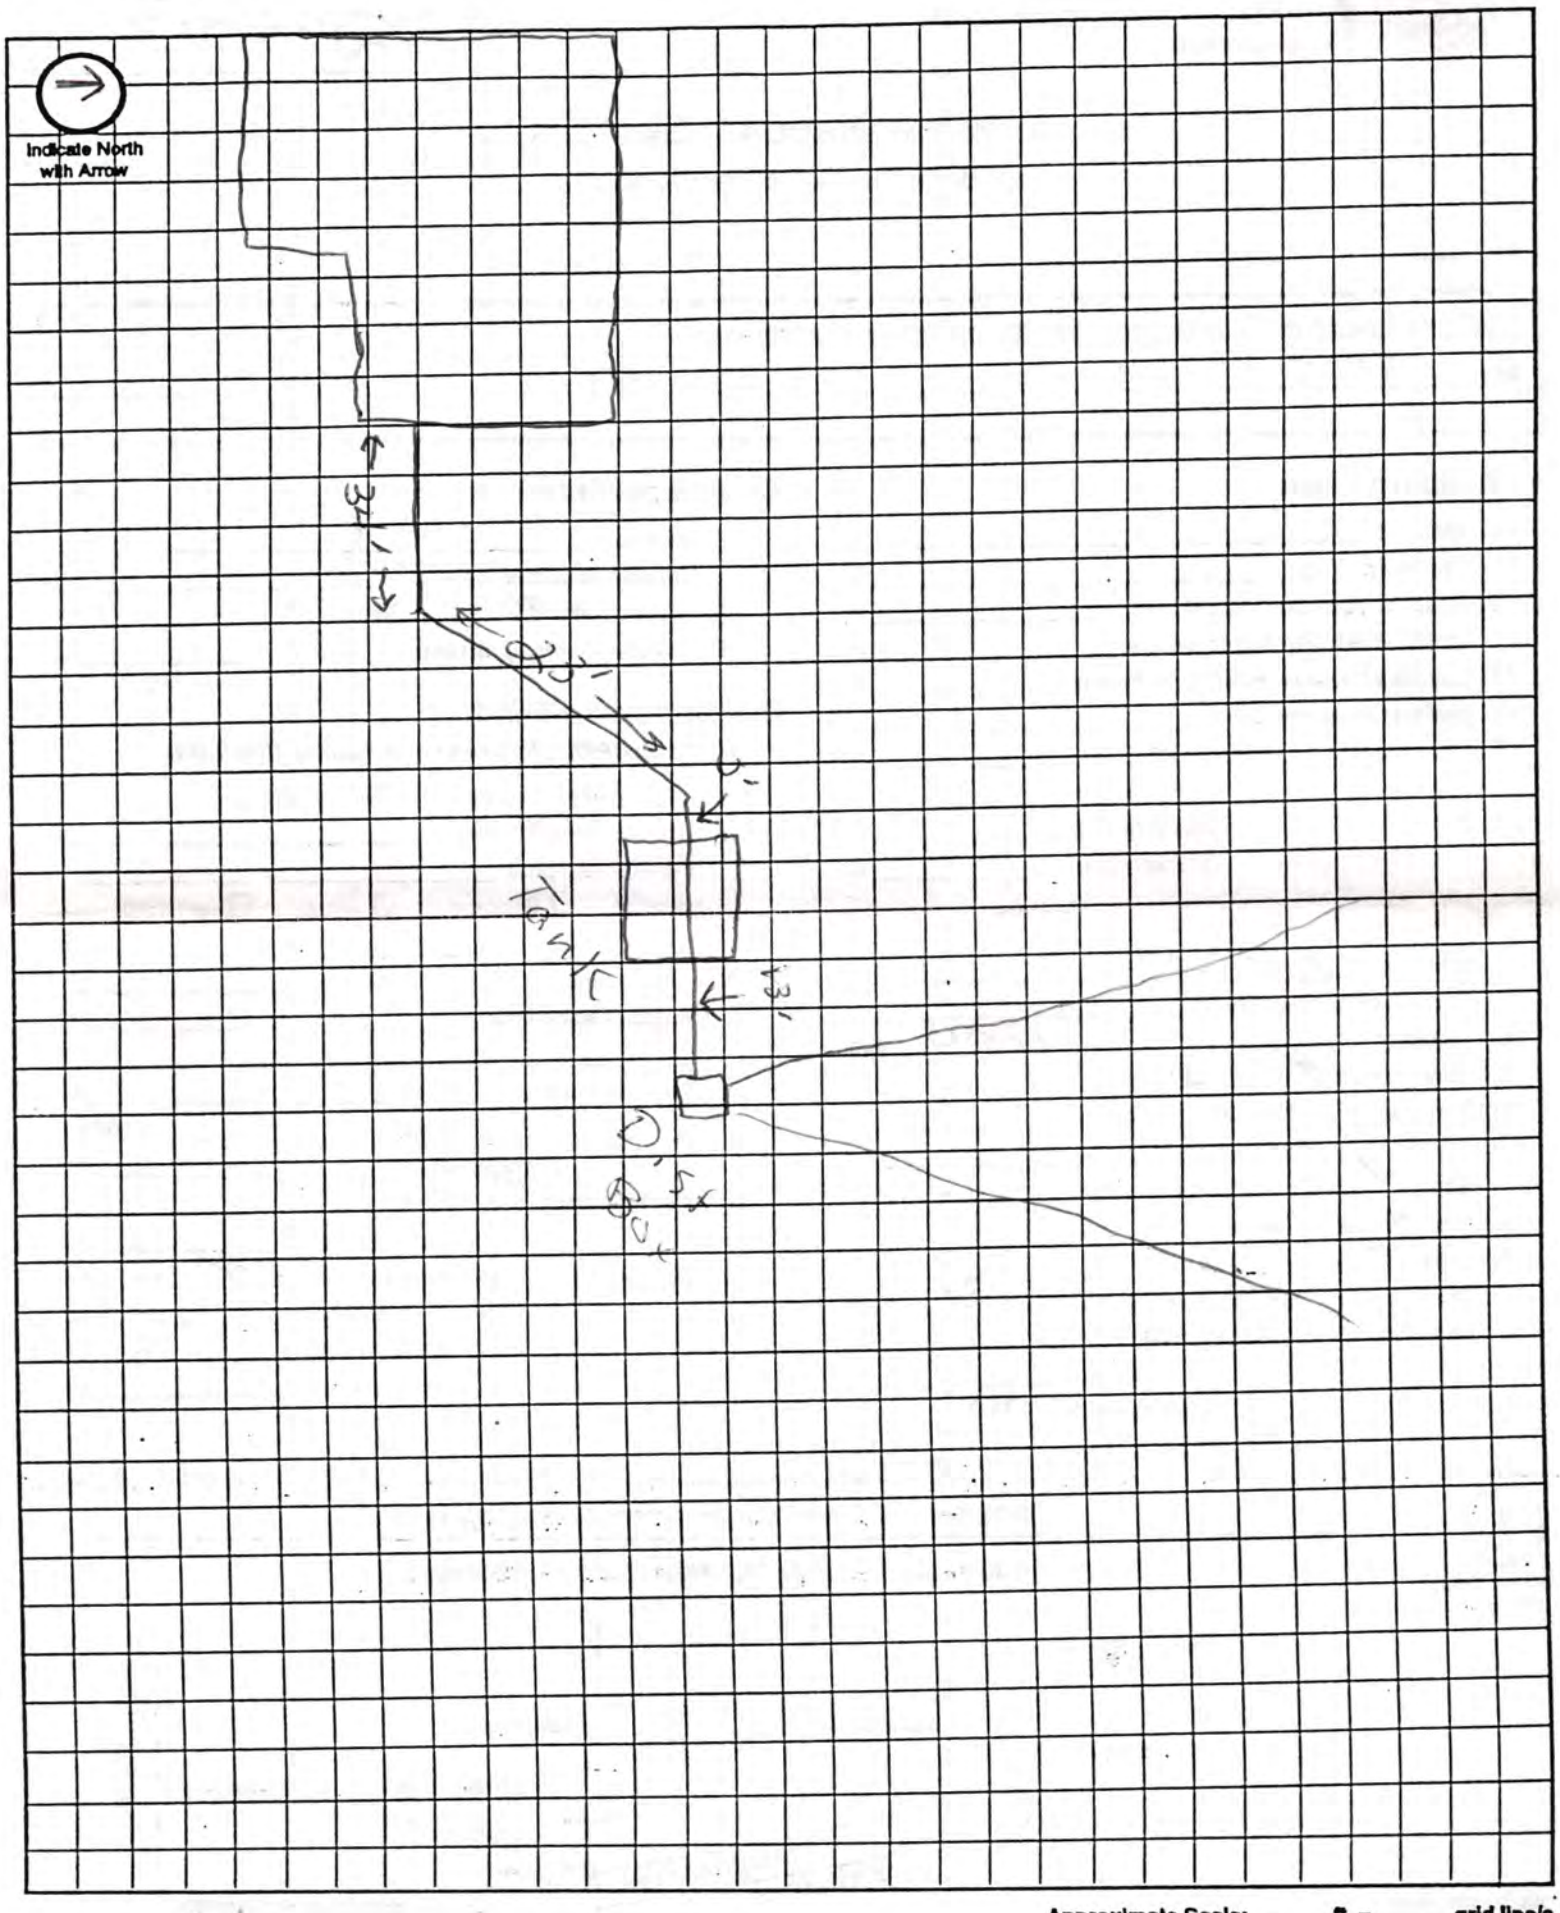

Approximate Scale: _____ ft. = _____ grid line/s

Lincoln-Lancaster County Health Department
Environmental Health Division
3140 "N" Street • Lincoln, NE 68510-1514
Phone: 402-441-8022

D

Permit Number: 02390073

Sewage Disposal System

As Built Plans & Specifications

Date _____

System Location (Indicate correct number and street)

Address 8405 Saltillo (no rural route) City Lincoln NE, Zip _____

A. Building Sewer

1. Material: _____
   Diameter: _____ in.
2. Distance above basement floor: _____ in.
   or distance below basement floor: _____ in.
3. Distance between dwelling and septic tank: _____ ft.
4. Number of clean-outs: _____
5. Distances to: well or suction line _____ ft.
   stream _____ ft.
   pressure line _____ ft.
   property line _____ ft.

B. Septic Tank

1. Material: Concrete
   Number of compartments: _____
2. Capacity: 1000 gal.
3. Factory built: ☑ Yes ☐ No
4. Manholes: Over inlet, diameter _____ in.
   Over outlet, diameter _____ in.
   Riser: ☑ above ☐ below grade _____ in.
5. Inlet: ☑ baffle ☐ tee
6. Outlet: ☑ baffle ☐ tee
7. Depth to top of tank, below unfinished grade: 36 in.
8. Distances to: Well or suction line _____ ft.
   Stream _____ ft.
   Pressure line 200 ft.
   Property line _____ ft.

C. Distribution Box

1. Material: Plastic
   Number available outlets: 5
2. Factory built: ☑ Yes ☐ No
3. Distance from septic tank: 13 ft.

D. Absorption Field


(Provide as-built drawings on back of this form)

1. Type: ☐ Half rounds ☐ Perforated pipe
   Diameter of half round: _____
   or perforated pipe: _____
   Material: ☐ fiberglass ☐ plastic ☐ concrete
   ☐ other _____
2. Lateral lines: Number _____
   Length of each line: _____ ft. _____ ft.
   _____ ft. _____ ft., _____ ft.
3. Trench dimensions: Width _____ ft.
   Slope _____ in/100 ft.
   Average depth _____ in
4. Filter material: Gravel
   Depth of material _____ in.
5. Distances to: Well or suction line 200 ft.
   Stream _____ ft.
   Pressure line _____ ft.
   Property line _____ ft.

Complete "As Built" drawing on back of this form.

Indicate North with Arrow

Individual Sewage System Design (Example)

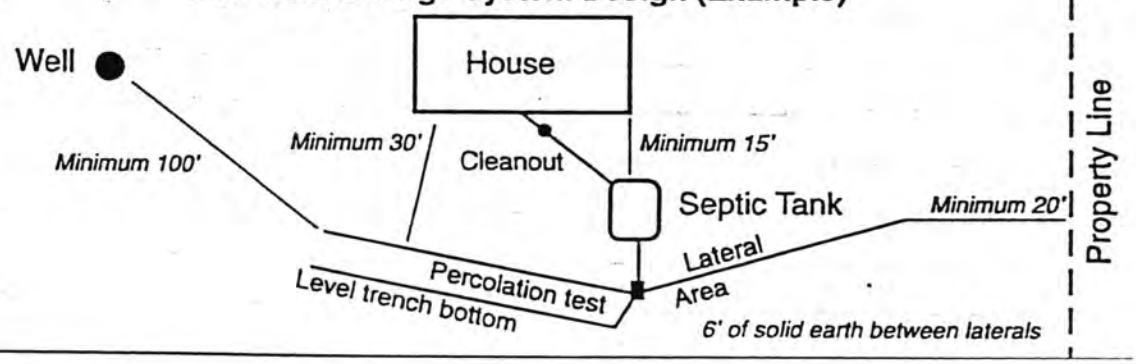

FORM 23-103 10-96