LINCOLN-LANCASTER COUNTY HEALTH DEPARTMENT

ENVIRONMENTAL HEALTH DIVISION
3140 "N" STREET Lincoln, NE 68510-1514 (402) 441-8000
NON TRANSFERABLE

PERMIT

Permit
SEWAGE INSTALLATION
LAGOON

No. 98380178201

Issued 06/23/98
Expires 12/23/98
Revenue Code 3157

FEES: $150.00

PAID

Establishment
ROGER & VERNA PROCHASKA
T8N R8E SEC 28 QTR NW
LOT 2IT
17800 S 134 ST-BENNET

TOTAL $150.00

Permittee
ROGER & VERNA PROCHASKA
17800 S 134 ST
BENNET NE 68317

Issued By Health Director
Lincoln-Lancaster County Health Department

007667

THIS LICENSE OR PERMIT IS ISSUED SUBJECT TO REVOCATION AS PROVIDED BY LAW "POST IN A PROMINENT PLACE"

ROB HOWELL 450-7345
INTEGRITY BLDRS.

Lincoln-Lancaster County Health Department
Environmental Health Division
3140 "N" Street • Lincoln, NE 68510-1514
Phone: 402-441-8022

A

Permit Number: 98380178Z

Sewage Disposal System

Request for Site Clearance and Permit

Include Form B, Form C and Applicable Fees with this Application.

☐ Septic System ☒ Lagoon ☐ Other (Refer to Form C)

The undersigned hereby requests site clearance and permit to construct a Sewage Disposal System in conformance with appropriate resolution or ordinance, as described herein:

PLEASE PRINT OR TYPE

A. System Location (Indicate correct number and street)

Address 17800 So. 134th (no rural route) City Bennett NE, Zip 68317

Legal Description NW 28 8N 8E SEE ATTACHED PART 2 IT
1/4 1/4 Section Township Range Subdivision Addition Block Lot

Geographical Location (if known): Longitude Lot 8 Latitude

☒ Check if system mail address is not the same as the owner's address

B. Owner

Name Roger & Verna Prochaska Signature

Address 17800 So. 134th City/State/Zip ~~[illegible]~~, not Bennett, NE 68317

☐ Check if owner designed system Home Phone 788-2220 Work Phone 483-3236

C. Contractor

Name Integrity Builders, Inc Company Name

Address 925 S.W. 2nd City/State/Zip Lincoln, NE 68508

☐ Check if contractor designed system Work Phone 438-3334

D. Engineer/Installer ☐ Check and complete if engineer designed system

Designer Name Firm Bowens Plumbing Work Phone

E. This System Will Serve a

☒ Residential Dwelling Number of Bedrooms 3 Is there a Whirlpool Bathtub YES (NO)

☐ Commercial Establishment/Other Facility Specify

Design flow in gallons per day Type of Wastewater: ☒ Domestic ☐ Non-Domestic.

DO NOT WRITE BELOW THIS LINE

Approval Process ☐ Municipal Code 24.38 ☒ County Resolution No. 2832

1. Health Department	Date rec'd 6/23/98 Date frwd 6/23/98	ACTION ☒ Approved ☐ Disapproved Signature Jerrold C. Hood	
2. Supt. Bldg. Insp. or Village Clerk	Date rec'd 6/23/98 Date frwd 6/23/98	ACTION ☐ Approved ☐ Disapproved Signature	
3. City or County Engineer	Date rec'd 6/23/98 Date frwd 6/23/98	ACTION ☒ Approved ☐ Disapproved Signature	

Installation Final Written Approval

By Paul D. Thomas

Date 12-7-98

Business Office Use Only

Date Rec'd 6-23-98
Amt Paid $150.00
Rec'd By ldf Cash/Check No. 1237

FORM 23-100 10-96 White - Health Dept. Yellow - Engineer Pink - Bldg. Inspector


Lincoln-Lancaster County Health Department
Environmental Health Division
3140 "N" Street • Lincoln, NE 68510-1514
Phone: 402-441-8022

C

Permit Number: 9838 01782

Sewage Disposal System
Preliminary Plan Specifications

Draw a plot plan showing system location, lines, distribution box, tank and laterals, percolation test hole locations, well, residence, compass direction and property lines. Indicate on drawing if residence and well are existing or proposed.

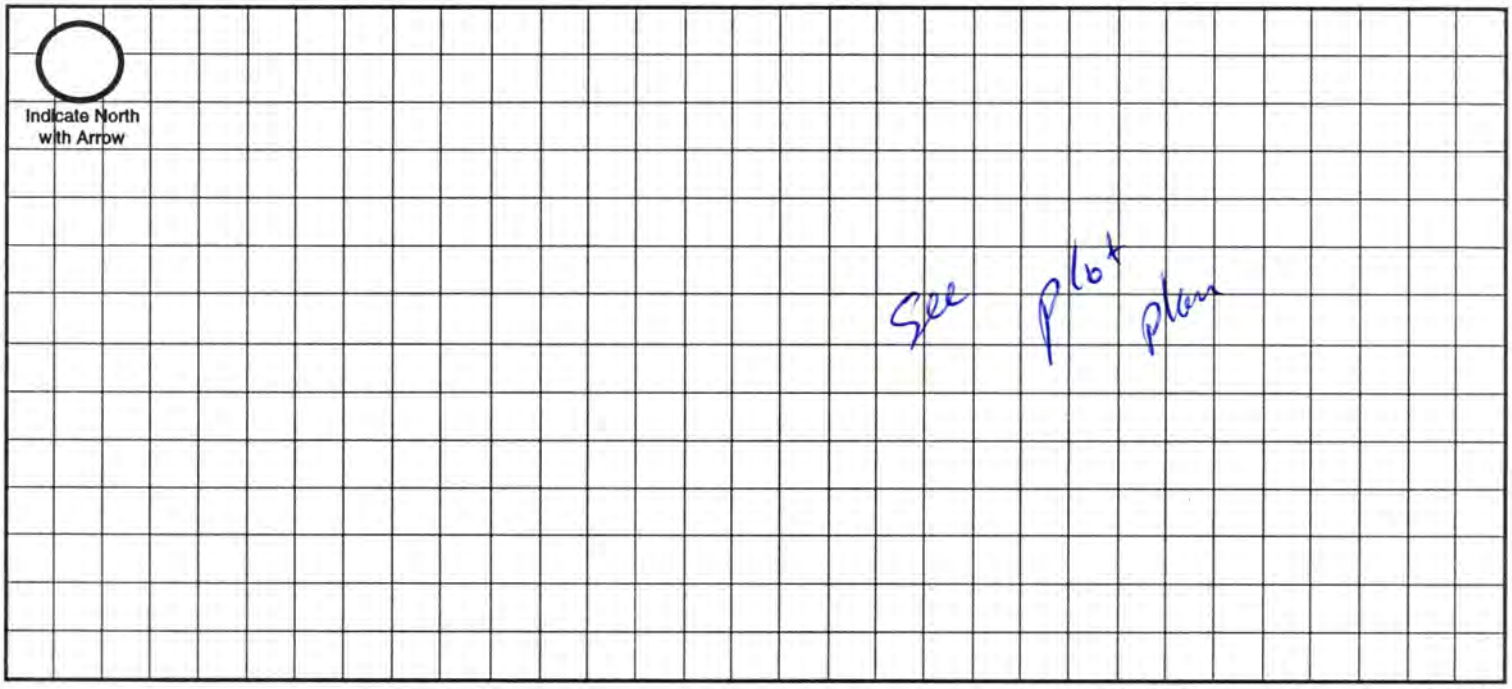

Approximate Scale: _____ ft. = _____ grid line/s

A. System Location (Indicate correct number and street)

Address (no rural route) 17800 So. 134th City Bennett NE, Zip _____

B. Proposed Septic Tank/s

Tank Material: ☐ Concrete ☐ Plastic ☐ Other _____

C. Proposed Absorption System (See Form B for Percolation Information)

Percolation Rate _____ (min. per inch) Soil Type: _____ Land Slope: _____ %

Type of Absorption System: ☐ Trench ☐ Bed ☐ Other _____

Total Square Feet of Field Required: _____ sq. ft.

Type of Lateral: ☐ Half-Moon ☐ Perforated Pipe ☐ Other Lateral Material: _____

Capacity of Septic Tank _____ gals Number of Absorption Beds: _____ Number of Distribution Laterals per Bed _____

Total Length of Laterals _____ ft. Number of Trenches _____ Trench Width _____

D. Setbacks Check the Boxes Below if the Required Setback has been Satisfied

Distance From	Private Well	Public Well	Surface Water	Gound Water	Pressure Water Lines	Property Lines	Foundations Yours	Foundations Neighbors	All Other Setbacks
Tank (ft)	50 ☐	500 ☐	50 ☐	NA ☐	25 ☐	20 ☐	15 ☐	25 ☐	☐
Field (ft)	100 ☐	500 ☐	50 ☐	4 ☐	30 ☐	20 ☐	30 ☐	40 ☐	☐
Lagoon (ft)	100 ☒	500 ☒	50 ☒	N/A ☐	30 ☒	50 ☒	100 ☒	200 ☒	☒

E. Required Signatures

Home Building Contractor Integrity Builders, Inc. Date 6-22-98

Installer Bowers Plumbing Co, Inc. Date _____

FORM 23-102 10-96

Lincoln-Lancaster County Health Department
Environmental Health Division
3140 "N" Street • Lincoln, NE 68510-1514
Phone: 402-441-8022

D

Permit Number: 98380178Z

Sewage Disposal System

As Built Plans & Specifications

Date 12-7-98

System Location (Indicate correct number and street)

Address 17800 S. 134 (no rural route) City Bennet NE, Zip 68317

A. Building Sewer

1. Material: PVC
   Diameter: 4" in.
2. Distance above basement floor: _____ in.
   or distance below basement floor: _____ in.
3. Distance between dwelling and septic tank: _____ ft.
4. Number of clean-outs: 4
5. Distances to: well or suction line _____ ft.
   stream _____ ft.
   pressure line _____ ft.
   property line _____ ft.

B. Septic Tank

1. Material: _____
   Number of compartments: _____
2. Capacity: _____ gal.
3. Factory built: ☐ Yes ☐ No
4. Manholes: Over inlet, diameter _____ in.
   Over outlet, diameter _____ in.
   Riser: ☐ above ☐ below grade _____ in.
5. Inlet: ☐ baffle ☐ tee
6. Outlet: ☐ baffle ☐ tee
7. Depth to top of tank, below unfinished grade: _____ in.
8. Distances to: Well or suction line _____ ft.
   Stream _____ ft.
   Pressure line _____ ft.
   Property line _____ ft.

C. Distribution Box

1. Material: _____
   Number available outlets: _____
2. Factory built: ☐ Yes ☐ No
3. Distance from septic tank: _____ ft.

D. Absorption Field


(Provide as-built drawings on back of this form)

1. Type: ☐ Half rounds ☐ Perforated pipe
   Diameter of half round: _____
   or perforated pipe: _____
   Material: ☐ fiberglass ☐ plastic ☐ concrete
   ☐ other _____
2. Lateral lines: Number _____
   Length of each line: _____ ft. _____ ft.
   _____ ft. _____ ft., _____ ft.
3. Trench dimensions: Width _____ ft.
   Slope _____ in/100 ft.
   Average depth _____ in
4. Filter material: _____
   Depth of material _____ in.
5. Distances to: Well or suction line _____ ft.
   Stream _____ ft.
   Pressure line _____ ft.
   Property line _____ ft.

Indicate North with Arrow

Complete "As Built" drawing on back of this form.

Individual Sewage System Design (Example)

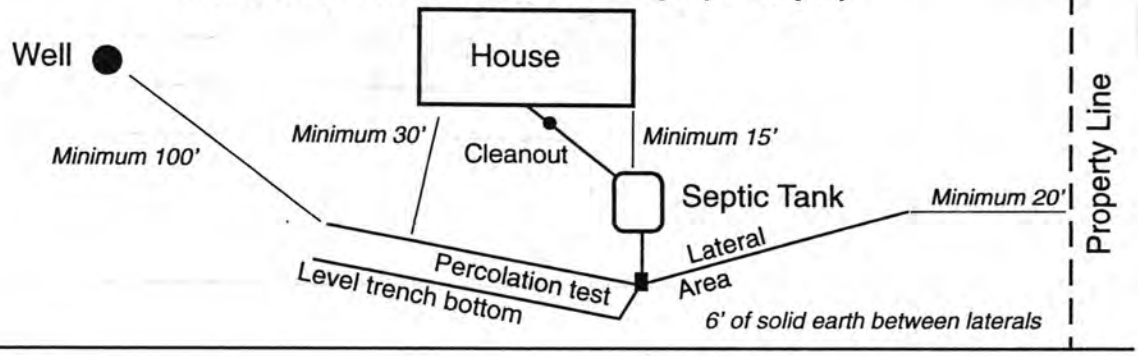

FORM 23-103 10-96

9838017822

PLOT PLAN

LANCASTER County, Nebraska

ALLIED SURVEYING AND MAPPING, INC.
LAND SURVEYORS

Phone (402) 434-2686
FAX (402) 434-2687

6120 South 58th Street · Suite "A" · Lincoln, Nebraska 68516-3650


17800 South 134th Street - Parcel #1 - Attached

Section 28 T 8 N, R 8 E of the 6th P.M.

Job No. 26174

May 15, 1998

Buyer/Roger & Verna Prochaska 714324-A

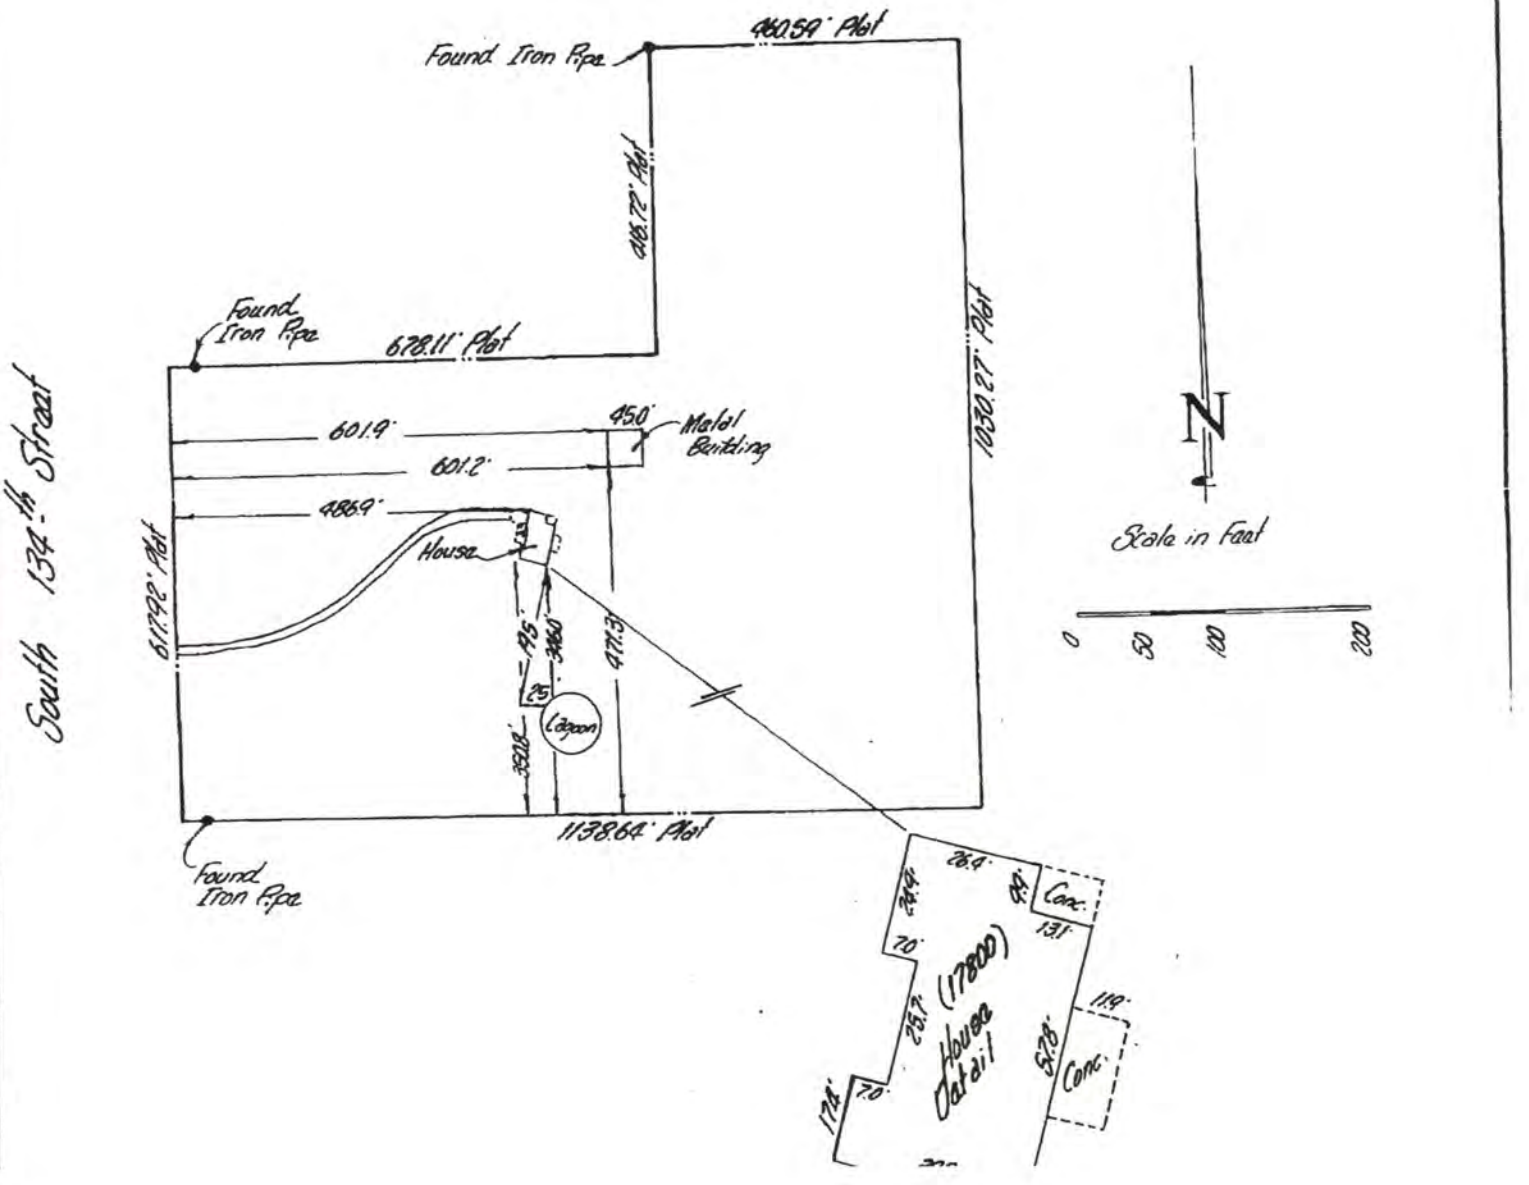


FILE: 71324B

EXHIBIT "A"

A PART OF LOT TWO (2), IRREGULAR TRACTS IN THE NORTHWEST QUARTER OF SECTION 28, TOWNSHIP 8 NORTH, RANGE 8 EAST OF THE 6TH P.M., LANCASTER COUNTY, NEBRASKA, MORE PARTICULARLY DESCRIBED AS FOLLOWS: REFERRING TO THE SOUTHWEST CORNER OF THE NORTHWEST QUARTER OF SAID SECTION 28, THENCE IN A NORTHERLY DIRECTION, ALONG THE WEST LINE OF THE NORTHWEST QUARTER OF SAID SECTION 28, ON AN ASSUMED BEARING OF NORTH 00 DEGREES 00 MINUTES 00 SECONDS EAST, FOR A DISTANCE OF 1320.00 FEET TO THE POINT OF BEGINNING, THENCE SOUTH 89 DEGREES 17 MINUTES 58 SECONDS EAST, PARALLEL TO THE SOUTH LINE OF THE NORTHWEST QUARTER OF SAID SECTION 28, FOR A DISTANCE OF 1138.64 FEET, THENCE NORTH 00 DEGREES 00 MINUTES 00 SECONDS EAST, PARALLEL TO THE WEST LINE OF THE NORTHWEST QUARTER OF SAID SECTION 28, FOR A DISTANCE OF 1030.27 FEET TO A POINT ON THE SOUTH LINE OF LOT 4 OF IRREGULAR TRACTS IN THE NORTHWEST QUARTER OF SAID SECTION 28, THENCE NORTH 89 DEGREES 04 MINUTES 30 SECONDS WEST, ALONG THE SOUTH LINE OF SAID LOT 4 OF IRREGULAR TRACTS FOR A DISTANCE OF 460.59 FEET TO A POINT ON THE EAST LINE OF LOT 3 OF IRREGULAR TRACTS IN THE NORTHWEST QUARTER OF SAID SECTION 28, THENCE SOUTH 00 DEGREES 00 MINUTES 00 SECONDS EAST, ALONG THE EAST LINE OF SAID LOT 3 OF IRREGULAR TRACTS FOR A DISTANCE OF 416.72 FEET TO THE SOUTHEAST CORNER OF SAID LOT 3 OF IRREGULAR TRACTS, THENCE NORTH 89 DEGREES 04 MINUTES 57 SECONDS WEST, ALONG THE SOUTH LINE OF SAID LOT 3 OF IRREGULAR TRACTS FOR A DISTANCE OF 678.11 FEET TO A POINT ON THE WEST LINE OF THE NORTHWEST QUARTER OF SAID SECTION 28, THENCE SOUTH 00 DEGREES 00 MINUTES 00 SECONDS EAST ALONG THE WEST LINE OF THE NORTHWEST QUARTER OF SAID SECTION 28, FOR A DISTANCE OF 617.92 FEET TO THE POINT OF BEGINNING.

As Built Drawing

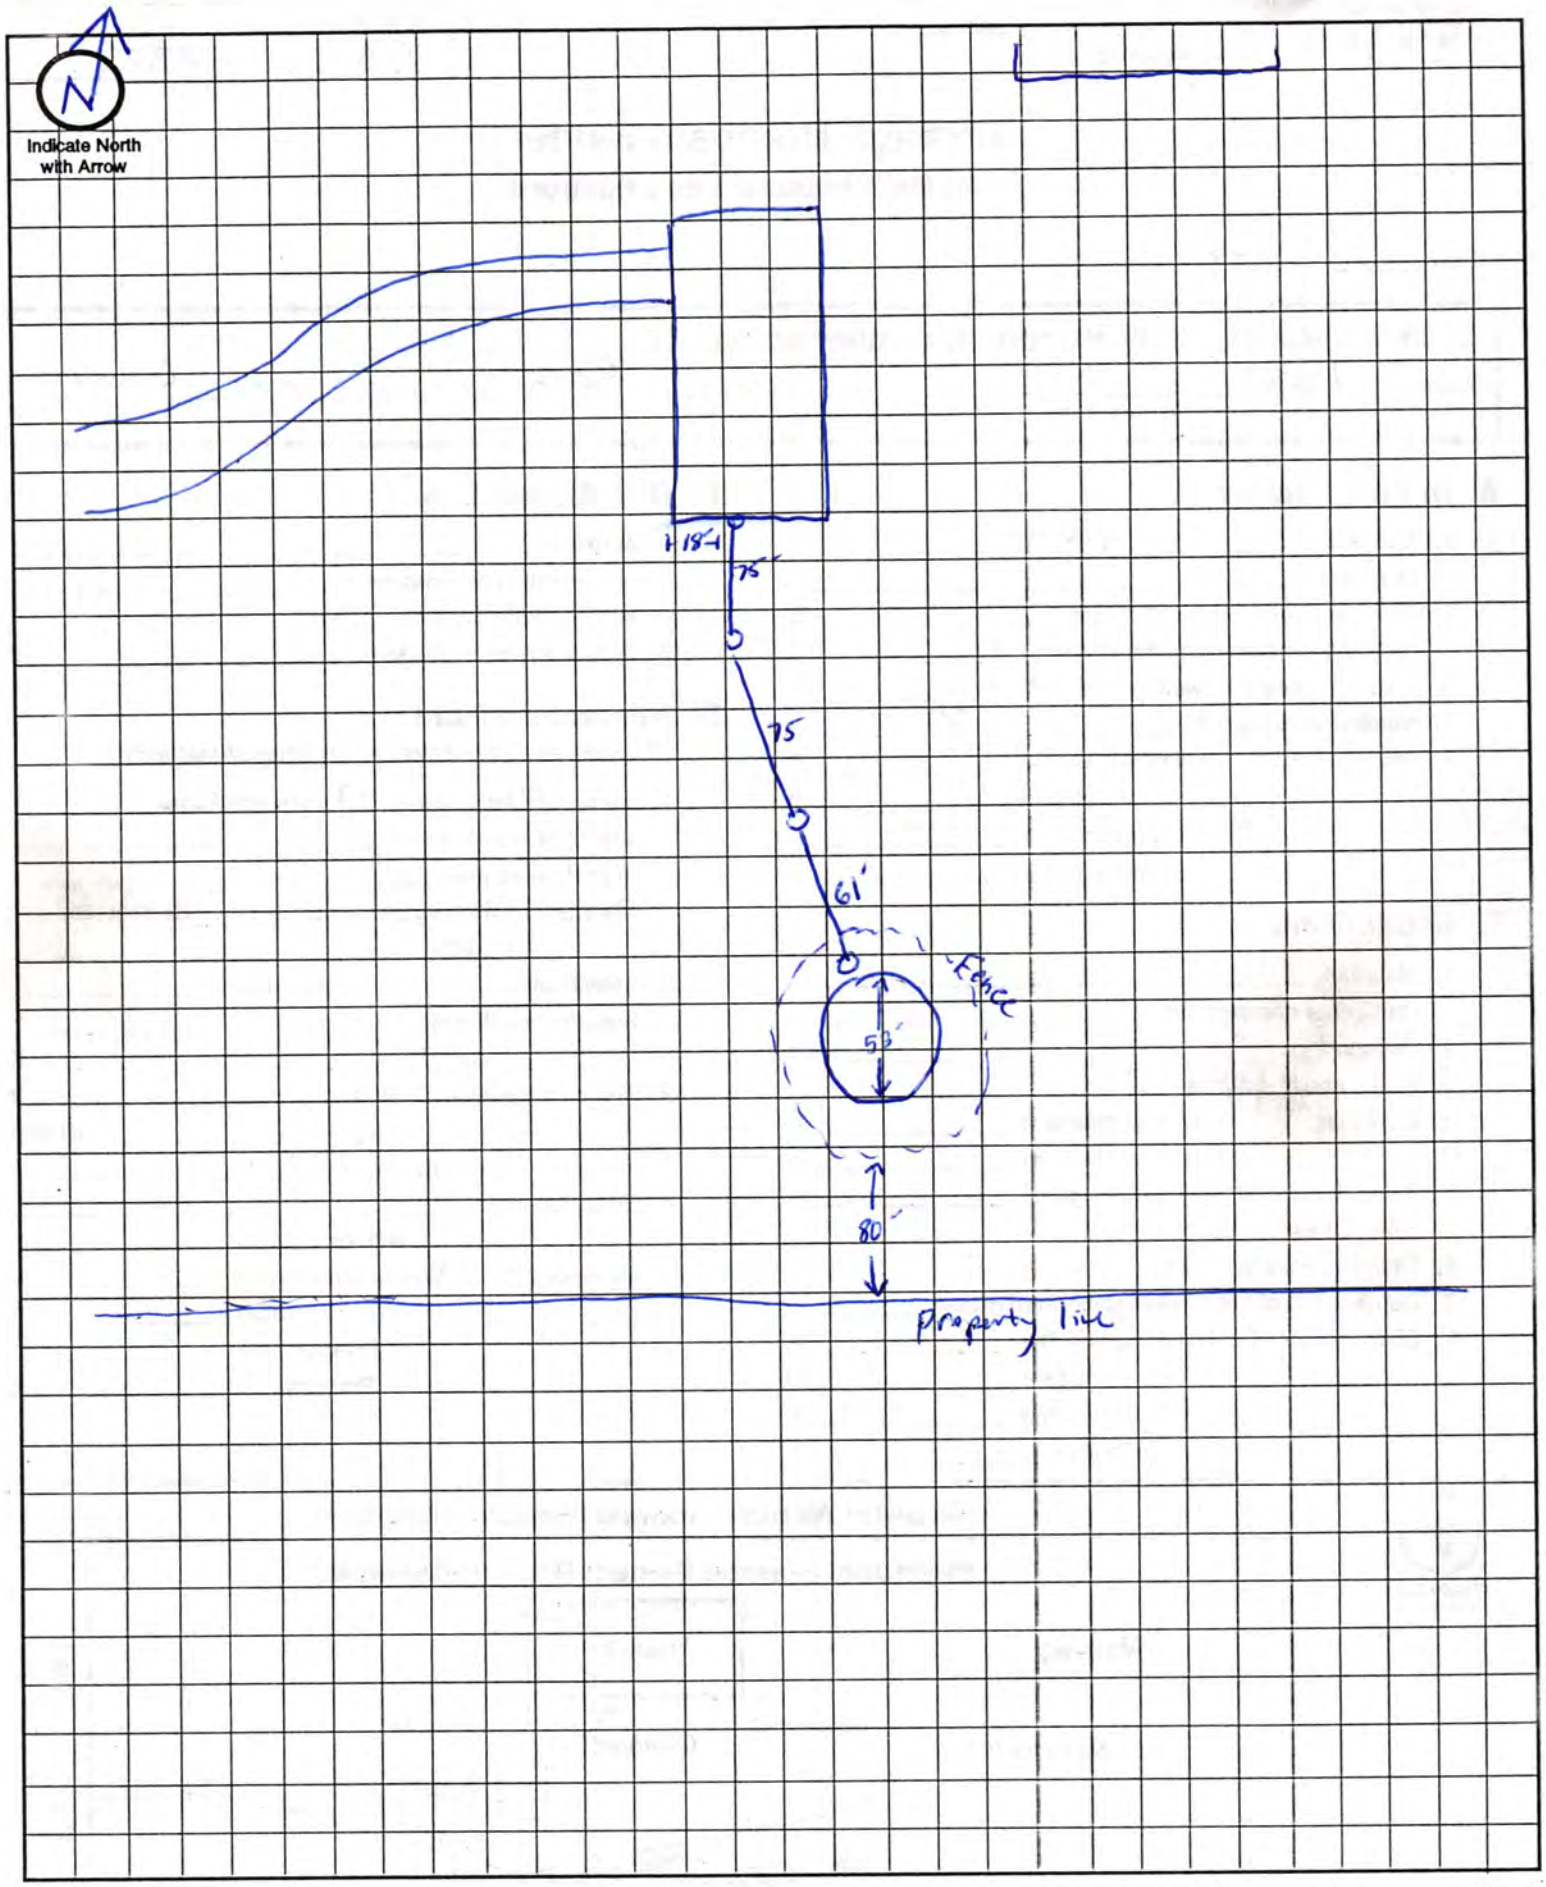

Approximate Scale: _____ft. = _____ grid line/s