Lincoln-Lancaster County Health Department
ENVIRONMENTAL PUBLIC HEALTH DIVISION

006425

3140 N STREET · LINCOLN, NE 68510-1514

(402) 441-8000

Permit: SEWAGE INSTALLATION
LAGOON

Permit # 05380298201

Issued 03/16/05
Expires 09/16/05
Revenue Code 3157

Establishment:
DELVIN DEDEN
T8N R8E SEC 32 QTR SE
E 1/2OF SE 1/4
13234 STAGECOACH RD-HICKMAN

FEES: $200.00

Permittee:
DELVIN DEDEN
4417 GLADSTONE ST
LINCOLN NE 68504

TOTAL: $200.00

Bruce D. Dart

Bruce D. Dart, Health Director

EPH COPY

Lincoln-Lancaster County Health Department
Environmental Health Division
3140 "N" Street • Lincoln, NE 68510-1514
Phone: 402-441-8022

A

Permit Number: 05360198201

Sewage Disposal System

Request for Site Clearance and Permit

Include Form B, Form C and Applicable Fees with this Application.

☐ Septic System ☒ Lagoon ☐ Other (Refer to Form C)

The undersigned hereby requests site clearance and permit to construct a Sewage Disposal System in conformance with appropriate resolution or ordinance, as described herein:

PLEASE PRINT OR TYPE

A. System Location (Indicate correct number and street)

Address 13234 Stagecoach Rd. (no rural route) City Hickman NE, Zip 68372

Legal Description E ½ SE ¼ 32 - 8N 8E
1/4 1/4 Section Township Range Subdivision Addition Block Lot

Geographical Location (if known): Longitude _____ Latitude _____

☑ Check if system mail address is not the same as the owner's address

B. Owner

Name Delvin Deden Signature Delvin Deden

Address 4417 Gladstone City/State/Zip Lincoln, Ne. 68504

☐ Check if owner designed system Home Phone Call 464-9648-daughter Work Phone Sandra Hosek

C. Contractor

Name Brad Southwick Company Name _____

Address _____ City/State/Zip _____

☐ Check if contractor designed system Work Phone _____

D. Engineer/Installer ☐ Check and complete if engineer designed system

Designer Name Brad - Southwick Firm _____ Work Phone _____

E. This System Will Serve a

☑ Residential Dwelling Number of Bedrooms 3 Is there a Whirlpool Bathtub YES (NO)

☐ Commercial Establishment/Other Facility Specify _____

Design flow in gallons per day _____ Type of Wastewater: ☒ Domestic ☐ Non-Domestic.

DO NOT WRITE BELOW THIS LINE

Approval Process ☐ Municipal Code 24.38 ☒ County Resolution No. 2832

1. **Health Department** Date rec'd 3/16/05 Date frwd 3/16/05 ACTION ☒ Approved ☐ Disapproved Signature Jerrold C. Hood
2. **Supt. Bldg. Insp. or Village Clerk** Date rec'd 3/16/05 Date frwd _____ ACTION ☑ Approved ☐ Disapproved Signature _____
3. **City or County Engineer** Date rec'd 3-16-05 Date frwd 3-16-05 ACTION ☒ Approved ☐ Disapproved Signature Jim Flouek

8/10/05 Need letter, drawings, etc. to L.C.H.

Installation Final Written Approval

By Jerrold C. Hood R.E.H.S.

Date NOVEMBER 9, 2005

Business Office Use Only

Date Rec'd 03/16/05

Amt Paid 200.00

Rec'd By _____ Cash/~~Check~~ No. CASH

FORM 23-100 10-96 White - Health Dept. Yellow - Engineer Pink - Bldg. Inspector


Lincoln-Lancaster County Health Department
Environmental Health Division
3140 "N" Street • Lincoln, NE 68510-1514
Phone: 402-441-8022

C

Permit Number: 053802982

Sewage Disposal System
Preliminary Plan Specifications

Draw a plot plan showing system location, lines, distribution box, tank and laterals, percolation test hole locations, well, residence, compass direction and property lines. Indicate on drawing if residence and well are existing or proposed.

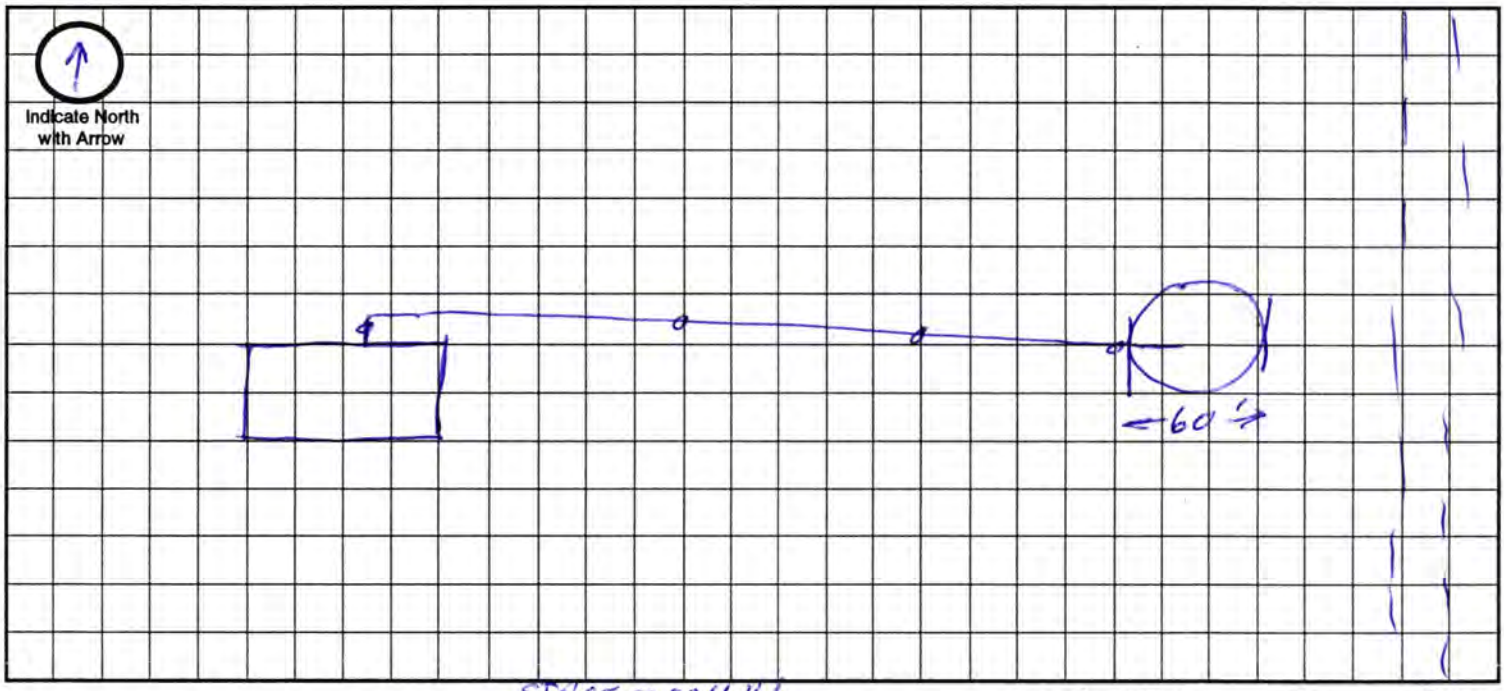

Approximate Scale: _____ ft. = _____ grid line/s

A. System Location (Indicate correct number and street)

Address (no rural route) 13234 Stagecoach City Hickman NE, Zip 68372

B. Proposed Septic Tank/s

Tank Material: ☐ Concrete ☐ Plastic ☐ Other _____

C. Proposed Absorption System (See Form B for Percolation Information)

Percolation Rate _____ (min. per inch) Soil Type: _____ Land Slope: _____ %

Type of Absorption System: ☐ Trench ☐ Bed ☐ Other _____

Total Square Feet of Field Required: _____ sq. ft.

Type of Lateral: ☐ Half-Moon ☐ Perforated Pipe ☐ Other Lateral Material: _____

Capacity of Septic Tank _____ gals Number of Absorption Beds: _____ Number of Distribution Laterals per Bed _____

Total Length of Laterals _____ ft. Number of Trenches _____ Trench Width _____

D. Setbacks Check the Boxes Below if the Required Setback has been Satisfied

Distance From	Private Well	Public Well	Surface Water	Gound Water	Pressure Water Lines	Property Lines	Foundations Yours	Foundations Neighbors	All Other Setbacks
Tank (ft)	50 ☐	500 ☐	50 ☐	NA ☐	25 ☐	20 ☐	15 ☐	25 ☐	☐
Field (ft)	100 ☐	500 ☐	50 ☐	4 ☐	30 ☐	20 ☐	30 ☐	40 ☐	☐
Lagoon (ft)	100 ☒	500 ☒	50 ☒	N/A ☐	30 ☒	50 ☒	100 ☒	200 ☒	☒

E. Required Signatures

Home Building Contractor _____ Date _____

Installer Brad Burtness Date 3-15-05

FORM 23-102 10-96

Lincoln-Lancaster County Health Department
Environmental Health Division
3140 "N" Street • Lincoln, NE 68510-1514
Phone: 402-441-8022

D

Permit Number:

Sewage Disposal System

As Built Plans & Specifications

Date 8-12-05

System Location (Indicate correct number and street)

Address 13431 Stage Coach Rd (no rural route) City Hickman, NE, Zip 68372

A. Building Sewer

1. Material: Sch 40 PVC
   Diameter: 4 in.
2. Distance above basement floor: _____ in.
   or distance below basement floor: 13 in.
3. Distance between dwelling and ~~septic tank~~ Lagoon: 40 ft.
4. Number of clean-outs: 7
5. Distances to: well or suction line > 50 ft.
   stream N/A ft.
   pressure line > 5 ft.
   property line > 50 ft.

B. Septic Tank

1. Material: _____
   Number of compartments: _____
2. Capacity: _____ gal.
3. Factory built: ☐ Yes ☐ No
4. Manholes: Over inlet, diameter _____ in.
   Over outlet, diameter _____ in.
   Riser: ☐ above ☐ below grade _____ in.
5. Inlet: ☐ baffle ☐ tee
6. Outlet: ☐ baffle ☐ tee
7. Depth to top of tank, below unfinished grade: _____ in.
8. Distances to: Well or suction line _____ ft.
   Stream _____ ft.
   Pressure line _____ ft.
   Property line _____ ft.

C. Distribution Box

1. Material: _____
   Number available outlets: _____
2. Factory built: ☐ Yes ☐ No
3. Distance from septic tank: _____ ft.

D. Absorption Field


(Provide as-built drawings on back of this form)

1. Type: ☐ Half rounds ☐ Perforated pipe
   Diameter of half round: _____
   or perforated pipe: _____
   Material: ☐ fiberglass ☐ plastic ☐ concrete
   ☐ other _____
2. Lateral lines: Number _____
   Length of each line: _____ ft. _____ ft.
   _____ ft. _____ ft., _____ ft.
3. Trench dimensions: Width _____ ft.
   Slope _____ in/100 ft.
   Average depth _____ in
4. Filter material: _____
   Depth of material _____ in.
5. Distances to: Well or suction line _____ ft.
   Stream _____ ft.
   Pressure line _____ ft.
   Property line _____ ft.


Complete "As Built" drawing on back of this form.

Indicate North with Arrow

Individual Sewage System Design (Example)

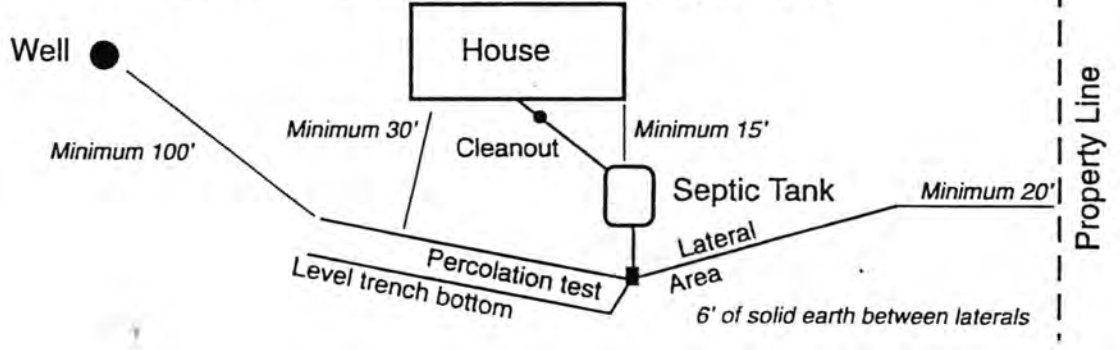

As Built Drawing

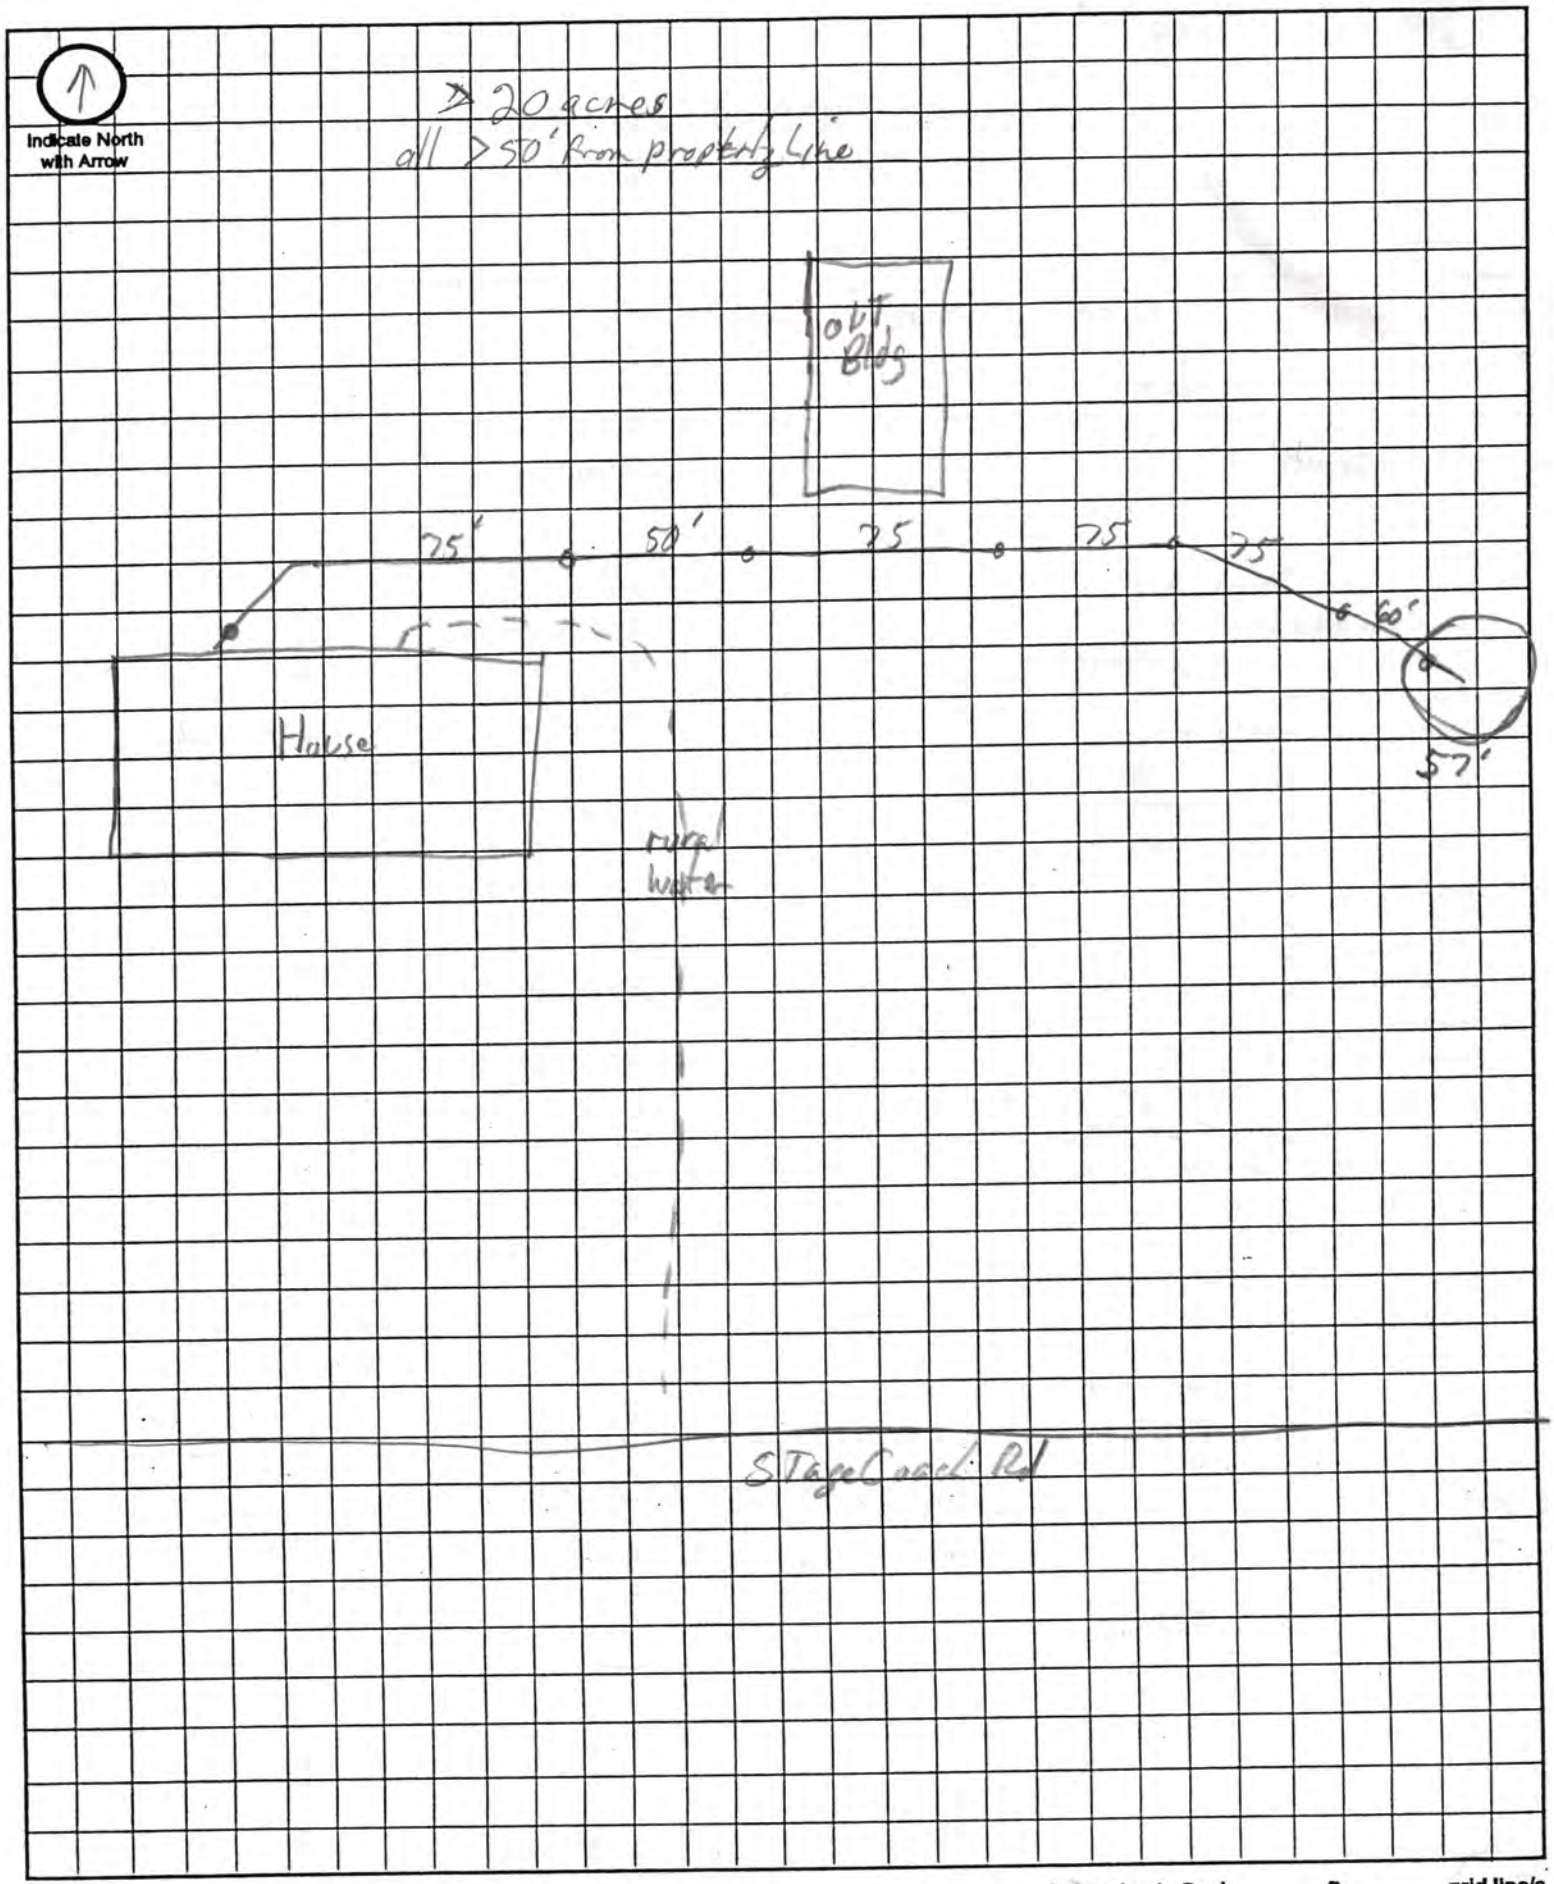

Approximate Scale: _____ ft. = _____ grid line/s