Lincoln-Lancaster County Health Department
Environmental Health Division
3140 "N" Street • Lincoln, NE 68510-1514
Phone: 402-441-8022

D

Permit Number:

Sewage Disposal System

As Built Plans & Specifications

Date 6-18-07

System Location (Indicate correct number and street)

Address 2626 W. STALLION CIR (no rural route) City LINCOLN NE NE, Zip 68523

A. Building Sewer

1. Material: PVC
   Diameter: 4 in.
2. Distance above basement floor: N/A in.
   or distance below basement floor: 12 in.
3. Distance between dwelling and septic tank: 15 ft.
4. Number of clean-outs: 2
5. Distances to: well or suction line 160 ft.
   stream N/A ft.
   pressure line N/A ft.
   property line 65 ft.

B. Septic Tank

1. Material: PLASTIC COMPOSIT
   Number of compartments:
2. Capacity: 1000 gal.
3. Factory built: ☑ Yes ☐ No
4. Manholes: Over inlet, diameter ____ in.
   Over outlet, diameter ____ in.
   Riser: ☒ above ☐ below grade 6 in.
5. Inlet: ☒ baffle ☐ tee
6. Outlet: ☒ baffle ☐ tee
7. Depth to top of tank, below unfinished grade: 48 in.
8. Distances to: Well or suction line 160 ft.
   Stream N/A ft.
   Pressure line N/A ft.
   Property line 55 ft.

C. Distribution Box

1. Material: PLASTIC COMPOSIT
   Number available outlets: 8
2. Factory built: ☒ Yes ☐ No
3. Distance from septic tank: 12 ft.

D. Absorption Field


(Provide as-built drawings on back of this form)

1. Type: ☒ Half rounds ☐ Perforated pipe
   Diameter of half round: 34 IN
   or perforated pipe:
   Material: ☐ fiberglass ☒ plastic ☐ concrete
   ☐ other
2. Lateral lines: Number 1
   Length of each line: 100 ft. ____ ft.
   ____ ft. ____ ft., ____ ft.
3. Trench dimensions: Width 4FT ft.
   Slope 2½ in/100 ft.
   Average depth 36 in
4. Filter material: P-GRAVEL
   Depth of material ____ in.
5. Distances to: Well or suction line 180 ft.
   Stream N/A ft.
   Pressure line N/A ft.
   Property line 55 ft.

Complete "As Built" drawing on back of this form.

Indicate North with Arrow

Individual Sewage System Design (Example)

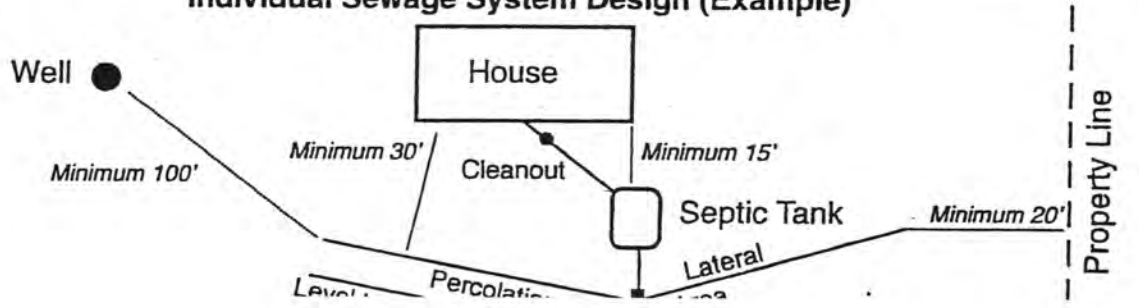

As Built Drawing

2626 W. Stallion Cir
Lincoln NE 68523

