To Jerry Hood Oakel House

D

Lincoln-Lancaster County Health Department
Environmental Health Division
3140 "N" Street • Lincoln, NE 68510-1514
Phone: 402-441-8022

Permit Number:

Sewage Disposal System
As Built Plans & Specifications

Date 5-19-98

System Location (Indicate correct number and street)

Address 9500 So. 64th (no rural route) City Lincoln NE, Zip 685

A. Building Sewer

1. Material: PVC CL 160
   Diameter: 4" in.
2. Distance above basement floor: [redacted] in.
   or distance below basement floor: 12 in.
3. Distance between dwelling and septic tank: _____ ft.
4. Number of clean-outs: 1
5. Distances to: well or suction line [redacted] ft.
   stream _____ ft.
   pressure line _____ ft.
   property line _____ ft.

B. Septic Tank

1. Material: Concrete
   Number of compartments: 3
2. Capacity: 1500 gal.
3. Factory built: ☑ Yes ☐ No
4. Manholes: Over inlet, diameter _____ in.
   Over outlet, diameter _____ in.
   Riser: ☑ above ☐ below grade 6 in.
5. Inlet: ☑ baffle ☐ tee
6. Outlet: ☑ baffle ☐ tee
7. Depth to top of tank, below unfinished grade: 85 in.
8. Distances to: Well or suction line 200 ft.
   Stream _____ ft.
   Pressure line _____ ft.
   Property line 22 ft.

C. Distribution Box

1. Material: Plastic
   Number available outlets: 5
2. Factory built: ☑ Yes ☐ No
3. Distance from septic tank: 10 ft.

D. Absorption Field


(Provide as-built drawings on back of this form)

1. Type: ☐ Half rounds ☑ Perforated pipe
   Diameter of half round: _____
   or perforated pipe: 4"
   Material: ☐ fiberglass ☑ plastic ☐ concrete
   ☐ other _____
2. Lateral lines: Number 5
   Length of each line: 70 ft. 70 ft.
   100 ft. 100 ft., 100 ft.
3. Trench dimensions: Width 3 ft.
   Slope 5 in/100 ft.
   Average depth 40 in
4. Filter material: _____
   Depth of material _____ in.
5. Distances to: Well or suction line 200 ft.
   Stream _____ ft.
   Pressure line _____ ft.
   Property line 20 ft.

Complete "As Built" drawing on back of this form.

Indicate North with Arrow


Individual Sewage System Design (Example)

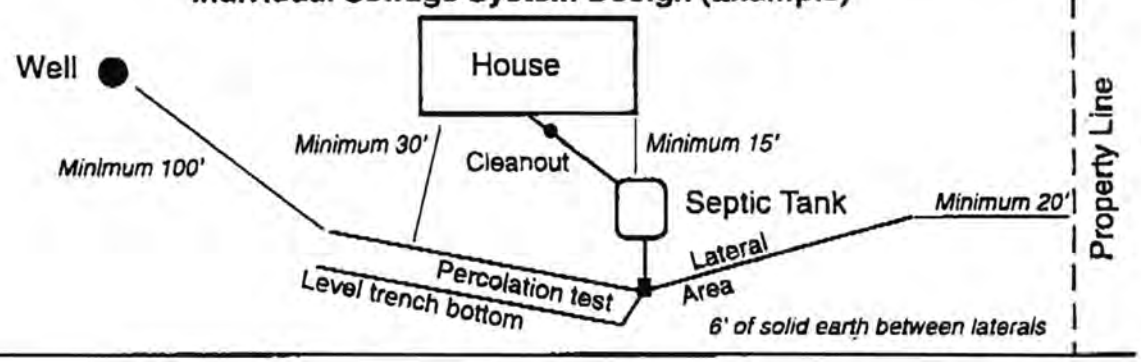

FORM 23-103 10-96

As Built Drawing

Wellmann Plumbing

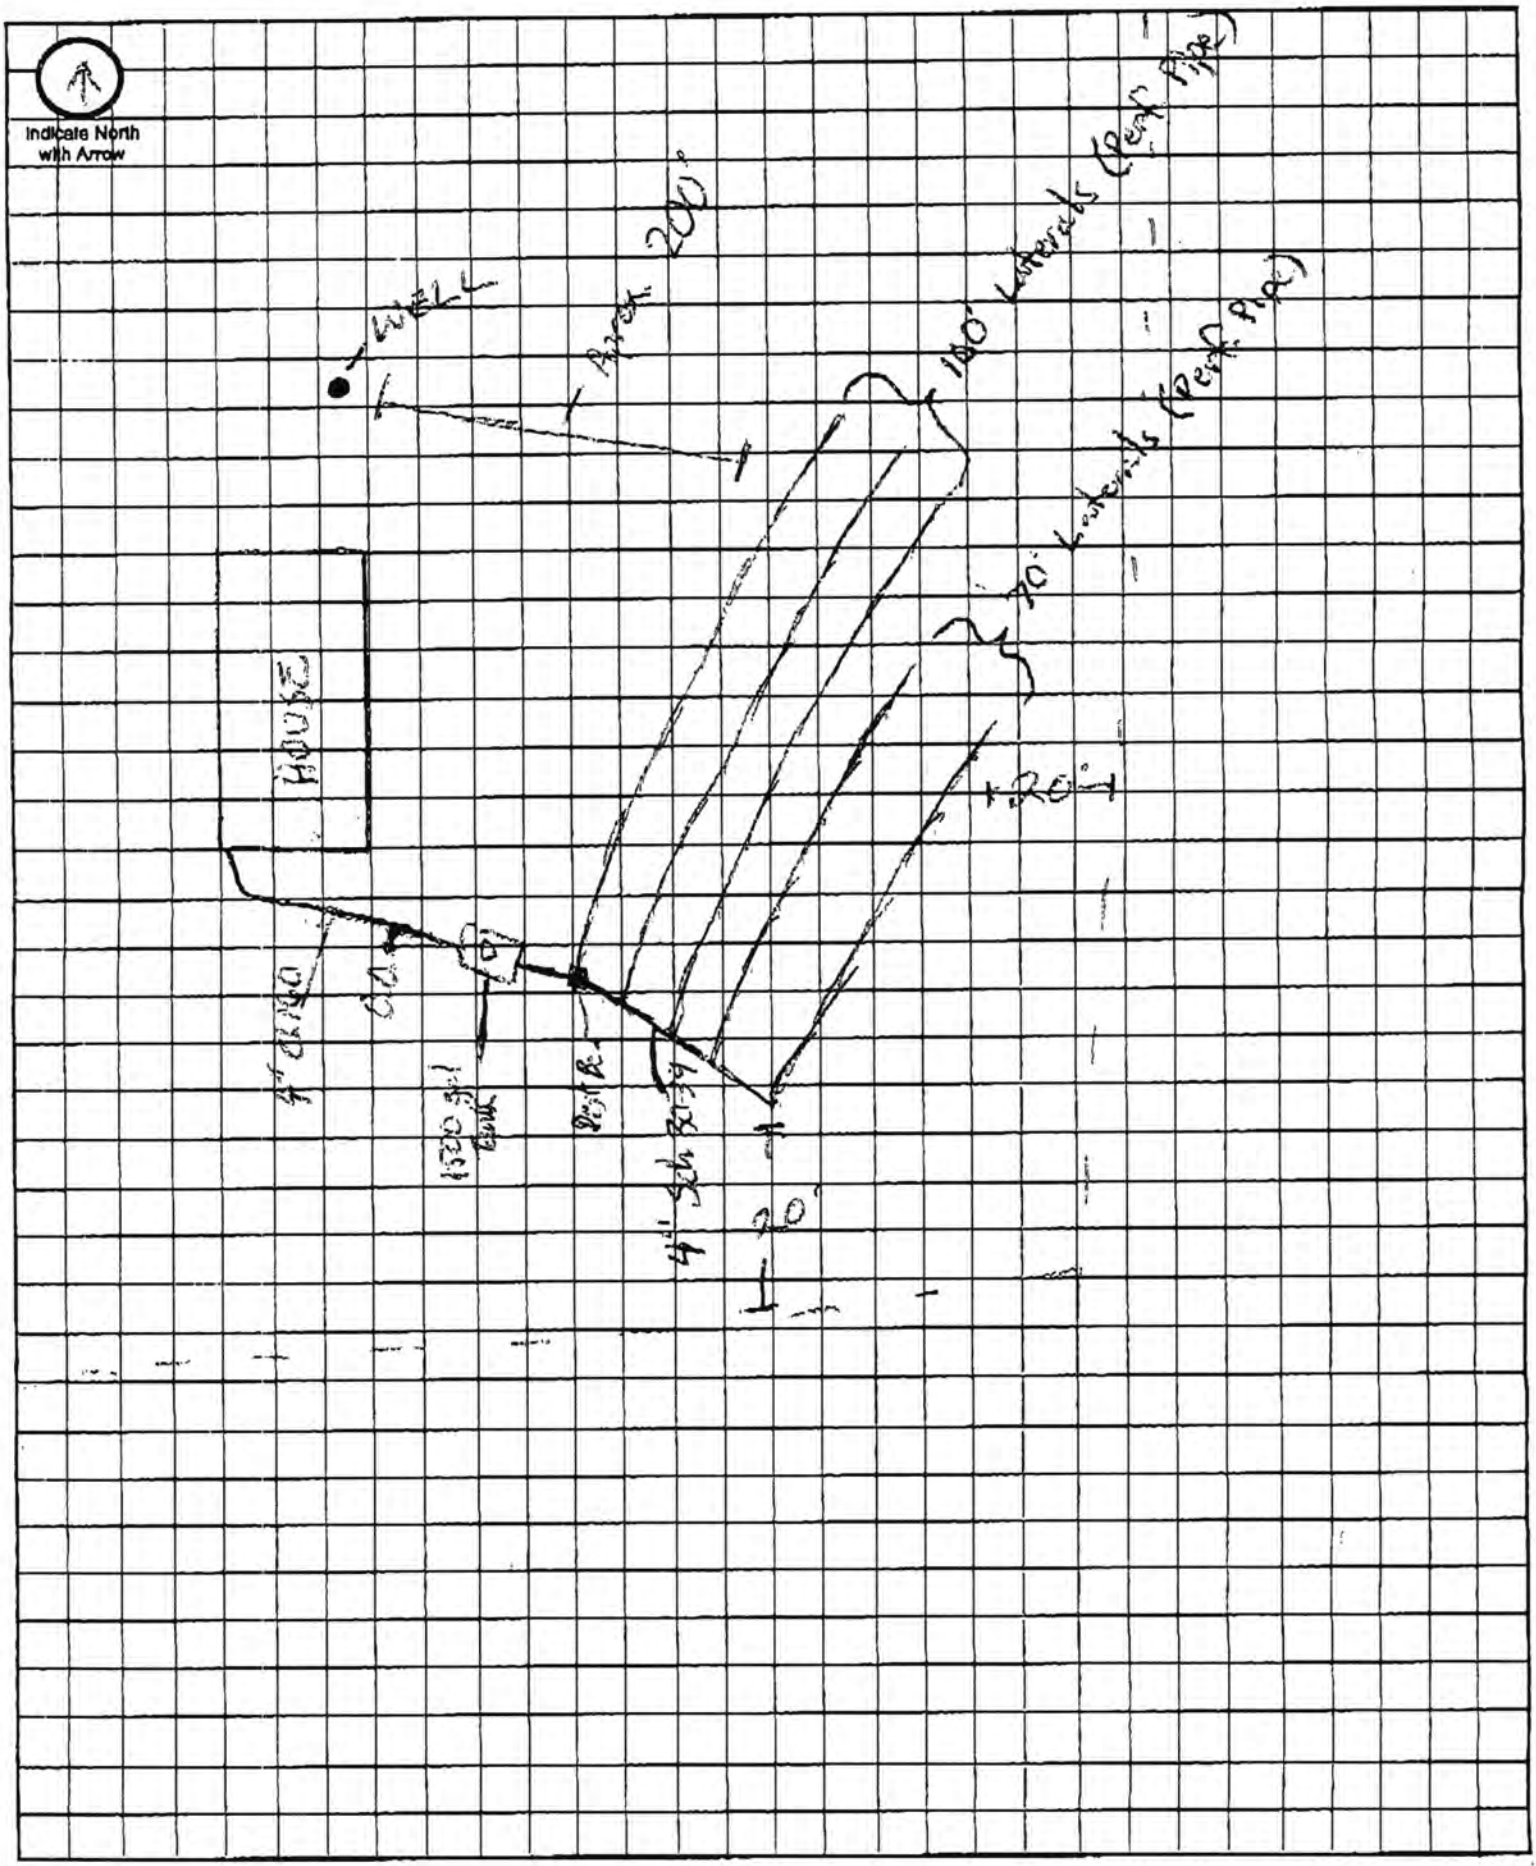

Approximate Scale: _____ ft. = _____ grid line/s