FILE #2554

CITY OF LINCOLN NEBRASKA

DEPARTMENT OF LICENSES AND PERMITS

INDIVIDUAL SEWAGE SYSTEM CONSTRUCTION — TYPE OF LICENSE OR PERMIT

FEBRUARY 27 1988 — THIS LICENSE OR PERMIT EXPIRES

ERAN D. ZAMB & VOLDEMAR POOL, 7700 YANKEE HILL ROAD, LINCOLN, NE 68516 — LICENSEE OR PERMITTEE / ADDRESS

T9N; R7E; Sec 22; Lot 29 I.T.; 7700 Yankee Hill Road — NAME OF ESTABLISHMENT, IF ANY / ADDRESS

REMARKS: NON TRANSFERABLE ALTER, EXTEND OR REPAIR

PERMIT	ACCOUNTING NUMBER	TOTAL
$ 30.00	018754	$ 30.00

Valid Receipt Only if Machine Receipted In This Space

Serial No. — Date and Amount

APPLICATION

HEALTH — ISSUING OFFICER OR DEPARTMENT

THIS LICENSE OR PERMIT IS ISSUED SUBJECT TO REVOCATION AS PROVIDED BY LAW

FORM HD-41(73) APPLICATION FOR PERMIT TO ALTER, EXTEND OR REPAIR INDIVIDUAL SEWAGE DISPOSAL SYSTEM

City Ordinance No. 9150 [X]
County Resolution No. 2832 [ ]

LINCOLN-LANCASTER COUNTY HEALTH DEPARTMENT
Division of Environmental Health
2200 St. Marys Ave.
Lincoln, Nebraska 68502 (Phone: 471-7800)

FILE NO. 2554

TO: Division of Environmental Health
Lincoln-Lancaster County Health Dept.

DATE: 8-25-1987

The undersigned hereby applies for a permit to ALTER [X], EXTEND [ ], or REPAIR [ ] an existing Individual Sewage Disposal System, in conformance with appropriate Ordinance or Resolution, as described in this application and drawings attached hereto.

1. Legal description of property: Twp. 9N; Range 7E; Section 22;
Block ____; Lot 29 IT; Addition ____
Street Address 7700 YANKEE HILL ROAD

2. Property Use: Residential ____ [X]; Commercial ____ [ ]
No. Bedrooms 4 Describe ____
Other Use [ ]
Describe ____

3. Type of existing Individual Sewage Disposal System: Septic Tank [X]; Other [ ]

4. Description of proposed alteration, extension or repair: REPLACE THE LATERAL FIELD IN THE PROPOSED NRD FLOOD CONTROL STRUCTURE AREA WITH A 16' WIDE TRENCH FILLED TO 6' DEEP WITH POROUS SOIL FROM THE EXISTING LATERAL AREA AND LOCATED NORTH OF EXISTING SEPTIC TANK.

5. Work to be done by: Owner [ ]; or Contractor [X], BRAD SOUTHWICK
Contractor's Name

6. Estimated cost of project:

a. Materials	$ 810	-
b. Labor	$ 640	-
c. Other	$ 750	- (MOVE SOIL)
TOTAL	$ 2,200	-

Signature of Applicant (owner or lessee)

7700 YANKEE HILL ROAD, LINCOLN, NE 68516
Address

(Do not write below this line)

REVIEWING ACTION

1. Date Rec'd: ____
Filing Fee: $ 30.00

2. Site Visits:
Date: 10-22-87 by: ____
Date: ____ by: ____
Date: ____ by: ____

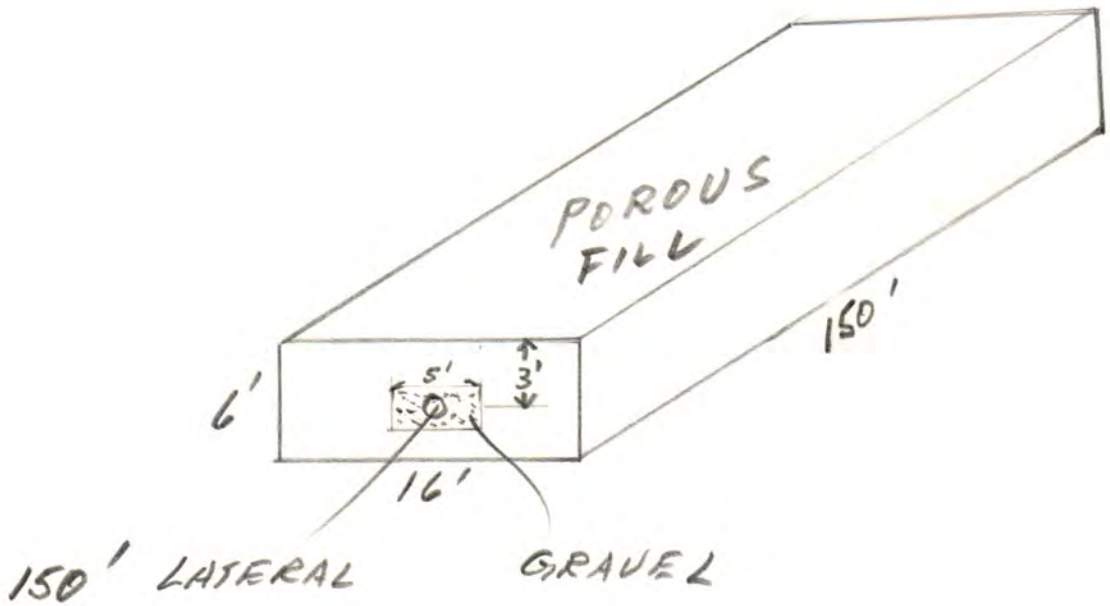
3. Date: Approved [X]; Disapproved [ ]
by: Jerrold C. Hood

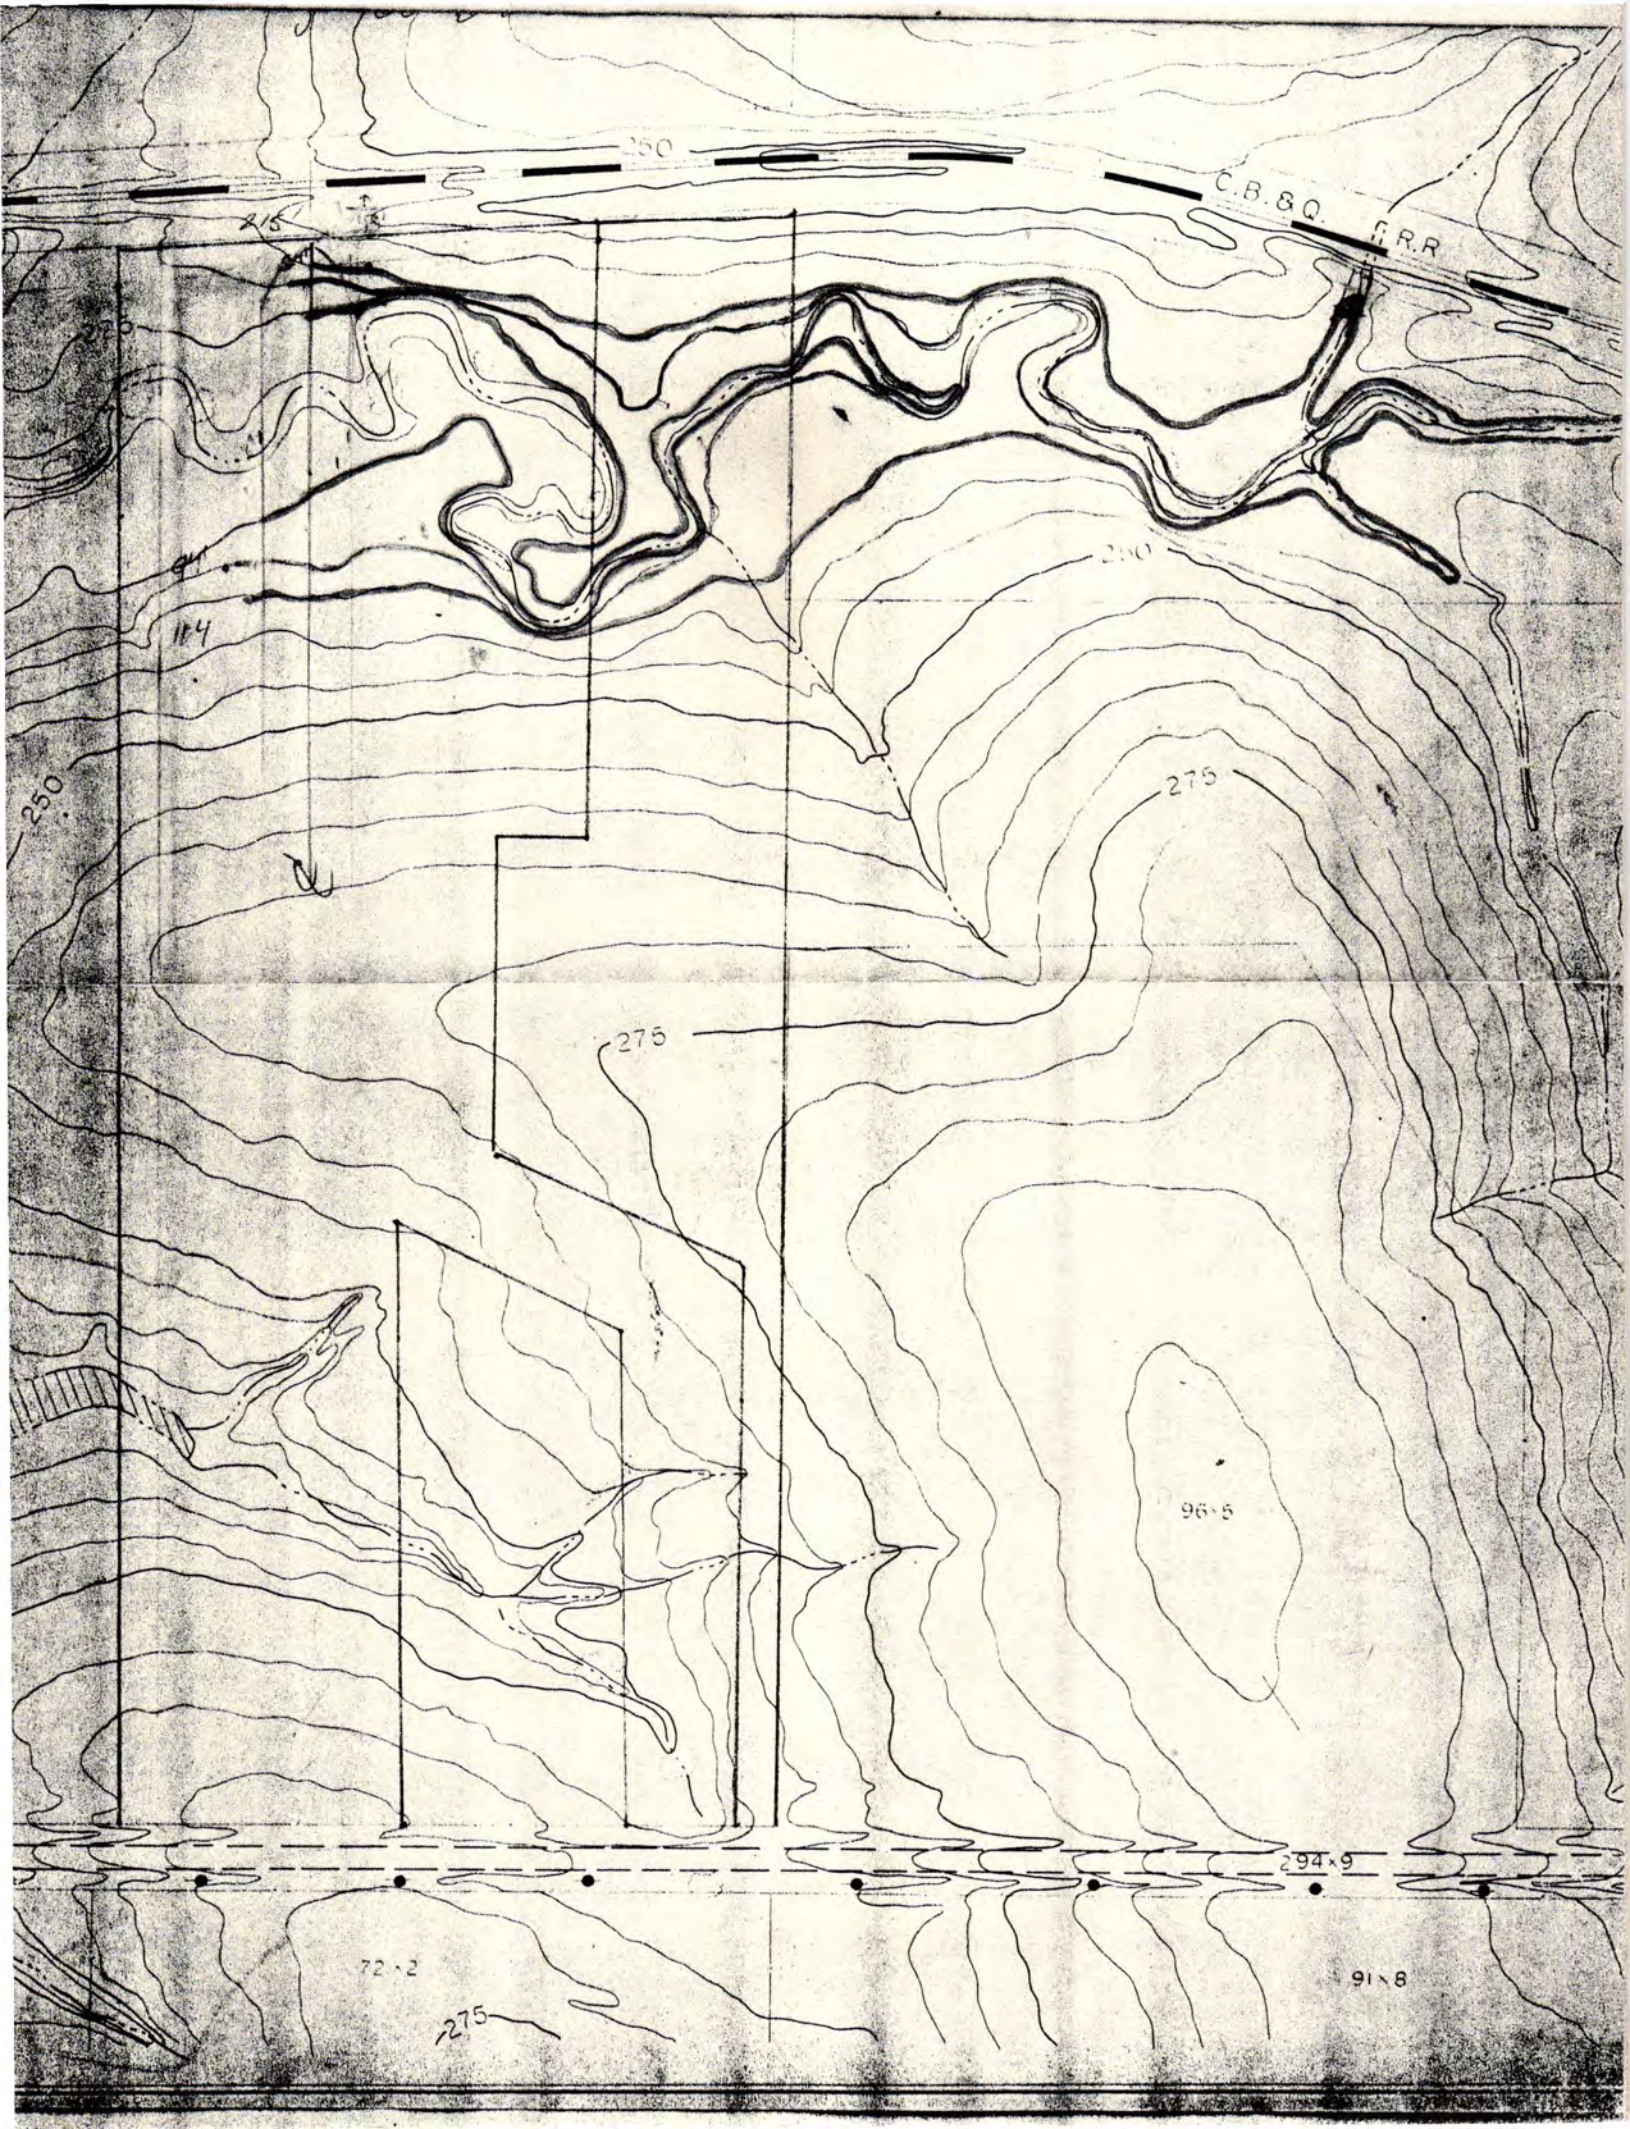
4. INSTALLATION FINAL WRITTEN APPROVAL
Date: ____ by: ____

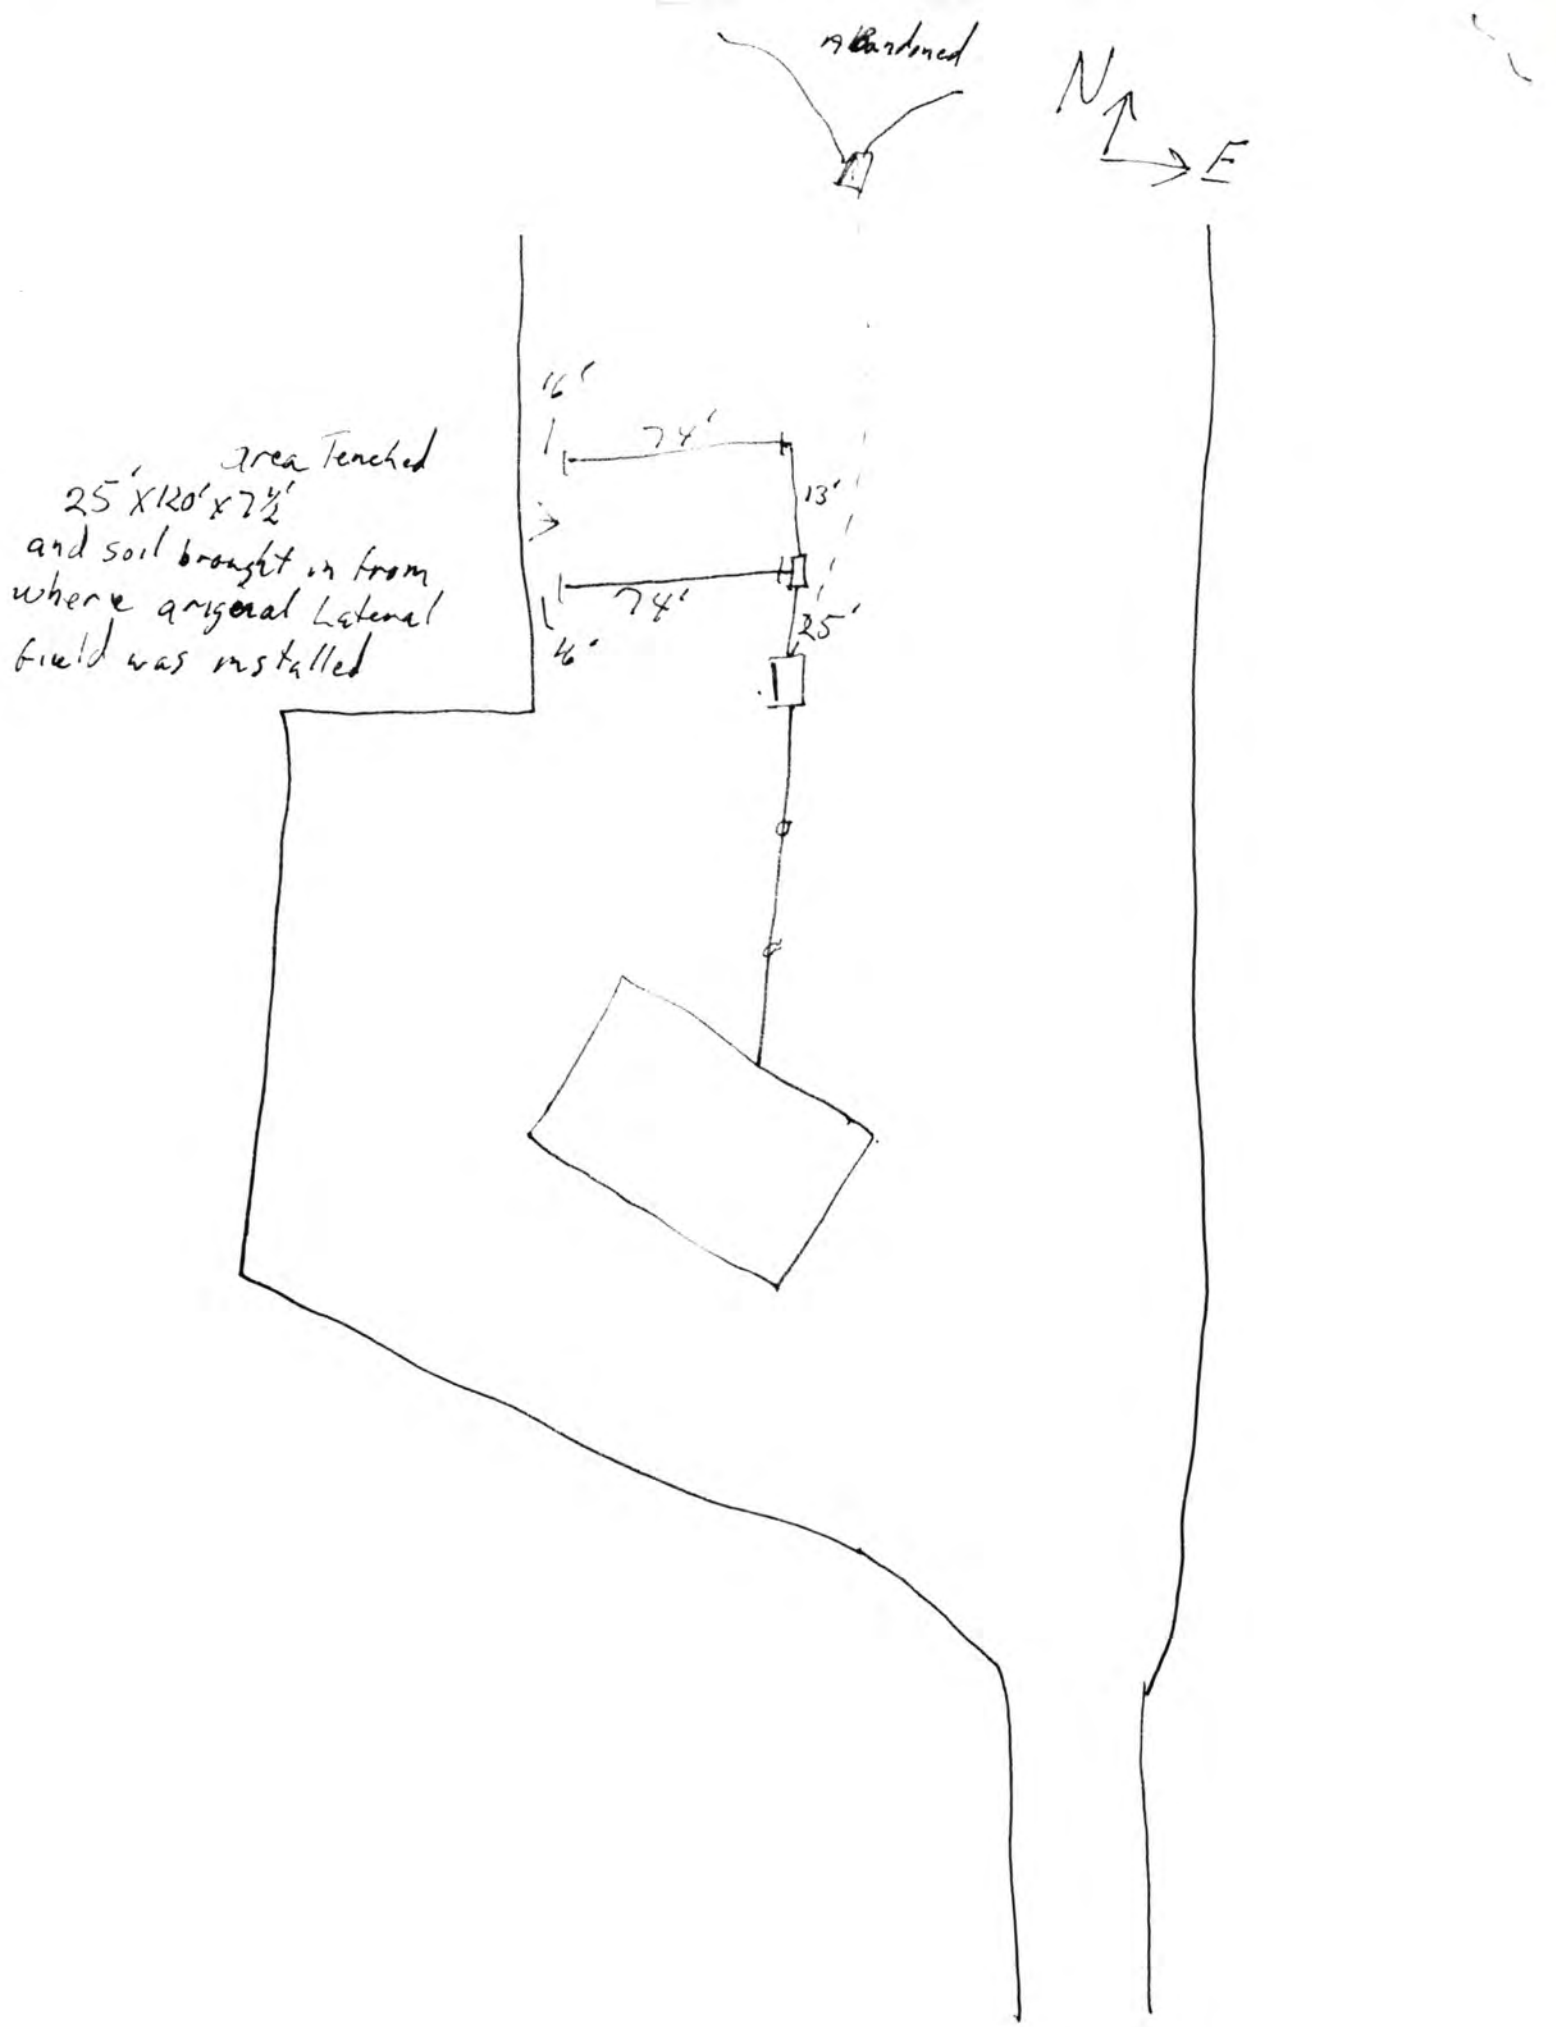
X DIFFERENT CONCEPT, SO EXPERIMENTAL, PROVISIONAL APPROVAL.

2554

PROPOSED NEW LATERL AREA
7700 YANKEE HILL RD.




C.B.&Q. R.R.
250
275
275
275
96.5
94.9
72.2
91.8


Abandoned
N
E
Area Trenched
25' X 120' x 7½'
and soil brought in from
where original Lateral
field was installed
6'
74'
13'
74'
25'
6'