Lincoln-Lancaster County Health Department

ENVIRONMENTAL HEALTH DIVISION

3140 N STREET · LINCOLN, NE 68510-1514 (402) 441-8000

Permit
SEWAGE INSTALLATION
OTHER DESIGNED SEWAGE DISPOSAL SYSTEM

Permit # 02380249101

Issued 06/10/02
Expires 12/10/02
Revenue Code 3157

Establishment
MIKE ENGEL
T9N R8E SEC 7
LOT 20
4800 S 112 ST

FEES: $300.00

TOTAL: $300.00

Permittee
MIKE ENGEL
4800 S 112 ST
LINCOLN NE 68520

Bruce D. Dart

Bruce D. Dart, Health Director

• POST IN A PROMINENT PLACE • NOT TRANSFERABLE

002469

Non-Standard Onsite

A

Lincoln-Lancaster County Health Department
Environmental Health Division
3140 "N" Street • Lincoln, NE 68510-1514
Phone: 402-441-8022

Permit Number: 02380249

Sewage Disposal System

Request for Site Clearance and Permit

Include Form B, Form C and Applicable Fees with this Application.

☐ Septic System ☐ Lagoon ☑ Other (Refer to Form C)

The undersigned hereby requests site clearance and permit to construct a Sewage Disposal System in conformance with appropriate resolution or ordinance, as described herein:

PLEASE PRINT OR TYPE

A. System Location (Indicate correct number and street)

Address 4600 S. 112th (no rural route) City Lincoln NE, Zip

Legal Description 1/4 7 1/4 Section 9N Township 8E Range Subdivision Addition Block Lot 20 A.T.

Geographical Location (if known): Longitude Latitude

☐ Check if system mail address is not the same as the owner's address

B. Owner

Name Mike Engel Signature

Address 4800 S. 112th City/State/Zip Lincoln Ne.

☐ Check if owner designed system Home Phone Work Phone

C. Contractor

Name Gary Cort Company Name Heritage Builders

Address City/State/Zip Lincoln Ne.

☐ Check if contractor designed system Work Phone

D. Engineer/Installer ☐ Check and complete if engineer designed system

Designer Name Jeremy Williams Firm Design Assoc. Work Phone

E. This System Will Serve a

☑ Residential Dwelling Number of Bedrooms 4 Is there a Whirlpool Bathtub (YES) NO

☐ Commercial Establishment/Other Facility Specify

Design flow in gallons per day Type of Wastewater: ☐ Domestic ☐ Non-Domestic.

DO NOT WRITE BELOW THIS LINE

Approval Process ☒ Municipal Code 24.38 ☐ County Resolution No. 2832

1. **Health Department** Date rec'd 6/10/02 Date frwd 6/10/02 ACTION ☒ Approved ☐ Disapproved Signature Jerrold C. Wood
2. **Supt. Bldg. Insp. or Village Clerk** Date rec'd 6-10-02 Date frwd 6-10-02 ACTION ☒ Approved ☐ Disapproved Signature
3. **City or County Engineer** Date rec'd 6/10/02 Date frwd 6/10/02 ACTION ☒ Approved ☐ Disapproved Signature Chase Bolen

~~4/4/02 Sewer, tank + 3 laterals. J.C.H.~~ 6/12/02

Installation Final Written Approval

By Jerrold C. Wood R.E.H.S.

Date JUNE 12, 2002

Business Office Use Only (SPECIAL) Fee 300.00


Date Rec'd 06/10/02

Amt Paid 300.00

Rec'd By Cash/Check No. 33395

FORM 23-100 10-96 White - Health Dept. Yellow - Engineer Pink - Bldg. Inspector


#023802491

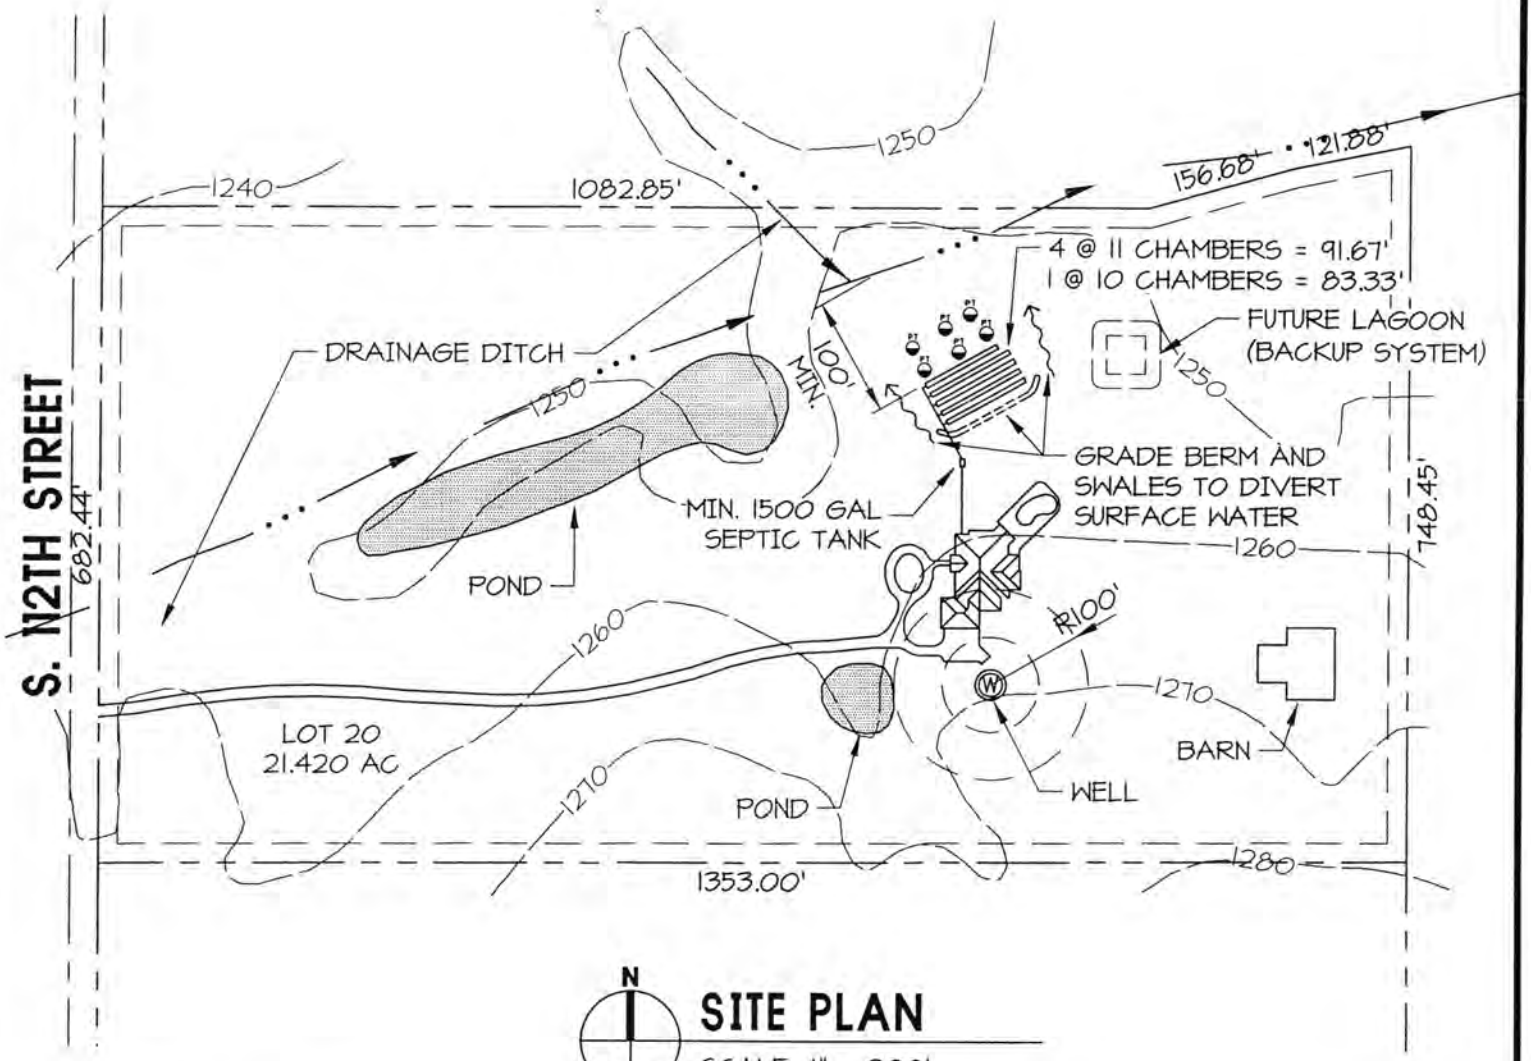

N

SITE PLAN

SCALE: 1" = 200'

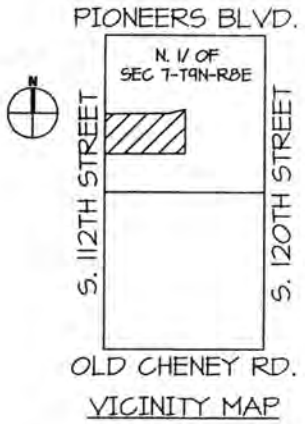

VICINITY MAP

Pollution Control Project

Nebraska DEQ

02-OWT-006

APPROVED

~~JUN 0 8 2002~~

REGISTERED PROFESSIONAL ENGINEER
BERNARD L. HOTTOVY
E-4113
STATE OF NEBRASKA

May 20, 2002

1 OF 2

DESIGN ASSOCIATES OF LINCOLN, INC

PERSHING SQUARE
1609 "N" STREET
LINCOLN NEBRASKA 68508
voice: 402/474-3000
fax: 402/474-4045
desassoc@inebraska.com

project no.

sheet name: ON-SITE WASTEWATER TREATMENT SYSTEM


4800 S. 112TH STREET

LOT 20, N 1/2 SEC 7 T9N R8E
LINCOLN, NEBRASKA

date: 25 MAR 2002
revised: △ 20 MAY 02 △


Built as shown.

#D23802491

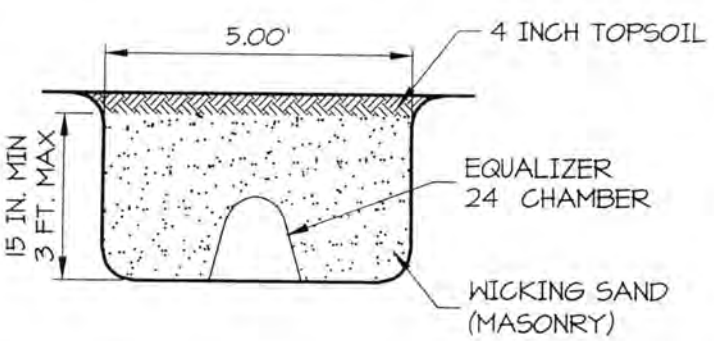


SECTION A-A

NO SCALE

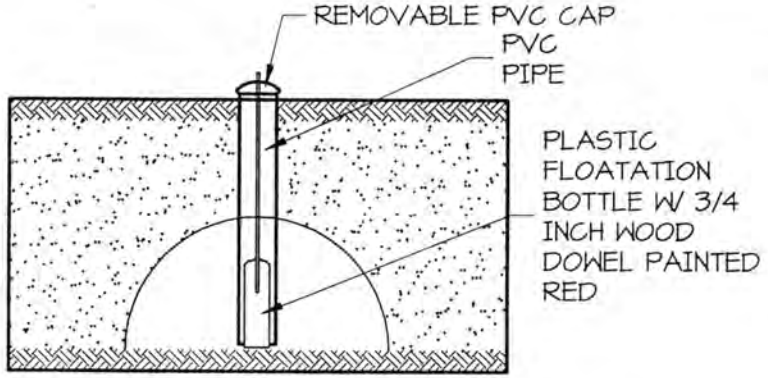

HIGH WATER INDICATOR

NO SCALE (REQUIRED)

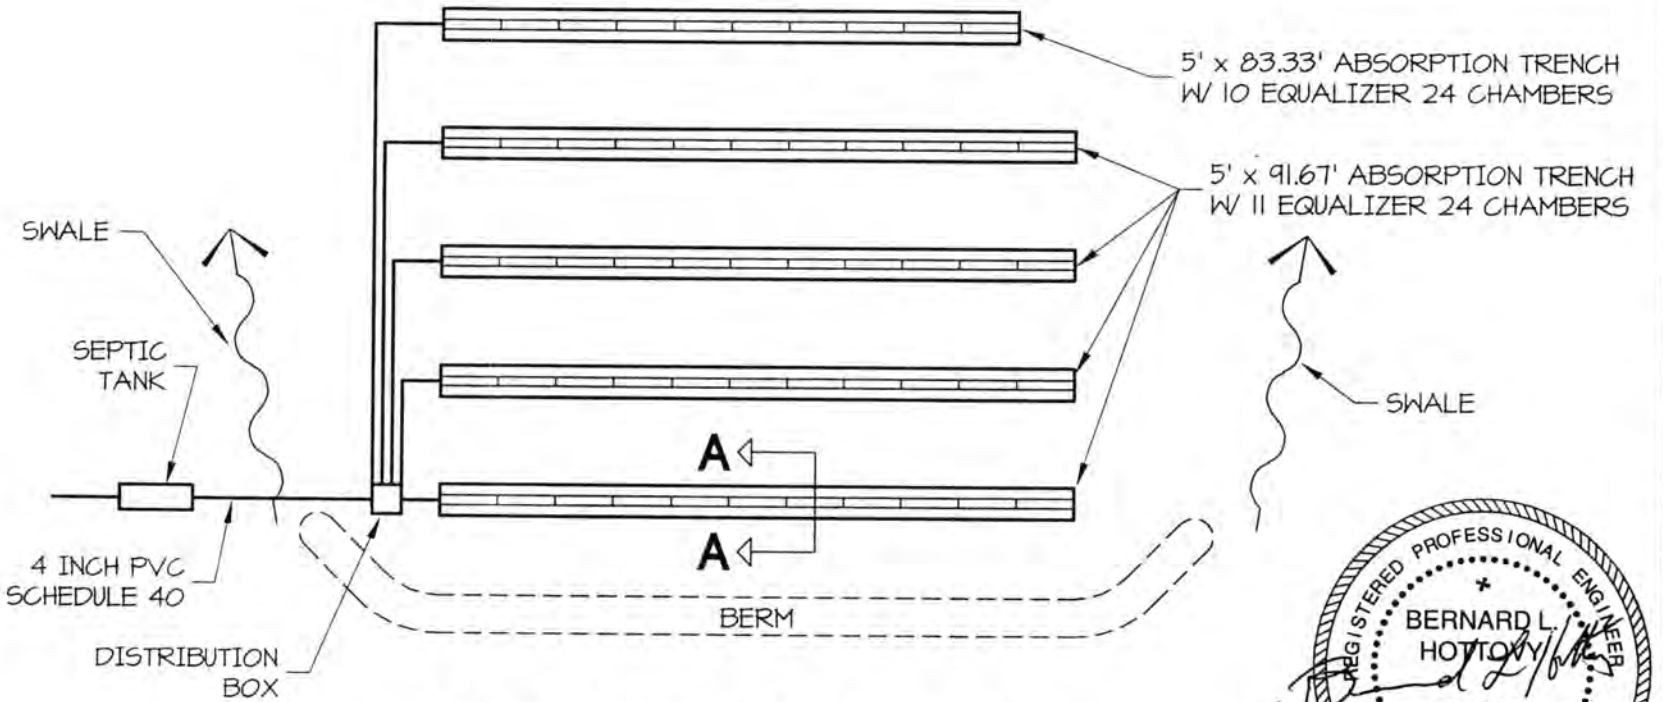

ABSORPTION TRENCH PLAN

NO SCALE

REGISTERED PROFESSIONAL ENGINEER
BERNARD L. HOTTOVY
E-4113
STATE OF NEBRASKA

25 MAR 2002
20 MAY 02

4800 S. 112TH STREET

LOT 20, N 1/2 SEC 7 T9N R8E
LINCOLN, NEBRASKA

ON-SITE WASTEWATER TREATMENT SYSTEM

DESIGN ASSOCIATES OF LINCOLN, INC.
1609 "N" STREET
LINCOLN, NEBRASKA 68508
PHONE:(402) 474-3000
FAX:(402) 474-4045
desassoc@inebraska.com

2 OF 2