D

Lincoln-Lancaster County Health Department
Environmental Health Division
3140 "N" Street • Lincoln, NE 68510-1514
Phone: 402-441-8022

Permit Number:

Sewage Disposal System

As Built Plans & Specifications

Date 27SEPT 2011

System Location (Indicate correct number and street)

Address ~~11630~~ 11633 ASPEN CANYON Rd. (no rural route) City LINCOLN NE, Zip 68526

A. Building Sewer

1. Material: PVC
   Diameter: 4 in.
2. Distance above basement floor: _____ in.
   or distance below basement floor: 24 in.
3. Distance between dwelling and septic tank: 83 ft.
4. Number of clean-outs: 2
5. Distances to: well or suction line NA ft.
   stream NA ft.
   pressure line 30 ft.
   property line 100 ft.

B. Septic Tank

1. Material: CONCRETE
   Number of compartments: 1
2. Capacity: 1250 gal.
3. Factory built: ☒ Yes ☐ No
4. Manholes: Over inlet, diameter _____ in.
   Over outlet, diameter _____ in.
   Riser: ☒ above ☐ below grade 4 in.
5. Inlet: ☒ baffle ☐ tee
6. Outlet: ☒ baffle ☐ tee
7. Depth to top of tank, below unfinished grade: 20 in.
8. Distances to: Well or suction line NA ft.
   Stream NA ft.
   Pressure line OVER 50 ft.
   Property line OVER 50 ft.

C. Distribution Box

1. Material: _____
   Number available outlets: _____
2. Factory built: ☐ Yes ☐ No
3. Distance from septic tank: 45 ft.

D. Absorption Field


(Provide as-built drawings on back of this form)

1. Type: ☐ Half rounds ☐ Perforated pipe
   Diameter of half round: _____
   or perforated pipe: _____
   Material: ☐ fiberglass ☐ plastic ☐ concrete
   ☐ other INFILTRATORS
2. Lateral lines: Number 2
   Length of each line: 116 ft. 116 ft.
   _____ ft. _____ ft., _____ ft.
3. Trench dimensions: Width 4 ft.
   Slope 0 in/100 ft.
   Average depth 18 in
4. Filter material: NA
   Depth of material NA in.
5. Distances to: Well or suction line NA ft.
   Stream NA ft.
   Pressure line OVER 75 ft.
   Property line " " ft.

Complete "As Built" drawing on back of this form.

Indicate North with Arrow

Individual Sewage System Design (Example)

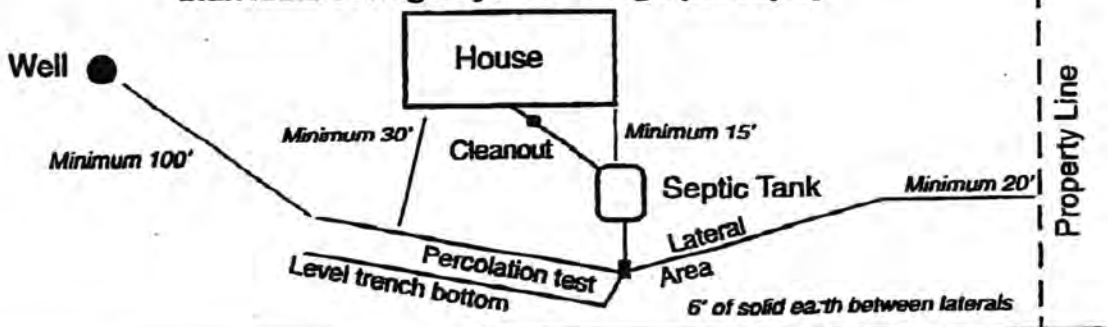

FORM 23-103 10-96

As Built Drawing

11433 ~~11460~~ Aspen Canyon Rd

