LINCOLN-LANCASTER COUNTY HEALTH DEPARTMENT

FILE NO. 1445-C

INDIVIDUAL SEWAGE SYSTEM CONSTRUCTION — TYPE OF PERMIT

April 27, 1979 — THIS PERMIT EXPIRES

Paul Nordstrom — ISSUED TO

Box 165, Waverly, NE — ADDRESS

T12N, R7E, Section 11 — LEGAL DESCRIPTION

REMARKS: NON-TRANSFERABLE

PERMIT	INSPECTION FEE	OCCUPATION TAX	TOTAL
$ 30.00	$	$	$ 30.00
ACCOUNTING NO.	ACCOUNTING NO.	ACCOUNTING NO.	CODE
018754	110.16	148.14	6-2

RECEIPTED BY — DATE — AMOUNT

VALID RECEIPT ONLY IF RECEIPTED IN THIS SPACE

HEALTH — ISSUING OFFICER

THIS PERMIT IS ISSUED AS PROVIDED BY COUNTY RESOLUTION NO. ———

20109-0977

FORM 20103-0477
REQUEST FOR SITE CLEARANCE AND PERMIT
FOR INDIVIDUAL SEWAGE DISPOSAL SYSTEM
City Ordinance No. 9150 ☐
County Resolution No. 2832 ☒

LINCOLN-LANCASTER COUNTY HEALTH DEPARTMENT
Division of Environmental Health
2200 St. Marys Avenue
Lincoln, Nebraska 68502
Phone: 474-1541

FILING FEE: $ 30.00

FILE NO. 1445-C

DATE: _____

The undersigned hereby requests SITE CLEARANCE and PERMIT to construct an Individual Sewage Disposal System in conformance with appropriate resolution or ordinance, as described herein:

1. Legal description of property: Twp. 12N; Range 7E; Section 11; NE¼ NE¼
   Block _____: Lot _____: Addition _____
   Street Address RFD Waverly, Nebr. 68462
2. Property Use: Residential ☒ ; Commercial ☐ Other Use ☐
   No. of Bedrooms 2. Describe Mobile Home
3. Type of Individual Sewage Disposal System: Septic Tank ☒ ; Other ☐
4. Distance to public sewer: _____ ft.

Paul Nordstrom
Signature of Applicant (Owner or Lessee)
RFD Box 165
Waverly, Nebr. 68462
Address

(Do not write below this double line)

1. Health Department: Date Rec'd. 10/26/78. Date Frwd. 10/27/78. ACTION: Approved ☒ Disapproved ☐ Signature: Jerrold C. Hood
2. Supt. Bldg. Insp.: or Village Clerk Date Rec'd. _____. Date Frwd. _____. ACTION: Approved ☐ Disapproved ☐ Signature: Diane Reese
3. City or County Engineer: Date Rec'd. 10-27-78 Date Frwd. 10-27-78. ACTION: Approved ☒ Disapproved ☐ Signature: Henry Graff

REMARKS OR REASONS FOR DISAPPROVAL _____

Site Visits:
Date: 11/3/78 by: J. C. H.
Date: _____ by: _____
Date: _____ by: _____

INSTALLATION FINAL WRITTEN APPROVAL
Date: 11/3/78 By: Jerrold C. Hood

White: Health Dept. Copy
Yellow: Engineers Copy
Pink: Bldg. Inspector's Copy

FORM 20105-0477
SOIL ABSORPTION TEST DATA REPORT
(Annex to Application)
(Reference: City Ordinance No. 9150 and County Resolution No. 2832)

LINCOLN-LANCASTER COUNTY HEALTH DEPARTMENT
Division of Environmental Health
2200 St. Marys Avenue
Lincoln, Nebraska 68502
Phone: 474-1541

B

FILE NO. 1445-C

PROPERTY WHERE SOIL TESTED:

Location: Township 12 ; Range 7 ; Section & ¼ Section 11 .
Property Dimensions: NE/4 ft. x ft. Area: 160 acres. (Attach Sheet C with sketch of property).
Soil Type: Silty Clay ☐ ; Silty Clay Loam ☒ ; Sandy Loam ☐ ; Silt Loam ☐ ; Clay Loam ☐ .
Dates of Tests: 10-24-78 to 10-25-78 . Weather: Precip. NONE Temp. APPROX. 50° .

OWNER: Paul Nordstrom
RFD 130x165
Address: Waverly, Nebr. 68462

PERCOLATION TEST DATA TABLE

a.	b.	c.	d.	e.	f.	g.	h.	i.	j.	k.	l.	m.	n.
		Pre-Saturation Period				Percolation Readings						Results	
		Start		End		Start			End				
Hold No.	Hole Depth (in.)	Date (Mo./ Day)	Time (Hr./ Min.)	Date (Mo./ Day)	Time (Hr./ Min.)	Date (Mo./ Day)	Time (Hr./ Min.)	Water Level (in.)	Time (Hr./ Day)	Water Level (in.)	Elapsed Time (Min.)	Water Level Drop (in.)	Percolation Rates (Min./in.)
1	36	10/24	2:15	10/24	6:15	10/25	8:30PM	6"	9:00PM	5¾"	30 min	¼"	
2	"	"	"	"	"	"	"	6"	"	6"	"	0	
3	"	"	"	"	"	"	"	6"	"	4½"	"	1½"	
4	"	"	"	"	"	"	"	6"	"	3"	"	2"	
5	"	"	"	"	"	"	"	6"	"	6"	"	0	
6	"	"	"	"	"	"	"	6"	"	3"	"	2"	
7	"	"	"	"	"	"	"	6"	"	6"	"	0	

Sum of Percolation Rates: _____
Average of Rates: _____
Mean of Rates: _____

Paul Nordstrom
Signature of Person Conducting Test

Address Waverly, Nebr. 68462 Phone 785-2272

(Do not write below this line)

REVIEWING ACTION

Remarks: _____
Soil Type (SCS): Sharpsburg Silty Clay Loam
Date: October 26, 1978

Approved Percolation Rate (a)
A. 37 min./inch
B. _____ min./inch
C. _____ min./inch

Jerrold C. Head
Signature of Reviewing Official

FORM 20102-0477
PRELIMINARY PLANS & SPECIFICATIONS FOR SEWAGE DISPOSAL SYSTEM (Annex to Application)
City Ordinance No. 9150 ☐
County Resolution No. 2832 ☐


LINCOLN-LANCASTER COUNTY HEALTH DEPARTMENT
Division of Environmental Health
2200 St. Marys Avenue
Lincoln, Nebraska 68502
Phone: 474-1541

C

Sketch of property showing Percolation Test hole locations, well, residence, direction and property line.

FILE NO. 1445-C

Indicate on sketch if residence and well are exisiting or proposed.

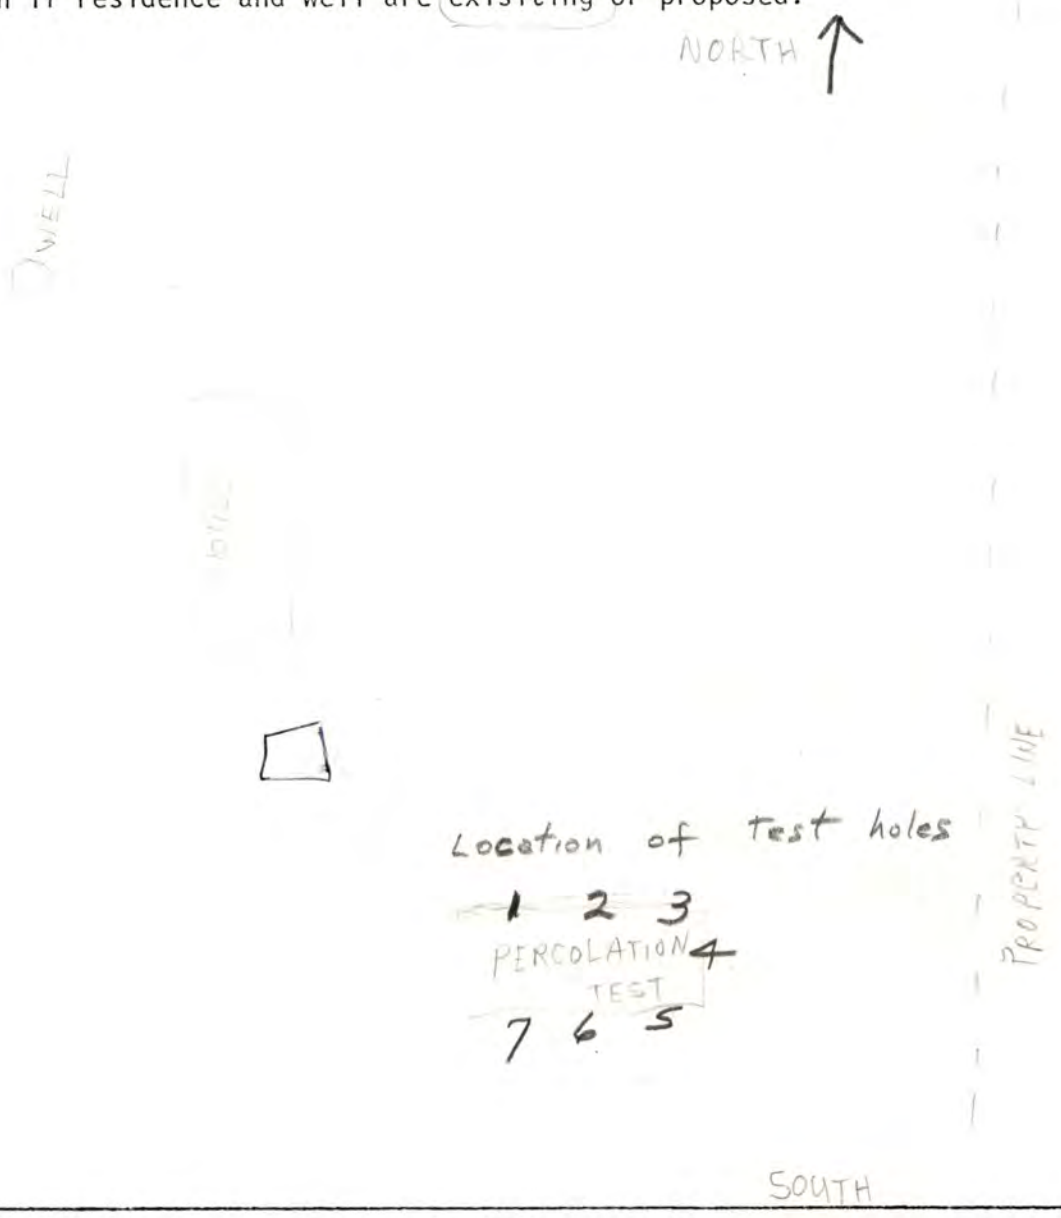

REVIEWING ACTION

Remarks: _____

Date: October 26, 1978

Minimum Design Requirement
1. Capacity of Septic Tank 1000 gals.
2. Total Length of Laterals _____ ft.
3. With a Trench Width of _____ in.
4. Total Area of Lateral needed 555 sq.ft.

Gerrald C. Hood
Signature of Reviewing Official

FORM 20104-0477
PLANS & SPECIFICATIONS FOR SEWAGE DISPOSAL SYSTEM (Annex to Application)
City Ordinance No. 9150 ☐
County Resolution No. 2832 ☐

LINCOLN-LANCASTER COUNTY HEALTH DEPARTMENT
Division of Environmental Health
2200 St. Marys Avenue
Lincoln, Nebraska 68502
Phone: 474-1541

D

DATE: 3 Nov. 1978

FILE NO. _____


SPECIFICATIONS AS BUILT

A. BUILDING SEWER: Mobil Home
1. Material PVC; Diameter 4 in.
2. Distance above basement floor _____ in., or below basement floor ____ in.
3. Distance between dwelling and septic tank 36 ft.
4. Number of clean-outs 1.
5. Distances to:
Well or ~~Suction~~ Line 160 ft.; Stream — ft.; Pressure Line _____ ft.; Property Line 102 ft.

B. SEPTIC TANK:
1. Material Concrete; No. of compartments 1.
2. Capacity 1000 gals.;
3. Factory Built: Yes ☒ No ☐
(Company Pre-cast Step Co., Inc.)
4. Manholes: Over Inlet; diam. 8 in.
Over Outlet; diam. 12 in.
None Riser Above ☐ Below ☐ Grade ____ in.
5. Inlet: Baffle ☒ ; or Tee ☐
6. Outlet: Baffle ☒ ; or Tee ☐
7. Depth of top of tank below finished grade 12 in.
8. Distances to:
Well or Suction Line 160 ft.; Stream — ft.; Pressure Line 60 ft.; Property Line 102 ft.

C. DISTRIBUTION BOX:
1. Material Concrete; Number - available outlets 6.
2. Factory Built: Yes ☒ No ☐
(Company Pre-cast Step Co., Inc)
3. Distance from Septic Tank 45 ft.


D. ABSORPTION FIELD: (Provide as built drawings on back of this form)
1. Type: Half Rounds ☐ Perforated Pipe ☒
Diameter of Half Round — or Perforated Pipe 4" .
Material: fiberglass ☐ ; plastic ☒ ; concrete ☐ ; other PVC.
2. Lateral Lines:
Number 2 ; Length of each line 100, _____, _____, _____, _____ ft.;
Total length of laterals 200 ft.;
Distance between lateral lines 20 ft.
3. Trench dimensions: Width 3 ft.;
Slope 6 in/100 ft.; Average Depth 28 in.
4. Filter Material: Road Gravel
Depth of Material 12 in.
5. Distances to:
Well or Suction Line 205 ft.; Stream — ft.; Pressure Line — ft.; Property Line 31-20 ft.

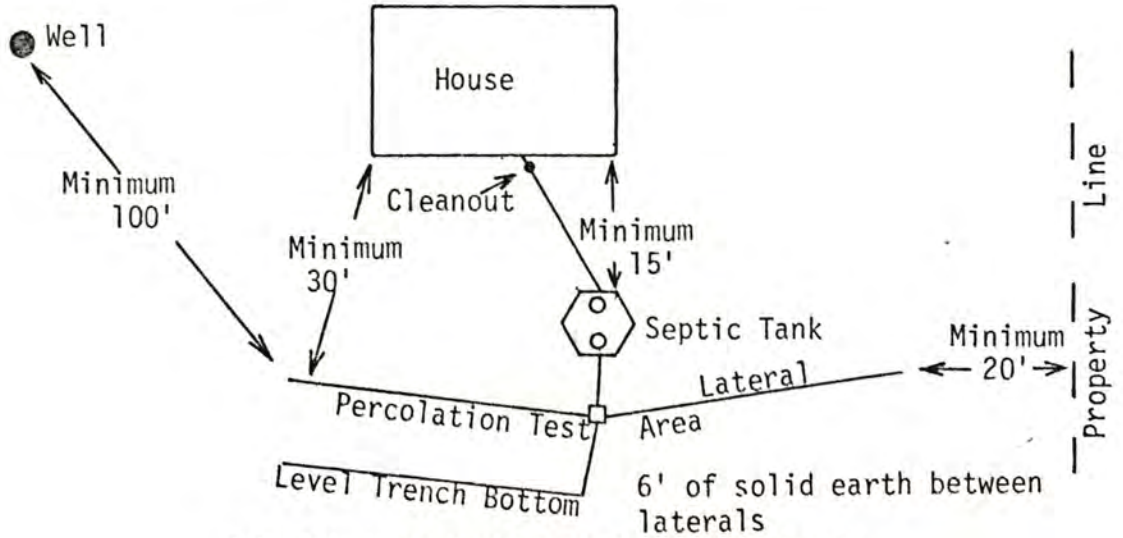

TYPICAL INDIVIDUAL SEWAGE SYSTEM DESIGN

AS BUILT DRAWING OF SYSTEM

DATE 3 Nov. 1978 INSTALLERS Bob, Tony + Paul

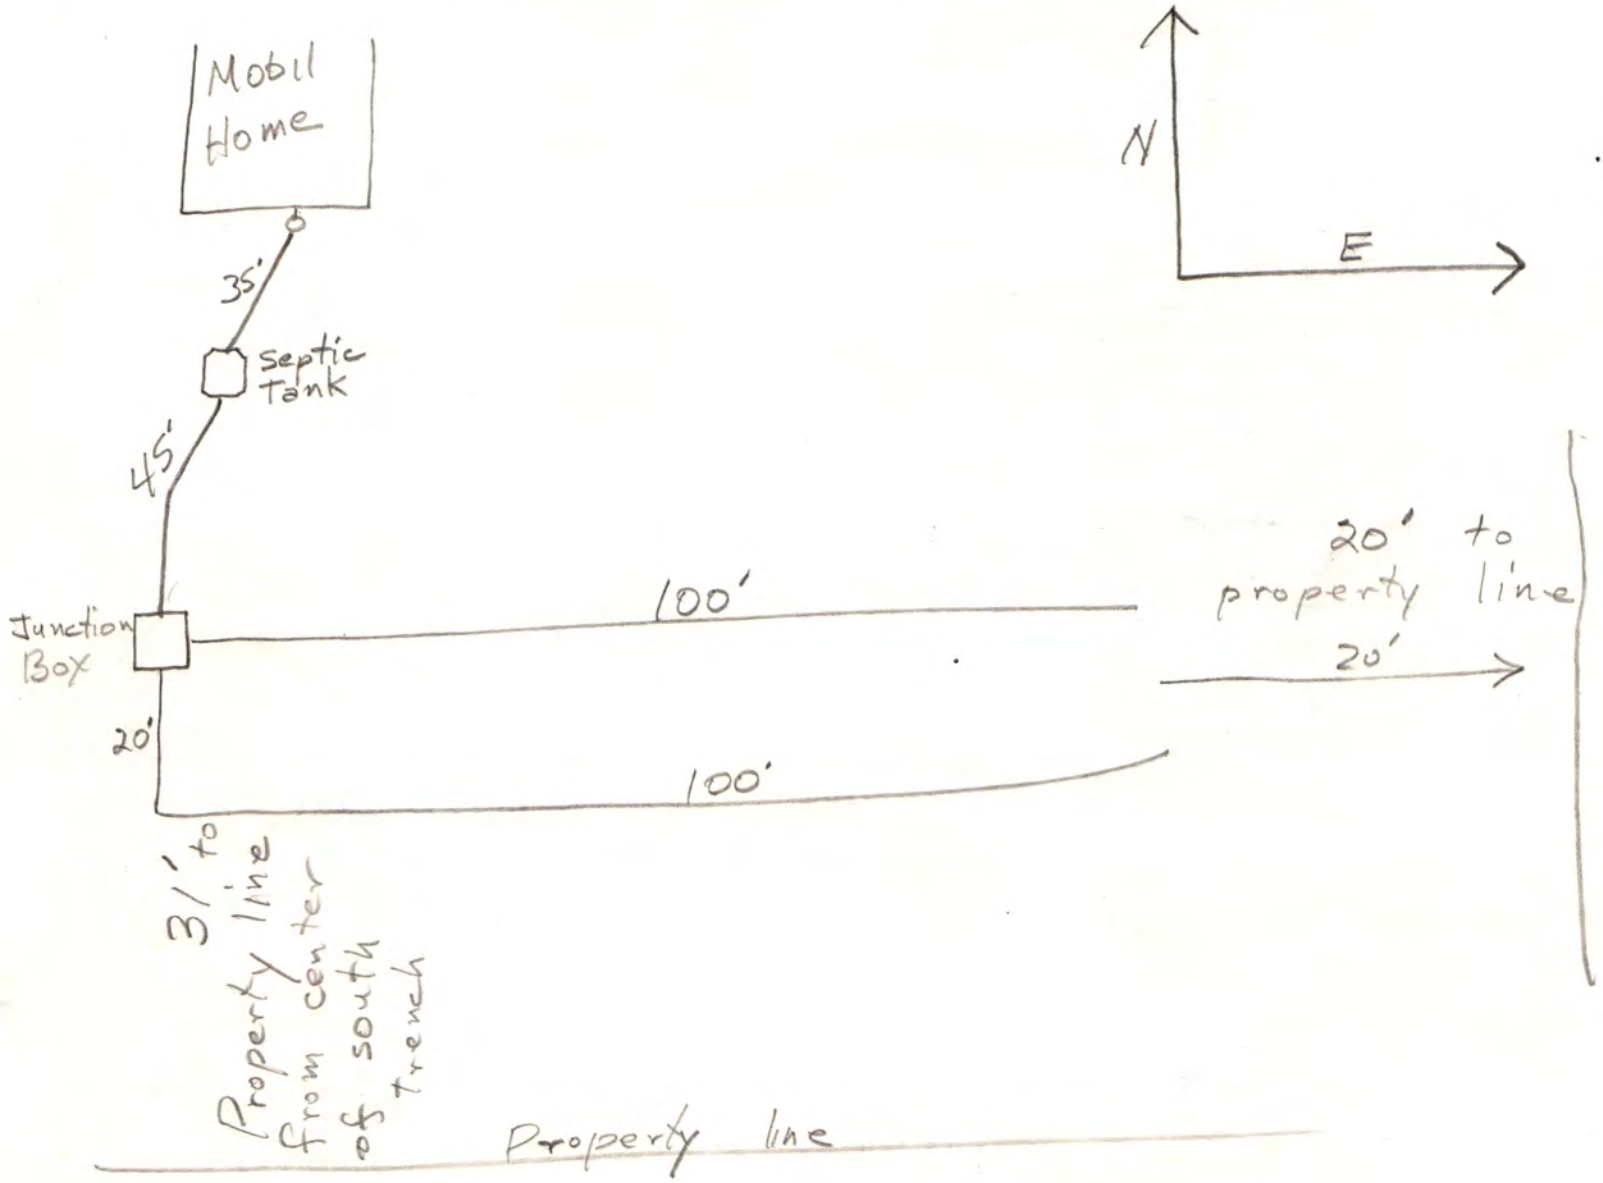

NEBRASKA — SHEET NUMBER 4

