Lincoln-Lancaster County Health Department

ENVIRONMENTAL HEALTH DIVISION

3140 N STREET · LINCOLN, NE 68510-1514 (402) 441-8000

Permit

SEWAGE INSTALLATION
LAGOON

Establishment

RANDALL GETTMAN
T9N R8E SEC 24 QTR NE
E 1/2 OF NE 1/4 LOT 31IT

Permittee

RANDALL GETTMAN
5500 THISTLE CIR
LINCOLN NE 68516

Permit # 01380236601

Issued 09/14/01
Expires 03/14/02
Revenue Code 3157

FEES: $200.00

TOTAL: $200.00

Bruce D. Dart

Bruce D. Dart, Health Director

• POST IN A PROMINENT PLACE • NOT TRANSFERABLE

000123

Lincoln-Lancaster County Health Department
Environmental Health Division
3140 "N" Street • Lincoln, NE 68510-1514
Phone: 402-441-8022

A

Permit Number:

Sewage Disposal System

Request for Site Clearance and Permit

Include Form B, Form C and Applicable Fees with this Application.

☐ Septic System ☒ Lagoon ☐ Other (Refer to Form C)

The undersigned hereby requests site clearance and permit to construct a Sewage Disposal System in conformance with appropriate resolution or ordinance, as described herein:

PLEASE PRINT OR TYPE

A. System Location (Indicate correct number and street)

Address _____ City _____ NE, Zip _____
(no rural route)

Legal Description E½ of NE/4 25 9N 6E 3 I.T.
1/4 1/4 Section Township Range Subdivision Addition Block Lot

Geographical Location (if known): Longitude _____ Latitude _____

☐ Check if system mail address is not the same as the owner's address

B. Owner

Name Randall Gettman Signature _____

Address 5500 Thistle City/State/Zip Lincoln, Ne 68516

☐ Check if owner designed system Home Phone 423-6864 Work Phone _____

C. Contractor

Name Brad Southwick Company Name Southwick Sewer & Drain

Address 17201 So 72nd st. City/State/Zip Hickman Ne 68372

☒ Check if contractor designed system Work Phone 430-7606

D. Engineer/Installer ☐ Check and complete if engineer designed system

Designer Name _____ Firm _____ Work Phone _____

E. This System Will Serve a

☒ Residential Dwelling Number of Bedrooms 2 Is there a Whirlpool Bathtub YES NO

☐ Commercial Establishment/Other Facility Specify _____

Design flow in gallons per day _____ Type of Wastewater: ☐ Domestic ☐ Non-Domestic.

DO NOT WRITE BELOW THIS LINE

Approval Process ☐ Municipal Code 24.38 ☒ County Resolution No. 2832

1. **Health Department** Date rec'd 9/14/01 Date frwd 9/14/01 **ACTION** ☒ Approved ☐ Disapproved Signature Jerrold C. Hood

2. **Supt. Bldg. Insp. or Village Clerk** Date rec'd N/A Date frwd N/A **ACTION** ☐ Approved ☐ Disapproved Signature _____

3. **City or County Engineer** Date rec'd 9/14/01 Date frwd 9/14/01 **ACTION** ☒ Approved ☐ Disapproved Signature _____

9/14/01 Need ~~drawing~~, fence, signs, ~~heating etc.~~ E.H.

Installation Final Written Approval

By Jerrold C. Hood R.E.H.S.

Date APRIL 15, 2002

Business Office Use Only

Date Rec'd 09/14/01

Amt Paid 200.00

Rec'd By _____ ~~Cash~~/Check No. 4420

FORM 23-100 10-96 White - Health Dept. Yellow - Engineer Pink - Bldg. Inspector

Lincoln-Lancaster County Health Department
Environmental Health Division
3140 "N" Street • Lincoln, NE 68510-1514
Phone: 402-441-8022


C

Permit Number:

Sewage Disposal System

Preliminary Plan Specifications

Draw a plot plan showing system location, lines, distribution box, tank and laterals, percolation test hole locations, well, residence, compass direction and property lines. Indicate on drawing if residence and well are existing or proposed.

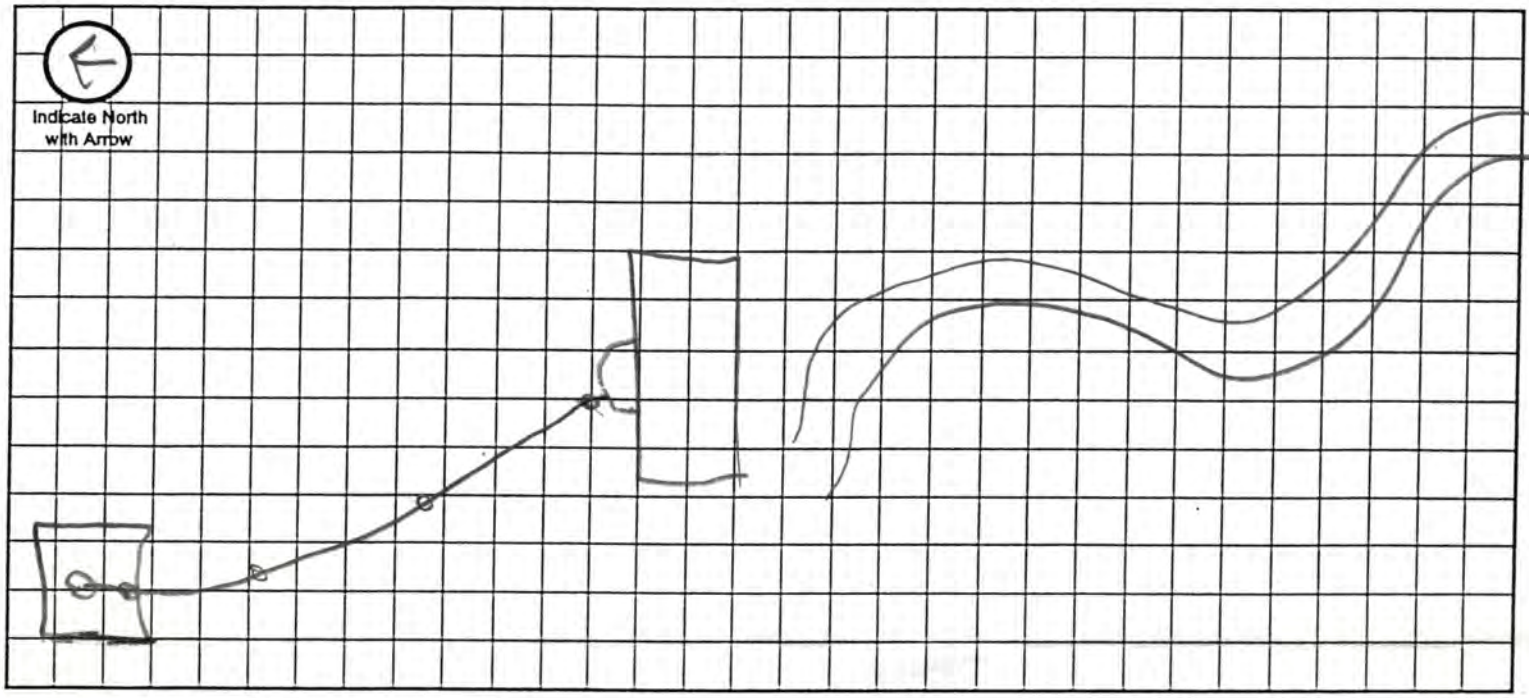

Approximate Scale: _____ ft. = _____ grid line/s

A. System Location (Indicate correct number and street)

Address (no rural route) Midway Rd City Bennet NE, Zip 68317

B. Proposed Septic Tank/s

Tank Material: ☐ Concrete ☐ Plastic ☐ Other _____

C. Proposed Absorption System (See Form B for Percolation Information)

Percolation Rate _____ (min. per inch) Soil Type: _____ Land Slope: _____ %

Type of Absorption System: ☐ Trench ☐ Bed ☐ Other _____

Total Square Feet of Field Required: _____ sq. ft.

Type of Lateral: ☐ Half-Moon ☐ Perforated Pipe ☐ Other Lateral Material: _____

Capacity of Septic Tank _____ gals Number of Absorption Beds: _____ Number of Distribution Laterals per Bed _____

Total Length of Laterals _____ ft. Number of Trenches _____ Trench Width _____

D. Setbacks Check the Boxes Below if the Required Setback has been Satisfied

Distance From	Private Well	Public Well	Surface Water	Gound Water	Pressure Water Lines	Property Lines	Foundations Yours	Foundations Neighbors	All Other Setbacks
Tank (ft)	50 ☐	500 ☐	50 ☐	NA ☐	25 ☐	20 ☐	15 ☐	25 ☐	☐
Field (ft)	100 ☐	500 ☐	50 ☐	4 ☐	30 ☐	20 ☐	30 ☐	40 ☐	☐
Lagoon (ft)	100 ☒	500 ☒	50 ☒	N/A ☐	30 ☒	50 ☒	100 ☒	200 ☒	☒

E. Required Signatures

Home Building Contractor _____ Date _____

Installer Brad Smith Date 9-14-01

Schultz

D

Lincoln-Lancaster County Health Department
Environmental Health Division
3140 "N" Street • Lincoln, NE 68510-1514
Phone: 402-441-8022

Permit Number:

Sewage Disposal System

As Built Plans & Specifications

Date 9-15-01 Randall Gettman

System Location (Indicate correct number and street)

Address Midway Rd. (no rural route) City Bennet NE, Zip 68317

A. Building Sewer

1. Material: PVC Sch 40
   Diameter: 4 in.
2. Distance above basement floor: _____ in.
   or distance below basement floor: 60 in.
3. Distance between dwelling and ~~septic tank~~ Lagoon: 400 ft.
4. Number of clean-outs: 6
5. Distances to: well or suction line NA ft.
   stream NA ft.
   pressure line > 30 ft.
   property line > 50 ft.

B. Septic Tank

1. Material: _____
   Number of compartments: _____
2. Capacity: _____ gal.
3. Factory built: ☐ Yes ☐ No
4. Manholes: Over inlet, diameter _____ in.
   Over outlet, diameter _____ in.
   Riser: ☐ above ☐ below grade _____ in.
5. Inlet: ☐ baffle ☐ tee
6. Outlet: ☐ baffle ☐ tee
7. Depth to top of tank, below unfinished grade: _____ in.
8. Distances to: Well or suction line _____ ft.
   Stream _____ ft.
   Pressure line _____ ft.
   Property line _____ ft.

C. Distribution Box

1. Material: _____
   Number available outlets: _____
2. Factory built: ☐ Yes ☐ No
3. Distance from septic tank: _____ ft.

D. Absorption Field


(Provide as-built drawings on back of this form)

1. Type: ☐ Half rounds ☐ Perforated pipe
   Diameter of half round: _____
   or perforated pipe: _____
   Material: ☐ fiberglass ☐ plastic ☐ concrete
   ☐ other _____
2. Lateral lines: Number _____
   Length of each line: _____ ft. _____ ft.
   _____ ft. _____ ft., _____ ft.
3. Trench dimensions: Width _____ ft.
   Slope _____ in/100 ft.
   Average depth _____ in
4. Filter material: _____
   Depth of material _____ in.
5. Distances to: Well or suction line _____ ft.
   Stream _____ ft.
   Pressure line _____ ft.
   Property line _____ ft.

Indicate North with Arrow


Complete "As Built" drawing on back of this form.

Individual Sewage System Design (Example)

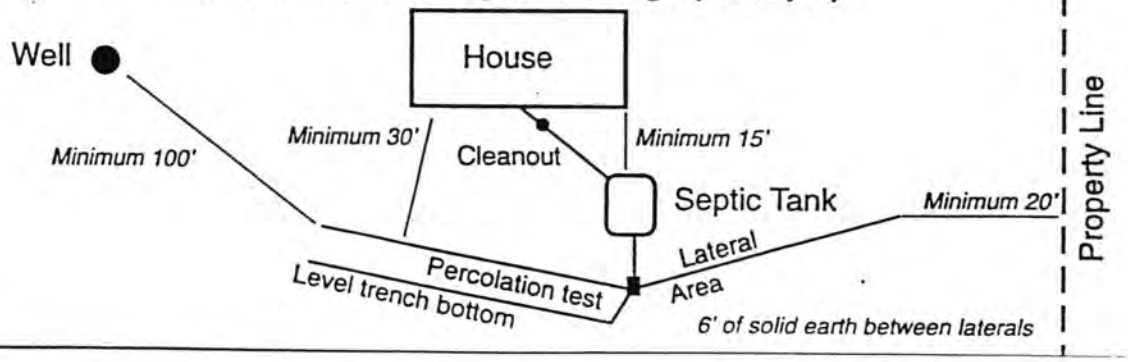

FORM 23-103 10-96

As Built Drawing

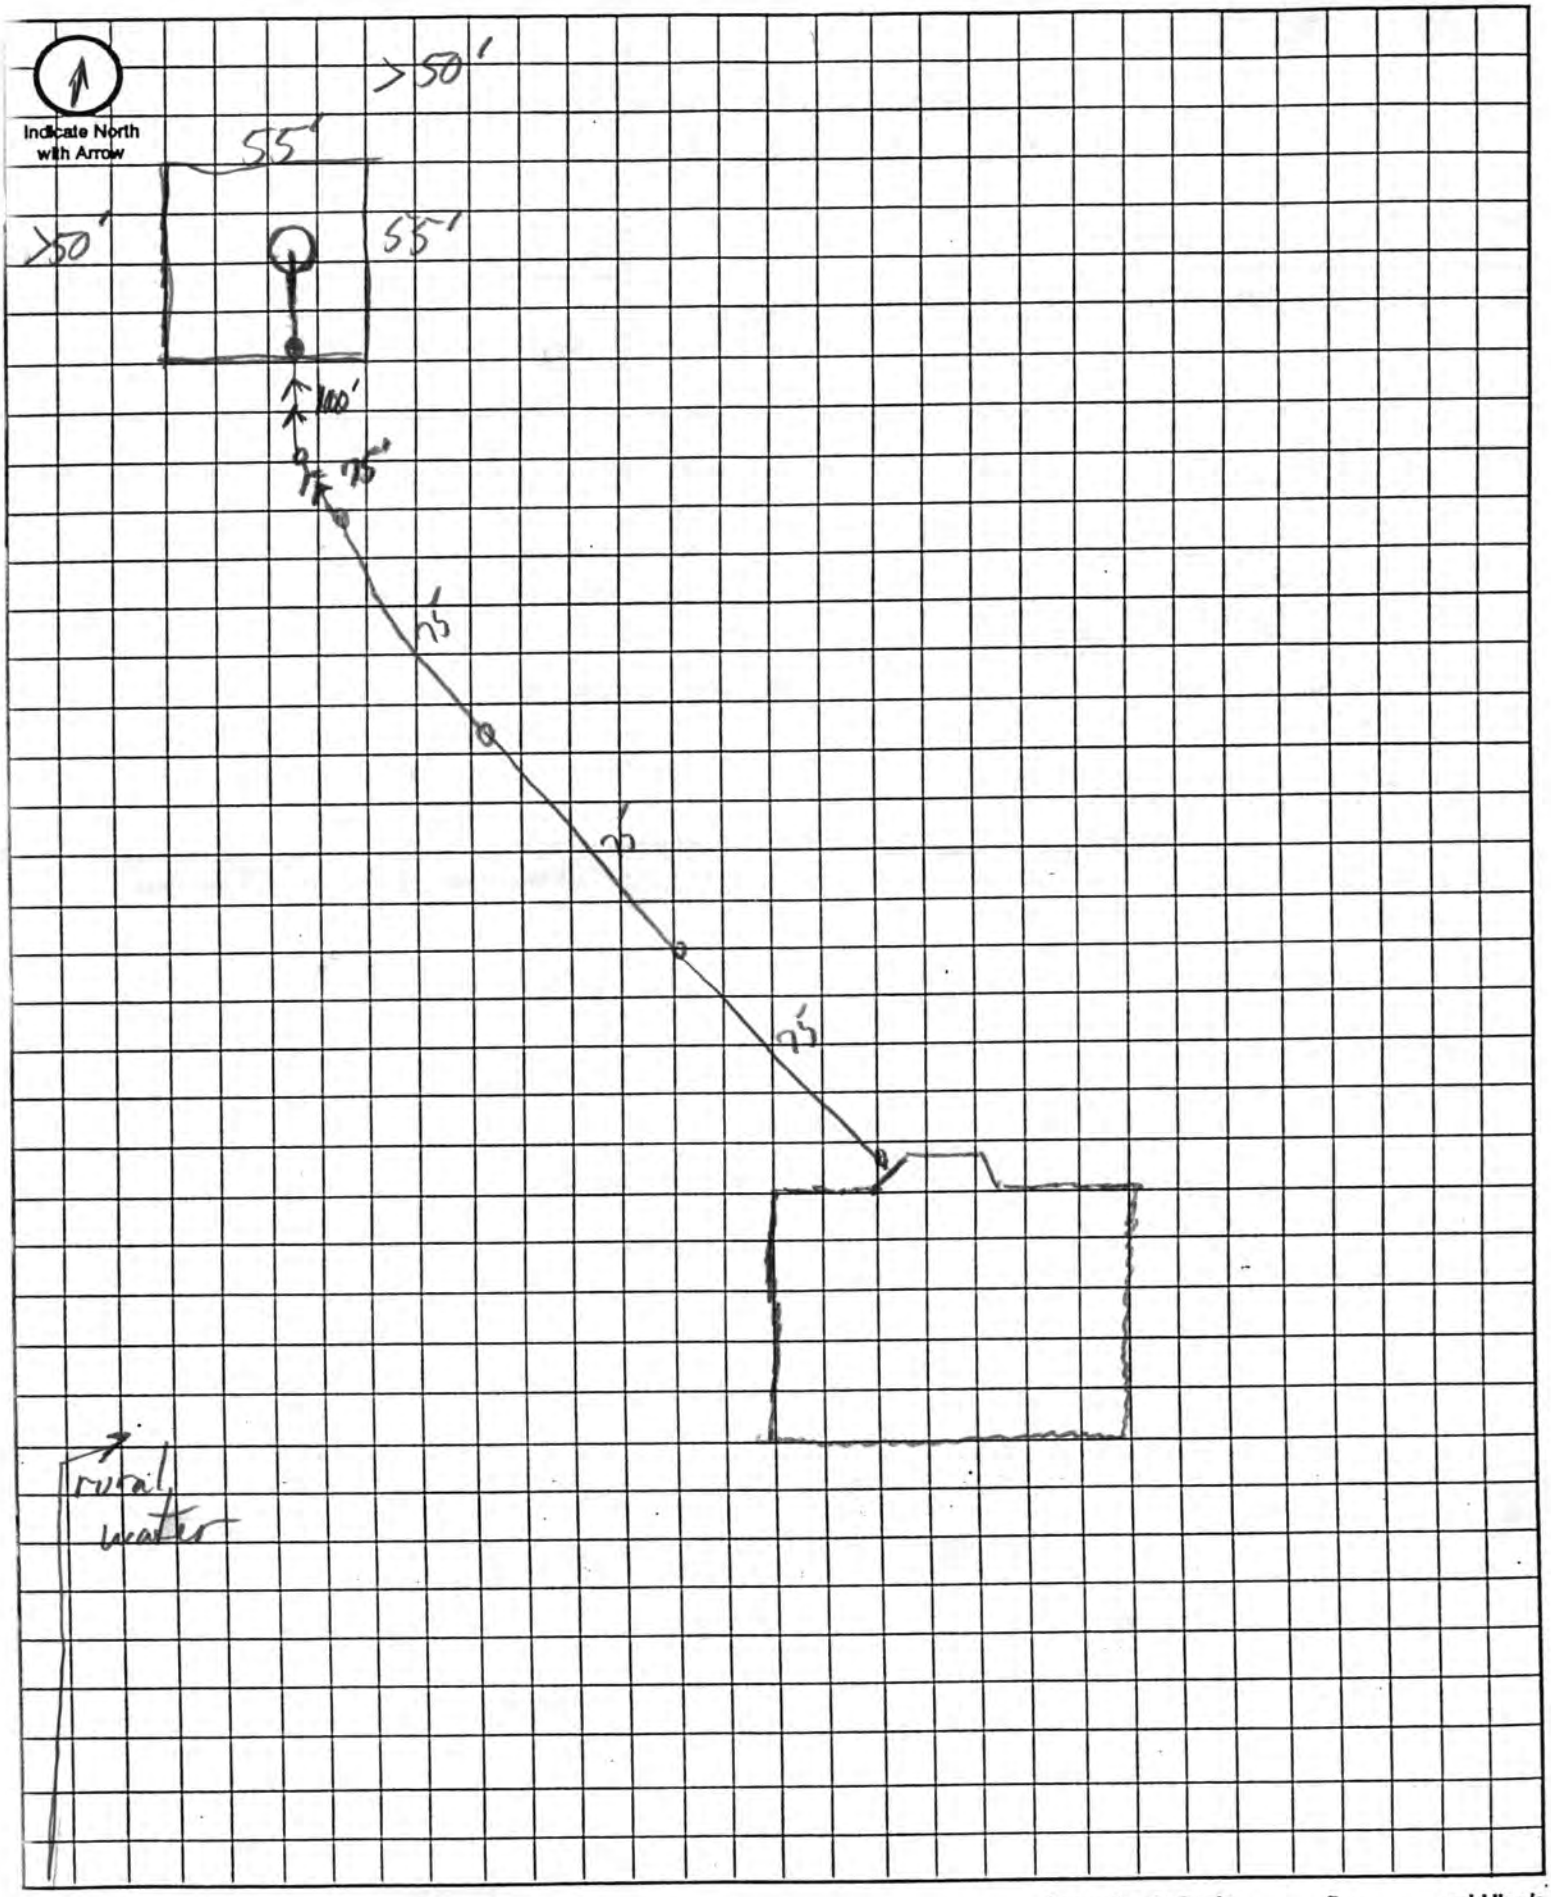

Approximate Scale: _____ ft. = _____ grid line/s