Lincoln-Lancaster County Health Department

ENVIRONMENTAL PUBLIC HEALTH DIVISION

3140 N STREET · LINCOLN, NE 68510-1514

(402) 441-8000

003772

Permit SEWAGE INSTALLATION
LAGOON

Permit # 04380280901

Issued 04/08/04
Expires 10/08/04
Revenue Code 3157

Establishment SCOTT JURGENS
T9N R8E SEC 32
LOT 40IT
11200 S 120 ST-BENNET

FEES: $200.00

Permittee SCOTT JURGENS
11200 S 120 ST
BENNET NE 68317

TOTAL: $200.00

Bruce D. Dart

Bruce D. Dart, Health Director

EPH COPY

Lincoln-Lancaster County Health Department
Environmental Health Division
3140 "N" Street • Lincoln, NE 68510-1514
Phone: 402-441-8022

A

Permit Number: 04380280901

Sewage Disposal System

Request for Site Clearance and Permit

Include Form B, Form C and Applicable Fees with this Application.

RECEIVED APR 08 2004

CHANGE TO →

☐ Septic System ☒ Lagoon ☐ Other (Refer to Form C)

The undersigned hereby requests site clearance and permit to construct a Sewage Disposal System in conformance with appropriate resolution or ordinance, as described herein:

PLEASE PRINT OR TYPE

A. System Location (Indicate correct number and street)

Address 11200 S 120th (no rural route) City Bennet NE, Zip 68317

Legal Description 32 9N 8E HOI.T
1/4 1/4 Section Township Range Subdivision Addition Block Lot

Geographical Location (if known): Longitude _____ Latitude _____

☐ Check if system mail address is not the same as the owner's address

B. Owner

Name Scott Jurgens Signature _____

Address 11200 S. 120 City/State/Zip Bennet, Ne 68317

☐ Check if owner designed system Home Phone _____ Work Phone _____

C. Contractor

Name Brad Southwick Company Name Southwick Sewer + Drain

Address 17201 S. 72nd St City/State/Zip Hickman, Ne 68372

☒ Check if contractor designed system Work Phone 430-7606

D. Engineer/Installer ☐ Check and complete if engineer designed system

Designer Name _____ Firm _____ Work Phone _____

E. This System Will Serve a

☒ Residential Dwelling Number of Bedrooms 3 Is there a Whirlpool Bathtub YES (NO)

☐ Commercial Establishment/Other Facility Specify _____

Design flow in gallons per day _____ Type of Wastewater: ☐ Domestic ☐ Non-Domestic.

DO NOT WRITE BELOW THIS LINE

Approval Process ☐ Municipal Code 24.38 ☐ County Resolution No. 2832

1. **Health Department** Date rec'd 4/8/04 Date frwd 4/9/04 ACTION ☒ Approved ☐ Disapproved Signature Jerrold C. Hood
   * as per owner, meets setback requirements,
2. **Supt. Bldg. Insp. or Village Clerk** Date rec'd _____ Date frwd _____ ACTION ☐ Approved ☐ Disapproved Signature _____
3. **City or County Engineer** Date rec'd _____ Date frwd _____ ACTION ☐ Approved ☐ Disapproved Signature _____

4/8/04 TOO CLOSE TO PROPERTY LINE J.CH
3/19/07 - 40 ft from Prop Line

Installation Final Written Approval

By _____

Date 3/19/07

Business Office Use Only
Date Rec'd 04/08/04
Amt Paid 200.00
Rec'd By LO ~~Cash~~/Check No. 1011

FORM 23-100 10-96 White - Health Dept. Yellow - Engineer Pink - Bldg. Inspector


Lincoln-Lancaster County Health Department
Environmental Health Division
3140 "N" Street • Lincoln, NE 68510-1514
Phone: 402-441-8022

C

Permit Number: 04380280 9

Sewage Disposal System
Preliminary Plan Specifications

raw a plot plan showing system location, lines, distribution box, tank and laterals, percolation test hole locations, well, residence, ompass direction and property lines. Indicate on drawing if residence and well are existing or proposed.

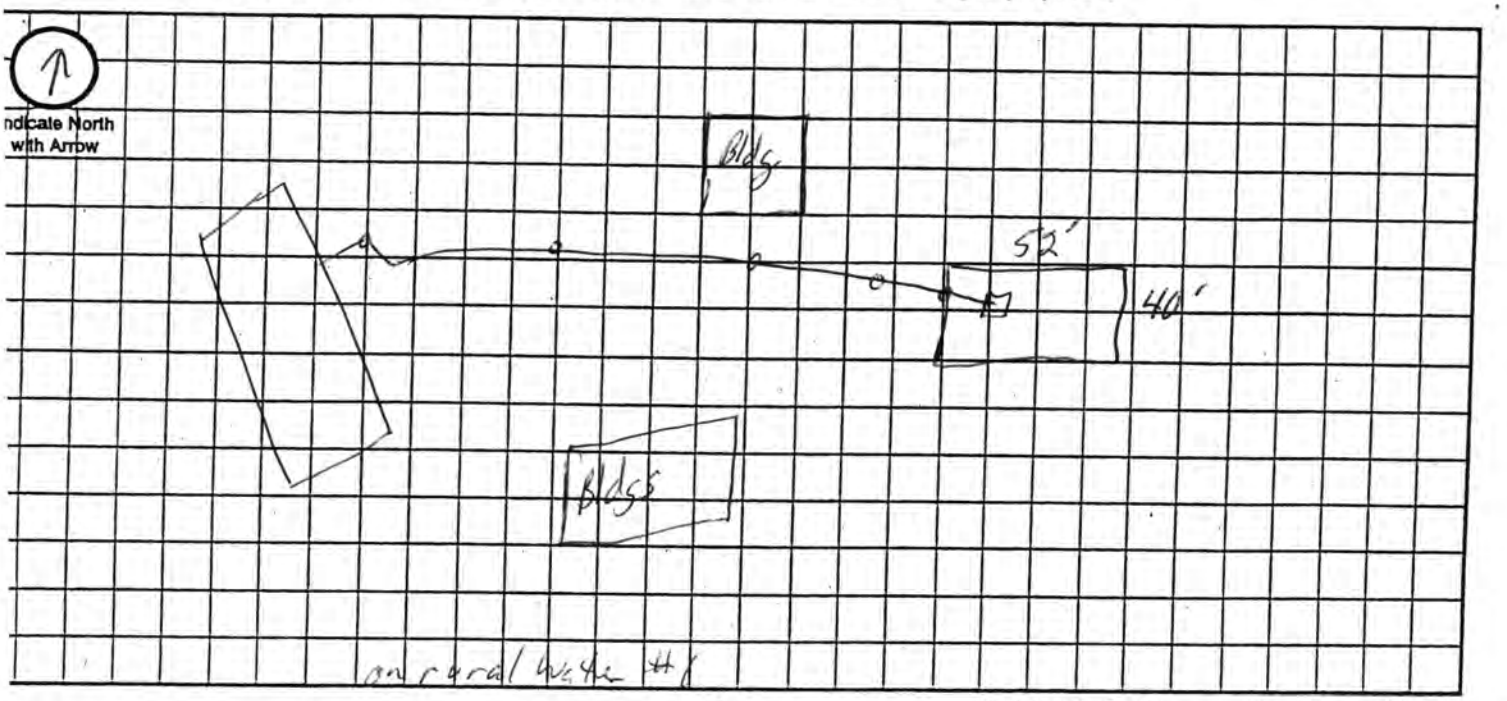

Approximate Scale: _____ ft. = _____ grid line/s

. System Location (Indicate correct number and street)

ldress (no rural route) 11200 S. 120 City Bennet NE, Zip 68372

. Proposed Septic Tank/s

nk Material: ☐ Concrete ☐ Plastic ☐ Other _____

. Proposed Absorption System (See Form B for Percolation Information)

rcolation Rate _____ (min. per inch) Soil Type: _____ Land Slope: _____ %

pe of Absorption System: ☐ Trench ☐ Bed ☐ Other _____

al Square Feet of Field Required: _____ sq. ft.

pe of Lateral: ☐ Half-Moon ☐ Perforated Pipe ☐ Other Lateral Material: _____

pacity of Septic Tank _____ gals Number of Absorption Beds: _____ Number of Distribution Laterals per Bed _____

al Length of Laterals _____ ft. Number of Trenches _____ Trench Width _____

Setbacks Check the Boxes Below if the Required Setback has been Satisfied

istance From	Private Well	Public Well	Surface Water	Gound Water	Pressure Water Lines	Property Lines	Foundations Yours	Foundations Neighbors	All Other Setbacks
ank (ft)	50 ☐	500 ☐	50 ☐	NA ☐	25 ☐	20 ☐	15 ☐	25 ☐	☐
eld (ft)	100 ☐	500 ☐	50 ☐	4 ☐	30 ☐	20 ☐	30 ☐	40 ☐	☐
poon (ft)	100 ☒	500 ☒	50 ☒	N/A ☐	30 ☒	50 ☒	100 ☒	200 ☒	☒

Required Signatures

ie Building Contractor _____ Date _____

aller _____ Date 4-7-04

23-102 10-95

Lincoln-Lancaster County Health Department
Environmental Health Division
3140 "N" Street • Lincoln, NE 68510-1514
Phone: 402-441-8022

D

Permit Number:

Sewage Disposal System

As Built Plans & Specifications

Date 4-15-04

T9 R8 Sec 32

Scott Jurgens

System Location (Indicate correct number and street)

Address 11200 S 120th (no rural route) City Bennet NE, Zip 68317

A. Building Sewer

1. Material: PVC Sch 40
   Diameter: 4 in.
2. Distance above basement floor: _____ in.
   or distance below basement floor: 15 in.
3. Distance between dwelling and ~~septic tank~~ Lagoon: 340 ft.
4. Number of clean-outs: 6
5. Distances to: well or suction line _____ ft.
   stream _____ ft.
   pressure line _____ ft.
   property line _____ ft.

B. Septic Tank

1. Material: _____
   Number of compartments: _____
2. Capacity: _____ gal.
3. Factory built: ☐ Yes ☐ No
4. Manholes: Over inlet, diameter _____ in.
   Over outlet, diameter _____ in.
   Riser: ☐ above ☐ below grade _____ in.
5. Inlet: ☐ baffle ☐ tee
6. Outlet: ☐ baffle ☐ tee
7. Depth to top of tank, below unfinished grade: _____ in.
8. Distances to: Well or suction line _____ ft.
   Stream _____ ft.
   Pressure line _____ ft.
   Property line _____ ft.

C. Distribution Box

1. Material: _____
   Number available outlets: _____
2. Factory built: ☐ Yes ☐ No
3. Distance from septic tank: _____ ft.

D. Absorption Field


(Provide as-built drawings on back of this form)

1. Type: ☐ Half rounds ☐ Perforated pipe
   Diameter of half round: _____
   or perforated pipe: _____
   Material: ☐ fiberglass ☐ plastic ☐ concrete
   ☐ other _____
2. Lateral lines: Number _____
   Length of each line: _____ ft. _____ ft.
   _____ ft. _____ ft., _____ ft.
3. Trench dimensions: Width _____ ft.
   Slope _____ in/100 ft.
   Average depth _____ in
4. Filter material: _____
   Depth of material _____ in.
5. Distances to: Well or suction line _____ ft.
   Stream _____ ft.
   Pressure line _____ ft.
   Property line _____ ft.

Complete "As Built" drawing on back of this form.


Indicate North with Arrow

Individual Sewage System Design (Example)

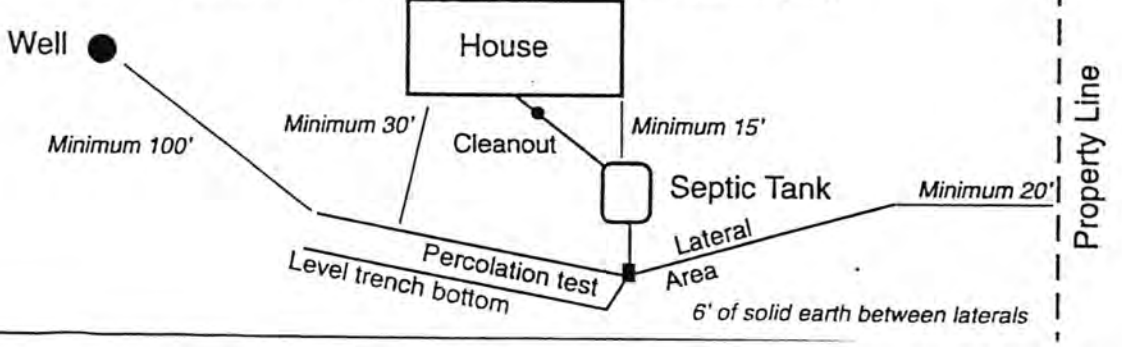

FORM 23-103 10-96

As Built Drawing

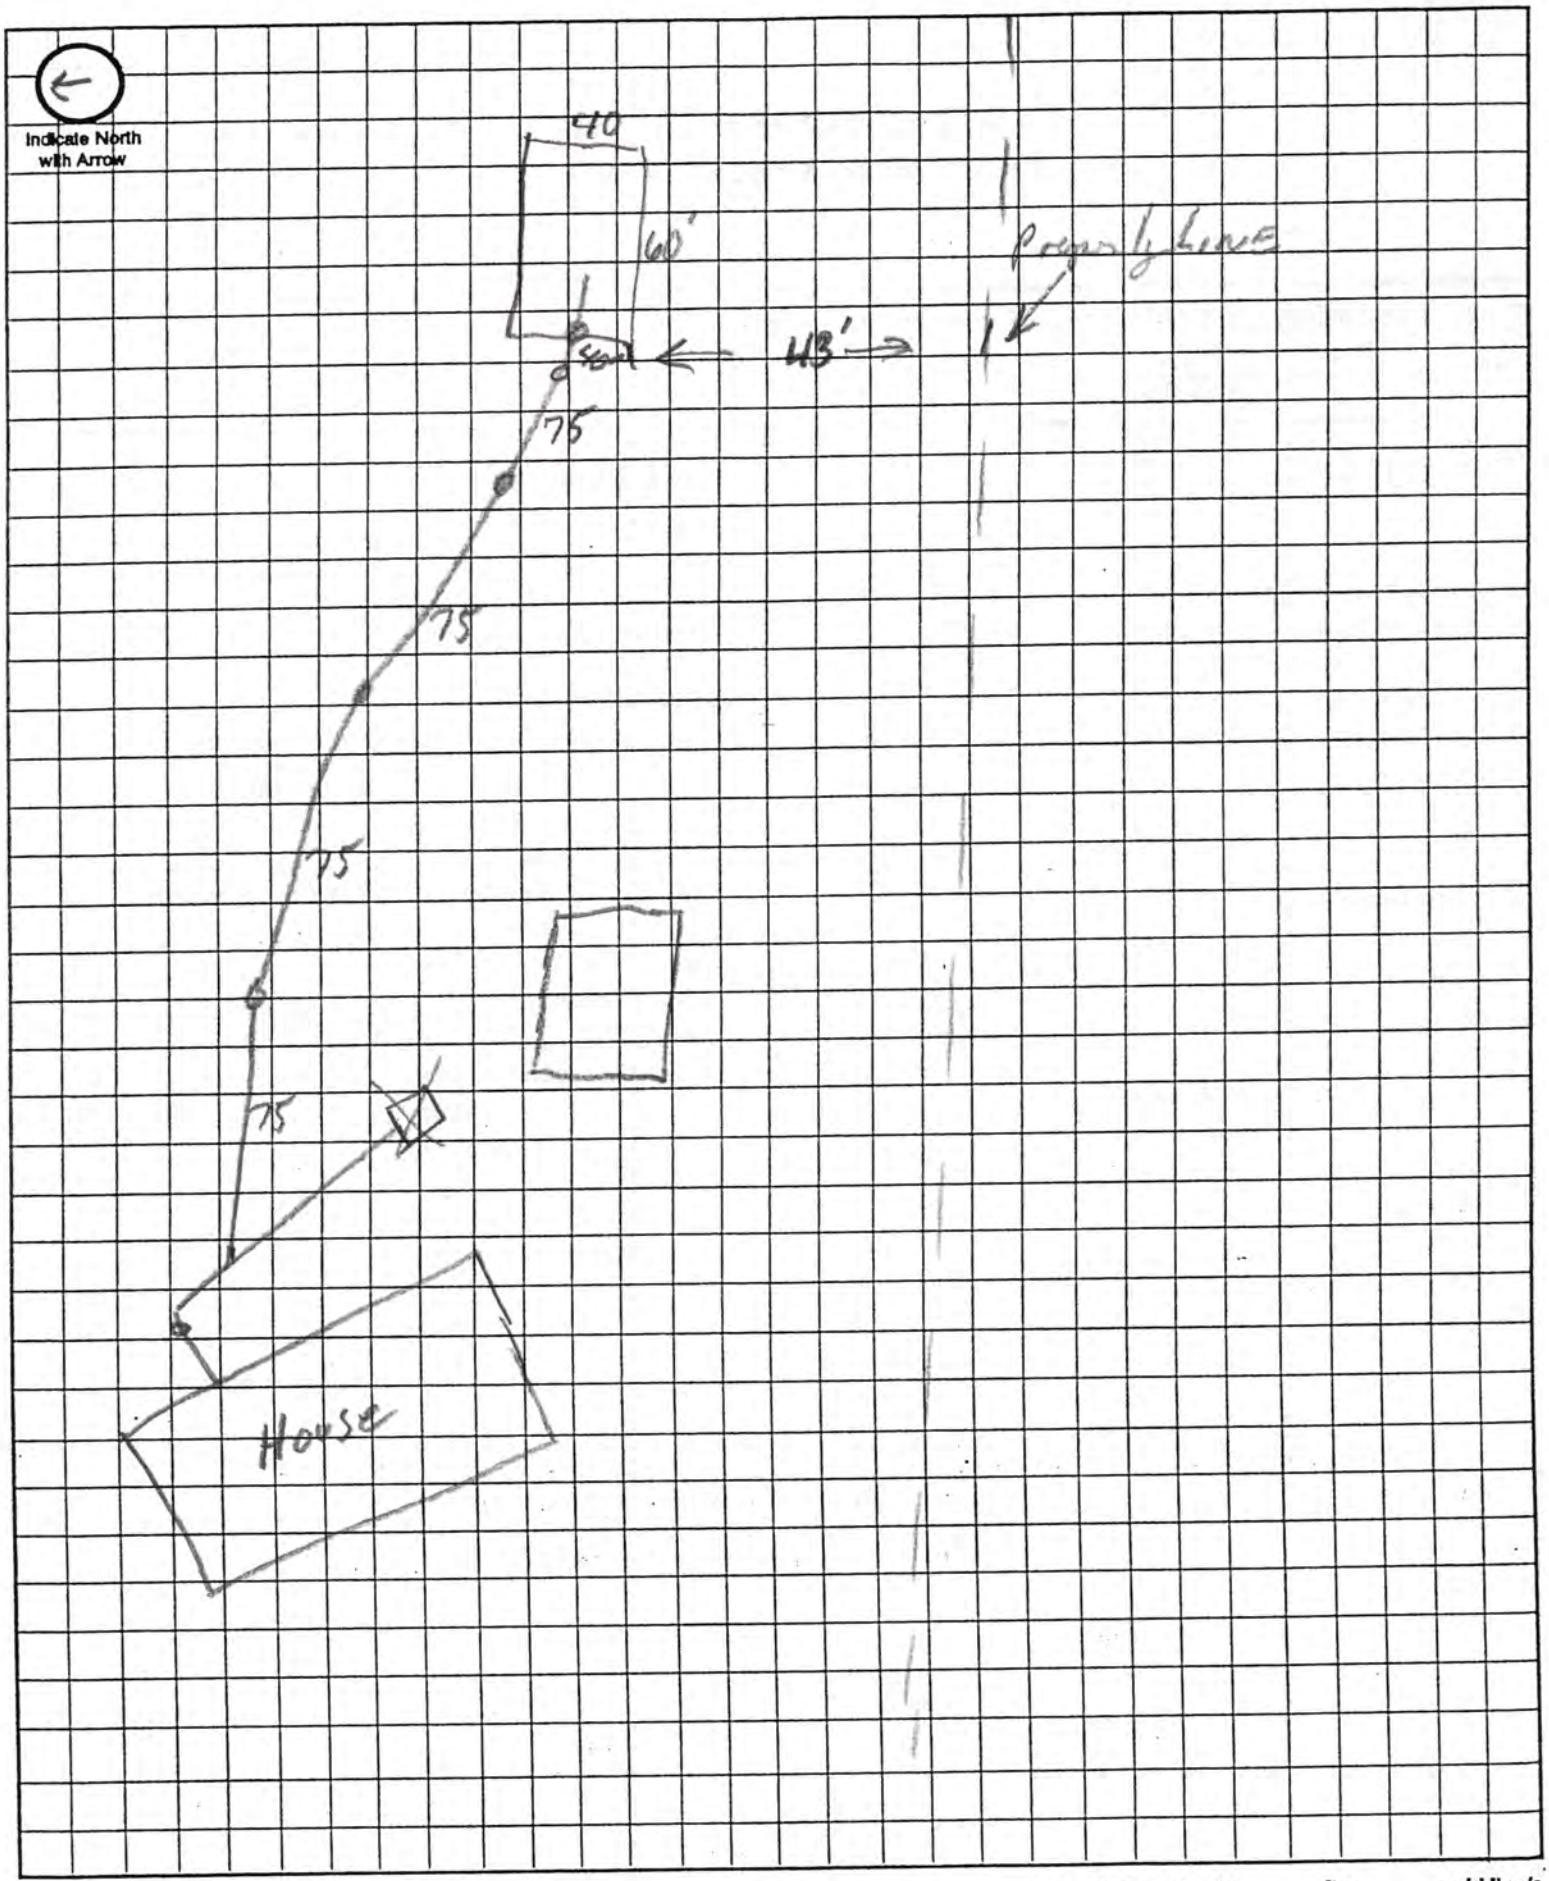

Approximate Scale: _____ ft. = _____ grid line/s