LINCOLN-LANCASTER COUNTY HEALTH DEPARTMENT

ENVIRONMENTAL HEALTH DIVISION

3140 "N" STREET Lincoln, NE 68510-1514 (402) 441-8000

NON TRANSFERABLE

PERMIT

Permit
SEWAGE INSTALLATION

No. 95380134001

Issued 09/05/95
Expires 03/05/96
Revenue Code 18754

Establishment
NORMAN PLUMBING
2400 N 63 ST
LINCOLN NE 68507

FEES: $150.00

TOTAL $150.00

Permittee
NORMAN PLUMBING
2400 N 63 ST
LINCOLN NE 68507

Issued By M. Jane Ford
Health Director

THIS LICENSE OR PERMIT IS ISSUED SUBJECT TO REVOCATION AS PROVIDED BY LAW "POST IN A PROMINENT PLACE"

REQUEST FOR SITE CLEARANCE AND PERMIT
FOR INDIVIDUAL SEWAGE DISPOSAL SYSTEM
City Ordinance No. 9150 ☐
County Resolution No. 2832 ☐

Lincoln-Lancaster County
HEALTH DEPARTMENT
3140 "N" STREET LINCOLN, NE 68510-1514

FILING FEE: $150 ck

FILE NO. _____

DATE: 8-25-95

The undersigned hereby requests SITE CLEARANCE and PERMIT to construct an Individual Sewage Disposal System in conformance with appropriate resolution or ordinance, as described herein: So. Half of N.W. QTr + No. Half of S.W. QTr

1. Legal description of property: Twp. 12N ; Range 7E ; Section 8 ;
   Block _____ : Lot _____ : Addition _____
   Street Address 21300 No. 40th

2. Property Use: Residential ☒ ; Commercial ☐ Other Use ☐
   No. of Bedrooms 3 . Describe _____

3. Type of Individual Sewage Disposal System: Septic Tank ☒ ; Other ☐

4. Distance to public sewer: _____ ft.

Norman Plbg.
Signature of Applicant (Owner or Lessee)

2400 No. 63rd Lincoln 68507
Address ph # 464-5721

(Do not write below this double line)

1. Health Department: Date Rec'd. 8/29/95. Date Frwd. 8/29/95. ACTION: Approved ☒ Disapproved ☐ Signature: Jerrold E. Hood
2. Supt. Bldg. Insp.: or Village Clerk: Date Rec'd. 8/29/95. Date Frwd. 8/29/95. ACTION: Approved ☐ Disapproved ☐ Signature: _____
3. City or County Engineer: Date Rec'd. 08/29/95. Date Frwd. _____. ACTION: Approved ☒ Disapproved ☐ Signature: _____

REMARKS OR REASONS FOR DISAPPROVAL _____

Site Visits:
Date: 9-7-95 by: ran need drawing
Date: _____ by: _____
Date: _____ by: _____

INSTALLATION FINAL WRITTEN APPROVAL
Date: 9-14-95 By: _____

White: Health Dept. Copy
Yellow: Engineers Copy
Pink: Bldg. Inspector's Copy

FORM 23 43

RECEIVED 1994

FORM 20105-0477
SOIL ABSORPTION TEST DATA REPORT
(Annex to Application)
(Reference: City Ordinance No. 9150 and County Resolution No. 2832)

LINCOLN-LANCASTER COUNTY HEALTH DEPARTMENT
Division of Environmental Health
2200 St. Marys Avenue
Lincoln, Nebraska 68502
Phone: 471-7800

B

Test Location
40th + Agnew Rd ½ mile No. East side

FILE NO. _____

PROPERTY WHERE SOIL TESTED:

Location: Township 12N ; Range 7E ; Section & ¼ Section 8 .
Property Dimensions: _____ ft. x _____ ft. Area: _____ acres. (Attach Sheet C with sketch of property).
Soil Type: Silty Clay ☐ ; Silty Clay Loam ☐ ; Sandy Loam ☐ ; Silt Loam ☐ ; Clay Loam ■ .
Dates of Tests: 11-25-94 to 11-26-94 . Weather: Precip. 0 Temp. 45°.

Holes - 2-3-4 - had water in From Pre-Test

OWNER: _____

Address: _____

PERCOLATION TEST DATA TABLE

a.	b.	c.	d.	e.	f.	g.	h.	i.	j.	k.	l.	m.	n.
		Pre-Saturation Period				Percolation Readings						Results	
		Start		End		Start			End				
Hold No.	Hole Depth (in.)	Date (Mo./Day)	Time (Hr./Min.)	Date (Mo./Day)	Time (Hr./Min.)	Date (Mo./Day)	Time (Hr./Min.)	Water Level (in.)	Time (Hr./Day)	Water Level (in.)	Elapsed Time (Min.)	Water Level Drop (in.)	Percolation Rates (Min./in.)
1	36"	11-25	10:30 Am	11-26	8:00 Am	11-26	8:00 Am	6"	12:00 pm	5½"	30m	½"	
2	36"	11-25	10:30 Am	11-26	8:00 Am	11-26	8:00 Am	6"	12:00 pm	5¾"	30m	¼"	
3	36"	11-25	10:30 Am	11-26	8:00 Am	11-26	8:00 Am	6"	12:00 pm	5⅞"	30m	⅛"	
4	36"	11-25	10:30 Am	11-26	8:00 Am	11-26	8:00 Am	6"	12:00 pm	5¾"	30m	¼"	
5	36"	11-25	10:30 Am	11-26	8:00 Am	11-26	8:00 Am	6"	12:00 pm	5"	30m	1"	
6	36"	11-25	10:30 Am	11-26	8:00 Am	11-26	8:00 Am	6"	12:00 pm	5"	30m	1"	

Sum of Percolation Rates: _____
Average of Rates: _____
Mean of Rates: _____

Mike Hoogland
Signature of Person Conducting Test

Address 2700 Dan Ave Lincoln NE. Phone 464-0638
Precast Products Inc.

(Do not write below this line)

REVIEWING ACTION

Remarks: _____

Soil Type (SCS): _____

Date: _____

Approved Percolation Rate (a)
A. 60 min./inch
B. _____ min./inch
C. _____ min./inch

_____
Signature of Reviewing Official

N
Driveway
N. 45th
33'
4
3
Test Hole's
90'
2
180'
well
5
20'
6
200'
Water way
S

FORM 20104-0477
PLANS & SPECIFICATIONS FOR SEWAGE DISPOSAL SYSTEM (Annex to Application)
City Ordinance No. 9150 ☐
County Resolution No. 2832 ☐

LINCOLN-LANCASTER COUNTY HEALTH DEPARTMENT
Division of Environmental Health
2200 St. Marys Avenue SEP 13
Lincoln, Nebraska 68502
Phone: 471-7800

D

DATE: 9-6-95

FILE NO. _____

address 21300 No. 40th


SPECIFICATIONS AS BUILT

A. BUILDING SEWER:
1. Material C PVC ; Diameter 4 in.
2. Distance above basement floor _____ in., or below basement floor 36 in.
3. Distance between dwelling and septic tank 108 ft.
4. Number of clean-outs 2 .
5. Distances to:
Well or Suction Line 100 + ft.; Stream 100 + ft.; Pressure Line 100 + ft.; Property Line 100 + ft.


B. SEPTIC TANK:
1. Material Concrete; No. of compartments 1 .
2. Capacity 1250 gals.;
3. Factory Built: Yes ☒ No ☐
(Company Precast)
4. Manholes: Over Inlet; diam. 8" in.
Over Outlet; diam. 8" in.
Riser Above ☒ Below ☐ Grade 6 in.
5. Inlet: Baffle ☒ ; or Tee ☐
6. Outlet: Baffle ☒ ; or Tee ☐
7. Depth of top of tank below finished grade 18 in.
8. Distances to:
Well or Suction Line 100 + ft.; Stream 100 + ft.; Pressure Line 100 + ft.; Property Line 100 + ft.


C. DISTRIBUTION BOX:
1. Material Concrete ; Number - available outlets 5 .
2. Factory Built: Yes ☒ No ☐
(Company Precast)
3. Distance from Septic Tank 77 ft.


D. ABSORPTION FIELD: (Provide as built drawings on back of this form)
1. Type: Half Rounds ☒ Perforated Pipe ☐
Diameter of Half Round 20" or Perforated Pipe _____.
Material: fiberglass ☐ ; plastic ☐ ; concrete ☒ ; other _____.
2. Lateral Lines:
Number 3 ; Length of each line 92 , 100 , 100 , _____ , _____ ft.;
Total length of laterals 292 ft.;
Distance between lateral lines 29 ft.
3. Trench dimensions: Width 4 ft.;
Slope 4 in/100 ft.; Average Depth 42 in.
4. Filter Material: Gravel
Depth of Material 24 in.
5. Distances to:
Well or Suction Line 100 + ft.;
Stream ~~100 +~~ ft.; Pressure Line 100 + ft.; Property Line 100 + ft.

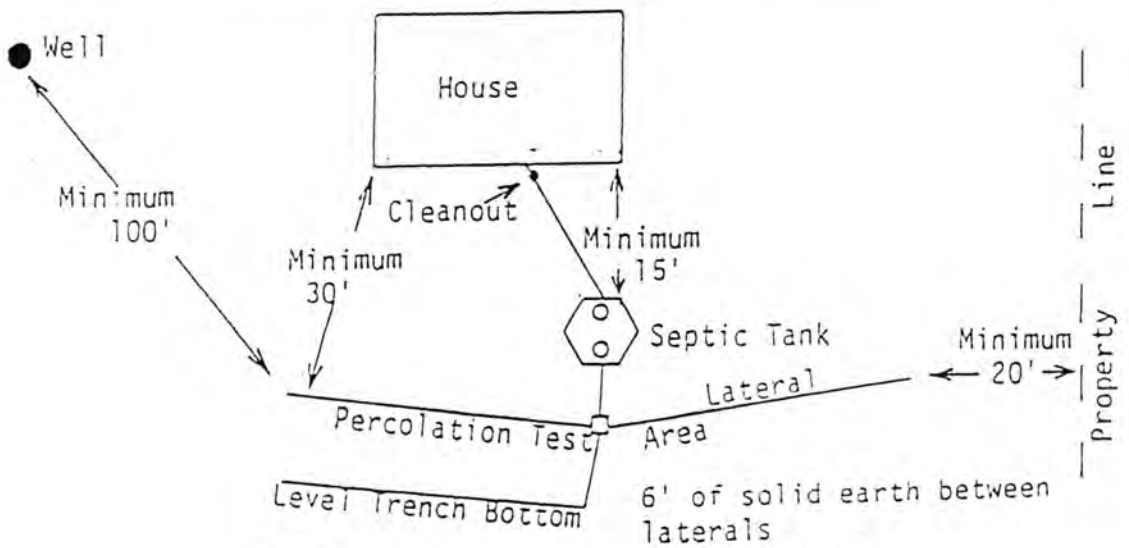

TYPICAL INDIVIDUAL SEWAGE SYSTEM DESIGN

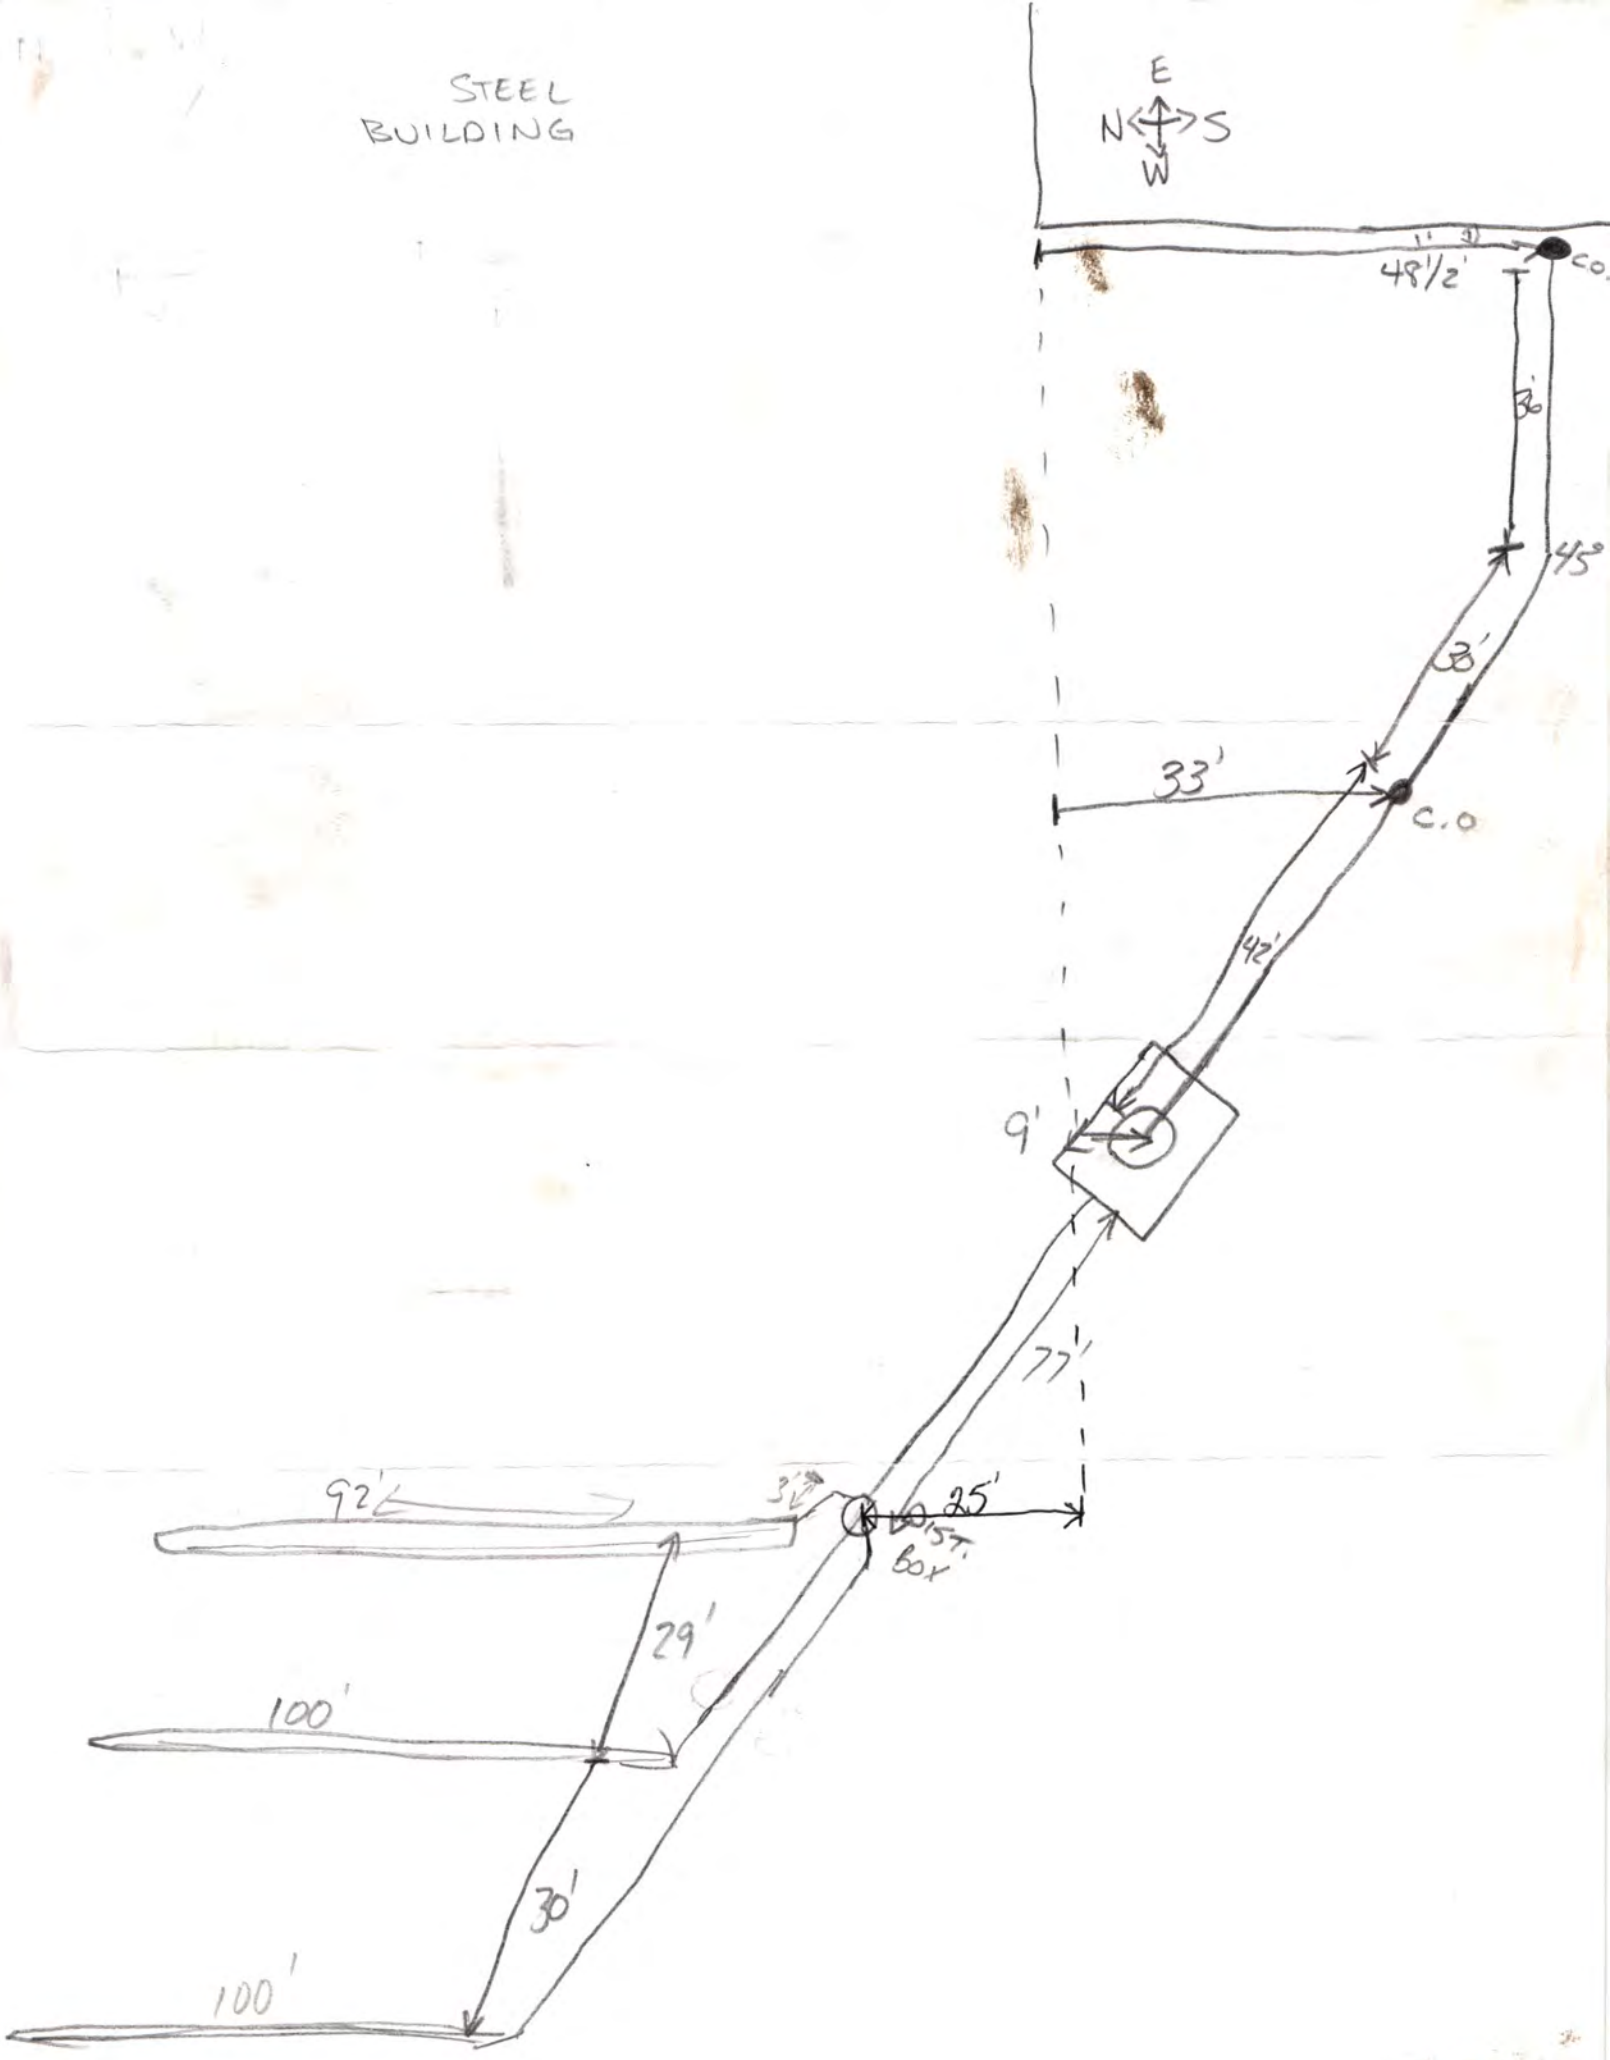
STEEL BUILDING
E
N
S
W
48 1/2'
C.O
36'
45°
33'
C.O
42'
9'
77'
92'
3'
25'
5'
Box
29'
100'
30'
100'

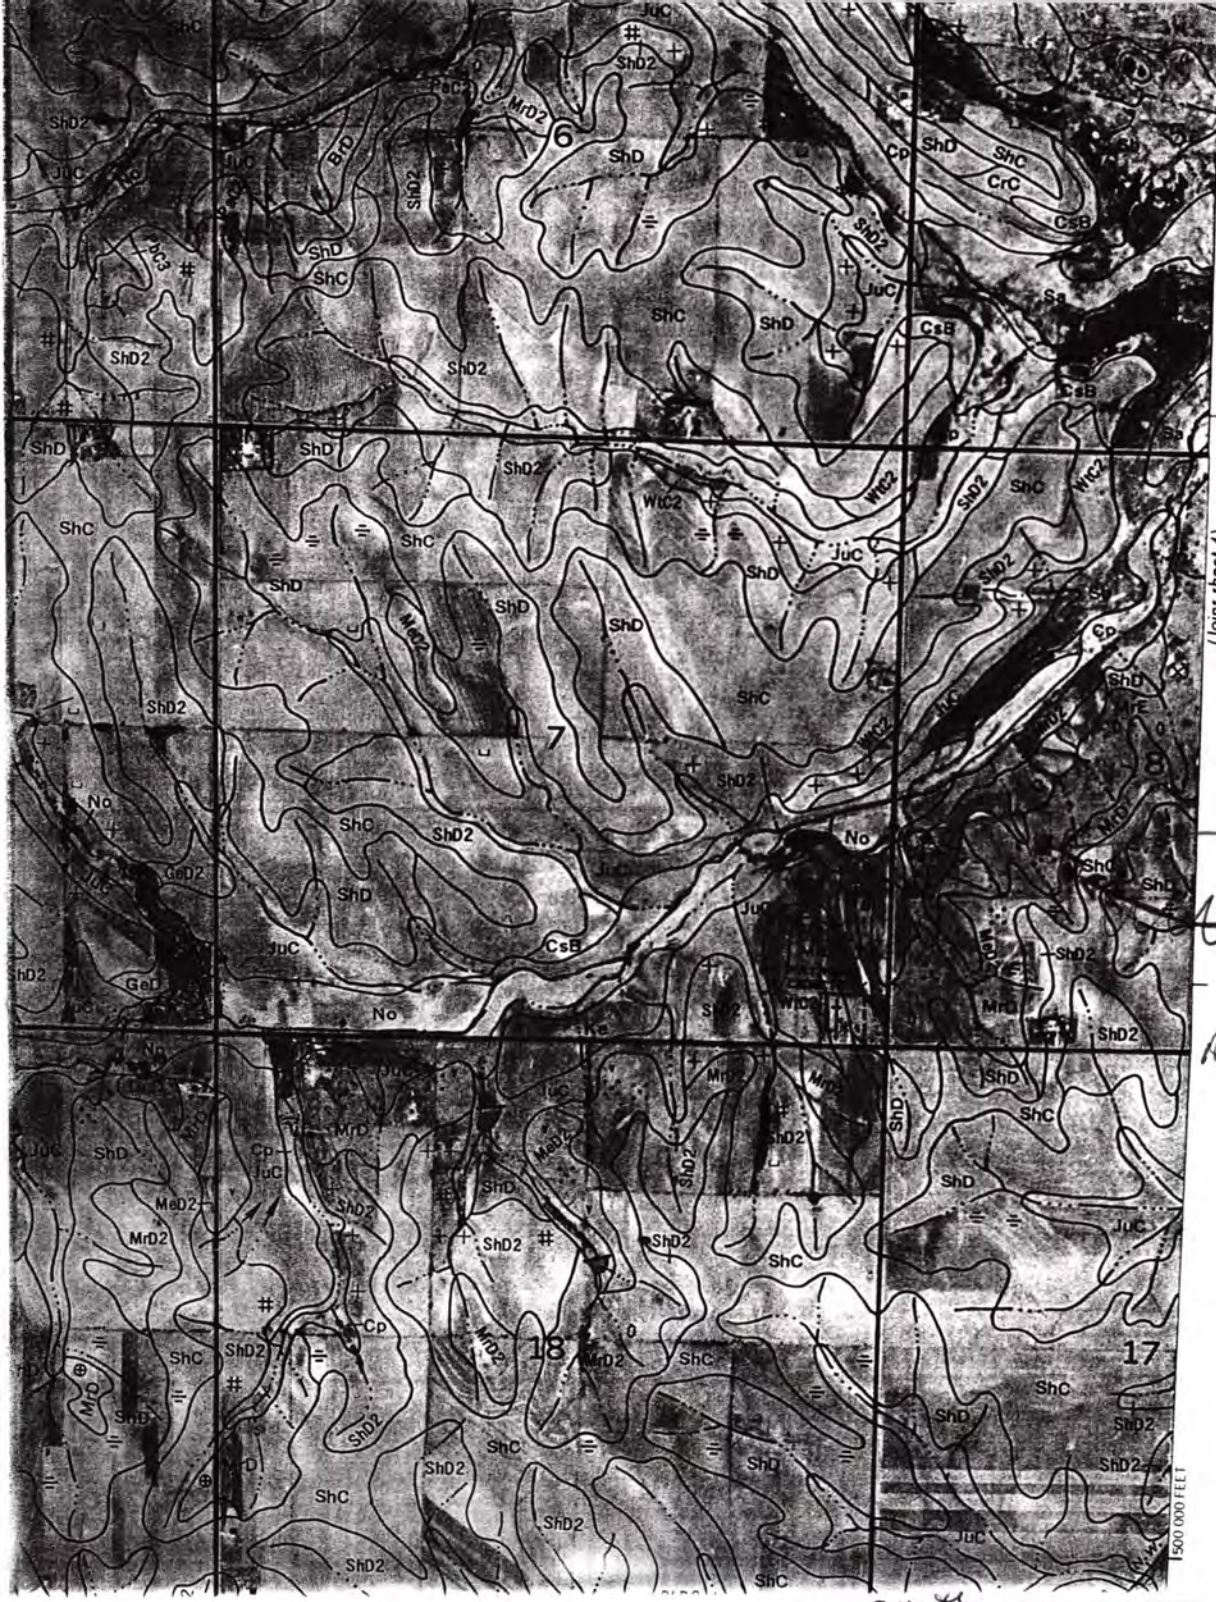

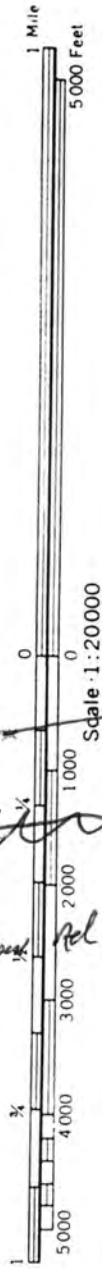

Septic system

Aquifer Rel.

E40 44