Lincoln-Lancaster County Health Department
ENVIRONMENTAL PUBLIC HEALTH DIVISION

006667

3140 N STREET · LINCOLN, NE 68510-1514

(402) 441-8000

Permit: SEWAGE INSTALLATION
LAGOON

Permit # 05380300201

Issued 04/15/05
Expires 04/15/06
Revenue Code 3157

Establishment:
VANTAGE POINTE HOMES
T10N R5E SEC 10
LOT 28IT
NW 98 ST

FEES: $200.00

Permittee:
VANTAGE POINTE HOMES
1000 W ROKEBY RD
ROKEBY NE 68522

TOTAL: $200.00

Bruce D. Dart

Bruce D. Dart, Health Director

EPH COPY

Lincoln-Lancaster County Health Department
Environmental Health Division
3140 "N" Street • Lincoln, NE 68510-1514
Phone: 402-441-8022

APR 15 2005

A

Permit Number: 05380300201

Sewage Disposal System

Request for Site Clearance and Permit

Include Form B, Form C and Applicable Fees with this Application.

☐ Septic System ☒ Lagoon ☐ Other (Refer to Form C)

The undersigned hereby requests site clearance and permit to construct a Sewage Disposal System in conformance with appropriate resolution or ordinance, as described herein:

PLEASE PRINT OR TYPE

A. System Location (Indicate correct number and street)

Address NW 98 (no rural route) City Lincoln NE, Zip 68524

Legal Description 10 10N 5E 28 I.T.
1/4 | 1/4 | Section | Township | Range | Subdivision | Addition | Block | Lot

Geographical Location (if known): Longitude _____ Latitude _____

☐ Check if system mail address is not the same as the owner's address

B. Owner

Name Vantage Pointe Homes Signature _____

Address _____ City/State/Zip _____

☐ Check if owner designed system Home Phone _____ Work Phone _____

C. Contractor

Name Brad Southwick Company Name Southwick Sewer & Drain

Address 17201 S. 72 City/State/Zip Hickman, Ne 68372

☐ Check if contractor designed system Work Phone _____

D. Engineer/Installer ☐ Check and complete if engineer designed system

Designer Name _____ Firm _____ Work Phone _____

E. This System Will Serve a

☒ Residential Dwelling Number of Bedrooms 2 Is there a Whirlpool Bathtub YES (NO)

☐ Commercial Establishment/Other Facility Specify _____

Design flow in gallons per day _____ Type of Wastewater: ☐ Domestic ☐ Non-Domestic.

DO NOT WRITE BELOW THIS LINE

Approval Process ☒ Municipal Code 24.38 ☐ County Resolution No. 2832

1. **Health Department** Date rec'd 4/15/05 Date frwd _____ ACTION ☒ Approved ☐ Disapproved Signature Jerrold C. Hood
2. **Supt. Bldg. Insp. or Village Clerk** Date rec'd 4/18/05 Date frwd 4/18/05 ACTION ☐ Approved ☐ Disapproved Signature _____
3. **City or County Engineer** Date rec'd 4-18-05 Date frwd 4-18-05 ACTION ☒ Approved ☐ Disapproved Signature _____

7/11/05 – lagoon – line O.K.

Installation Final Written Approval

By _____

Date 1/12/06

Business Office Use Only

Date Rec'd 4-15-05
Amt Paid $200.00
Rec'd By _____ Cash/Check No. 1083

FORM 23-100 10-96 White - Health Dept. Yellow - Engineer Pink - Bldg. Inspector

Lincoln-Lancaster County Health Department
Environmental Health Division
3140 "N" Street • Lincoln, NE 68510-1514
Phone: 402-441-8022


RECEIVED
APR 15 2005

C

Permit Number: 05380300201

Sewage Disposal System
Preliminary Plan Specifications

Draw a plot plan showing system location, lines, distribution box, tank and laterals, percolation test hole locations, well, residence, compass direction and property lines. Indicate on drawing if residence and well are existing or proposed.

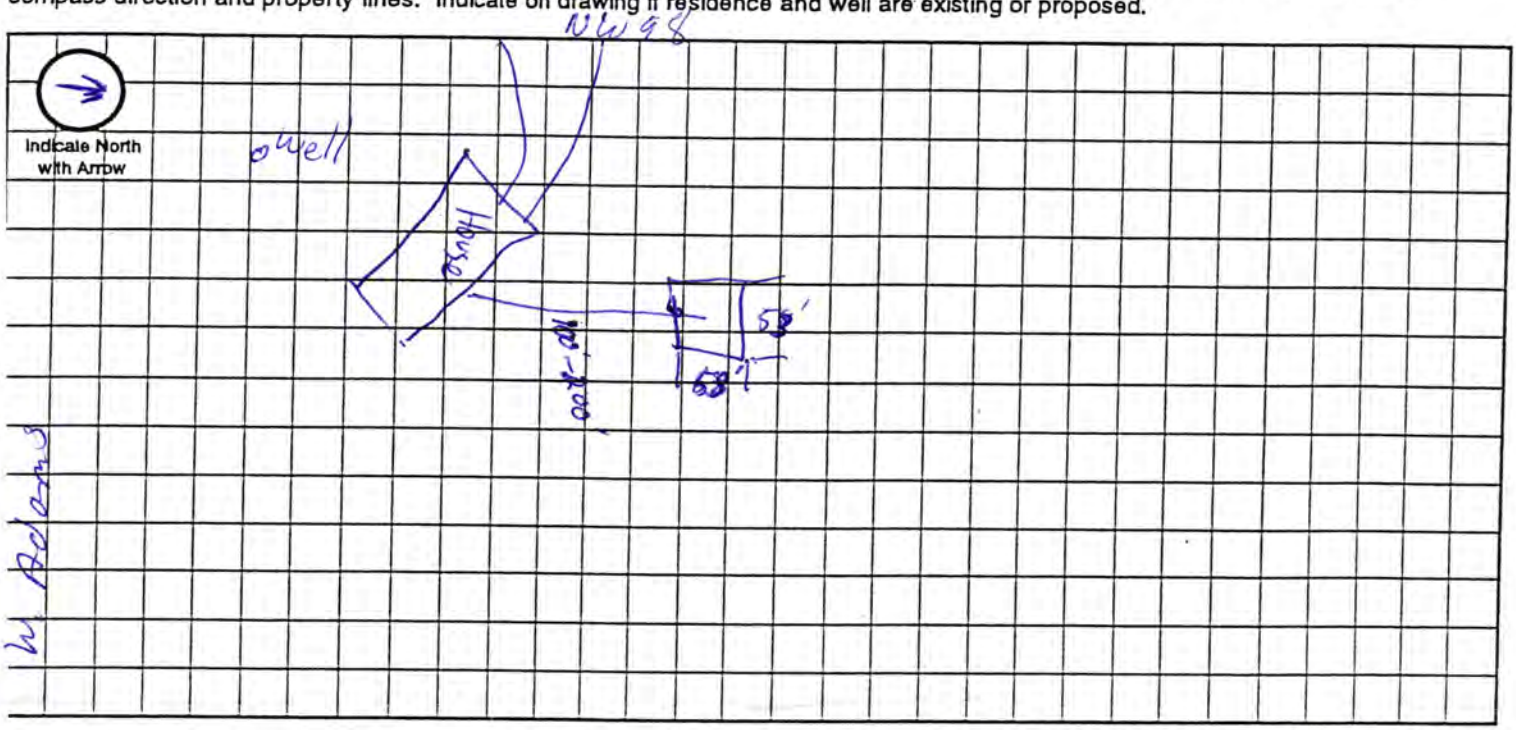

Approximate Scale: _____ ft. = _____ grid line/s

A. System Location (Indicate correct number and street)

Address (no rural route) NW 98 City LINCOLN NE, Zip 68524

B. Proposed Septic Tank/s

Tank Material: ☐ Concrete ☐ Plastic ☐ Other _____

C. Proposed Absorption System (See Form B for Percolation Information)

Percolation Rate _____ (min. per inch) Soil Type: _____ Land Slope: _____ %

Type of Absorption System: ☐ Trench ☐ Bed ☐ Other _____

Total Square Feet of Field Required: _____ sq. ft.

Type of Lateral: ☐ Half-Moon ☐ Perforated Pipe ☐ Other Lateral Material: _____

Capacity of Septic Tank _____ gals Number of Absorption Beds: _____ Number of Distribution Laterals per Bed _____

Total Length of Laterals _____ ft. Number of Trenches _____ Trench Width _____

D. Setbacks Check the Boxes Below if the Required Setback has been Satisfied

Distance From	Private Well	Public Well	Surface Water	Gound Water	Pressure Water Lines	Property Lines	Foundations Yours	Foundations Neighbors	All Other Setbacks
Tank (ft)	50 ☐	500 ☐	50 ☐	NA ☐	25 ☐	20 ☐	15 ☐	25 ☐	☐
Field (ft)	100 ☐	500 ☐	50 ☐	4 ☐	30 ☐	20 ☐	30 ☐	40 ☐	☐
Lagoon (ft)	100 ☒	500 ☒	50 ☒	N/A ☐	30 ☒	50 ☒	100 ☒	200 ☒	☒

E. Required Signatures

Home Building Contractor _____ Date _____

Installer _____ Date 4-15-05

RM 23-102 10-96

Lincoln-Lancaster County Health Department
Environmental Health Division
3140 "N" Street • Lincoln, NE 68510-1514
Phone: 402-441-8022

D

Permit Number:

Sewage Disposal System

As Built Plans & Specifications

Date 7-11-05

NE corner of NW 98 & W. Adams

System Location (Indicate correct number and street)

Address 3100 NW 98 (no rural route) City LINCOLN NE, Zip 68524

A. Building Sewer

1. Material: Sch 40 PVC
   Diameter: 4 in.
2. Distance above basement floor: _____ in.
   or distance below basement floor: 12 in.
3. Distance between dwelling and septic tank: 130 ft.
4. Number of clean-outs: 2 Lagoon
5. Distances to: well or suction line _____ ft.
   stream _____ ft.
   pressure line _____ ft.
   property line _____ ft.

B. Septic Tank

1. Material: _____
   Number of compartments: _____
2. Capacity: _____ gal.
3. Factory built: ☐ Yes ☐ No
4. Manholes: Over inlet, diameter _____ in.
   Over outlet, diameter _____ in.
   Riser: ☐ above ☐ below grade _____ in.
5. Inlet: ☐ baffle ☐ tee
6. Outlet: ☐ baffle ☐ tee
7. Depth to top of tank, below unfinished grade: _____ in.
8. Distances to: Well or suction line _____ ft.
   Stream _____ ft.
   Pressure line _____ ft.
   Property line _____ ft.

C. Distribution Box

1. Material: _____
   Number available outlets: _____
2. Factory built: ☐ Yes ☐ No
3. Distance from septic tank: _____ ft.

D. Absorption Field


(Provide as-built drawings on back of this form)

1. Type: ☐ Half rounds ☐ Perforated pipe
   Diameter of half round: _____
   or perforated pipe: _____
   Material: ☐ fiberglass ☐ plastic ☐ concrete
   ☐ other _____
2. Lateral lines: Number _____
   Length of each line: _____ ft. _____ ft.
   _____ ft. _____ ft., _____ ft.
3. Trench dimensions: Width _____ ft.
   Slope _____ in/100 ft.
   Average depth _____ in
4. Filter material: _____
   Depth of material _____ in.
5. Distances to: Well or suction line _____ ft.
   Stream _____ ft.
   Pressure line _____ ft.
   Property line _____ ft.


Complete "As Built" drawing on back of this form.

Indicate North with Arrow

Individual Sewage System Design (Example)

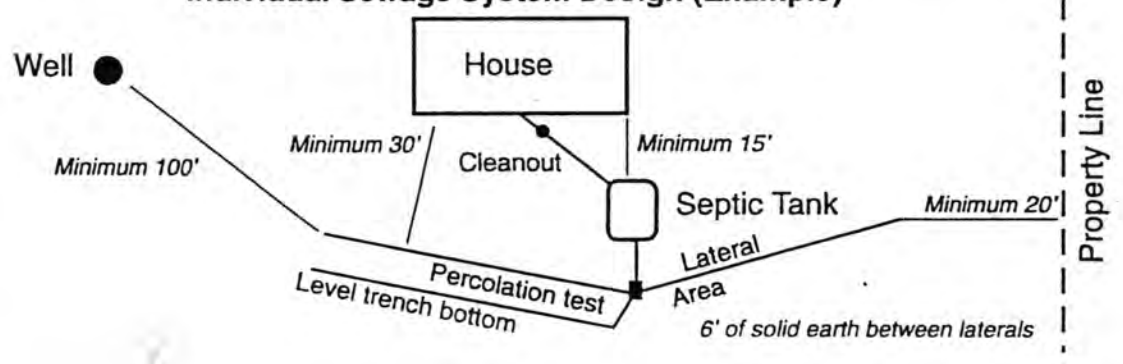

As Built Drawing

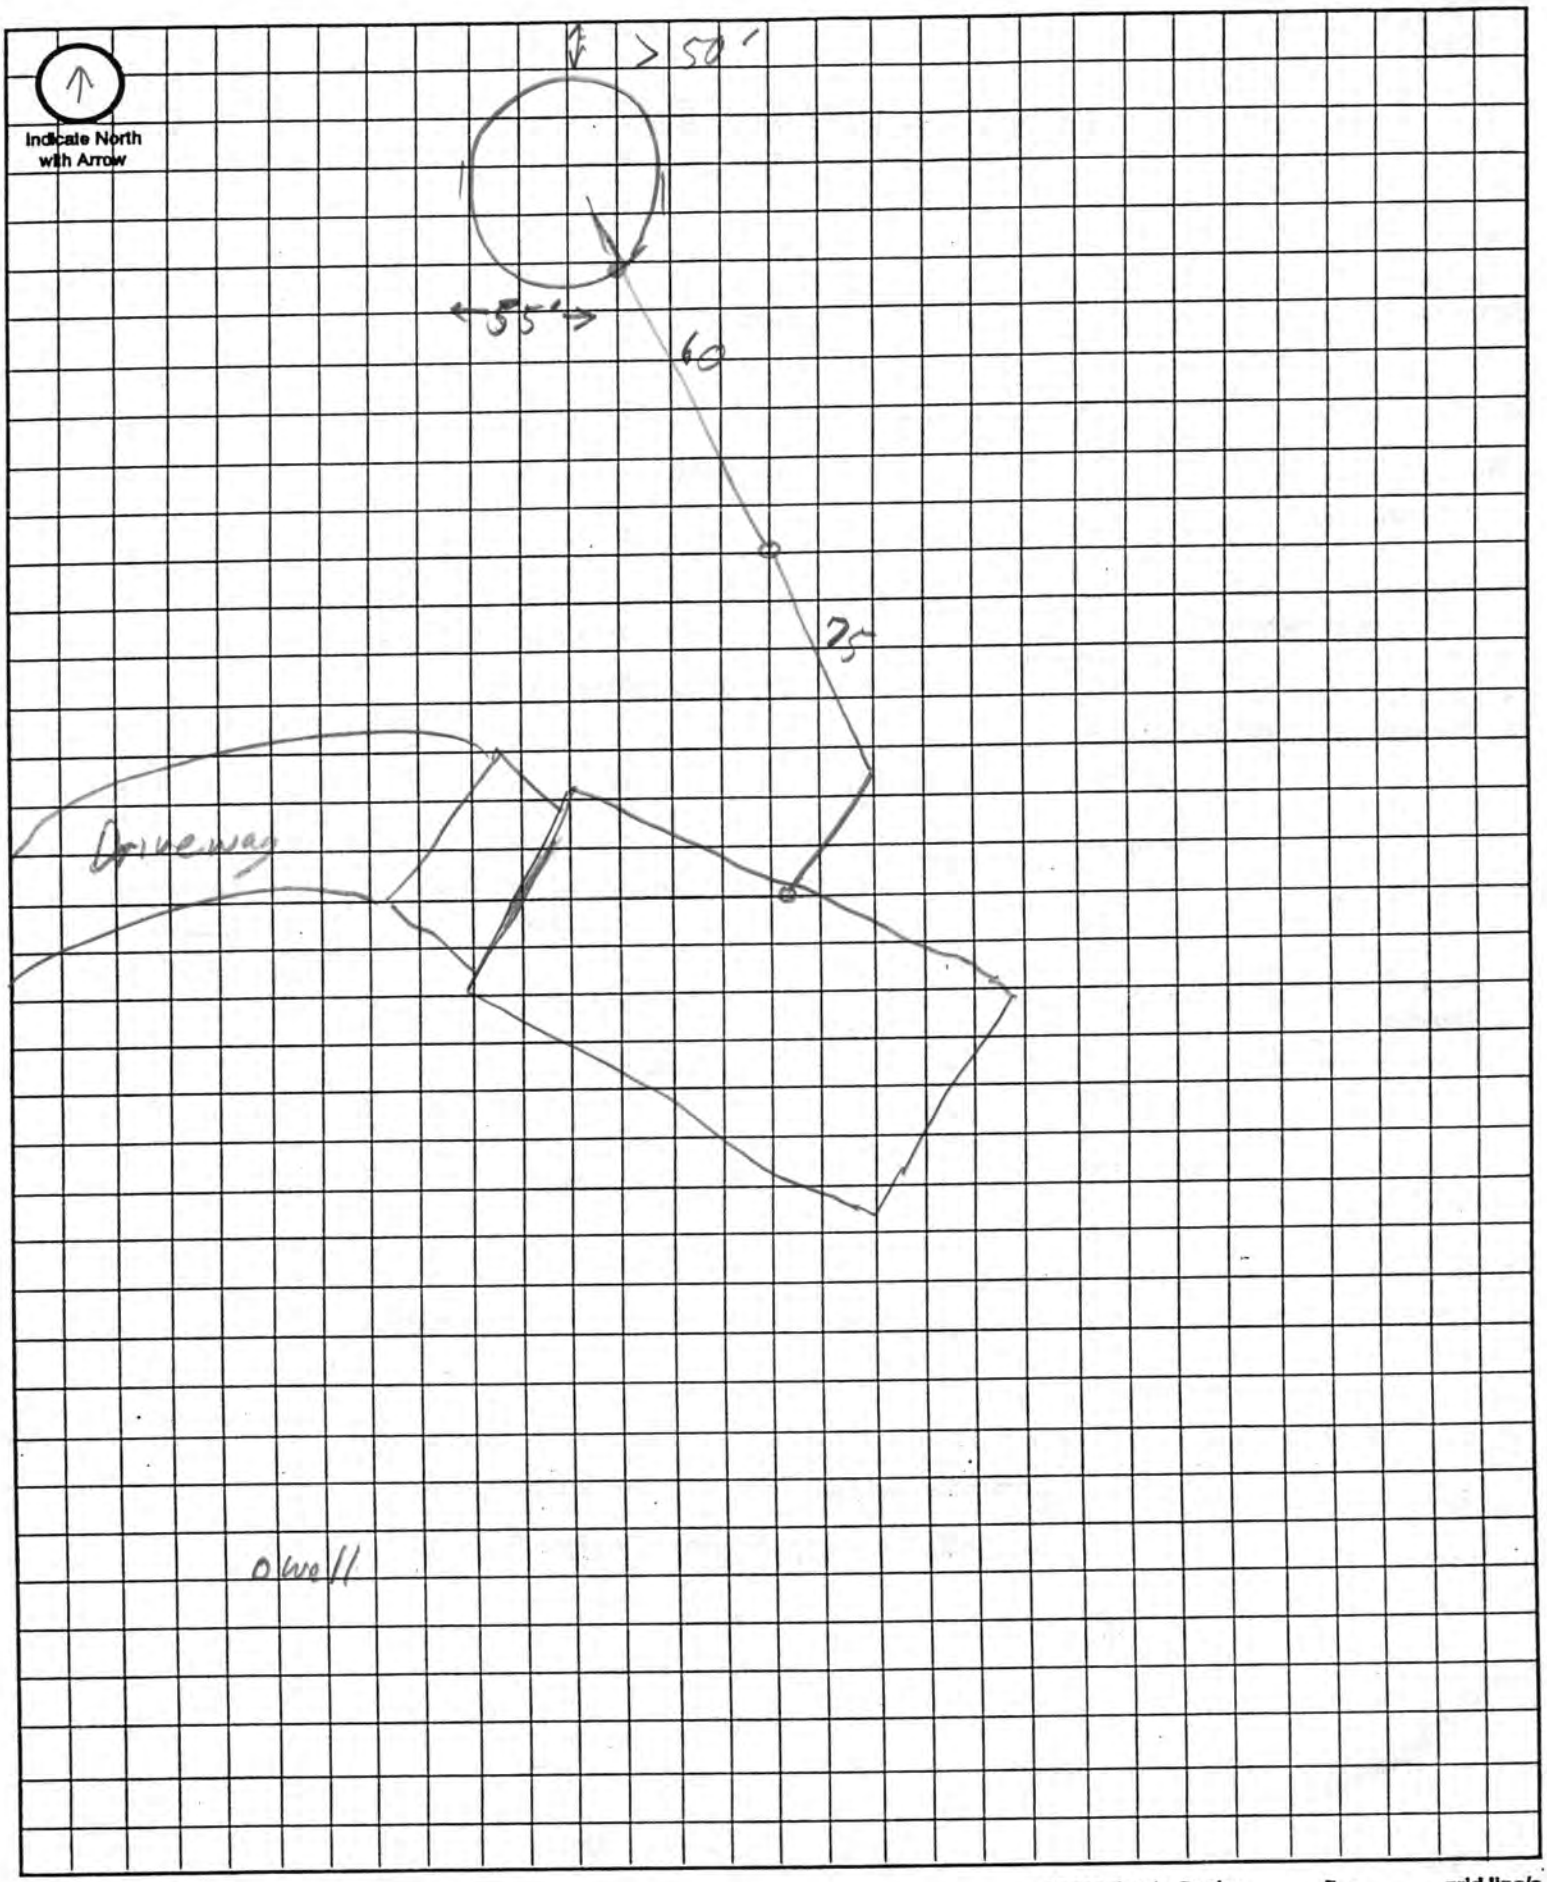

Approximate Scale: _____ ft. = _____ grid line/s