Lincoln-Lancaster County Health Department

ENVIRONMENTAL HEALTH DIVISION
3140 N STREET · LINCOLN, NE 68510-1514 (402) 441-8000

Permit

SEWAGE INSTALLATION
LAGOON

Permit # 99380201001

Issued 06/11/99
Expires 12/11/99
Revenue Code 3157

FEES: $150.00

Establishment

WALLACE RONALD DOUGLAS
T12N R5E SEC 24 QTR NW
NW 70 ST& ROCKCREEK RD-RAYMOND

Permitee

WALLACE RONALD DOUGLAS
1244 CLEARVIEW BLVD
LINCOLN NE 68512

TOTAL: $150.00

Leon F. Vinci, MPH, Health Director

• POST IN A PROMINENT PLACE • NOT TRANSFERABLE

010561

Lincoln-Lancaster County Health Department
Environmental Health Division
3140 "N" Street • Lincoln, NE 68510-1514
Phone: 402-441-8022

A

Permit Number: 993802 010

Sewage Disposal System

Request for Site Clearance and Permit

Include Form B, Form C and Applicable Fees with this Application.

☐ Septic System ☒ Lagoon ☐ Other (Refer to Form C)

The undersigned hereby requests site clearance and permit to construct a Sewage Disposal System in conformance with appropriate resolution or ordinance, as described herein:

PLEASE PRINT OR TYPE

A. System Location (Indicate correct number and street)

Address ~~ROCK CREEK RD~~ NW 70TH 18800 (~~no rural route~~) City RAYMOND NE, Zip

Legal Description NW 1/4 1/4 24 Section T12N Township R5E Range Subdivision Addition Block Lot

Geographical Location (if known): Longitude Latitude

☐ Check if system mail address is not the same as the owner's address

B. Owner

Name WALLACE RONALD DOUGLAS Signature

Address 1244 GLENVIEW BLVD City/State/Zip LINCOLN, NE 68508

☐ Check if owner designed system Home Phone 402 421-1613 Work Phone N/A

C. Contractor RON LICHTE

Name RON ERNEST Company Name LICHTE EXCAVATING-ERNEST WELL DRILLERS

Address City/State/Zip MILFORD NEBRASKA

☑ Check if contractor designed system Work Phone

D. Engineer/Installer ☐ Check and complete if engineer designed system

Designer Name Firm Work Phone

E. This System Will Serve a

☒ Residential Dwelling Number of Bedrooms 3+ Is there a Whirlpool Bathtub (YES) NO

☐ Commercial Establishment/Other Facility Specify

Design flow in gallons per day Type of Wastewater: ☒ Domestic ☐ Non-Domestic.

DO NOT WRITE BELOW THIS LINE

Approval Process ☐ Municipal Code 24.38 ☒ County Resolution No. 2832

1. **Health Department**	Date rec'd 6-11-99 Date frwd 6/14/99	**ACTION** ☒ Approved ☐ Disapproved Signature	
2. **Supt. Bldg. Insp. or Village Clerk**	Date rec'd 6-14-99 Date frwd 6-14-99	**ACTION** ☒ Approved ☐ Disapproved Signature	
3. **City or County Engineer**	Date rec'd 6/14/99 Date frwd 6/14/99	**ACTION** ☒ Approved ☐ Disapproved Signature	

10-21-99 Jim need ~~Hydrology~~ & Face

Installation Final Written Approval

By

Date 2-4-00

Business Office Use Only

Date Rec'd 06/11/99
Amt Paid 150 cc
Rec'd By Gash/Check No. 507

FORM 23-100 10-96 White - Health Dept. Yellow - Engineer Pink - Bldg. Inspector

Lincoln-Lancaster County Health Department
Environmental Health Division
3140 "N" Street • Lincoln, NE 68510-1514
Phone: 402-441-8022

B

Permit Number: 993802010

Sewage Disposal System

Soil Absorption Test Data Report

Annex to Application

PLEASE PRINT OR TYPE

System Location (Indicate correct number and street)

Address 18800 ~~ROCK CREEK RD~~ NW 70TH (no rural route) City RAYMOND, NE Zip _____

Owner W.R. DOUGLAS Addresss 1244 E CLEARVIEW BLVD, LINCOLN, NB 68510

Soil Type (SCS): _____ Percolation Rate: _____ min./inch

Date of Tests _____ to _____ Weather: Precipitation _____ Temperature _____

Percolation Test Data Table

A.	B.	C. D. E. F. Pre-Saturation Period				G. H. I. J. K. Percolation Readings					L. M. N. Results		
		Start		End		Start			End				
Hole No.	Hole Depth (in)	Date (Mo/Da)	Time (Hr/Min)	Date (Mo/Da)	Time (Hr/Min)	Date (Mo/Da)	Time (Hr/Min)	Water Lev (in.)	Date (Mo/Da)	Time (Hr/Min)	Elapsed Time (Min)	Water Level Drop (in)	Percolation Rates (Min/in)
					N/A		N/A						

Person Conducting Percolation Tests

Name: _____

Phone: _____

Address _____

Sum of Percolation Rates: _____

Average of Rates: _____

Rate Used for Calculation: _____

DO NOT WRITE BELOW THIS LINE

Reviewing Action

Remarks SEALED LAGOON WILL BE CONSTRUCTED,

Signature of Reviewing Official _____ Date 6-10-99

FORM 23-101 10-96

Lincoln-Lancaster County Health Department
Environmental Health Division
3140 "N" Street • Lincoln, NE 68510-1514
Phone: 402-441-8022

C

Permit Number: 99302010

Sewage Disposal System
Preliminary Plan Specifications

Draw a plot plan showing system location, lines, distribution box, tank and laterals, percolation test hole locations, well, residence, compass direction and property lines. Indicate on drawing if residence and well are existing or proposed.



Approximate Scale: _____ ft. = _____ grid line/s

A. System Location (Indicate correct number and street)

Address (no rural route) 8800 NW 70th City RAYMOND NE, Zip _____

B. Proposed Septic Tank/s

Tank Material: ☐ Concrete ☐ Plastic ☐ Other _____

C. Proposed Absorption System (See Form B for Percolation Information)

Percolation Rate _____ (min. per inch) Soil Type: _____ Land Slope: _____ %

Type of Absorption System: ☐ Trench ☐ Bed ☐ Other _____

Total Square Feet of Field Required: _____ sq. ft.

Type of Lateral: ☐ Half-Moon ☐ Perforated Pipe ☐ Other Lateral Material: _____

Capacity of Septic Tank _____ gals Number of Absorption Beds: _____ Number of Distribution Laterals per Bed _____

Total Length of Laterals _____ ft. Number of Trenches _____ Trench Width _____


D. Setbacks Check the Boxes Below if the Required Setback has been Satisfied

Distance From	Private Well	Public Well	Surface Water	Gound Water	Pressure Water Lines	Property Lines	Foundations Yours	Foundations Neighbors	All Other Setbacks
Tank (ft)	50 ☐	500 ☐	50 ☐	NA ☐	25 ☐	20 ☐	15 ☐	25 ☐	☐
Field (ft)	100 ☐	500 ☐	50 ☐	4 ☐	30 ☐	20 ☐	30 ☐	40 ☐	☐
Lagoon (ft)	100 ☒	500 ☒	50 ☒	N/A ☒	30 ☒	50 ☒	100 ☒	200 ☒	☒

E. Required Signatures

Home Building Contractor _____ Date 11 June 99

Installer LENZ CONST SEWARD Date _____

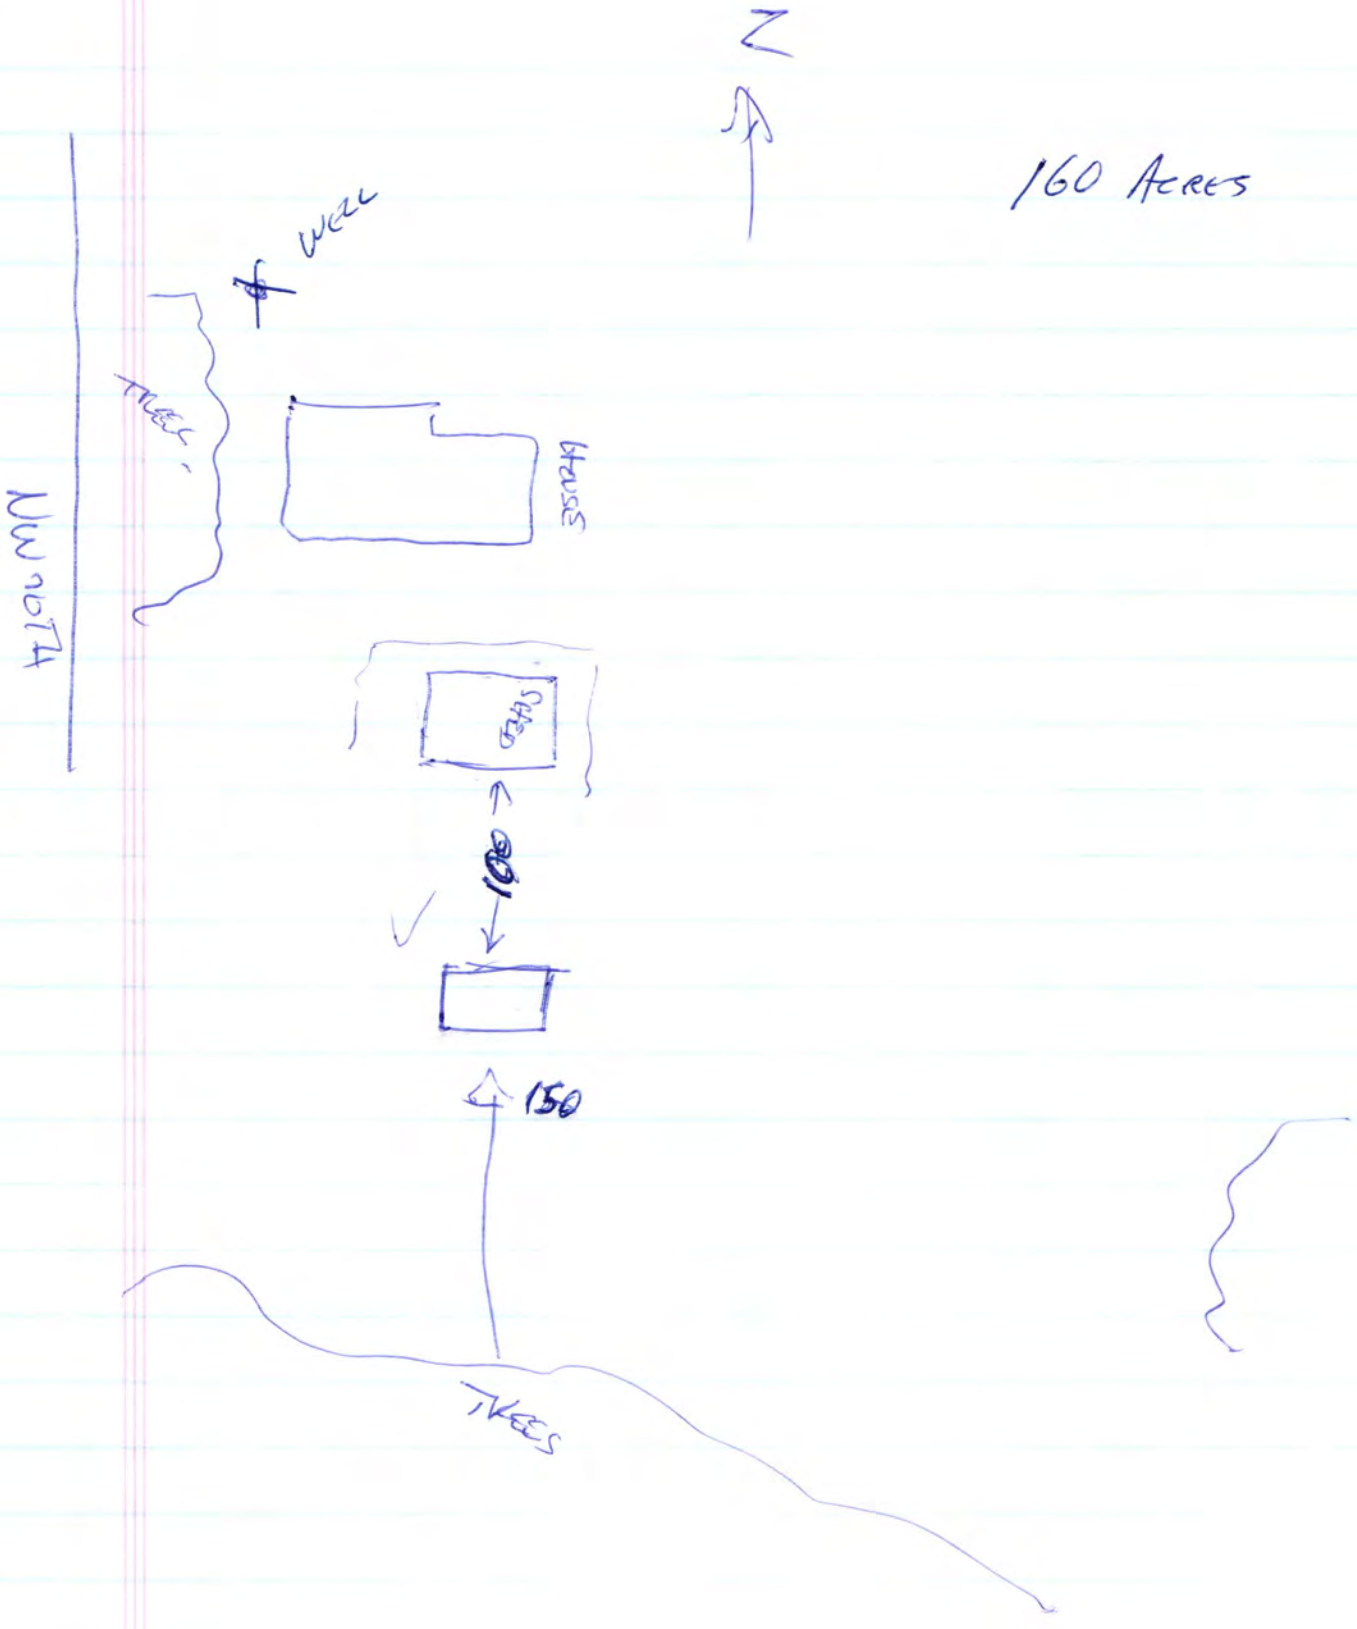
N
160 Acres
well
house
Shed
100
150
Trees

Lincoln-Lancaster County Health Department
Environmental Health Division
3140 "N" Street • Lincoln, NE 68510-1514
Phone: 402-441-8022

OCT 25 1999

D

Permit Number: 993802 dD

Sewage Disposal System

As Built Plans & Specifications

Ron Douglas
18800 NW 70th

Date 10/21/99

System Location (Indicate correct number and street)
Address 18800 NW 70th (no rural route) City Raymond NE, Zip _____

A. Building Sewer

1. Material: 4" SDR 26
   Diameter: _____ in.
2. Distance above basement floor: _____ in.
   or distance below basement floor: _____ in.
3. Distance between dwelling and septic tank: _____ ft.
4. Number of clean-outs: _____
5. Distances to: well or suction line _____ ft.
   stream _____ ft.
   pressure line _____ ft.
   property line _____ ft.

B. Septic Tank

1. Material: _____
   Number of compartments: _____
2. Capacity: _____ gal.
3. Factory built: ❑ Yes ❑ No
4. Manholes: Over inlet, diameter _____ in.
   Over outlet, diameter _____ in.
   Riser: ❑ above ❑ below grade _____ in.
5. Inlet: ❑ baffle ❑ tee
6. Outlet: ❑ baffle ❑ tee
7. Depth to top of tank, below unfinished grade: _____ in.
8. Distances to: Well or suction line _____ ft.
   Stream _____ ft.
   Pressure line _____ ft.
   Property line _____ ft.

C. Distribution Box

1. Material: _____
   Number available outlets: _____
2. Factory built: ❑ Yes ❑ No
3. Distance from septic tank: _____ ft.

D. Absorption Field


(Provide as-built drawings on back of this form)

1. Type: ❑ Half rounds ❑ Perforated pipe
   Diameter of half round: _____
   or perforated pipe: _____
   Material: ❑ fiberglass ❑ plastic ❑ concrete
   ❑ other _____
2. Lateral lines: Number _____
   Length of each line: _____ ft. _____ ft.
   _____ ft. _____ ft., _____ ft.
3. Trench dimensions: Width _____ ft.
   Slope _____ in/100 ft.
   Average depth _____ in
4. Filter material: _____
   Depth of material _____ in.
5. Distances to: Well or suction line _____ ft.
   Stream _____ ft.
   Pressure line _____ ft.
   Property line _____ ft.

Complete "As Built" drawing on back of this form.


Indicate North with Arrow

Individual Sewage System Design (Example)

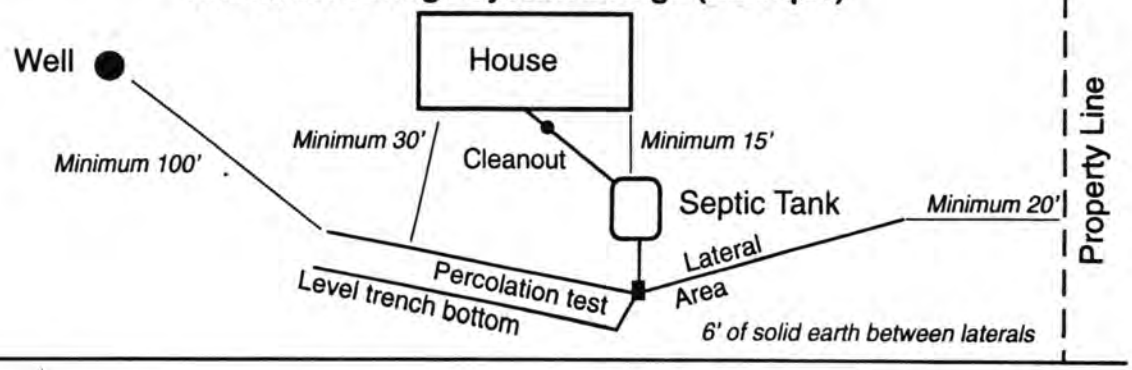


FORM 23-103 10-96

As Built Drawing

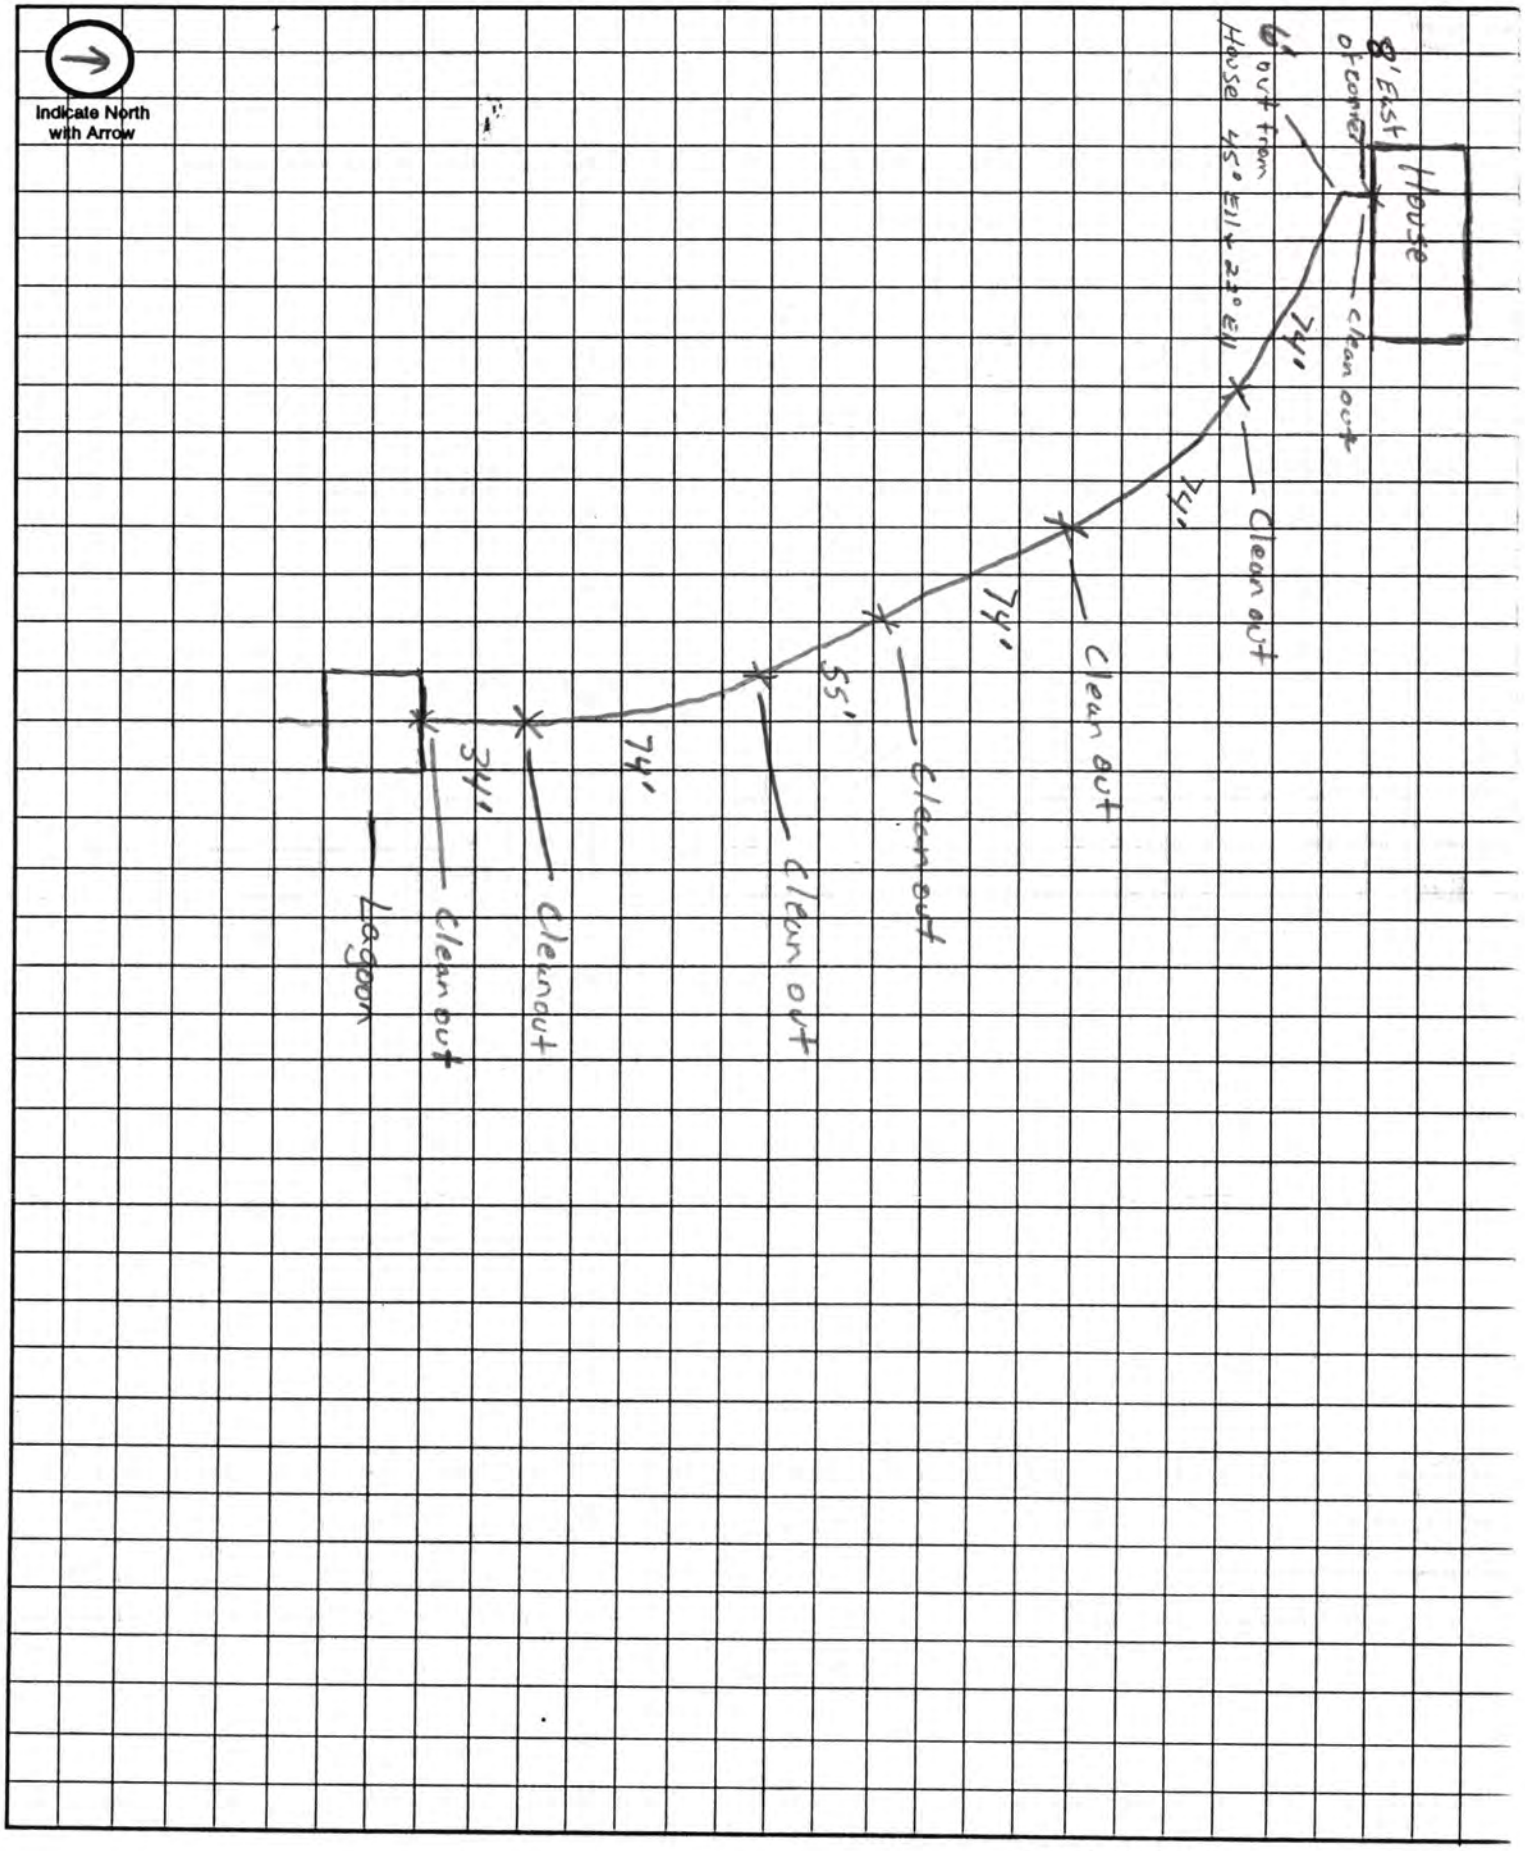

Approximate Scale: _____ ft. = _____ grid line/s

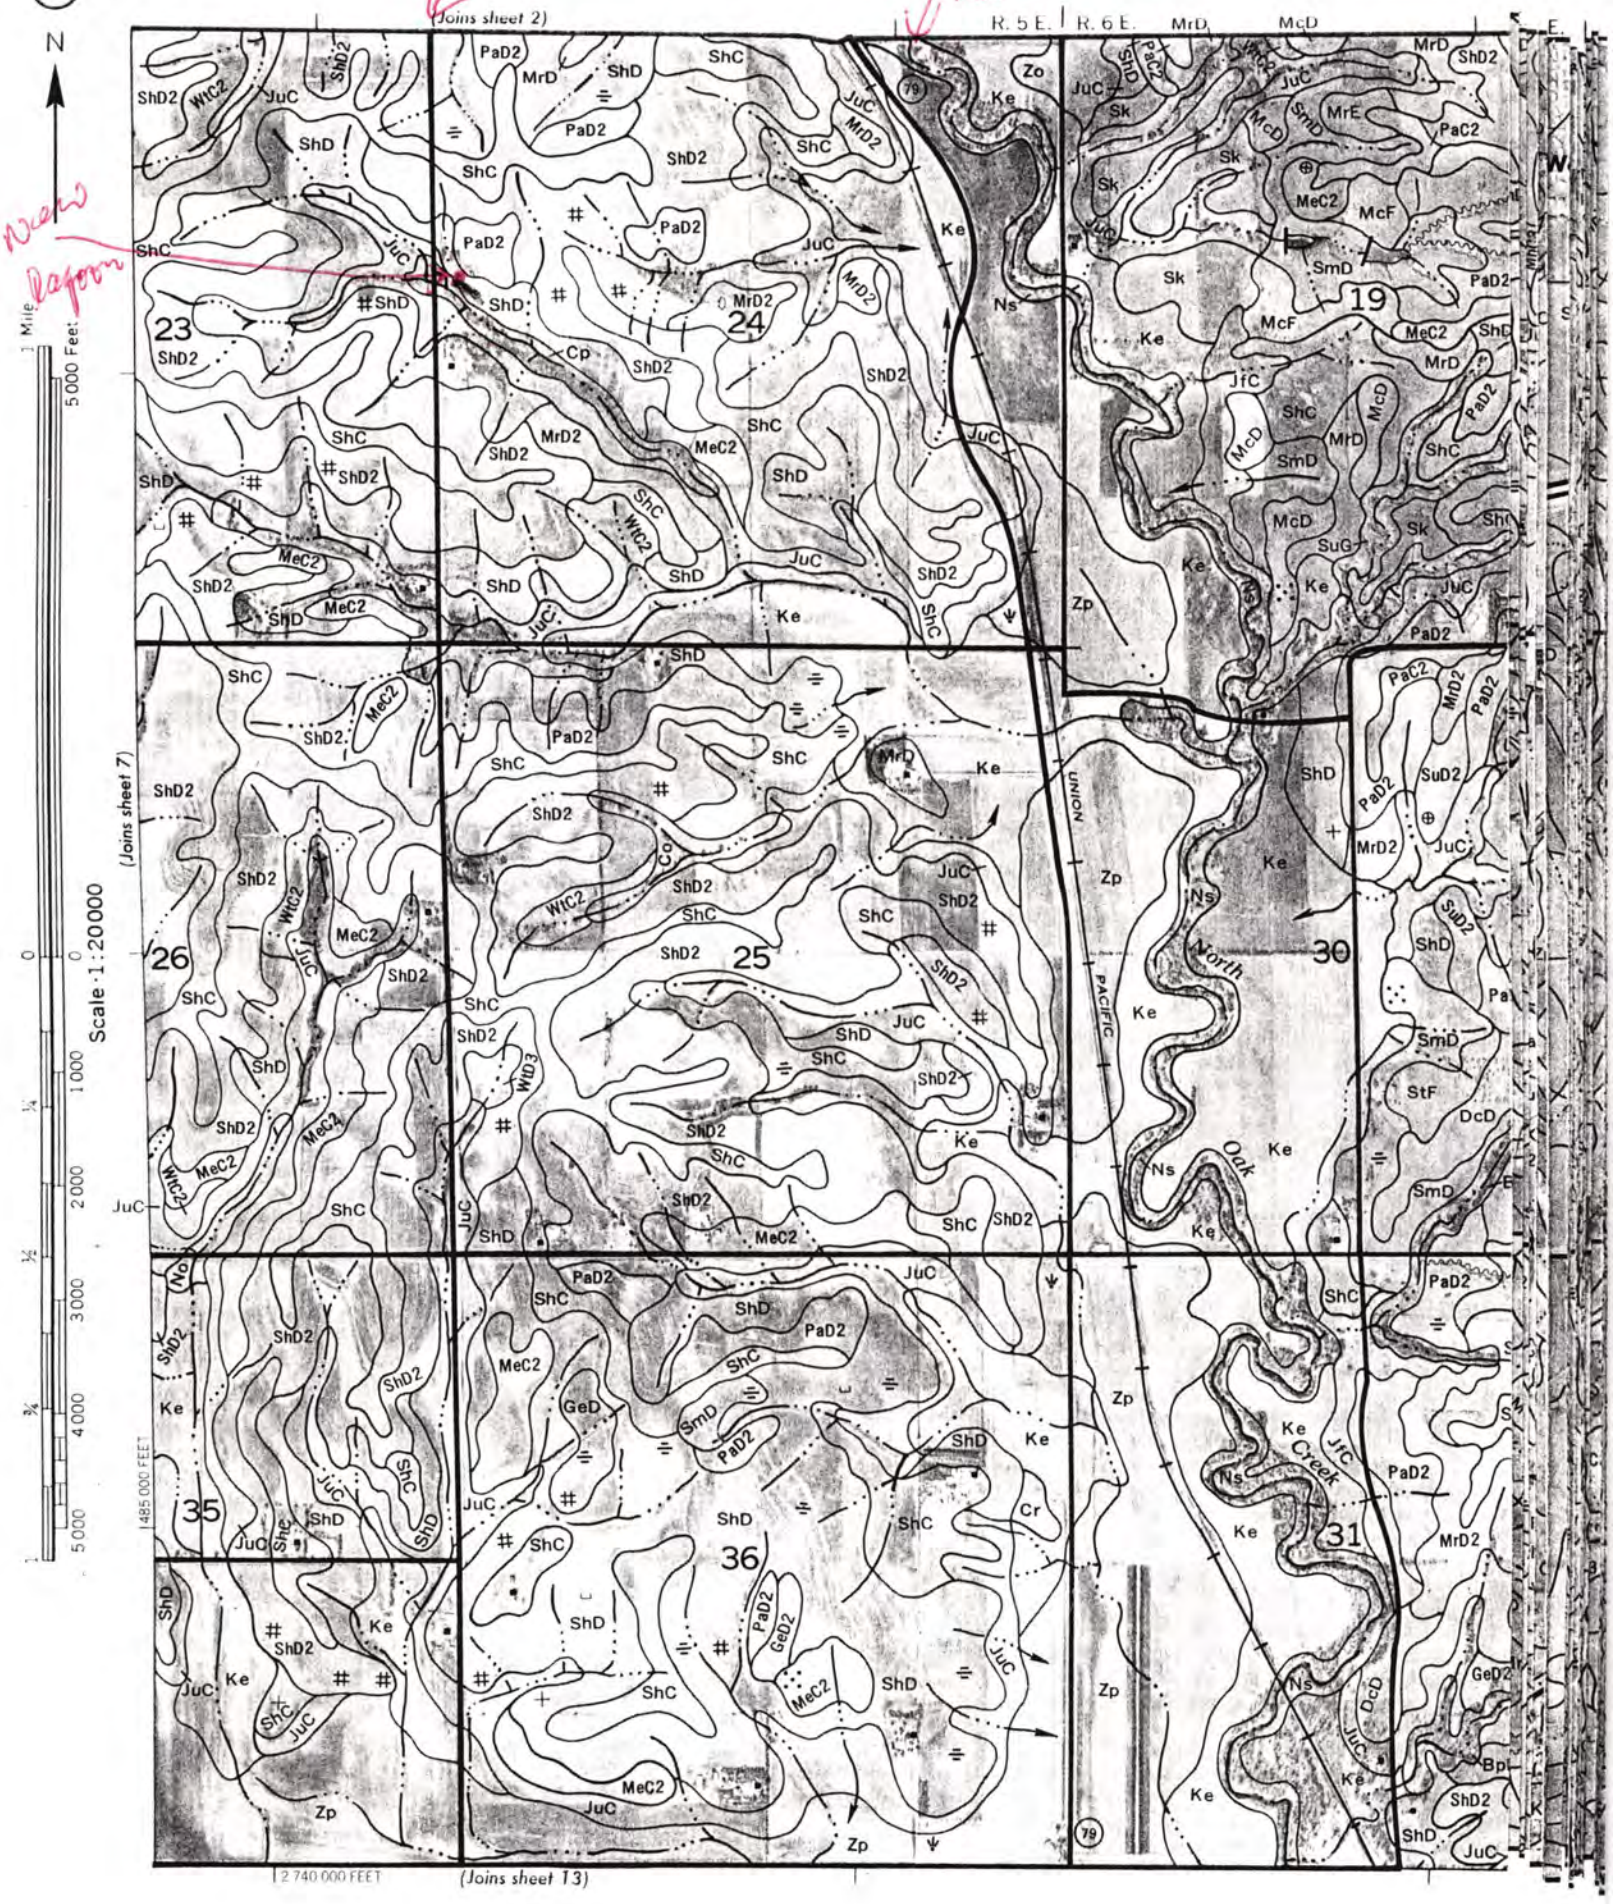
NW 204th
W. Rock Creek Rd
Near Lapsom
R. 5 E.
R. 6 E.
(Joins sheet 2)
(Joins sheet 7)
(Joins sheet 13)
UNION
PACIFIC
North
Oak
Creek
23
24
25
26
30
31
35
36
19
Scale 1:20000
1 Mile
5000 Feet
2 740 000 FEET
1 485 000 FEET