LINCOLN-LANCASTER COUNTY HEALTH DEPARTMENT

3140 "N" STREET
NON TRANSFERABLE

ENVIRONMENTAL HEALTH DIVISION
Lincoln, NE 68510-1514

(402) 441-8000

PERMIT

Permit

SEWAGE SYSTEM REPAIR

No. 96390052301

Issued 10/01/96
Expires 04/01/97
Revenue Code 18754

Establishment

KENNETH SEEMANN
T12N R5 SEC 26
LOT 3
17303 NW 70 STREET

FEES: $50.00

TOTAL $50.00

Permittee

KENNETH SEEMANN
RR0001
BOX 00023
RAYMOND NE 68428

2672

Issued By M. Jane Ford
Health Director

THIS LICENSE OR PERMIT IS ISSUED SUBJECT TO REVOCATION AS PROVIDED BY LAW "POST IN A PROMINENT PLACE"

SEP 16 1996

FORM HD-41(73) APPLICATION FOR PERMIT TO ALTER, EXTEND OR REPAIR INDIVIDUAL SEWAGE DISPOSAL SYSTEM

City Ordinance No. 9150 ☐

County Resolution No. 2832 ☒

Lincoln-Lancaster County HEALTH DEPARTMENT

3140 "N" STREET LINCOLN, NE 68510-1514

FILE NO. _____

TO: Division of Environmental Health
Lincoln-Lancaster County Health Dept.

DATE: 9-20-96

The undersigned hereby applies for a permit to ALTER ☒, EXTEND ☐, or REPAIR ☐ an existing Individual Sewage Disposal System, in conformance with appropriate Ordinance or Resolution, as described in this application and drawings attached hereto.

1. Legal description of property: Twp. 12 N ; Range 5 ; Section 26 ;
Block _____ ; Lot 3 I.T. ; Addition IN IRREGULAR TRACT IN N.E.¼ OF SEC 26 T 12 N, R 5 E of THE 6TH
Street Address 17303 NW 70TH N. Rowell Oaks Rd

2. Property Use: Residential _____ ☒; Commercial _____ ☐
No. Bedrooms 3 BEDROOM Describe _____

Other Use ☐
Describe _____

3. Type of existing Individual Sewage Disposal System: Septic Tank ☒; Other ☐

4. Description of proposed alteration, extension or repair: REPLACE SEPTIC TANK WITH NEW LATERAL

5. Work to be done by: Owner ☐ ; or Contractor ☒ , B + R PUMP SERV
Contractor's Name

6. Estimated cost of project:

a. Materials	$	2332 00
b. Labor	$	400 00
c. Other	$	8 75
TOTAL	$	2740 75

Kenneth W. Seemann
Signature of Applicant (owner or lessee)

RR-1 Box 23 Raymond, Nb 68428
Address

(Do not write below this line)

REVIEWING ACTION

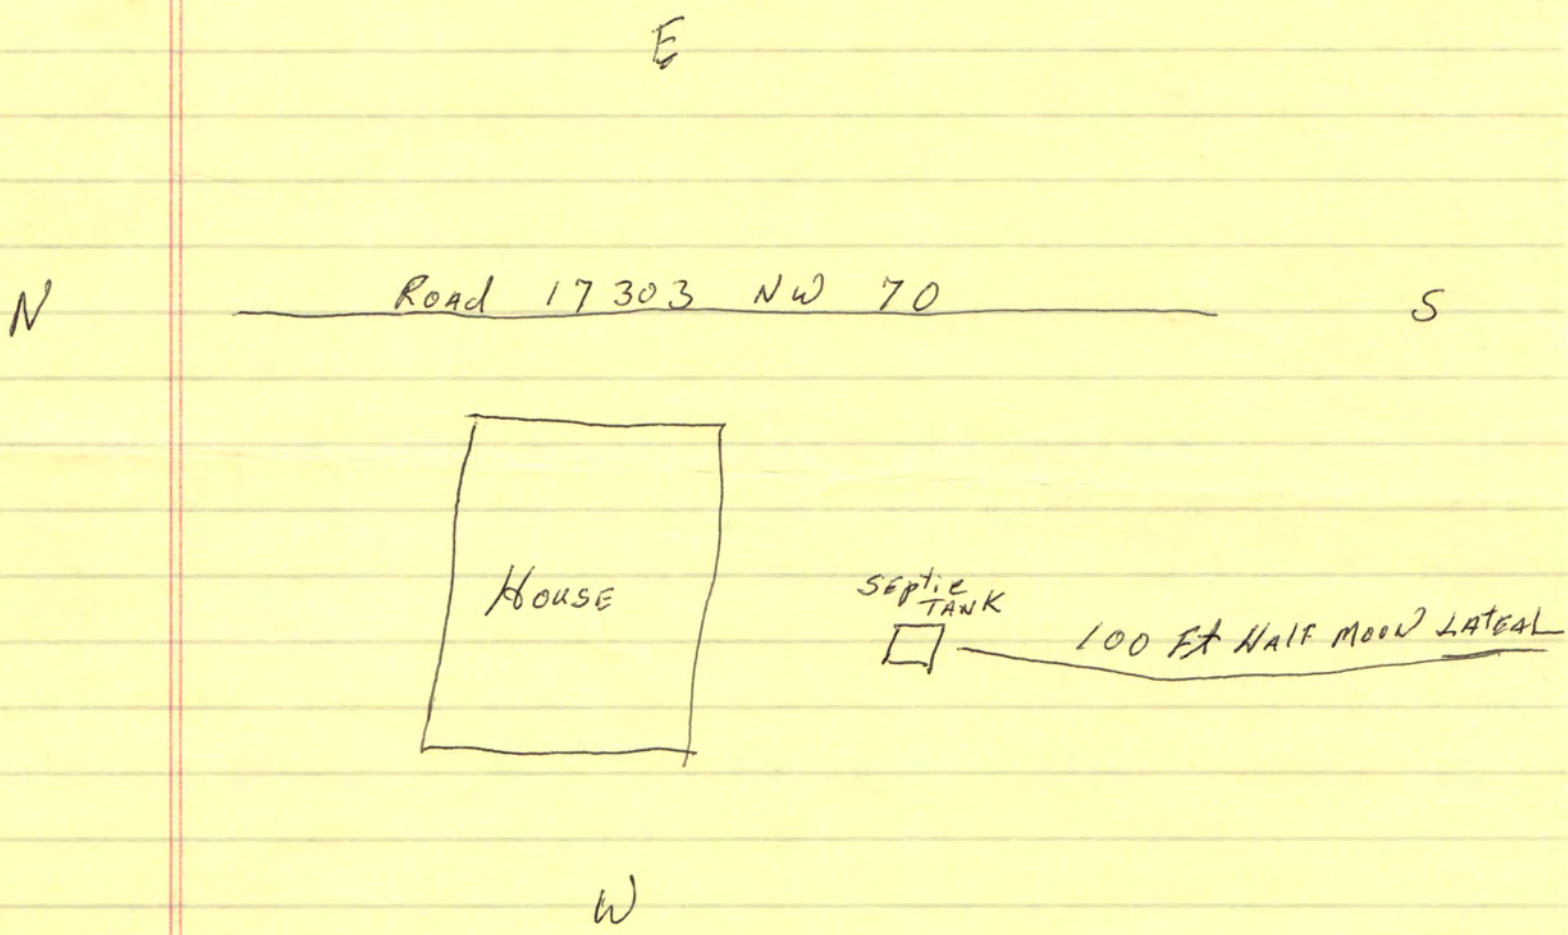
1. Date Rec'd: 9-20-96
Filing Fee: $ 150.00

2. Site Visits:
Date: 9-17-96 by: ms sewage running out south of house
Date: 10-25-96 by: ms need bracing
Date: _____ by: _____

3. Date: Approved ☒; Disapproved ☐
by: Ron Maynard

4. INSTALLATION FINAL WRITTEN APPROVAL
Date: 1-14-97 by: Ron Maynard

SEP 16 1996


E
N
Road 17303 NW 70
S
House
SEPTIC TANK
100 Ft HALF MOON LATERAL
W

FORM 20104-0477
PLANS & SPECIFICATIONS FOR SEWAGE DISPOSAL SYSTEM (Annex to Application)
City Ordinance No. 9150 ☐
County Resolution No. 2832 ☐

LINCOLN-LANCASTER COUNTY HEALTH DEPARTMENT
Division of Environmental Health
2200 St. Marys Avenue
Lincoln, Nebraska 68502
Phone: 471-7800

D

DATE: Ken Saeman

FILE NO. _____

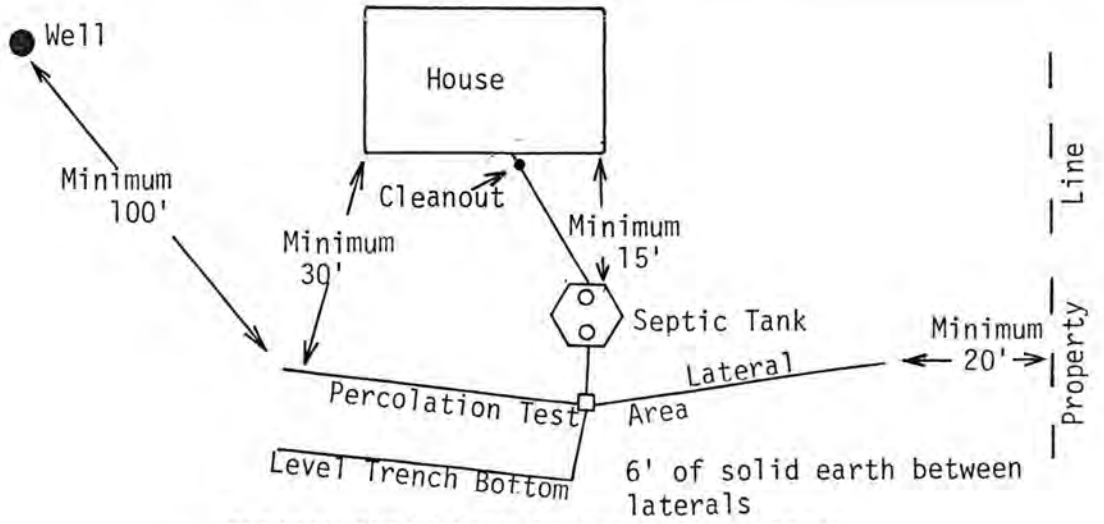
SPECIFICATIONS AS BUILT

A. BUILDING SEWER:
1. Material SOIL PIPE; Diameter 4" in.
2. Distance above basement floor _____ in., or below basement floor _____ in.
3. Distance between dwelling and septic tank 35 ft.
4. Number of clean-outs 0.
5. Distances to:
Well or Suction Line 100+ ft.; Stream _____ ft.; Pressure Line _____ ft.; Property Line _____ ft.

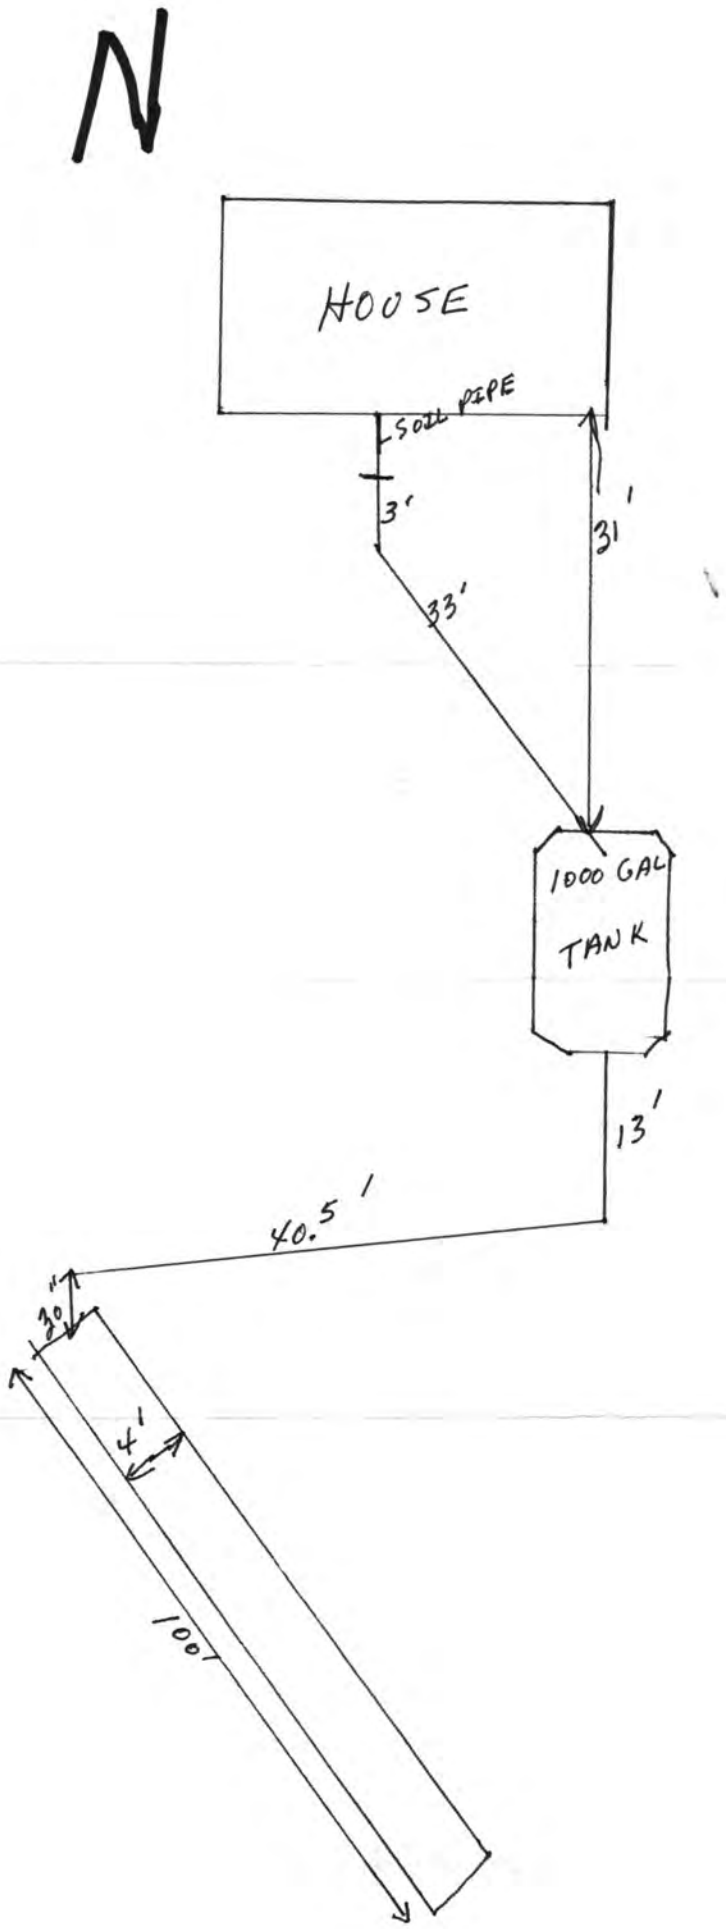
B. SEPTIC TANK:
1. Material CONCRETE; No. of compartments _____.
2. Capacity 1000 gals.;
3. Factory Built: Yes ☒ No ☐
(Company PRE-CAST)
4. Manholes: Over Inlet; diam. 6 in.
Over Outlet; diam. 6 in.
Riser Above ☒ Below ☐ Grade 4 in.
5. Inlet: Baffle ☒ ; or Tee ☐
6. Outlet: Baffle ☒ ; or Tee ☐
7. Depth of top of tank below finished grade 18 in.
8. Distances to:
Well or Suction Line 100+ ft.; Stream _____ ft.; Pressure Line 60+ ft.; Property Line 50 ft.

C. DISTRIBUTION BOX:
1. Material _____; Number - available outlets _____.
2. Factory Built: Yes ☐ No ☐
(Company _____)
3. Distance from Septic Tank _____ ft.

D. ABSORPTION FIELD: (Provide as built drawings on back of this form)
1. Type: Half Rounds ☒ Perforated Pipe ☐
Diameter of Half Round 4' LENGTH or Perforated Pipe _____.
Material: fiberglass ☐ ; plastic ☐ ; concrete ☒ ; other _____.
2. Lateral Lines:
Number 1 ; Length of each line 100, _____, _____, _____, _____ ft.;
Total length of laterals 100 ft.;
Distance between lateral lines _____ ft.
3. Trench dimensions: Width 4 ft.;
Slope 0 in/100 ft.; Average Depth 32 in.
4. Filter Material: ROAD GRAVEL
Depth of Material 22 in.
5. Distances to:
Well or Suction Line 100+ ft.; Stream _____ ft.; Pressure Line 90+ ft.; Property Line 40 ft.



TYPICAL INDIVIDUAL SEWAGE SYSTEM DESIGN


N
HOUSE
SOIL PIPE
3'
31'
33'
1000 GAL
TANK
13'
40.5'
30
4'
100'


8
N
(Joins sheet 2)
R 5 E
R 6 E
MrD
McD
(Joins sheet 7)
Scale 1:20000
5000 Feet
1000
2000
3000
4000
5000
485 000 FEET
2 740 000 FEET
(Joins sheet 13)
23
24
25
26
30
31
35
36
19
79
North
Oak
Creek
UNION
PACIFIC
ShD2
ShC
JuC
PaD2
MrD2
MeC2
Ke
Zp
Ns
Sk
McF
McD
SmD
JtC
Cp
Co
Cr
MrD
ShD
PaC2
MeC2
SuD2
StF
DcD
GeD2
Bp