LINCOLN-LANCASTER COUNTY HEALTH DEPARTMENT

ENVIRONMENTAL HEALTH DIVISION

3140 "N" STREET
Lincoln, NE 68510-1514
(402) 441-8000

NON TRANSFERABLE

PERMIT

Permit
SEWAGE INSTALLATION

No. 96380147101

Issued 08/12/96
Expires 02/12/97
Revenue Code 18754

Establishment
ROBERT CADEK
T12N R5E SEC 14

FEES: $150.00

TOTAL $150.00

Permittee
ROBERT CADEK
8000 W ROCK CREEK RD
RAYMOND NE 68428

Issued By M. Jane Ford
Health Director

2448

THIS LICENSE OR PERMIT IS ISSUED SUBJECT TO REVOCATION AS PROVIDED BY LAW "POST IN A PROMINENT PLACE"

FORM 20103-0477
REQUEST FOR SITE CLEARANCE AND PERMIT
FOR INDIVIDUAL SEWAGE DISPOSAL SYSTEM
City Ordinance No. 9150 ☐
County Resolution No. 2832 ☒

LINCOLN-LANCASTER COUNTY HEALTH DEPARTMENT
Division of Environmental Health
3140 N Street
Lincoln NE 68510
(402)-441-8022

A

FILING FEE: $ 150.00

FILE NO. _____

DATE: _____

The undersigned hereby requests SITE CLEARANCE and PERMIT to construct an Individual Sewage Disposal System in conformance with appropriate resolution or ordinance, as described herein:

1. Legal description of property: Twp. 12N ; Range 5E ; Section 14 ; SEE ATTACHED
   Block _____ : Lot _____ : Addition _____
   Street Address _____

2. Property Use: Residential ☒ ; Commercial ☐ Other Use ☐
   No. of Bedrooms 3 . Describe RANCH

3. Type of Individual Sewage Disposal System: Septic Tank ☒ ; Other ☐

4. Distance to public sewer: _____ ft.

Robert J Cooke
Signature of Applicant (Owner or Lessee)

8000 D Rock Creek Rd.
Address
Raymond NE 68428

(Do not write below this double line)

1. Health Department: Date Rec'd. 8/12/96. Date Frwd. 8/12/96. ACTION: Approved ☒ Disapproved ☐ Signature: Jerrold C. Hood

2. Supt. Bldg. Insp.: or Village Clerk Date Rec'd. 8/12/96. Date Frwd. 8/12/96. ACTION: Approved ☒ Disapproved ☐ Signature: _____

3. City or County Engineer: Date Rec'd. 08/12/96. Date Frwd. _____. ACTION: Approved ☐ Disapproved ☐ Signature: _____

REMARKS OR REASONS FOR DISAPPROVAL _____

Site Visits:
Date: 8-15-96 by: _____
Date: _____ by: _____
Date: _____ by: _____

INSTALLATION FINAL WRITTEN APPROVAL
Date: 8-15-96 By: Ron Morgan

White: Health Dept. Copy
Yellow: Engineers Copy
Pink: Bldg. Inspector's Copy

FORM 23-43

FORM 20105-0477
SOIL ABSORPTION TEST DATA REPORT
(Annex to Application)
(Reference: City Ordinance No. 9150 and County Resolution No. 2832)

LINCOLN-LANCASTER COUNTY HEALTH DEPARTMENT
Division of Environmental Health
3140 N Street
Lincoln NE 68510
(402)-441-8022

B

FILE NO. _____

MAP #1 ON SOIL SURVEY

PROPERTY WHERE SOIL TESTED:

Location: Township 12 N ; Range 5E ; Section & ¼ Section 14 .
Property Dimensions: _____ ft. x _____ ft. Area: 20.73 acres. (Attach Sheet C with sketch of property).

Soil Type: Silty Clay ☐ ; Silty Clay Loam ☐ ; Sandy Loam ☐ ; Silt Loam ☐ ; Clay Loam ☐ .

Dates of Tests: 8/10 to 8/11 . Weather: Precip. .10 Temp. 75 .

OWNER: ROBERT + DAWN CREEK
Address: 8000 W Rock Creek Rd. RAYMOND NE 68428

PERCOLATION TEST DATA TABLE

a.	b.	c.	d.	e.	f.	g.	h.	i.	j.	k.	l.	m.	n.
		Pre-Saturation Period				Percolation Readings						Results	
		Start		End		Start			End				
Hold No.	Hole Depth (in.)	Date (Mo./ Day)	Time (Hr./ Min.)	Date (Mo./ Day)	Time (Hr./ Min.)	Date (Mo./ Day)	Time (Hr./ Min.)	Water Level (in.)	Time (Hr./ Day)	Water Level (in.)	Elapsed Time (Min.)	Water Level Drop (in.)	Percolation Rates (Min./in.)
1	36	8/10	11:00	8/10	3:00	8/11	3:00	6"	8/11 3:00	5/8 6 3/4	30	5/8	48MIN/IN
2										7/8 6 1/4		7/8	34MIN/IN
3										5/8 7 1/2		5/8	48MIN/IN
4										5/8 7 3/4		5/8	48MIN/IN
5										3/4 8		3/4	40MIN/IN
6										1 8 3/4		1	30MIN/IN

Robert J Creek
Signature of Person Conducting Test

Sum of Percolation Rates: _____
Average of Rates: _____
Mean of Rates: _____

Address 8000 W Rock creek Rd Phone 784-2098

(Do not write below this line)

REVIEWING ACTION

Remarks: _____
Soil Type (SCS): Sharpsburg Silty clay Loam
Date: AUGUST 12, 1996

Approved Percolation Rate (a)
A. 41 min./inch
B. _____ min./inch
C. _____ min./inch

Jerrold C. Hoop
Signature of Reviewing Official

FORM 20102-0477
PRELIMINARY PLANS & SPECIFICATIONS FOR SEWAGE DISPOSAL SYSTEM (Annex to Application)
City Ordinance No. 9150 ☐
County Resolution No. 2832 ☐


LINCOLN-LANCASTER COUNTY HEALTH DEPARTMENT
Division of Environmental Health
3140 N Street
Lincoln NE 68510
(402)-441-8022

C

Sketch of property showing Percolation Test hole locations, well, residence, direction and property line.

FILE NO._____

Indicate on sketch if residence and well are exisiting or proposed.

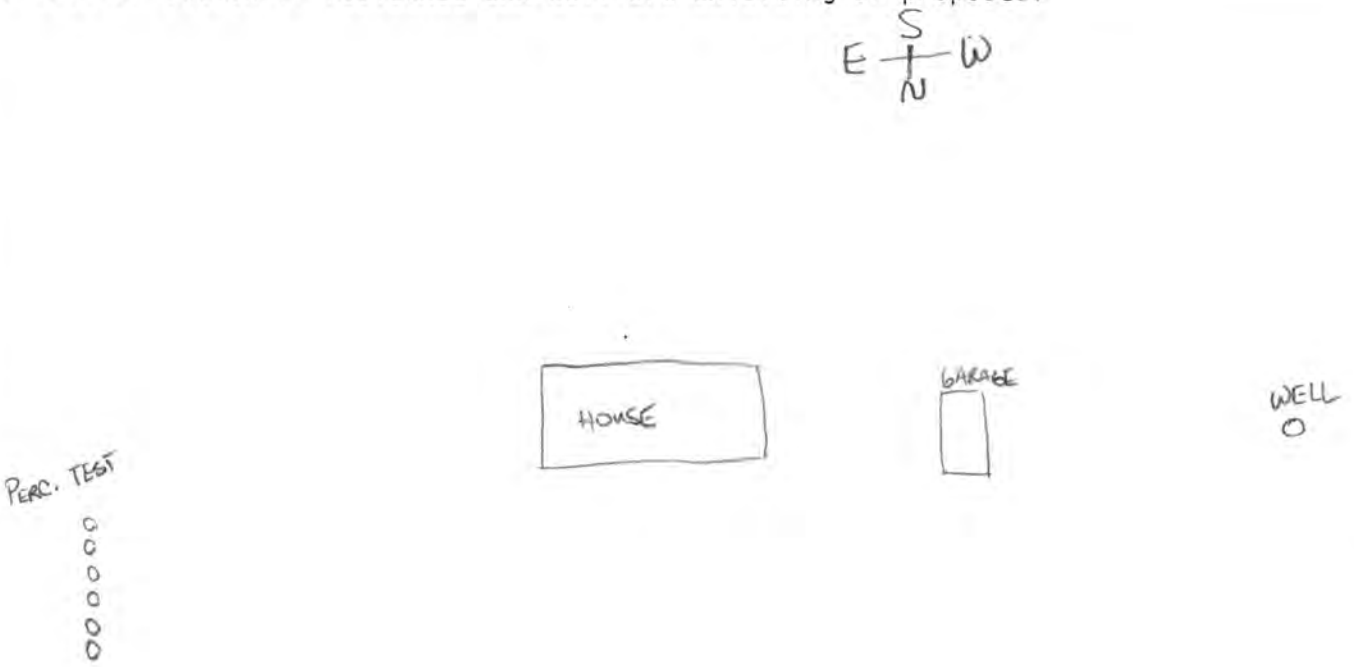

REVIEWING ACTION

Remarks :_____

Date: AUGUST 12, 1996

Minimum Design Requirement
1. Capacity of Septic Tank 1000 gals.
2. Total Length of Laterals_____ ft.
3. With a Trench Width of_____ in.
4. Total Area of Lateral needed 870 sq.ft.

Jerrold C. Hood
Signature of Reviewing Official

Robert Cadek

FORM 20104-0477
PLANS & SPECIFICATIONS FOR SEWAGE DISPOSAL SYSTEM (Annex to Application)
City Ordinance No. 9150 ☐
County Resolution No. 2832 ☐

Lincoln-Lancaster County Health Dept.
3140 "N" Street
Lincoln, NE 68510

D

DATE: 8/14/96

FILE NO: _____


SPECIFICATIONS AS BUILT

A. BUILDING SEWER: (2241)
1. Material PVC; Diameter 4" in.
2. Distance above basement floor NA in., or below basement floor 10" in.
3. Distance between dwelling and septic tank 119 ft.
4. Number of clean-outs 1.
5. Distances to:
Well or Suction Line 200+ ft.; Stream NA ft.; Pressure Line NA ft.; Property Line 100+ ft.

B. SEPTIC TANK:
1. Material CONCRETE; No. of compartments 1.
2. Capacity 1,000 gals.;
3. Factory Built: Yes ☒ No ☐
(Company AMERICAN CONC. PRO.)
4. Manholes: Over Inlet; diam. 24 in.
Over Outlet; diam. 8 in.
Riser Above ☐ Below ☒ Grade 2 in.
5. Inlet: Baffle ☒ ; or Tee ☐
6. Outlet: Baffle ☒ ; or Tee ☐
7. Depth of top of tank below finished grade 26 in.
8. Distances to:
Well or Suction Line 200+ ft.; Stream NA ft.; Pressure Line NA ft.; Property Line 100+ ft.


C. DISTRIBUTION BOX:
1. Material CONCRETE; Number available outlets 5.
2. Factory Built: Yes ☒ No ☐
(Company AMERICAN CONC. PROD.)
3. Distance from Septic Tank 26 ft.

D. ABSORPTION FIELD: (Provide as built drawings on back of this form)
1. Type: Half Rounds ☐ Perforated Pipe ☒
Diameter of Half Round _____ or Perforated Pipe 4".
Material: fiberglass ☐ ; plastic ☒ ; concrete ☐ ; other _____.
2. Lateral Lines:
Number 3 ; Length of each line 100, 100, 100, _____, _____ ft.;
Total length of laterals 300 ft.;
Distance between lateral lines _____ ft.
3. Trench dimensions: Width 3 ft.;
Slope 1 in/100 ft.; Average Depth 36 in.
4. Filter Material: PEA GRAVEL
Depth of Material 18 in.
5. Distances to:
Well or Suction Line 200+ ft.; Stream NA ft.; Pressure Line NA ft.; Property Line 100+ ft.

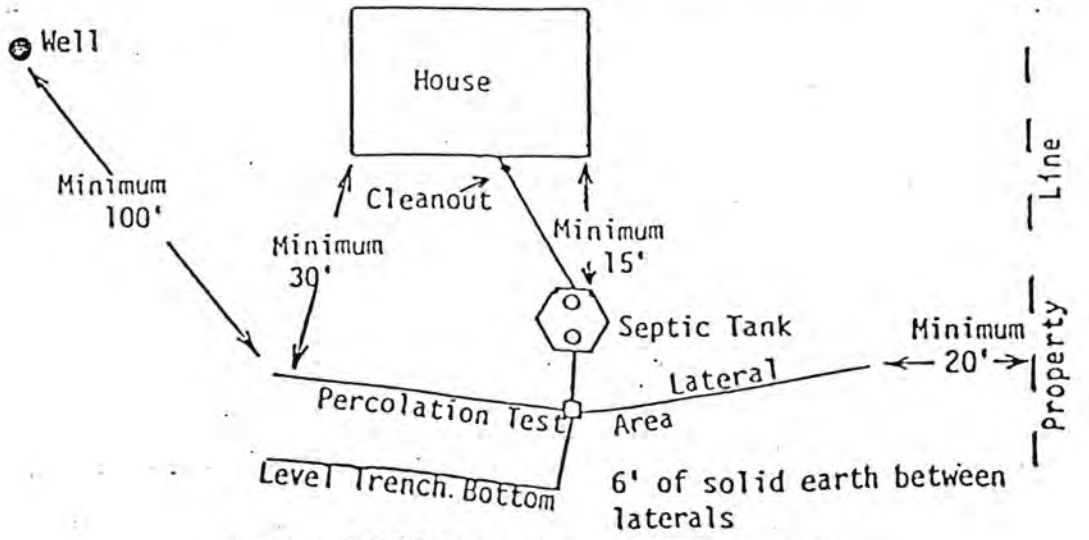

TYPICAL INDIVIDUAL SEWAGE SYSTEM DESIGN

1,000 GAL SEPTIC TANK AMERICAN CONC. PRO
JUNCTION BOX " " "
24" RISER AND LID " " "
900 SQ FT LATERALS

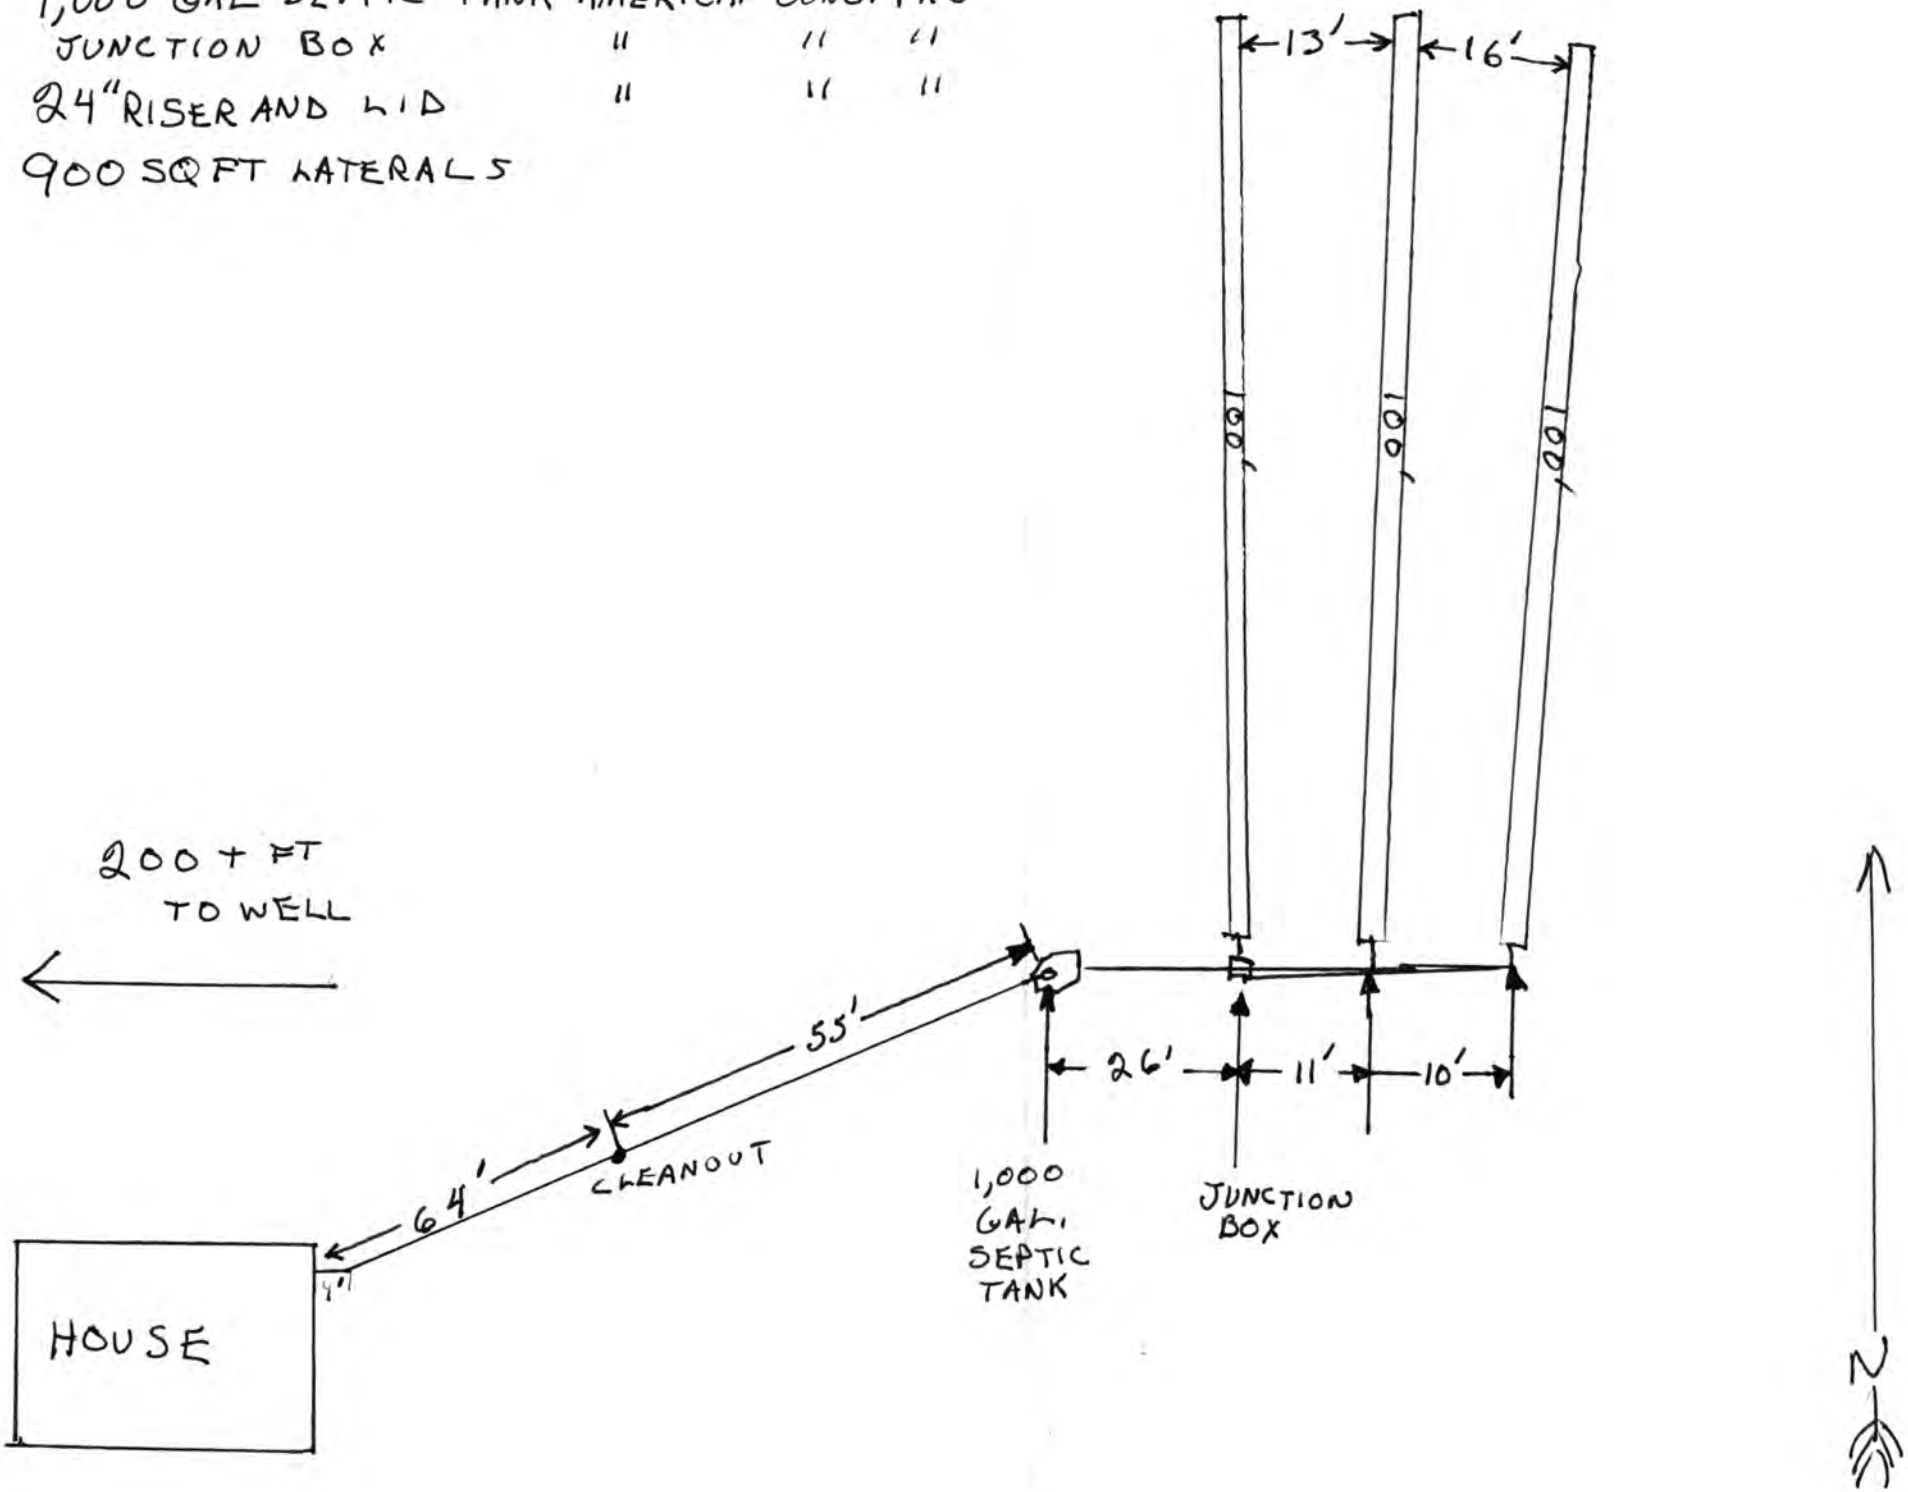

Plot Plan

For Loan Purposes Only

LANCASTER County, Nebraska

ALLIED SURVEYING AND MAPPING, INC.
LAND SURVEYORS
4830 South 44th Street - Lincoln, Nebraska 68516

Phone 483-5008


8000 West Rock Creek Road

Section 14 T 12 N, R 5 E of the 6th P.M.

Job No. 11196

September, 1989

Buyer/Cadek 89-9164

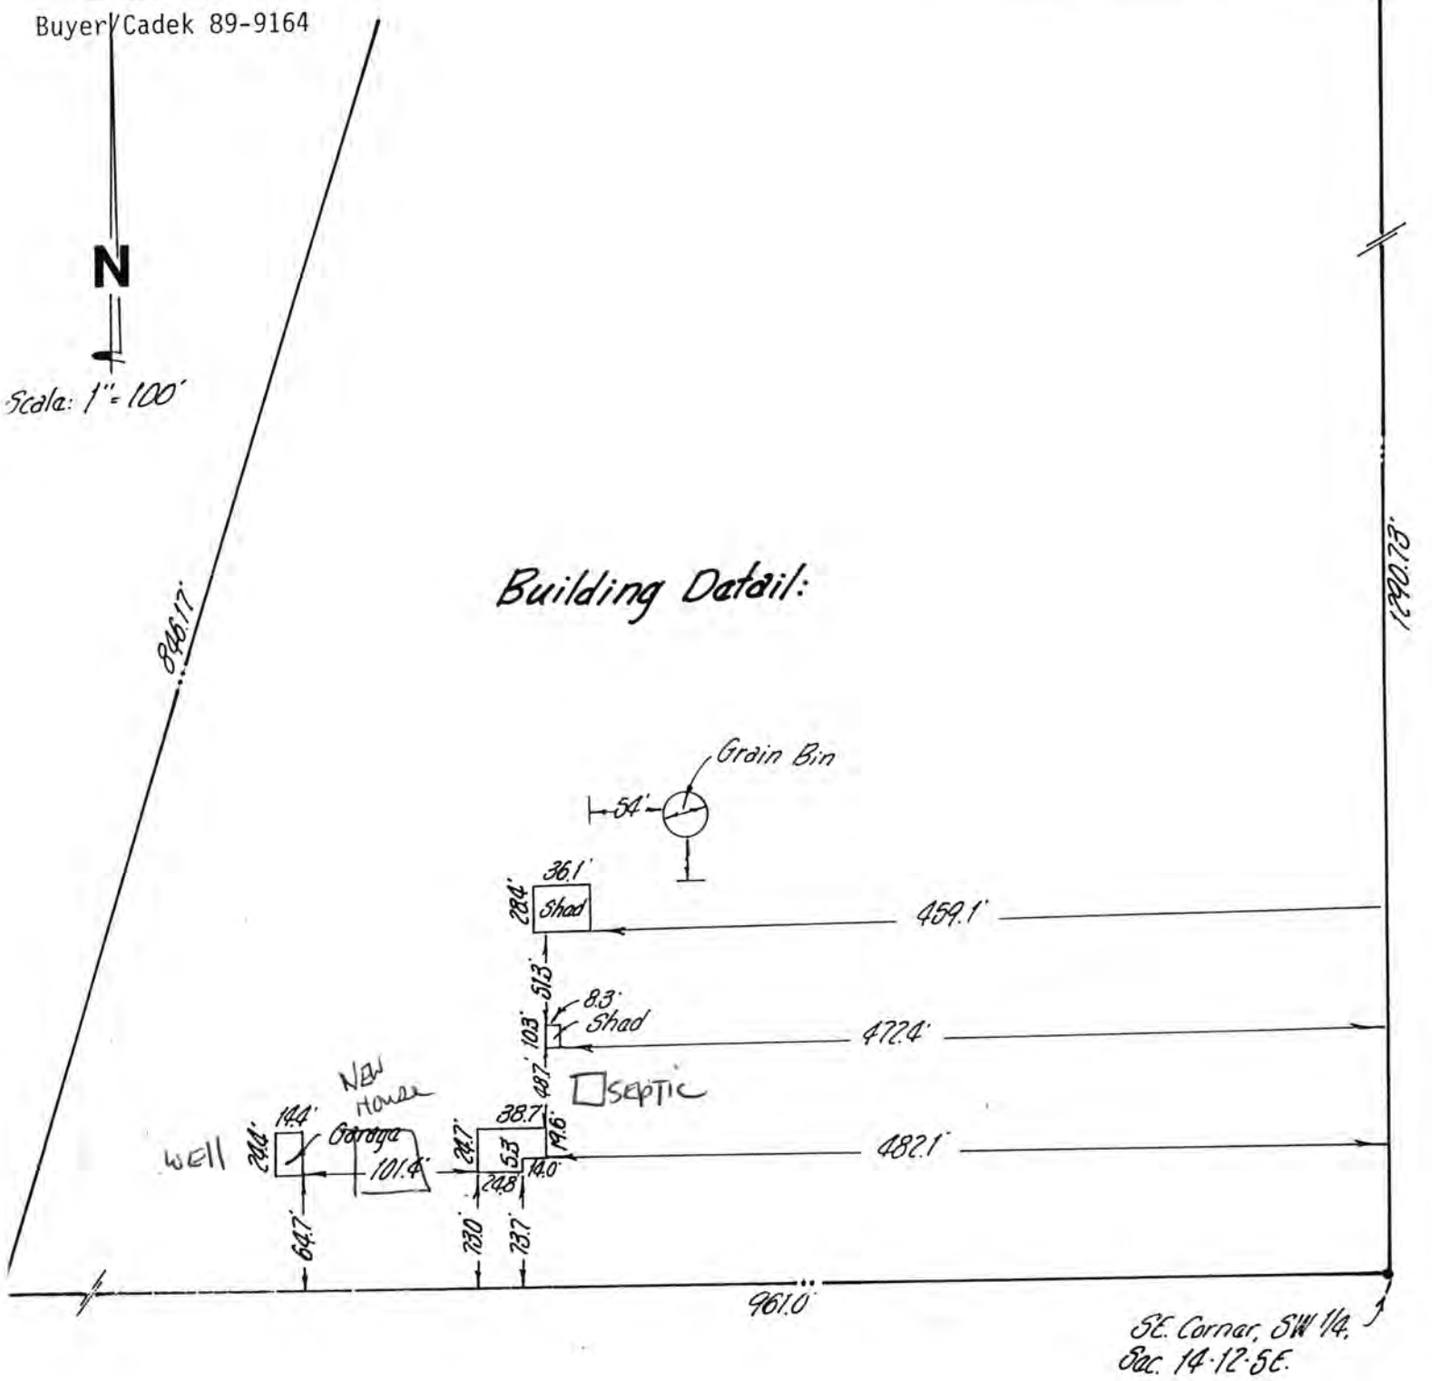


LOCATION VERIFICATION

This inspection and the accompanying plat are true and correct to the best of our knowledge and belief and were prepared for mortgage title insurance only. This does not constitute a boundary survey and is subject to any inaccuracies that a subsequent boundary survey may disclose; no property corners were set, and is not to be used or relied upon for the establishment of any fence, structure or other improvements.

NEBRASKA REGISTERED LAND SURVEYOR KERRY W. SIMONDS

Kerry W. Simonds, Date September 7, 1989

KERRY W. SIMONDS L.S. 333

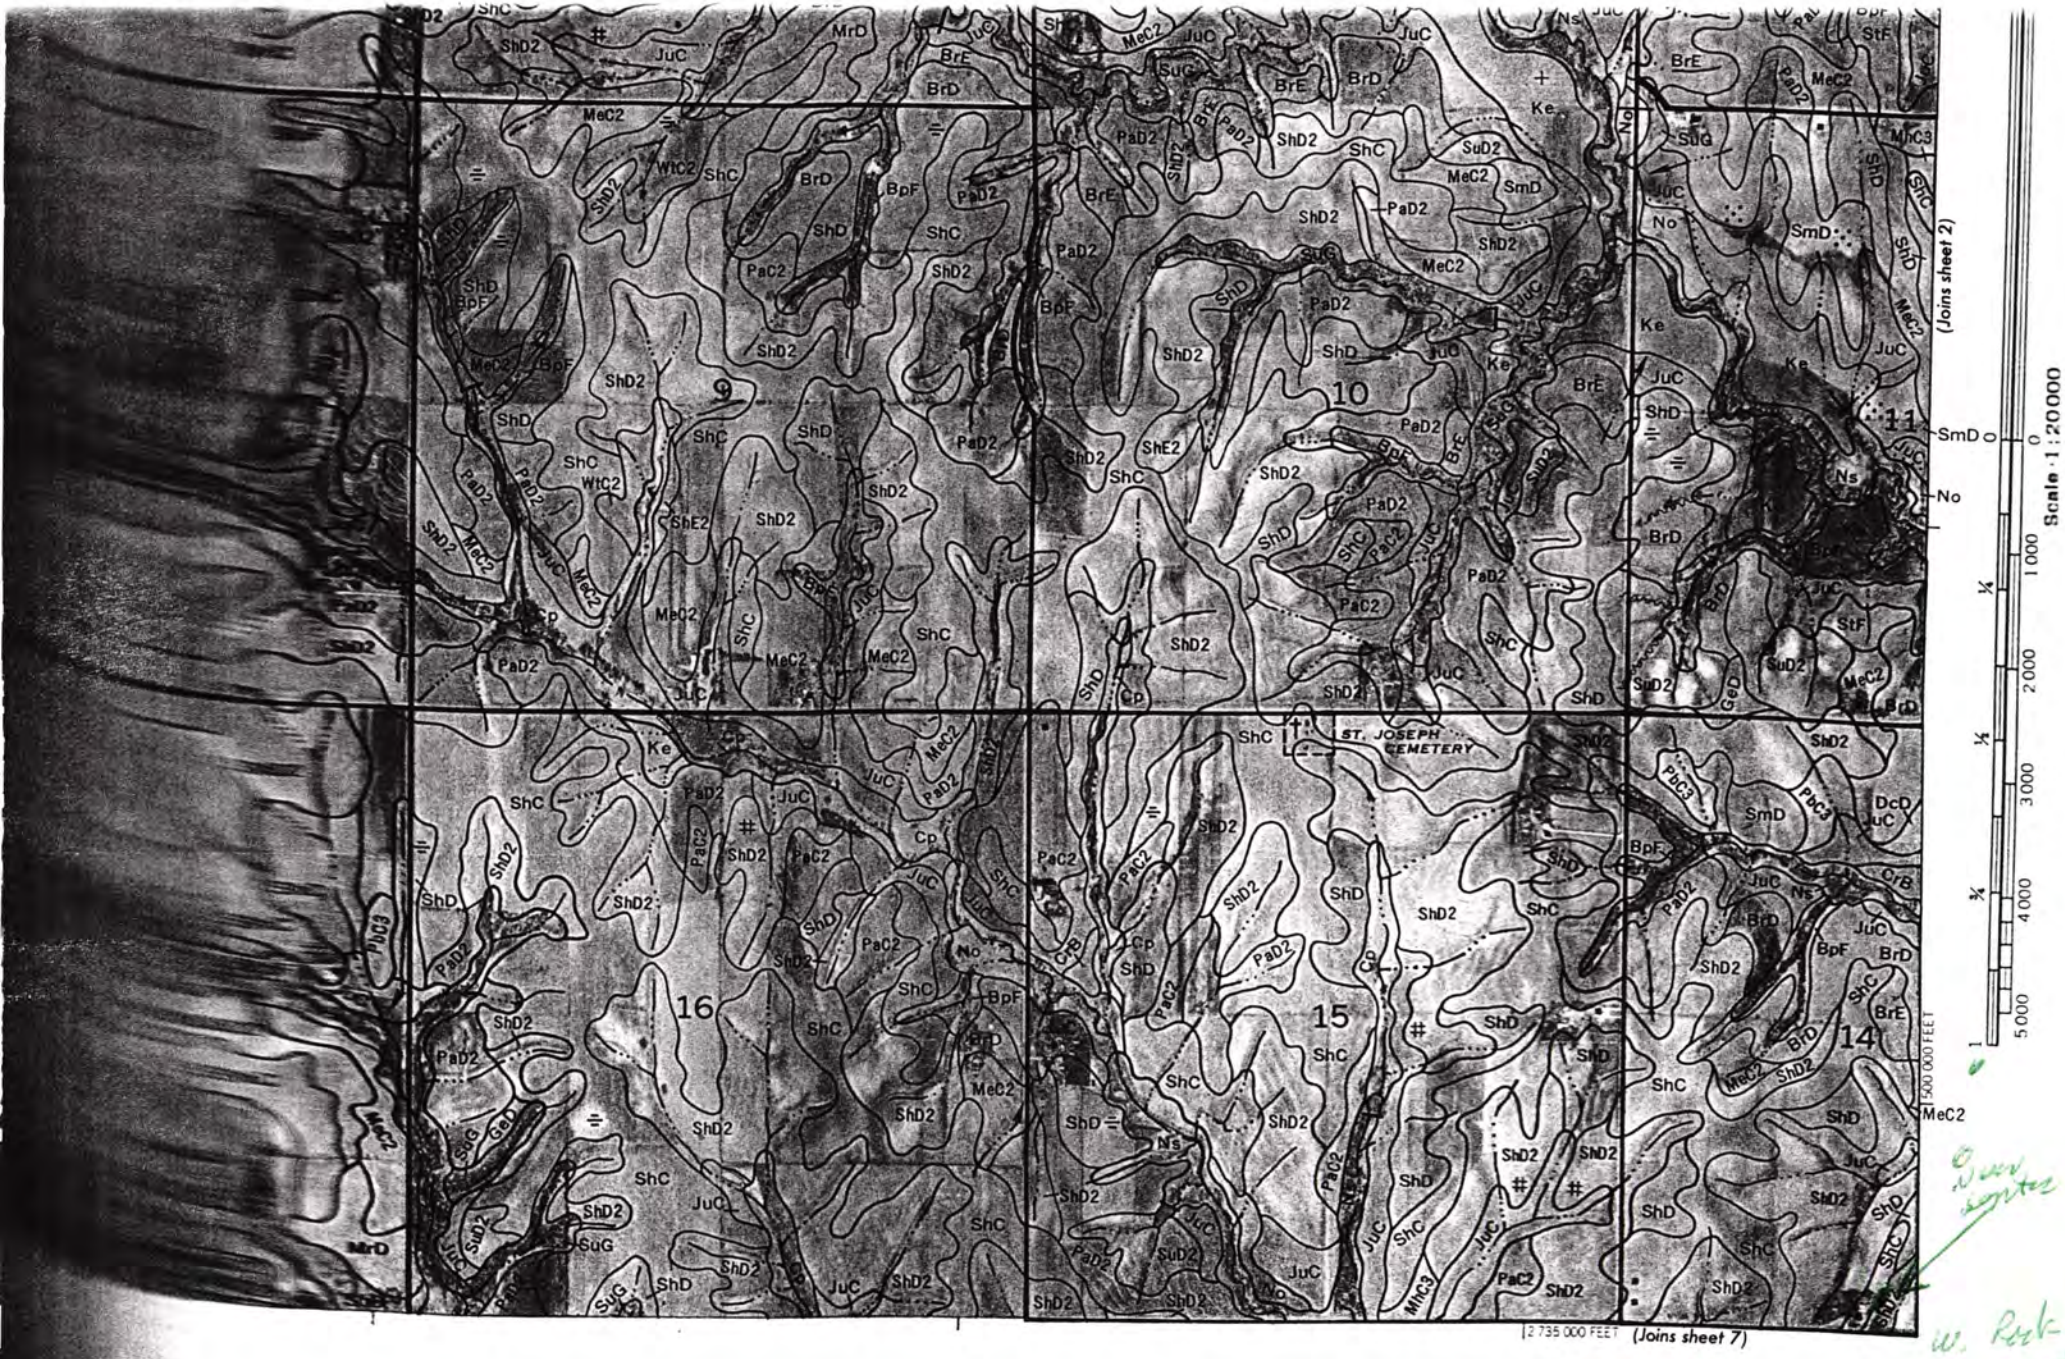
9
10
11
16
15
14
ST. JOSEPH CEMETERY
(Joins sheet 2)
(Joins sheet 7)
2 735 000 FEET
1 500 000 FEET
Scale 1:20000
W. Rock Creek