LINCOLN-LANCASTER COUNTY HEALTH DEPARTMENT

ENVIRONMENTAL HEALTH DIVISION

3140 "N" STREET Lincoln, NE 68510-1514 (402) 441-8000

NON TRANSFERABLE

PERMIT

Permit
SEWAGE INSTALLATION

No. 94380125101

Issued 11/18/94
Expires 05/18/95
Revenue Code 18754

Establishment
JOHN LOMIER
T10N R5E SEC 30
LOT 39

FEES: $150.00

TOTAL $150.00

Permittee
JOHN LOMIER
4810 W CLAIRE AV
LINCOLN NE 68523

Issued By M. Jane Ford
Health Director

THIS LICENSE OR PERMIT IS ISSUED SUBJECT TO REVOCATION AS PROVIDED BY LAW "POST IN A PROMINENT PLACE"

FORM 20103-0477
REQUEST FOR SITE CLEARANCE AND PERMIT
FOR INDIVIDUAL SEWAGE DISPOSAL SYSTEM
City Ordinance No. 915 ☐
County Resolution No. 2832 ☒

LINCOLN-LANCASTER COUNTY HEALTH DEPARTMENT
Division of Environmental Health
2200 St. Mary's Avenue
Lincoln, Nebraska 68502
Phone: 471-7800

A

FILING FEE: $ 150.00

FILE NO. _____

DATE: 18 NOV 1994

The undersigned hereby requests SITE CLEARANCE and PERMIT to construct an Individual Sewage Disposal System in conformance with appropriate resolution or ordinance, as described herein:

1. Legal description of property: Twp. 10N ; Range 5E ; Section 30 ;
   Block _____ : Lot 39 I.T. : Addition _____
   Street Address _____

2. Property Use: Residential ☒ ; Commercial ☐ Other Use ☐
   No. of Bedrooms 1 . Describe _____

3. Type of Individual Sewage Disposal System: Septic Tank ☐ ; Other ☒ LAGOON

4. Distance to public sewer: _____ ft.

JOHN LOMIER by Melvin Hagen
Signature of Applicant (Owner or Lessee)

4810 WEST CLAIRE
Address LINCOLN 68523

(Do not write below this double line)

1. Health Department: Date Rec'd. 11/18/94 . Date Frwd. 11/18/94 . ACTION: Approved ☒ Disapproved ☐ Signature: Jerrold C. Nord

2. Supt. Bldg. Insp.: or Village Clerk: Date Rec'd. 11/18/94 . Date Frwd. 11/18/94 . ACTION: Approved ☒ Disapproved ☐ Signature: Gary Lyon

3. City or County Engineer: Date Rec'd. 11/18/94 . Date Frwd. _____ . ACTION: Approved ☒ Disapproved ☐ Signature: Thomas Cajka

REMARKS OR REASONS FOR DISAPPROVAL _____

Site Visits:
Date: 3-29-95 by: P.D. need fence, gate signs, drawing
Date: 6-26-95 by: P.D. Bottom of gate 4" from ground
Date: _____ by: _____

INSTALLATION FINAL WRITTEN APPROVAL
Date: 7-12-95 By: Thomas Cajka

White: Health Dept. Copy
Yellow: Engineers Copy
Pink: Bldg. Inspector's Copy

FORM 23-43

FORM 20104-0477
PLANS & SPECIFICATIONS FOR SEWAGE DISPOSAL SYSTEM (Annex to Application)
City Ordinance No. 9150 ☐
County Resolution No. 2832 ☐

LINCOLN-LANCASTER COUNTY HEALTH DEPARTMENT
Division of Environmental Health
2200 St. Marys Avenue
Lincoln, Nebraska 68502
Phone: 471-7800

D

DATE: 6-26-96

FILE NO. _____


SPECIFICATIONS AS BUILT

A. BUILDING SEWER:
1. Material C PVC; Diameter 4 in.
2. Distance above basement floor _____ in., or below basement floor _____ in.
3. Distance between dwelling and septic tank _____ ft.
4. Number of clean-outs 3.
5. Distances to:
Well or Suction Line _____ ft.; Stream _____ ft.; Pressure Line _____ ft.; Property Line _____ ft.


B. SEPTIC TANK:
1. Material _____; No. of compartments _____.
2. Capacity _____ Gals.;
3. Factory Built: Yes ☐ No ☐ (Company _____)
4. Manholes: Over Inlet; diam. _____ in.
Over Outlet; diam. _____ in.
Riser Above ☐ Below ☐ Grade _____ in.
5. Inlet: Baffle ☐ ; or Tee ☐
6. Outlet: Baffle ☐ ; or Tee ☐
7. Depth of top of tank below finished grade _____ in.
8. Distances to:
Well or Suction Line _____ ft.; Stream _____ ft.; Pressure Line _____ ft.; Property Line _____ ft.

C. DISTRIBUTION BOX:
1. Material _____; Number - available outlets _____.
2. Factory Built: Yes ☐ No ☐ (Company _____)
3. Distance from Septic Tank _____ ft.

D. ABSORPTION FIELD: (Provide as built drawings on back of this form)
1. Type: Half Rounds ☐ Perforated Pipe ☐
Diameter of Half Round _____ or Perforated Pipe _____.
Material: fiberglass ☐ ; plastic ☐ ; concrete ☐ ; other _____.
2. Lateral Lines:
Number ___ ; Length of each line _____, _____, _____, _____, _____ ft.;
Total length of laterals _____ ft.;
Distance between lateral lines _____ ft.
3. Trench dimensions: Width _____ ft.;
Slope _____ in/100 ft.; Average Depth _____ in.
4. Filter Material: _____
Depth of Material _____ in.
5. Distances to:
Well or Suction Line _____ ft.; Stream _____ ft.; Pressure Line _____ ft.; Property Line _____ ft.

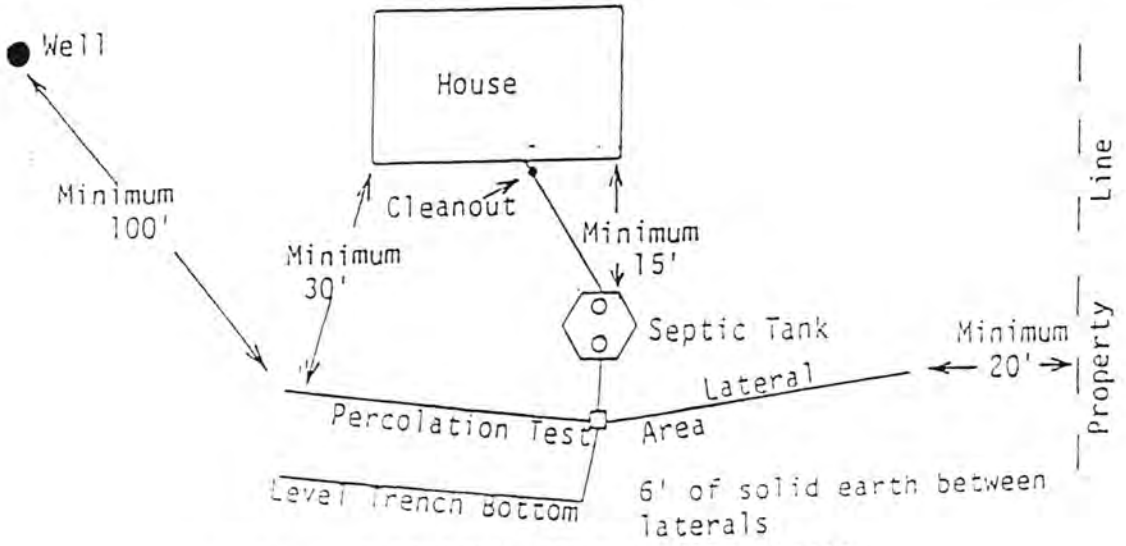


TYPICAL INDIVIDUAL SEWAGE SYSTEM DESIGN

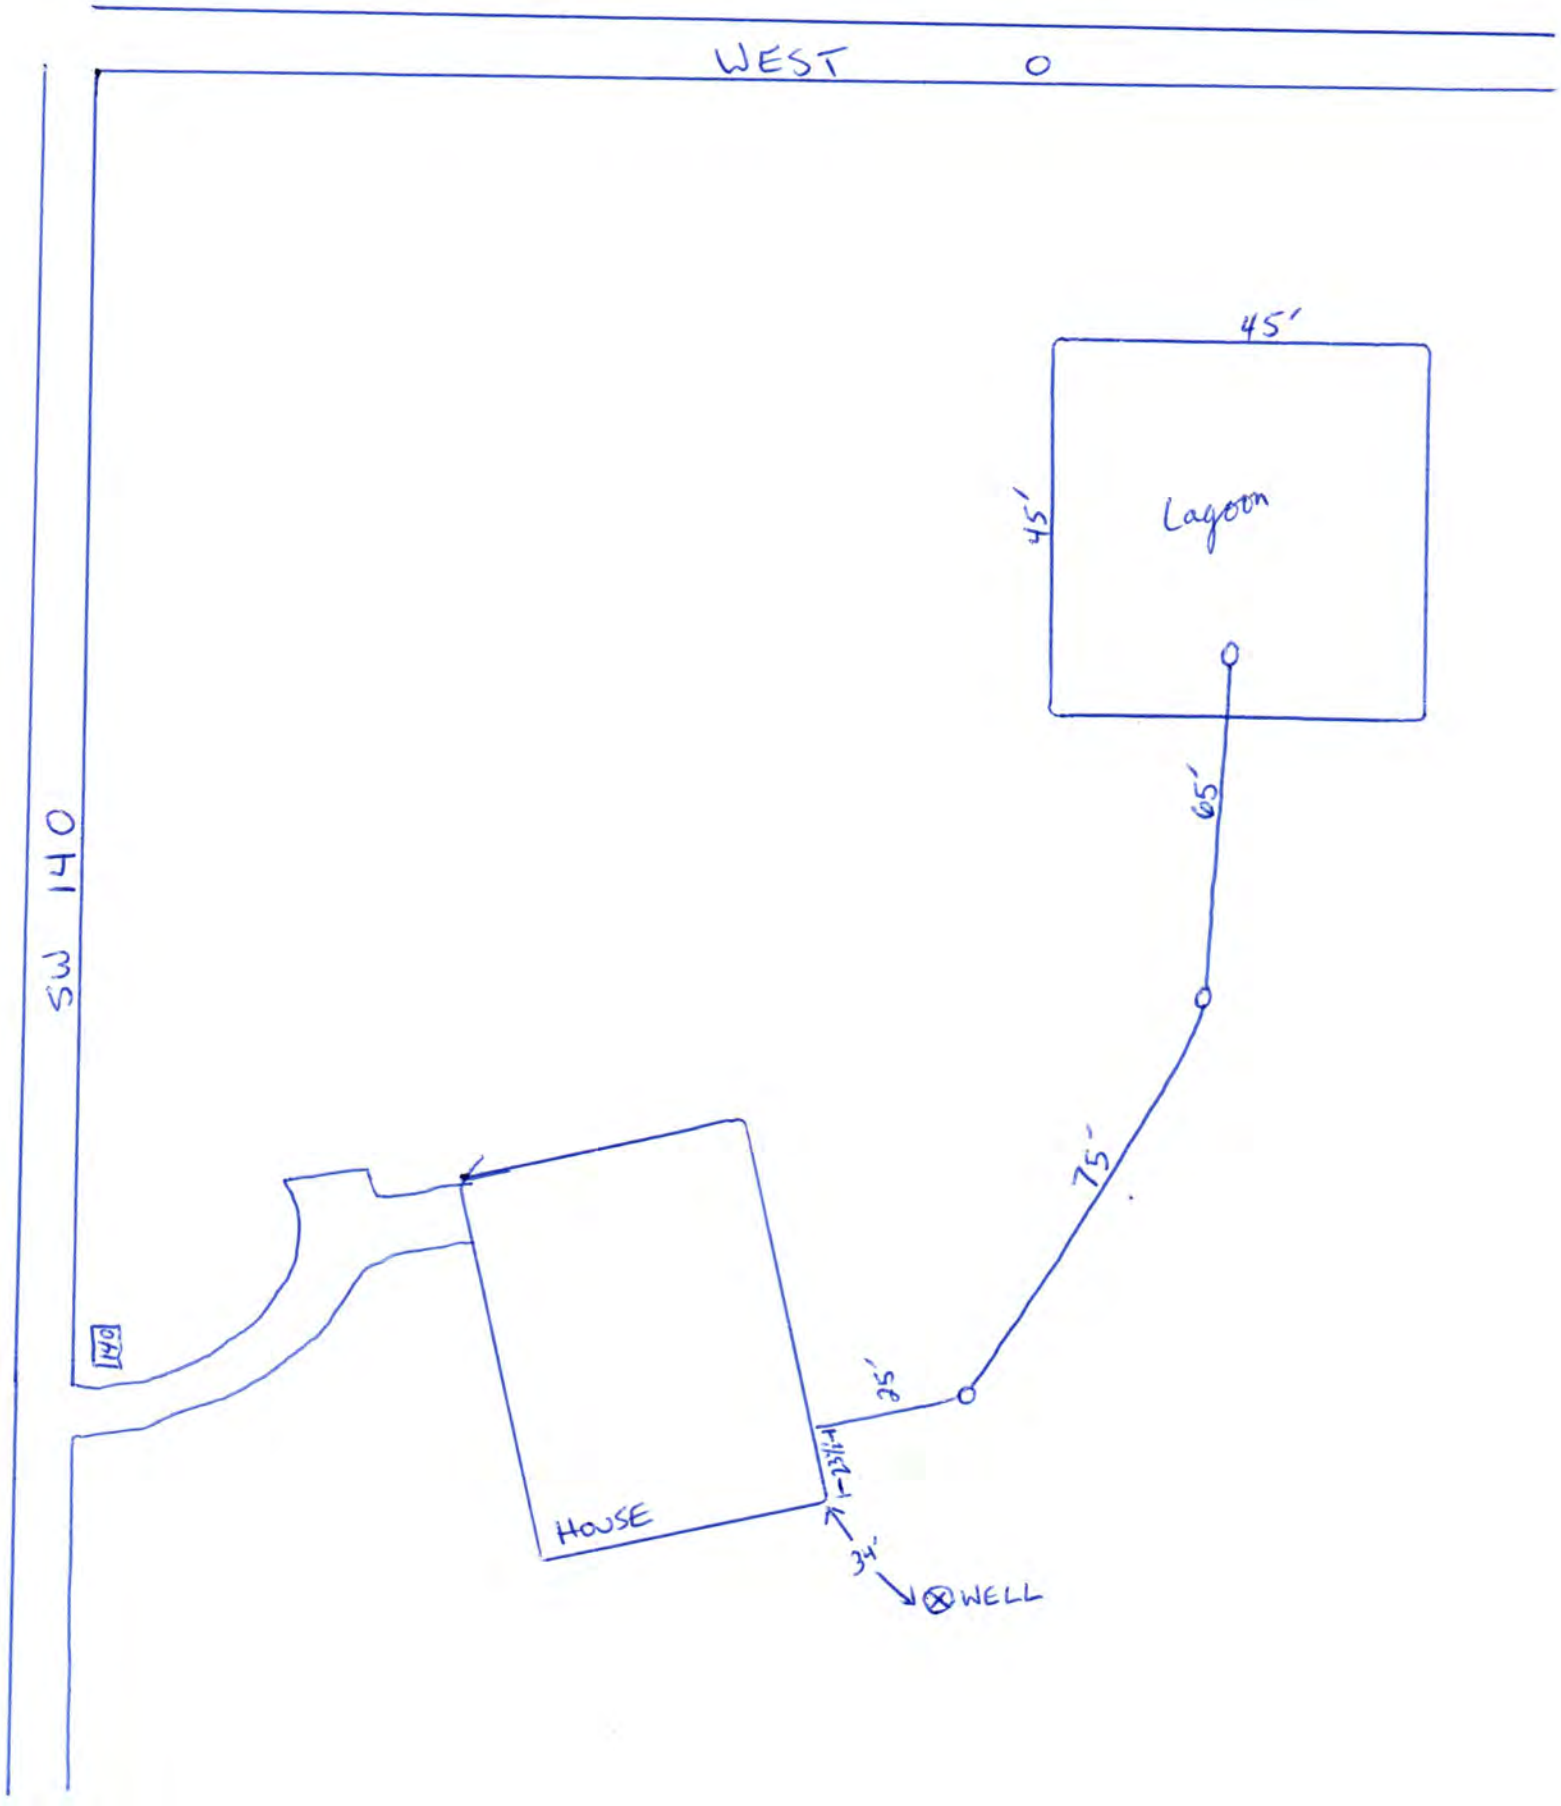
WEST
SW 140
140
45'
45'
Lagoon
65'
75'
25'
HOUSE
WELL
34'

LEGEND

• CORNER FOUND

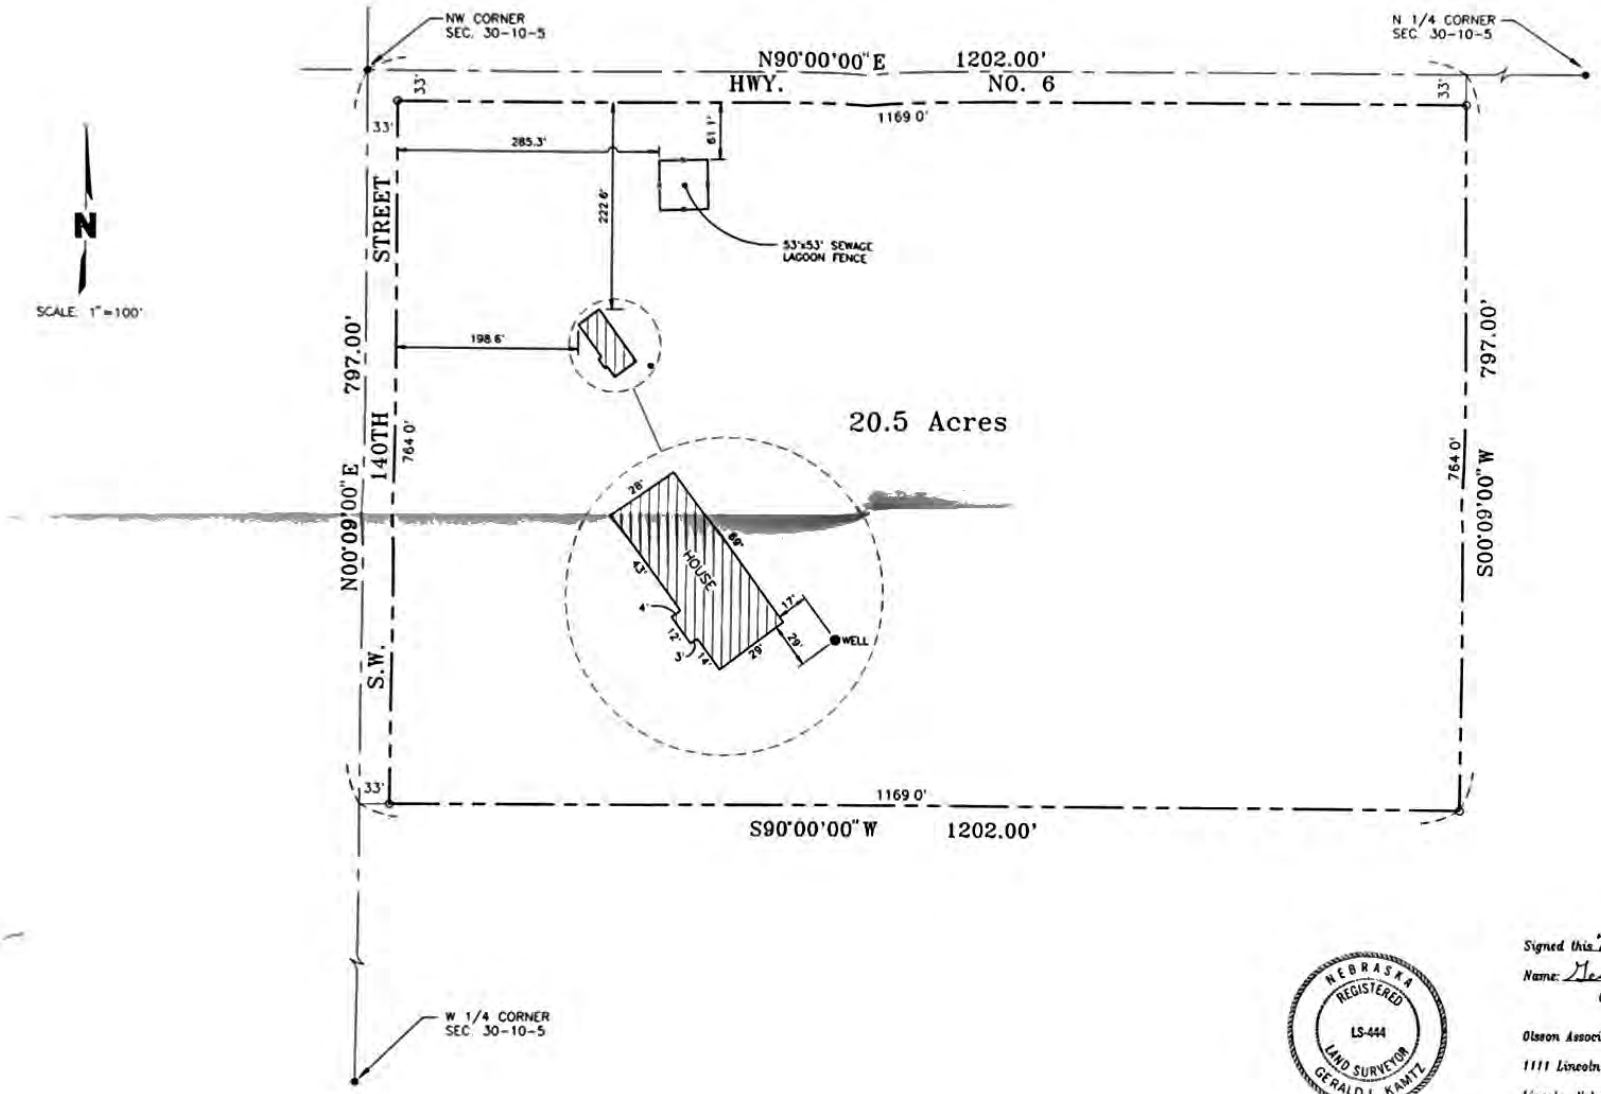

NEBRASKA REGISTERED LS-444 LAND SURVEYOR GERALD L. KAMTZ

Land Surveyor's Seal

Signed this 7th day of June 1995

Name: Gerald L. Kamtz

GERALD L. KAMTZ

Olsson Associates

1111 Lincoln Mall, P.O. Box 84608

Lincoln, Nebraska 68501-4608

Surveyor's license No. LS 444

402-474-6311