Lincoln-Lancaster County Health Department
ENVIRONMENTAL PUBLIC HEALTH DIVISION

005495

3140 N STREET · LINCOLN, NE 68510-1514

(402) 441-8000

Permit: SEWAGE INSTALLATION
SEPTIC SYSTEM

Permit # 04380289301

Issued 09/15/04
Expires 03/15/05
Revenue Code 3157

Establishment:
ROJO INVESTMENTS LLC
T10N R6E SEC 28 QTR SW
LOT 123IT
701 S CODDINGTON AVE

FEES: $200.00

Permittee:
ROJO INVESTMENTS LLC
2501 W DENTON RD
LINCOLN NE 68523

TOTAL: $200.00

Bruce D. Dart

Bruce D. Dart, Health Director

EPH COPY

Lincoln-Lancaster County Health Department
Environmental Health Division
3140 "N" Street • Lincoln, NE 68510-1514
Phone: 402-441-8022

A

Permit Number: 04380289301

Sewage Disposal System

Request for Site Clearance and Permit

Include Form B, Form C and Applicable Fees with this Application.

☑ Septic System ☐ Lagoon ☐ Other (Refer to Form C)

The undersigned hereby requests site clearance and permit to construct a Sewage Disposal System in conformance with appropriate resolution or ordinance, as described herein:

PLEASE PRINT OR TYPE

A. System Location (Indicate correct number and street)

Address (Approx. 701 S. Coddington Ave.) City Lincoln NE, Zip 68522
(no rural route)

Legal Description Irreg. Tract Lot 123 SW 28-10-6 1231.1
1/4 1/4 Section Township Range Subdivision Addition Block Lot

Geographical Location (if known): Longitude _____ Latitude _____

☐ Check if system mail address is not the same as the owner's address

B. Owner

Name ROJO Investments, L.L.C. Signature /John R. Puelz, Member

Address 2501 W. Denton Rd. City/State/Zip Lincoln, NE 68523

☐ Check if owner designed system Home Phone 402.421.8027 Work Phone 402.430.5284

C. Contractor

Name STAN KROESE Company Name DIRT WORKS PLUS INC

Address 7801 LEIGHTON City/State/Zip LINCOLN NE 68507

☑ Check if contractor designed system Work Phone 560.1208

D. Engineer/Installer ☐ Check and complete if engineer designed system

Designer Name _____ Firm _____ Work Phone _____

E. This System Will Serve a

☐ Residential Dwelling Number of Bedrooms ____ Is there a Whirlpool Bathtub YES NO

☑ Commercial Establishment/Other Facility Specify 4 EMPLOYEES

Design flow in gallons per day 25 GAL Type of Wastewater: ☒ Domestic ☐ Non-Domestic.

DO NOT WRITE BELOW THIS LINE

Approval Process ☒ Municipal Code 24.38 ☐ County Resolution No. 2832

1. **Health Department** Date rec'd 9/15/04 Date frwd 9/15/04 ACTION ☒ Approved ☐ Disapproved Signature Jerrold C. Hood
2. **Supt. Bldg. Insp. or Village Clerk** Date rec'd _____ Date frwd _____ ACTION ☒ Approved ☐ Disapproved Signature _____
3. **City or County Engineer** Date rec'd 9/15/04 Date frwd 9/15/04 ACTION ☒ Approved ☐ Disapproved Signature _____

To be built above flood plain.

Installation Final Written Approval

By _____

Date 7/13/05

Business Office Use Only
Date Rec'd 09/15/04
Amt Paid 200.00
Rec'd By _____ ~~Cash~~/Check No. 7175

FORM 23-100 10-96 White - Health Dept. Yellow - Engineer Pink - Bldg. Inspector

Lincoln-Lancaster County Health Department
Environmental Health Division
3140 "N" Street • Lincoln, NE 68510-1514
Phone: 402-441-8022


C

Permit Number: 043802893

Sewage Disposal System

Preliminary Plan Specifications

Draw a plot plan showing system location, lines, distribution box, tank and laterals, percolation test hole locations, well, residence, compass direction and property lines. Indicate on drawing if residence and well are existing or proposed.

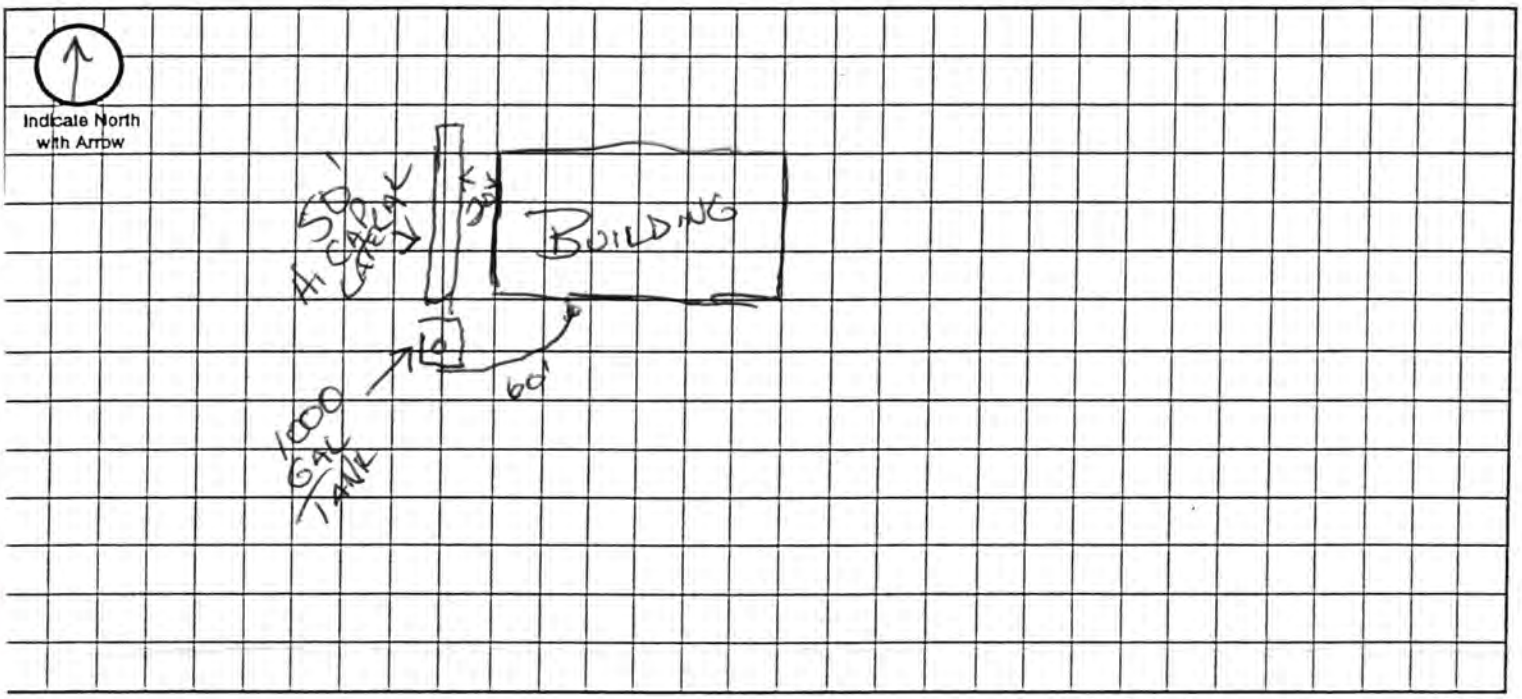

Approximate Scale: _____ ft. = _____ grid line/s

A. System Location (Indicate correct number and street)

Address (no rural route) _____ City _____ NE, Zip _____

B. Proposed Septic Tank/s

Tank Material: ☑ Concrete ☐ Plastic ☐ Other _____

C. Proposed Absorption System (See Form B for Percolation Information)

Percolation Rate _____ (min. per inch) Soil Type: _____ Land Slope: _____ %

Type of Absorption System: ☑ Trench ☐ Bed ☐ Other _____

Total Square Feet of Field Required: _____ sq. ft.

Type of Lateral: ☐ Half-Moon ☐ Perforated Pipe ☑ Other Lateral Material: INFILTRATOR

Capacity of Septic Tank _____ gals Number of Absorption Beds: _____ Number of Distribution Laterals per Bed _____

Total Length of Laterals _____ ft. Number of Trenches _____ Trench Width _____

D. Setbacks Check the Boxes Below if the Required Setback has been Satisfied

Distance From	Private Well	Public Well	Surface Water	Gound Water	Pressure Water Lines	Property Lines	Foundations Yours	Foundations Neighbors	All Other Setbacks
Tank (ft)	50 ☑	500 ☑	50 ☑	NA ☑	25 ☑	20 ☑	15 ☑	25 ☑	☑
Field (ft)	100 ☑	500 ☑	50 ☑	4 ☑	30 ☑	20 ☑	30 ☑	40 ☑	☐
Lagoon (ft)	100 ☐	500 ☐	50 ☐	N/A ☐	30 ☐	50 ☐	100 ☐	200 ☐	☐

E. Required Signatures

Home Building Contractor _____ /John R. Puelz, Member ROJO Inv Date 9/8/04

Installer _____ Date 9/16/04

Lincoln-Lancaster County Health Department
Environmental Health Division
3140 "N" Street • Lincoln, NE 68510-1514
Phone: 402-441-8022

D

Permit Number:

Sewage Disposal System

As Built Plans & Specifications

Date 7/12/05 ROJO INVESTMENTS

System Location (Indicate correct number and street)

Address _____ City _____ NE, Zip _____
(no rural route)

A. Building Sewer

1. Material: CLS 160
   Diameter: 4 in.
2. Distance above basement floor: 18 in.
   or distance below basement floor: _____ in.
3. Distance between dwelling and septic tank: 49 ft.
4. Number of clean-outs: _____
5. Distances to: well or suction line 100+ ft.
   stream 100+ ft.
   pressure line 100+ ft.
   property line 100+ ft.

B. Septic Tank

1. Material: CONC
   Number of compartments: 1
2. Capacity: 1000 gal.
3. Factory built: ☑ Yes ☐ No
4. Manholes: Over inlet, diameter _____ in.
   Over outlet, diameter _____ in.
   Riser: ☑ above ☐ below grade 6 in.
5. Inlet: ☑ baffle ☐ tee
6. Outlet: ☑ baffle ☐ tee
7. Depth to top of tank, below unfinished grade: 12 in.
8. Distances to: Well or suction line 100+ ft.
   Stream 100+ ft.
   Pressure line 100+ ft.
   Property line 100+ ft.

C. Distribution Box

1. Material: NONE
   Number available outlets: _____
2. Factory built: ☐ Yes ☐ No
3. Distance from septic tank: _____ ft.

D. Absorption Field


(Provide as-built drawings on back of this form)

1. Type: ☐ Half rounds ☐ Perforated pipe
   Diameter of half round: _____
   or perforated pipe: _____
   Material: ☐ fiberglass ☐ plastic ☐ concrete
   ☑ other 4" CAP INFILTRATOR
2. Lateral lines: Number 1
   Length of each line: 63 ft. _____ ft.
   _____ ft. _____ ft., _____ ft.
3. Trench dimensions: Width 3 ft.
   Slope 0 in/100 ft.
   Average depth 40 in
4. Filter material: GRAVEL-LESS
   Depth of material NA in.
5. Distances to: Well or suction line 100+ ft.
   Stream 100+ ft.
   Pressure line 100+ ft.
   Property line 50' ft.


Complete "As Built" drawing on back of this form.

Indicate North with Arrow

Individual Sewage System Design (Example)

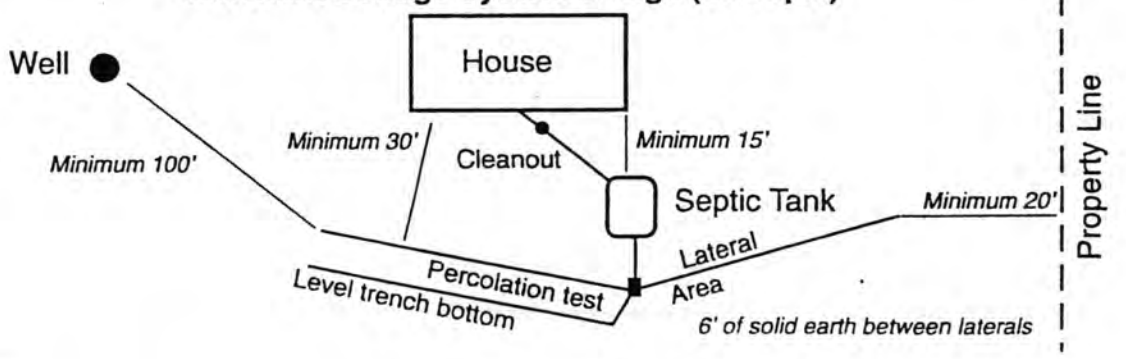

As Built Drawing

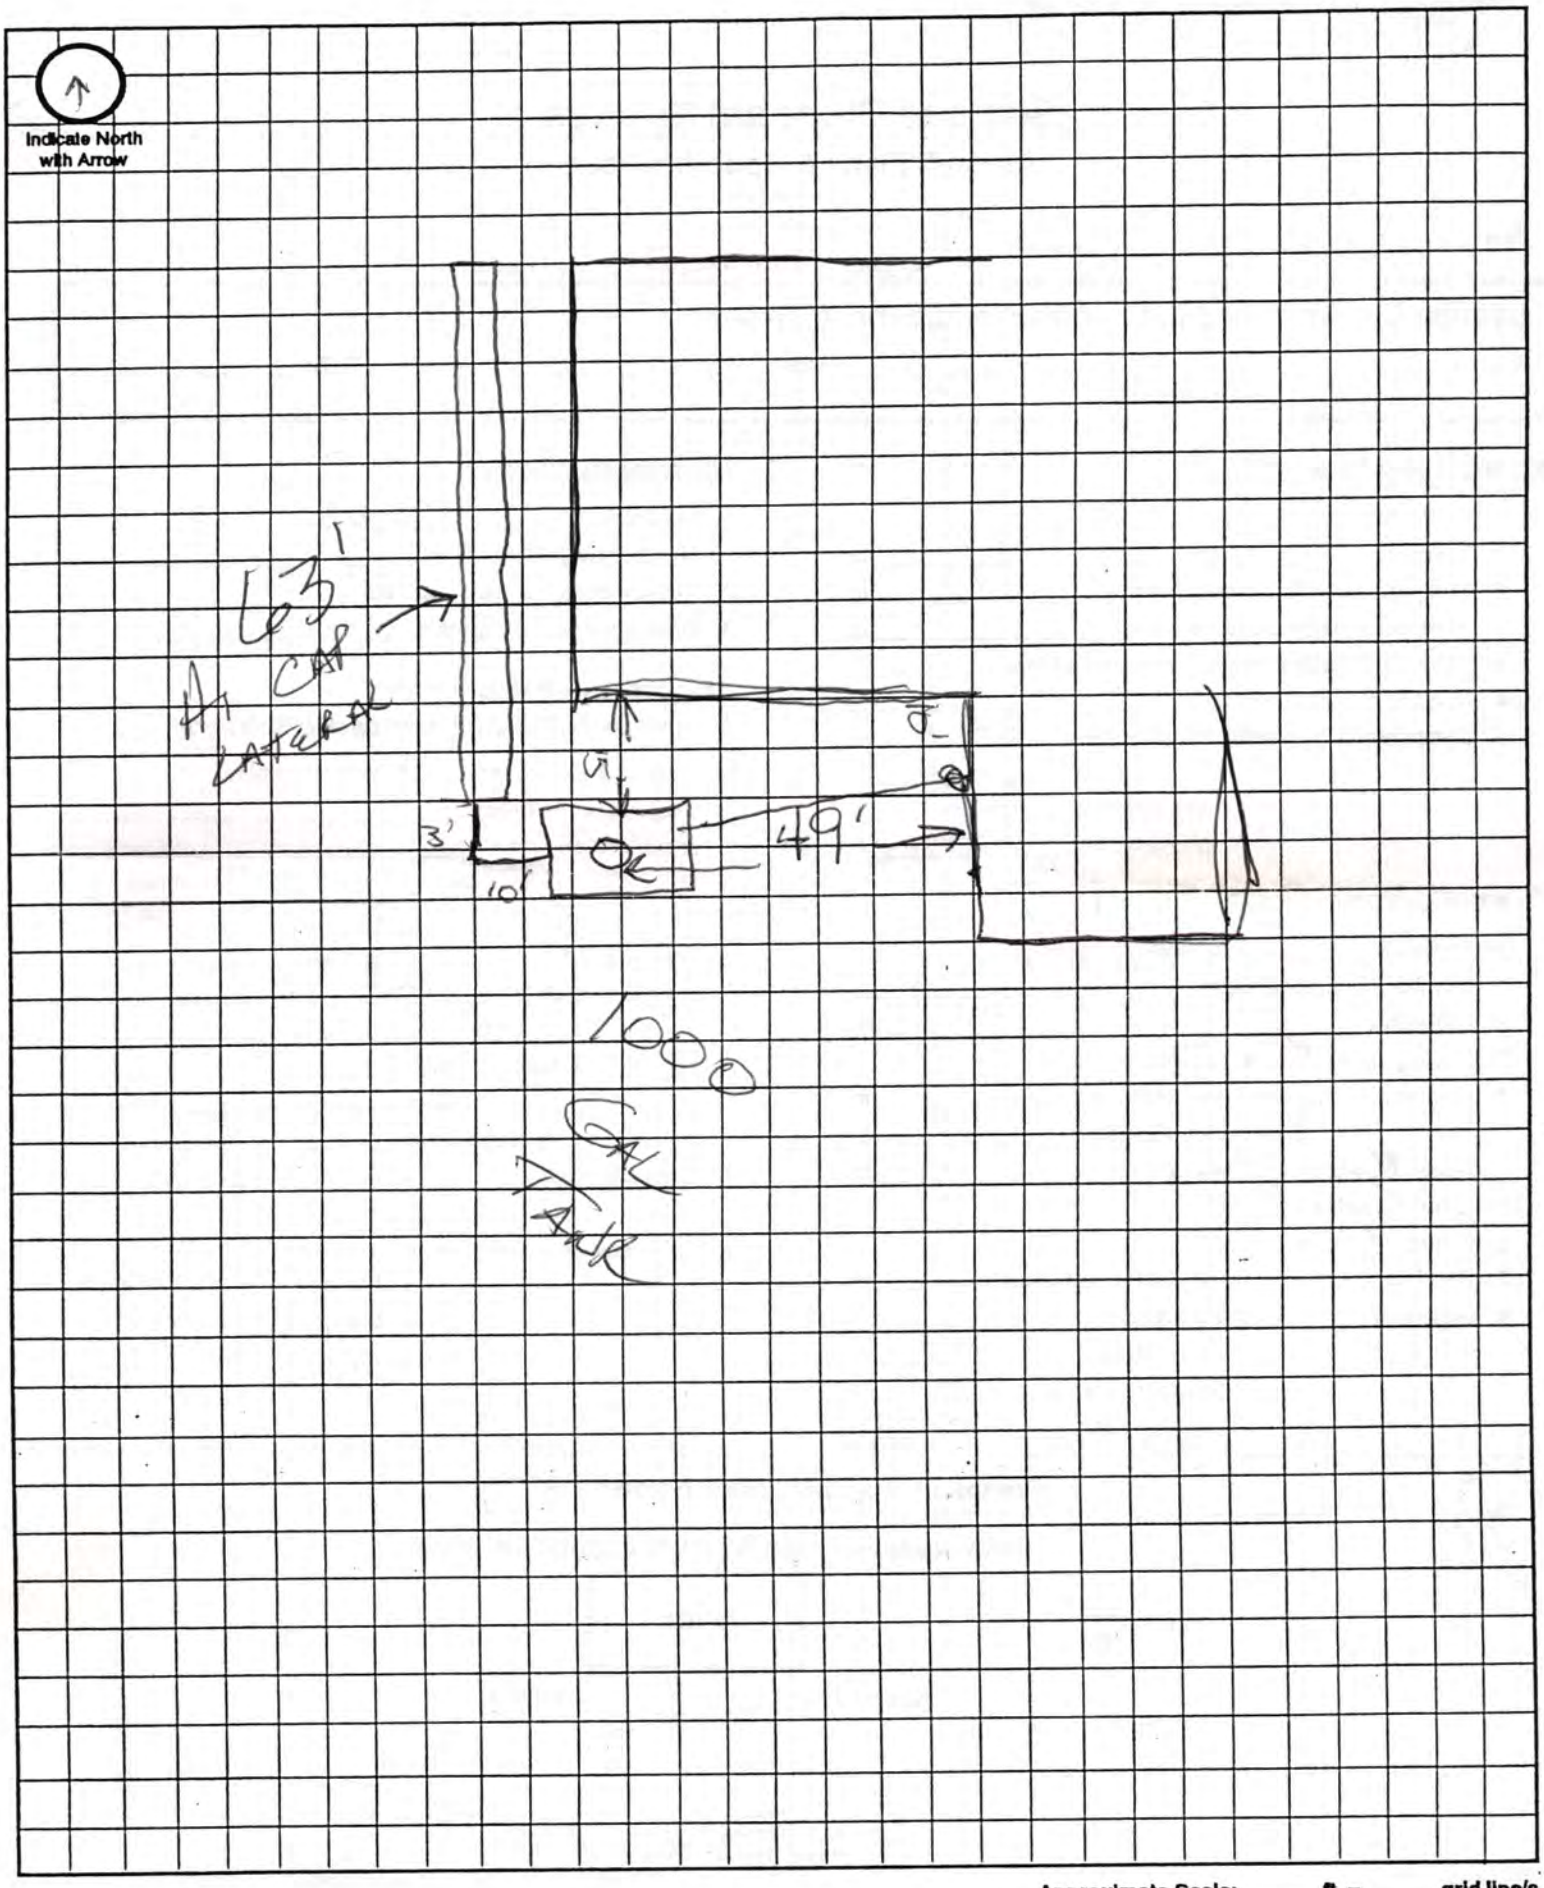

Approximate Scale: _____ ft. = _____ grid line/s