
AS BUILT DRAWING OF SYSTEM

DATE March-28-85 INSTALLER Strohmyer

West A.

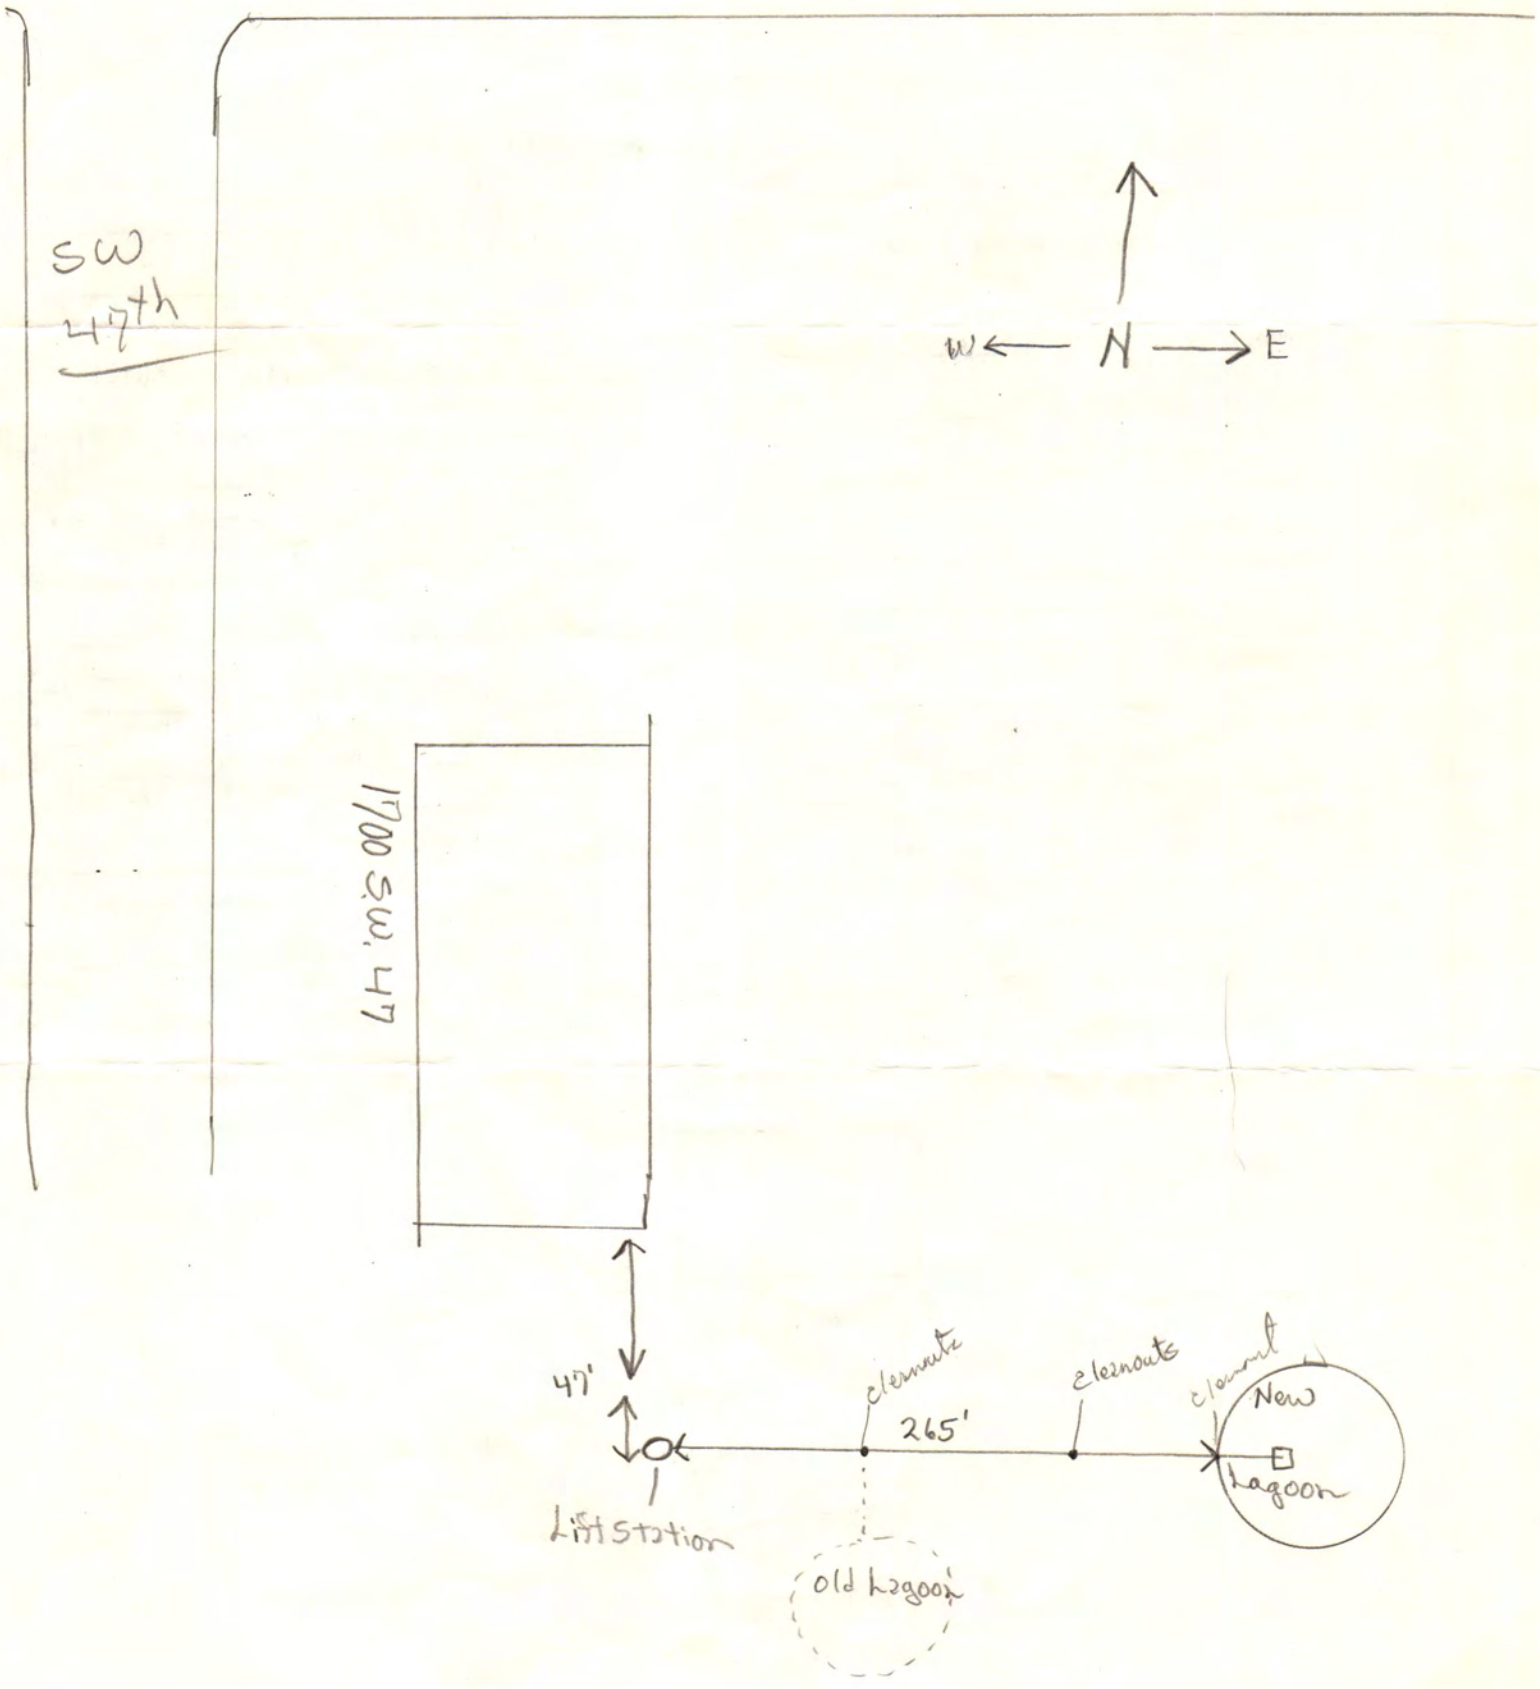

FORM HD- 45(73) PLANS & SPECIFICATIONS
SEWAGE DISPOSAL SYSTEM
(Annex to Application)
City Ordinance No. 9150 ☐
County Resolution No. 2832 ☐

LINCOLN-LANCASTER COUNTY HEALTH DEPARTMENT
Division of Environmental Health
2200 St. Marys Avenue
Lincoln, Nebraska 68502 (Phone: 475-6221)

FILE NO. _____

SPECIFICATIONS

DATE: 4-5-77


A. BUILDING SEWER:
1. Material pla; Diameter 4 in.
2. Distance above basement floor ___in.; or below basement floor X in.
3. Distance between dwelling and septic tank ___ft.
4. Number of clean-outs 1.
5. Distances To:
Well or Suction Line 50 ft.;
Stream ___ft.; Pressure Line ___ft.;
Property Line ___ft.

B. SEPTIC TANK (Provide construction drawings.)
1. Material _____; No. of compartments _____.
2. Capacity _____gals.; Liquid depth ___in.
3. Factory Built: Yes ☐ (Company _____)
No ☐
4. Manholes: Over Inlet; diam. ___in.
Over Outlet; diam. ___in.
Below Grade _____in.
5. Inlet: Baffle ☐; or Tee ☐
6. Outlet: Baffle ☐; or Tee ☐
Depth of outlet below inlet ___in.
7. Depth of top of tank below finished grade ___in.
8. Distances To:
Well or Suction Line ___ft.;
Stream ___ft.; Pressure Line ___ft.;
Property Line ___ft.


C. DISTRIBUTION BOX
1. Material _____; No. available outlets _____.
2. Factory Built: Yes ☐, (Company _____)
No ☐
3. Dimension: Length ___in.; Width ___in. Depth ___in.
4. Distance from Septic Tank ___ft.
5. Serial Distribution: Yes ☐, No ☐ (If yes, show detailed plans.)

D. ABSORPTION FIELD: (Provide drawings.)
1. Type: _____
2. Lateral Lines: Depth below grade ___in. Number ___; Length of each line ___ft Total length of Laterals ___ft.; Slope ___in/100 ft. Diameter of pipe ___ in.; Shape _____
Material: concrete ☐; fiber asbestos ☐; clay ☐; other _____
Distance between lateral lines ___ft.
3. Trench Dimensions: Depth ___in.; Width ___in.
4. Filter Material: _____.
Depth of material from trench bottom _____in.
5. Distances To:
Well or Suction Line ___ft.;
Stream ___ft.; Pressure Line ___ft.
Property Line ___ft.
6. Percolation Rate: _____minutes/inch

TYPICAL SKETCHES

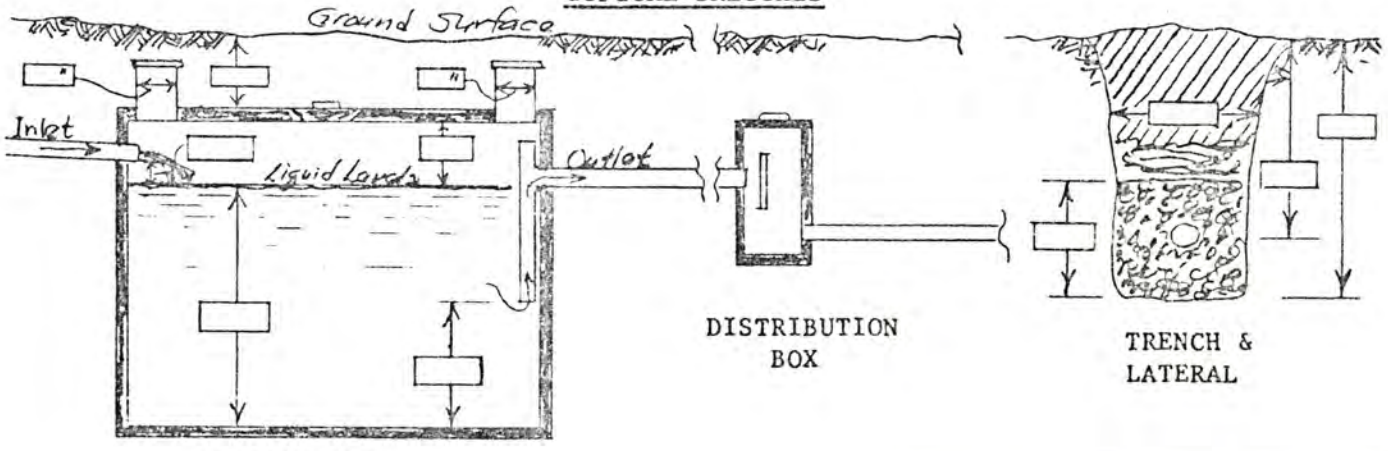

Robert O'Connell
Signature of Applicant

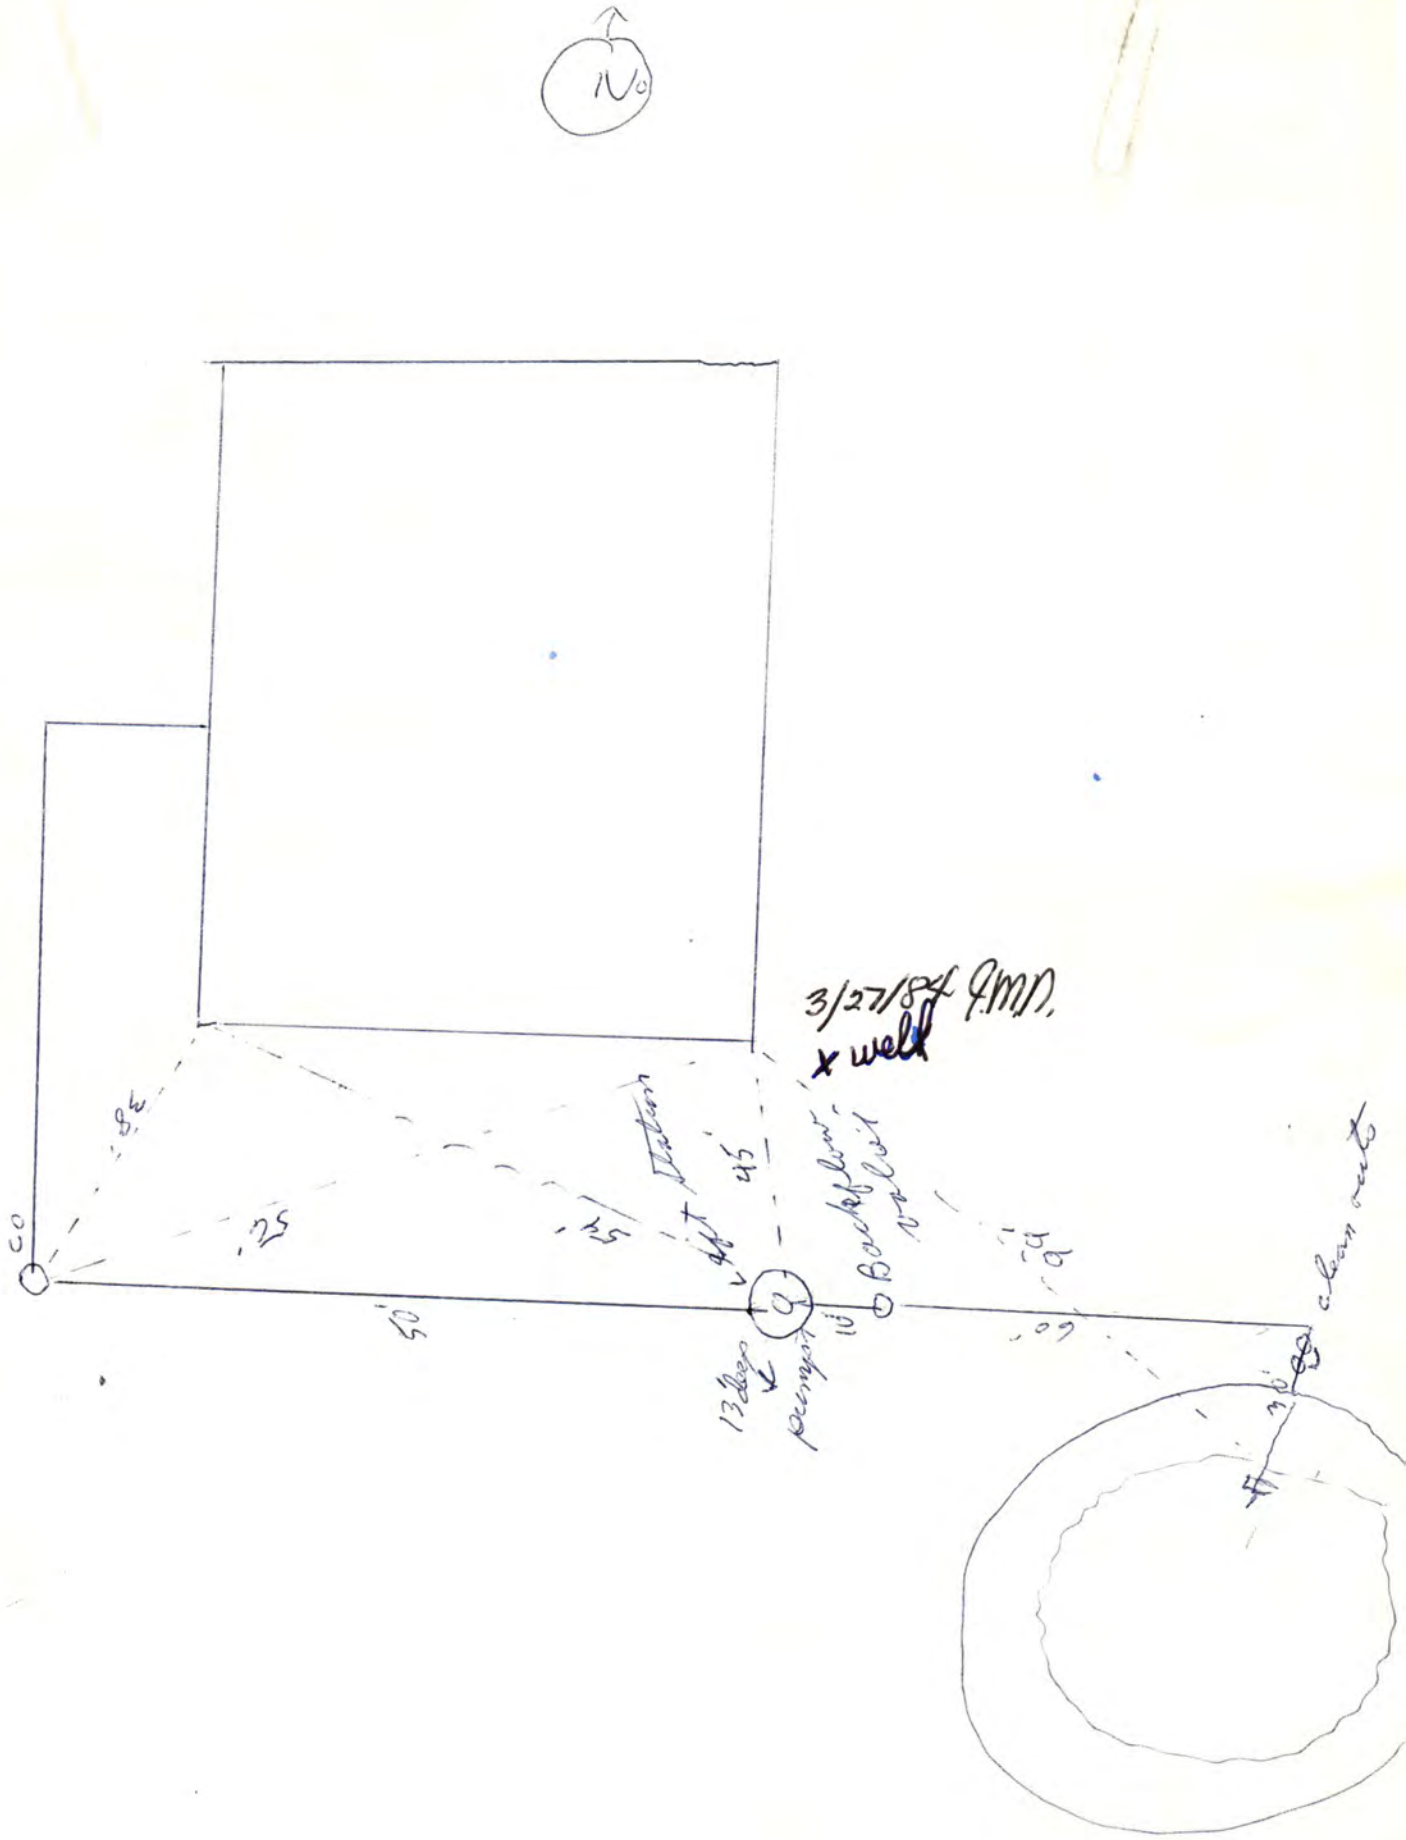
N
3/27/84 AMD.
+ well
CO
25
50
45
Station
clean out

FILE NO. 259

CITY OF LINCOLN NEBRASKA

DEPARTMENT OF LICENSES AND PERMITS

INDIVIDUAL SEWAGE SYSTEM CONSTRUCTION
TYPE OF LICENSE OR PERMIT

October 24, 1972
THIS LICENSE OR PERMIT EXPIRES

Robert Gilliam — Route #6
LICENSEE OR PERMITTEE — ADDRESS

T10N; R6E; Sec. 31; Bl. 2; Lot 5; High Ridge Acres
NAME OF ESTABLISHMENT, IF ANY — LEGAL DESCRIPTION — ADDRESS

REMARKS: Non-Transferable

PERMIT	INSPECTION FEE	OCCUPATION TAX	LICENSE	TOTAL
$ 30.00	$	$	$	$ 30.00

ACCOUNTING NO.	ACCOUNTING NO.	ACCOUNTING NO.	CODE
110.15	110.16	148.14	6-2

624-1535

SERIAL NO.	DATE	AMOUNT

VALID RECEIPT ONLY IF MACHINE RECEIPTED IN THIS SPACE

APPLICATION

THIS LICENSE OR PERMIT IS ISSUED SUBJECT TO REVOCATION AS PROVIDED BY LAW

FORM HD-30(67) REQUEST FOR SITE CLEARANCE FOR INDIVIDUAL SEWAGE DISPOSAL SYSTEM
City Ordinance No. 9150

LINCOLN-LANCASTER COUNTY HEALTH DEPARTMENT
Division of Environmental Health
2200 St. Marys Avenue
Lincoln, Nebraska 68502 (Phone: 432-7611)

FILE NO. 259

TO: Division of Environmental Health
Lincoln-Lancaster County Health Dept.

The undersigned hereby requests SITE CLEARANCE to construct an Individual Sewage Disposal System in conformance with Lincoln City Ordinance No. 9150, as described herein:

1. Legal description of property: Twp. 10N; Range 6; Section 31;
Block 2; Lot 5; Addition Highridge Acres
Street Address _____.

2. Property Use: Residential _____ [X]; Commercial _____ [ ]
No. of Bedrooms 2. Describe: _____
Other Use _____ [ ]
Describe: _____

3. Type of Individual Sewage Disposal System: Septic Tank [X]; Other [ ]

4. Distance to public sewer: _____ ft.

Robert Dillion
Signature of Applicant (owner or lessee)

Rt 6 Lincoln
Address

(Do not write below this double line)

REVIEWING ACTION

1. Health Department: Date Rec'd. 4/21/72. ACTION: Approved _____ [X] Disapproved [ ]
Date Frwd. 4/21/72. Signature: Gerald C. Hood

2. Supt. Bldg. Insp.: Date Rec'd. 4-24-72. ACTION: Approved _____ [X] Disapproved [ ]
Date Frwd. 4-24-72. Signature: Chas Leak By BL

3. City Engineer: Date Rec'd. _____. ACTION: Approved _____ [✓] Disapproved [ ]
Date Frwd. 4-24-72. Signature: [illegible]

REMARKS OR REASONS FOR DISAPPROVAL _____

FINAL ACTION ON SITE CLEARANCE: Approved [ ] Disapproved [ ]

Date Applicant Notified: _____ Signature _____

FORM HD-32(67) APPLICATION FOR PERMIT TO CONSTRUCT INDIVIDUAL SEWAGE DISPOSAL SYSTEM
City Ordinance No. 9150

LINCOLN-LANCASTER COUNTY HEALTH DEPARTMENT
Division of Environmental Health
2200 St. Marys Avenue
Lincoln, Nebraska 68502 (Phone: 432-7611)

FILE NO. _____

DATE: April 20, 1972

TO: Director of Health
Lincoln-Lancaster County Health Dept.

The undersigned hereby applies for a permit to construct an Individual Sewage Disposal System in conformance with Lincoln City Ordinance No. 9150, as described in this application and the annexed forms attached hereto.

1. Legal description of property: Twp. 10N; Range 6E; Section 31; Block 2; Lot 5; Addition ~~High~~ Ridgeacres; Street Address _____.

2. Property Use: Residential _____ [X]; Commercial _____ [ ]
No. of Bed Rooms 2 Describe: _____

Other Use _____ [ ]
Describe: _____

3. Type of Individual Sewage Disposal System: Septic Tank [X]; Other [ ]

4. Plans and Specifications of Proposed System. (See FORM HD-32a(67) PLANS & SPECIFICATIONS, SEWAGE DISPOSAL SYSTEM, attached hereto.)

5. Soil Absorption Properties. (See FORM HD-33(67) SOIL ABSORPTION TEST DATA REPORT, attached hereto.)

Robert Dillman
Signature of Applicant (owner or lessee)

Rt 6 Lincoln
Address

(Do not write below double line)

REVIEWING ACTION

1. Date Rec'd: _____
Filing Fee: $ 30.00

2. Date Site Clearance _____

3. Site Visits:
Date: 9/22/72 by: L. C. H.
Date: _____ by: _____
Date: _____ by: _____

4. Date: Approved [X]; Disapproved [ ]: 4/21/72
by: Jerrold C. Hood

5. BUREAU OF LICENSES & PERMITS
Date Notified: _____
Date Issued: _____ Serial _____

6. INSTALLATION FINAL WRITTEN APPROVAL
Date: 9/22/72 by: Jerrold C. Hood

FORM HD-32a(67) PLANS & SPECIFICATIONS
SEWAGE DISPOSAL SYSTEM
(Annex to Application)
Ordinance No. 9150

LINCOLN-LANCASTER COUNTY HEALTH DEPARTMENT
Division of Environmental Health
2200 St. Marys Avenue
Lincoln, Nebraska 68502 (Phone: 432-7611)

FILE NO. 259

SPECIFICATIONS

DATE: _____


A. BUILDING SEWER:
1. Material PLASTIC; Diameter 4 in.
2. Distance above basement floor ___ in.; or below basement floor ___ in.
3. Distance between dwelling and septic tank 48 ft.
4. Number of clean-outs 1.
5. Distances To:
Well or Suction Line — ft.;
Stream — ft.; Pressure Line — ft.;
Property Line ___ ft.

B. SEPTIC TANK (Provide construction drawings.)
1. Material Fiber; No. of compartments 1.
2. Capacity 1000 gals.; Liquid depth 50 in.
3. Factory Built: Yes ☒ (Company CORRUGATED FIBERGLASS) No ☐
4. Manholes: Over Inlet; diam. ___ in.
Over Outlet; diam. ___ in.
Below Grade ___ in.
5. Inlet: Baffle ☐; or Tee ☒
6. Outlet: Baffle ☐; or Tee ☐
Depth of outlet below inlet ___ in.
7. Depth of top of tank below finished grade 24 in.
8. Distances To:
Well or Suction Line — ft.;
Stream — ft.; Pressure Line — ft.;
Property Line — ft.


C. DISTRIBUTION BOX
1. Material CON; No. available outlets 5.
2. Factory Built: Yes ☒, (Company PRE-CAST STEP No ☐
3. Dimension: Length ___ in.; Width ___ in. Depth ___ in.
4. Distance from Septic Tank 74" ft.
5. Serial Distribution: Yes ☐, No ☒ (If yes, show detailed plans.)

D. ABSORPTION FIELD: (Provide drawings.)
1. Type: Half Round
2. Lateral Lines: Depth below grade ___ in. Number 1; Length of each line 100 ft Total length of Laterals 100 ft.; Slope 6 in/100 ft. Diameter of pipe 16 in.; Shape —
Material: concrete ☐; fiber asbestos ☐; clay ☐; other ___
Distance between lateral lines ___ ft.
3. Trench Dimensions: Depth 54 in.; Width 48 in.
4. Filter Material: Gravel.
Depth of material from trench bottom ___ in.
5. Distances To:
Well or Suction Line — ft.;
Stream — ft.; Pressure Line — ft.
Property Line — ft.
6. Percolation Rate: ___ minutes/inch

TYPICAL SKETCHES

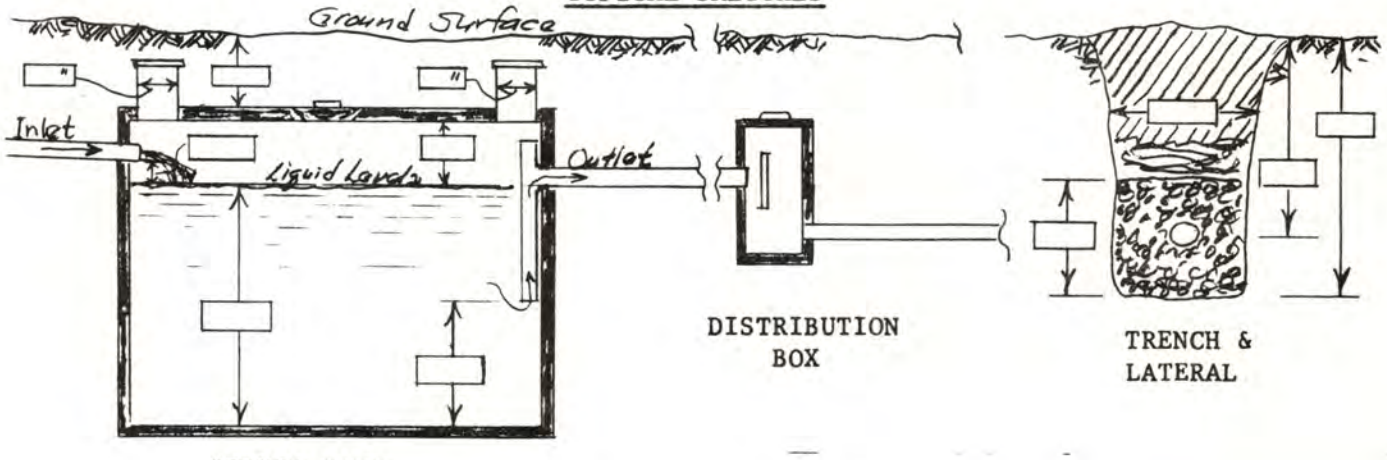

Signature of Applicant

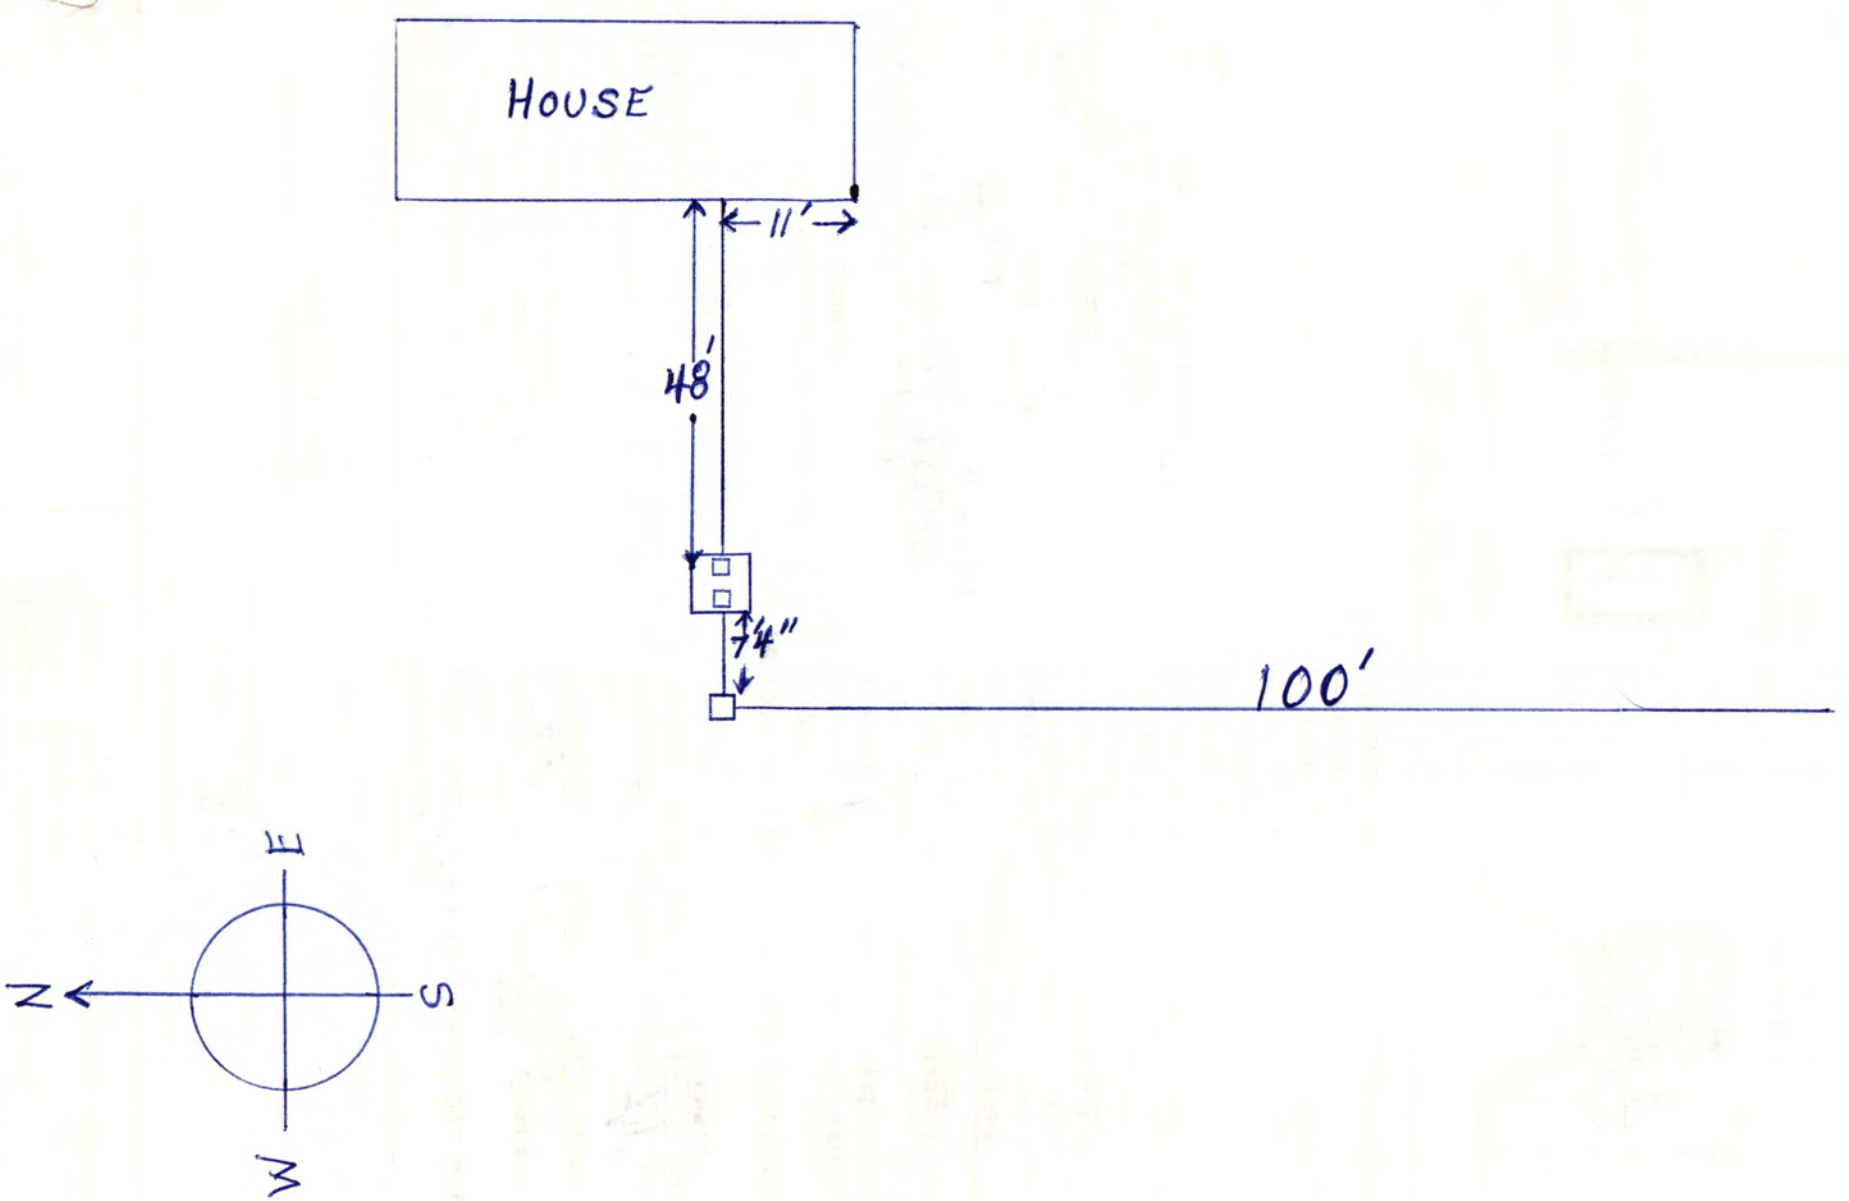
HOUSE
11'
48'
¾"
100'
E
N
S
W