Lincoln-Lancaster County Health Department

ENVIRONMENTAL HEALTH DIVISION
3140 N STREET · LINCOLN, NE 68510-1514 (402) 441-8000

Permit

SEWAGE INSTALLATION
SEPTIC SYSTEM

Establishment

ANTHONY J CLARKE
T11N R7E SEC 7 QTR NE
SE 1/4 OF NE 1/4 LOT 23
12001 N 40 ST

Permittee

ANTHONY J CLARKE
870 N 25 ST
APT 1
LINCOLN NE 68503

Permit # 01380233901

Issued 07/24/01
Expires 01/24/02
Revenue Code 3157

FEES: $200.00

TOTAL: $200.00

[redacted], Health Director

• POST IN A PROMINENT PLACE • NOT TRANSFERABLE

016135

Lincoln-Lancaster County Health Department
Environmental Health Division
3140 "N" Street • Lincoln, NE 68510-1514
Phone: 402-441-8022

A

Permit Number:

Sewage Disposal System

Request for Site Clearance and Permit

Include Form B, Form C and Applicable Fees with this Application.

☒ Septic System ☐ Lagoon ☐ Other (Refer to Form C)

The undersigned hereby requests site clearance and permit to construct a Sewage Disposal System in conformance with appropriate resolution or ordinance, as described herein:

PLEASE PRINT OR TYPE

A. System Location (Indicate correct number and street)

Address 12001 N. 40th (no rural route) City Lincoln NE NE, Zip 68503

Legal Description SE (1/4) NE (1/4) 7 (Section) 11 North (Township) Range 7 E. 6th P.M. (Range) Subdivision Addition Block 23 Lot I.T.

Geographical Location (if known): Longitude _____ Latitude _____

☒ Check if system mail address is not the same as the owner's address

B. Owner

Name Anthony J. Clarke Signature Anthony J Clarke

Address 870 N 25 Apt. 1 City/State/Zip Lincoln NE 68503

☐ Check if owner designed system Home Phone 402 474 4952 Work Phone 402 416 2470

C. Contractor

Name Stan Kluver Company Name Dirt Works Plus Inc

Address 7324 Ballard City/State/Zip LNK NE 68507

☒ Check if contractor designed system Work Phone 560 1208

D. Engineer/Installer ☐ Check and complete if engineer designed system

Designer Name _____ Firm _____ Work Phone _____

E. This System Will Serve a

☒ Residential Dwelling Number of Bedrooms 4 Is there a Whirlpool Bathtub YES NO

☐ Commercial Establishment/Other Facility Specify _____

Design flow in gallons per day_____ Type of Wastewater: ☑ Domestic ☐ Non-Domestic.

DO NOT WRITE BELOW THIS LINE

Approval Process ☐ Municipal Code 24.38 ☒ County Resolution No. 2832

1. **Health Department** Date rec'd 7/25/01 Date frwd 7/26/01 **ACTION** ☒ Approved ☐ Disapproved Signature Gerald C. Hood
2. **Supt. Bldg. Insp. or Village Clerk** Date rec'd _____ Date frwd _____ **ACTION** ☐ Approved ☐ Disapproved Signature _____
3. **City or County Engineer** Date rec'd _____ Date frwd _____ **ACTION** ☐ Approved ☐ Disapproved Signature _____

7-30-01, out of floodplain, need drawing

Installation Final Written Approval

By Bob Engert / for Steve Brauer

Date 7-31-01 8-1-01

Business Office Use Only
Date Rec'd 7/24/01
Amt Paid 200.00
Rec'd By CW Cash/Check No. 4073

FORM 23-100 10-96 White - Health Dept. Yellow - Engineer Pink - Bldg. Inspector

Lincoln-Lancaster County Health Department
Environmental Health Division
3140 "N" Street • Lincoln, NE 68510-1514
Phone: 402-441-8022

B

Permit Number:

Sewage Disposal System

Soil Absorption Test Data Report

Annex to Application

PLEASE PRINT OR TYPE

System Location (Indicate correct number and street)

Address 12001 N. 40th (no rural route) City Denton/Lincoln NE, Zip 68818

Owner Anthony J. Clarke Addresss 870 N. 25 Apt 1 Lincoln NE

Soil Type (SCS): _____ Percolation Rate: _____ min./inch

Date of Tests 7-11 to 7-12 Weather: Precipitation Sunny Temperature 85+

Percolation Test Data Table

A.	B.	C. D. E. F. Pre-Saturation Period				G. H. I. J. K. Percolation Readings					L. M. N. Results		
		Start		End		Start			End				
Hole No.	Hole Depth (in)	Date (Mo/Da)	Time (Hr/Min)	Date (Mo/Da)	Time (Hr/Min)	Date (Mo/Da)	Time (Hr/Min)	Water Lev (in.)	Date (Mo/Da)	Time (Hr/Min)	Elapsed Time (Min)	Water Level Drop (in)	Percolation Rates (Min/in)
1	24"	7/11	9:00	7/12	10:00	7/12	10:00	8"	7/12	2:00	30	5/8	48 MIN/IN
2	"	"	"	"	"	"	10:02	"	"	2:01	30	5/8	48 MIN/IN
3	"	"	"	"	"	"	10:05	"	"	2:03	30	1/2	60 MIN/IN
4	"	"	"	"	"	"	10:06	"	"	2:05	30	3/4	40 MIN/IN
5	"	"	"	"	"	"	10:08	"	"	2:07	30	5/8	48 MIN/IN
6	"	"	"	"	"	"	10:10	"	"	2:09	30	5/8	48 MIN/IN

Person Conducting Percolation Tests

Name: BY OWNER

Phone: _____

Address _____

Sum of Percolation Rates: _____

Average of Rates: _____

Rate Used for Calculation: 49

DO NOT WRITE BELOW THIS LINE

Reviewing Action

Remarks _____

Signature of Reviewing Official Jerrold C. Hood R.E.H.S. Date JULY 24, 2001

FORM 23-101 10-96


Lincoln-Lancaster County Health Department
Environmental Health Division
3140 "N" Street • Lincoln, NE 68510-1514
Phone: 402-441-8022

C

Permit Number:

Sewage Disposal System
Preliminary Plan Specifications

Draw a plot plan showing system location, lines, distribution box, tank and laterals, percolation test hole locations, well, residence, compass direction and property lines. Indicate on drawing if residence and well are existing or proposed.

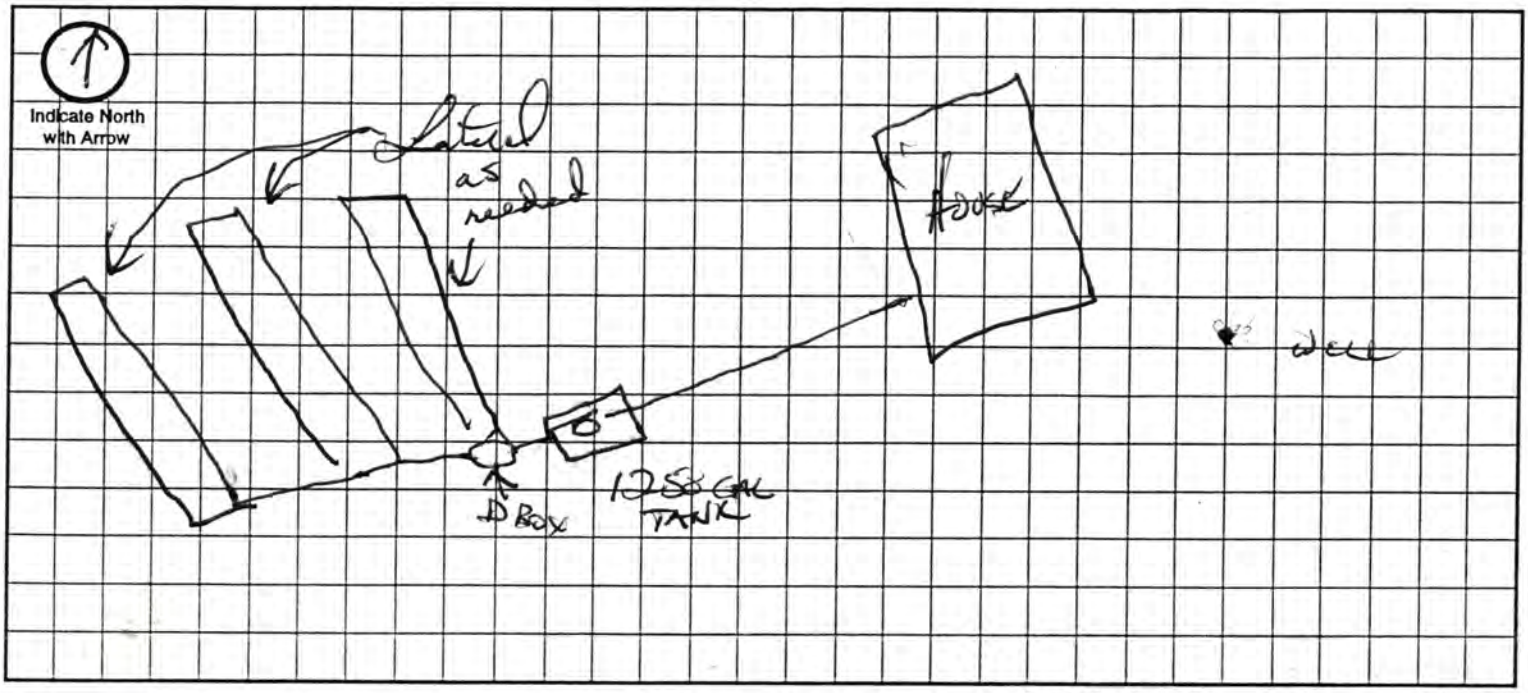

Approximate Scale: _____ ft. = _____ grid line/s

A. System Location (Indicate correct number and street)

Address (no rural route) 12001 N. 40th City Lincoln/Davey NE, Zip 68336

B. Proposed Septic Tank/s

Tank Material: ☑ Concrete ☐ Plastic ☐ Other _____

C. Proposed Absorption System (See Form B for Percolation Information)

Percolation Rate _____ (min. per inch) Soil Type: _____ Land Slope: _____ %

Type of Absorption System: ☑ Trench ☐ Bed ☐ Other _____

Total Square Feet of Field Required: 1320 sq. ft.

Type of Lateral: ☐ Half-Moon ☐ Perforated Pipe ☐ Other Lateral Material: Equalizers (High Capacity)

Capacity of Septic Tank 1250 gals Number of Absorption Beds: _____ Number of Distribution Laterals per Bed _____

Total Length of Laterals 330 ft. 660 GRAVELESS Number of Trenches 4 Trench Width 4'

D. Setbacks Check the Boxes Below if the Required Setback has been Satisfied

Distance From	Private Well	Public Well	Surface Water	Gound Water	Pressure Water Lines	Property Lines	Foundations Yours	Foundations Neighbors	All Other Setbacks
Tank (ft)	50 ☑	500 ☑	50 ☑	NA ☑	25 ☑	20 ☑	15 ☑	25 ☑	☑
Field (ft)	100 ☑	500 ☑	50 ☑	4 ☑	30 ☑	20 ☑	30 ☑	40 ☑	☑
Lagoon (ft)	100 ☐	500 ☐	50 ☐	N/A ☐	30 ☐	50 ☐	100 ☐	200 ☐	☐

E. Required Signatures

Home Building Contractor Matthew J Clark Date 7/21/01

Installer _____ Date 7/23/01

FORM 23-102 10-96

Lincoln-Lancaster County Health Department
Environmental Health Division
3140 "N" Street • Lincoln, NE 68510-1514
Phone: 402-441-8022

D

Permit Number:

Sewage Disposal System
As Built Plans & Specifications

Date 7-30-01

ANTHONY CLARKE

System Location (Indicate correct number and street)

Address 12001 N 40TH (no rural route) City LINCOLN NE. Zip 68503

A. Building Sewer

1. Material: CLS 160
   Diameter: 4 in.
2. Distance above basement floor: _____ in.
   or distance below basement floor: 14 in.
3. Distance between dwelling and septic tank: 198 ft.
4. Number of clean-outs: 3
5. Distances to: well or suction line 100+ ft.
   stream 100+ ft.
   pressure line 100+ ft.
   property line _____ ft.

B. Septic Tank

1. Material: CONC
   Number of compartments: 1
2. Capacity: 1250 gal.
3. Factory built: ☑ Yes ☐ No
4. Manholes: Over inlet, diameter _____ in.
   Over outlet, diameter _____ in.
   Riser: ☑ above ☐ below grade 6 in.
5. Inlet: ☑ baffle ☐ tee
6. Outlet: ☑ baffle ☐ tee
7. Depth to top of tank, below unfinished grade: 6 in.
8. Distances to: Well or suction line 100+ ft.
   Stream 100+ ft.
   Pressure line 100+ ft.
   Property line 30 ft.

C. Distribution Box

1. Material: CONC
   Number available outlets: 5
2. Factory built: ☑ Yes ☐ No
3. Distance from septic tank: 11 ft.

D. Absorption Field


(Provide as-built drawings on back of this form)

1. Type: ☐ Half rounds ☐ Perforated pipe
   Diameter of half round: _____
   or perforated pipe: _____
   Material: ☐ fiberglass ☐ plastic ☐ concrete
   ☑ other HIGH CAPACITY EQUALIZER
2. Lateral lines: Number 4
   Length of each line: 102 ft. 102 ft.
   90 ft. 34 ft. _____ ft.
3. Trench dimensions: Width 3.5 ft.
   Slope 0 in/100 ft.
   Average depth 27 in
4. Filter material: GRAVEL-LESS
   Depth of material _____ in.
5. Distances to: Well or suction line 100+ ft.
   Stream 100+ ft.
   Pressure line 100+ ft.
   Property line 40 ft.


Indicate North with Arrow

Complete "As Built" drawing on back of this form.

Individual Sewage System Design (Example)

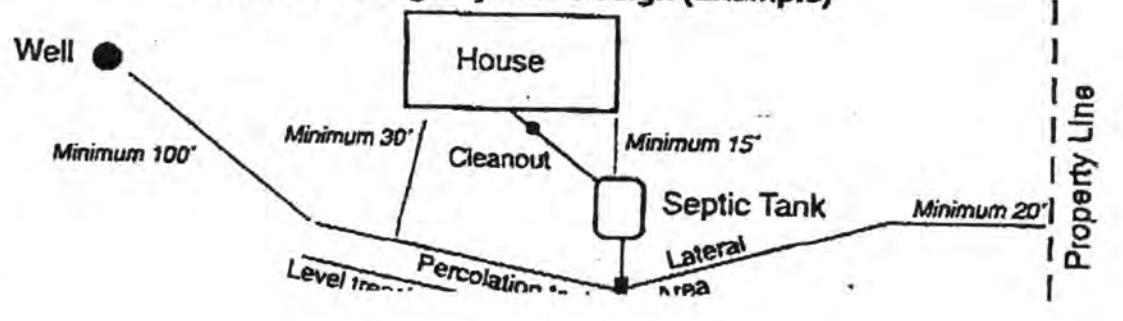

As Built Drawing

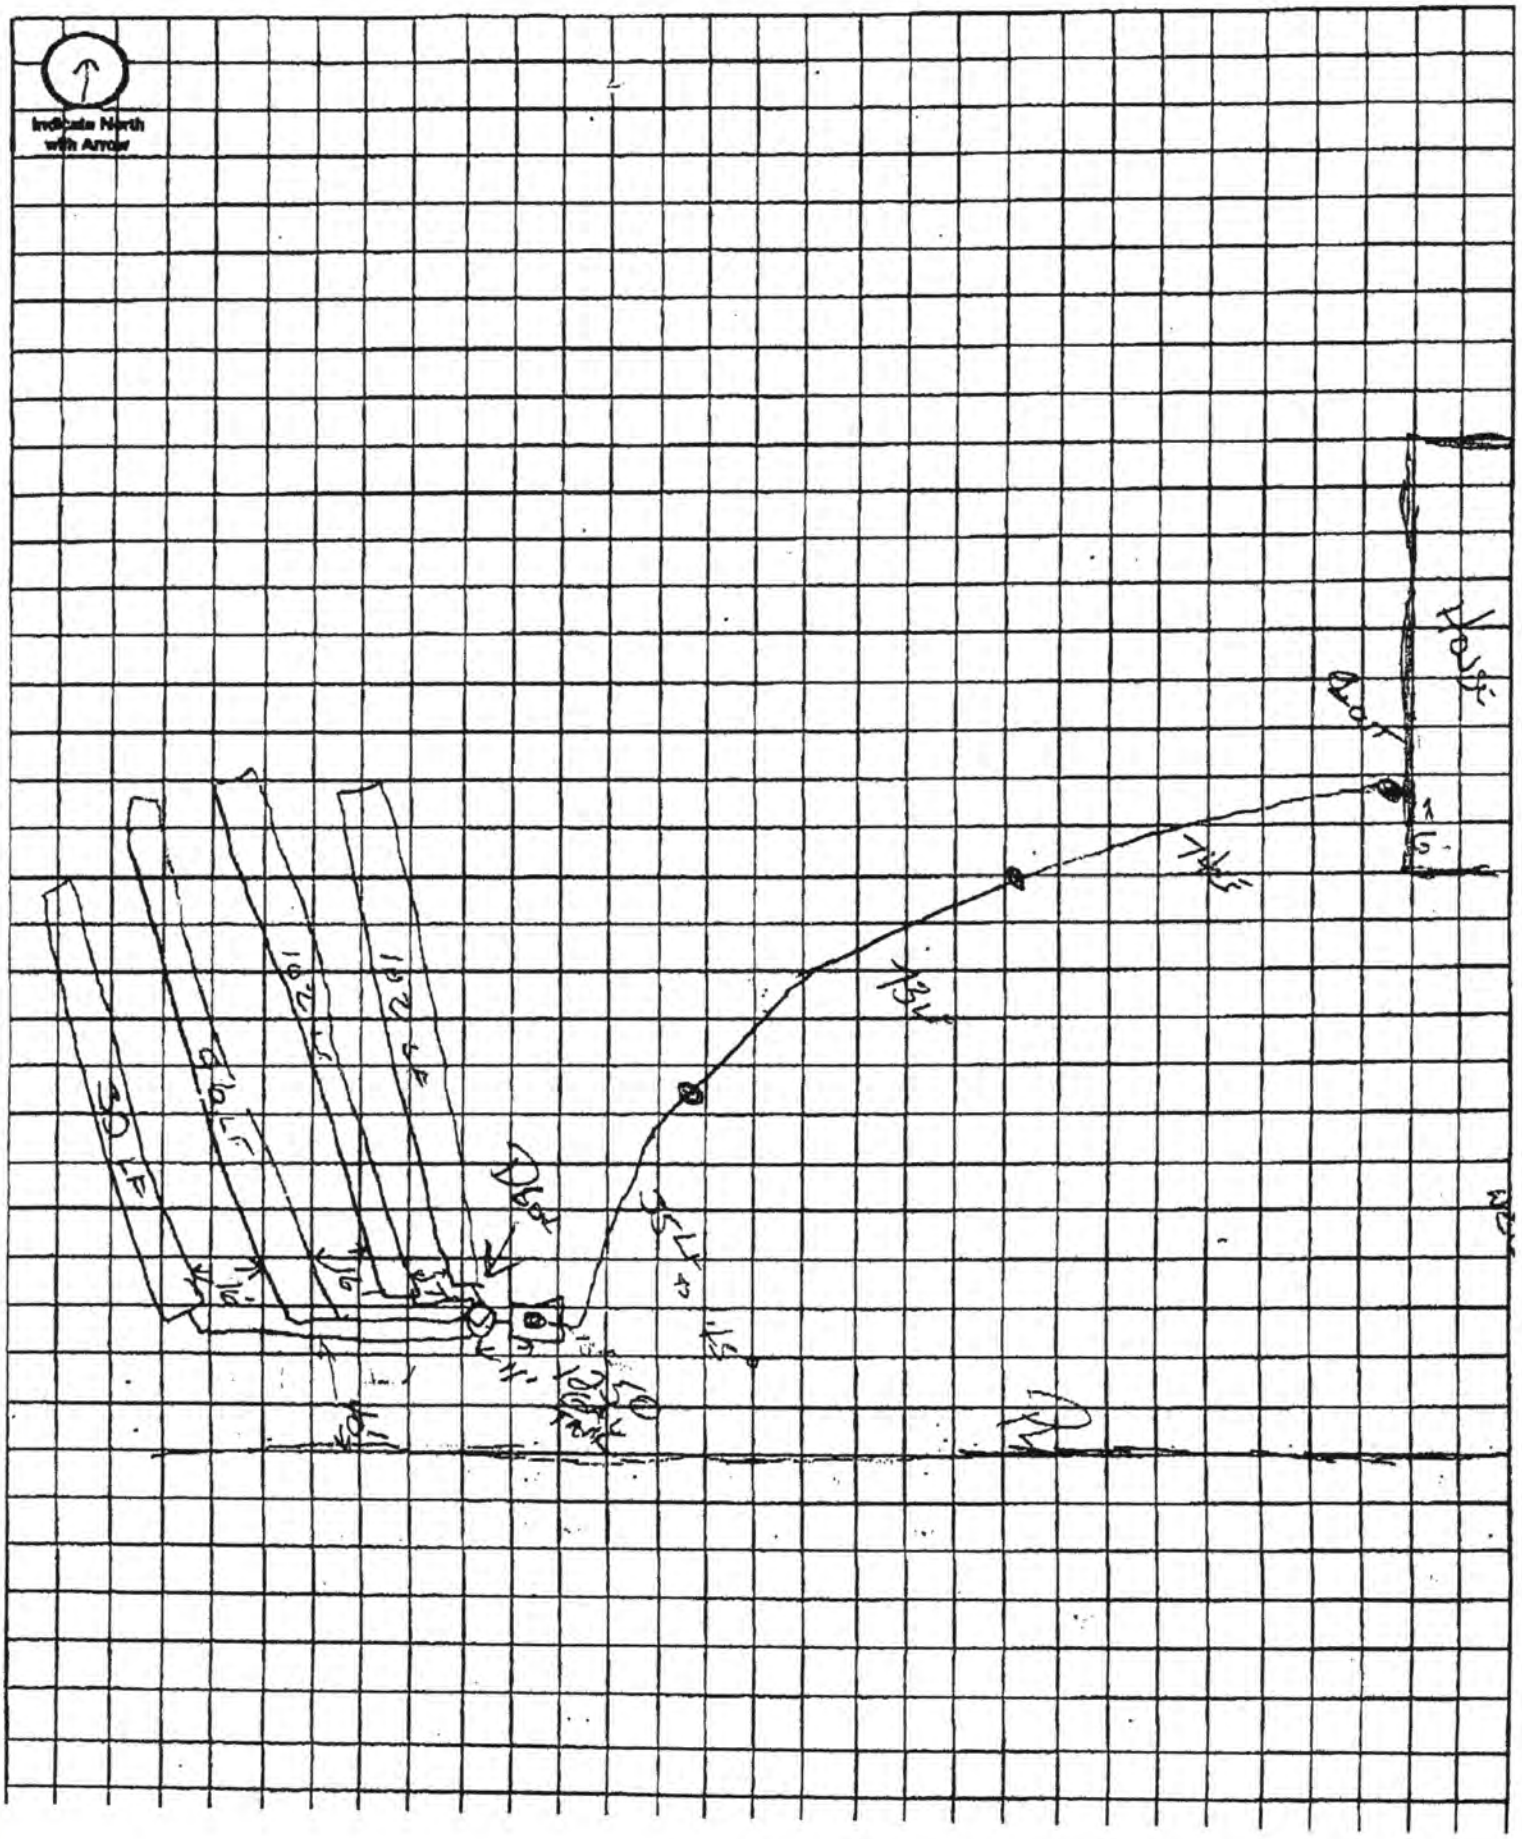


