LINCOLN-LANCASTER COUNTY HEALTH DEPARTMENT

FILE NO. 1471-C

INDIVIDUAL SEWAGE SYSTEM CONSTRUCTION — TYPE OF PERMIT

May 22, 1979 — THIS PERMIT EXPIRES

Roy Pester — ISSUED TO

1209 Galloway, Lincoln, NE 68512 — ADDRESS

T11N, R7E, Section 8 — LEGAL DESCRIPTION

REMARKS: NON-TRANSFERABLE

PERMIT	INSPECTION FEE	OCCUPATION TAX	TOTAL
$ 30.00	$	$	$ 30.00
ACCOUNTING NO.	ACCOUNTING NO.	ACCOUNTING NO.	CODE
	110.16	148.14	6-2

RECEIPTED BY — DATE — AMOUNT

VALID RECEIPT ONLY IF RECEIPTED IN THIS SPACE

HEALTH — ISSUING OFFICER

THIS PERMIT IS ISSUED AS PROVIDED BY COUNTY RESOLUTION NO. 2832

20109-0977

FORM 20103-0477
REQUEST FOR SITE CLEARANCE AND PERMIT
FOR INDIVIDUAL SEWAGE DISPOSAL SYSTEM
City Ordinance No. 9150 ☐
County Resolution No. 2832 ☒

LINCOLN-LANCASTER COUNTY HEALTH DEPARTMENT
Division of Environmental Health
2200 St. Marys Avenue
Lincoln, Nebraska 68502
Phone: 474-1541

A

FILING FEE: $ 30.00

FILE NO. 1471-C

DATE: 21 NOV 78

The undersigned hereby requests SITE CLEARANCE and PERMIT to construct an Individual Sewage Disposal System in conformance with appropriate resolution or ordinance, as described herein:

1. Legal description of property: Twp. 11N ; Range 7E ; Section 8 ; Block _____ : Lot _____ : Addition SEE ATTACHED
   Street Address @ 51st & Waverly Road
2. Property Use: Residential ☒ ; Commercial ☐ Other Use ☐
   No. of Bedrooms 3 . Describe _____
3. Type of Individual Sewage Disposal System: Septic Tank ☒ ; Other ☐
4. Distance to public sewer: @ 3 miles

Roy Lester
Signature of Applicant (Owner or Lessee)

1209 Galloway, Lincoln, Neb. 68512
Address

(Do not write below this double line)

1. Health Department: Date Rec'd. 11/22/78. Date Frwd. 11/22/78. ACTION: Approved ☒ Disapproved ☐ Signature: Gerald C. Hood
2. Supt. Bldg. Insp.: or Village Clerk Date Rec'd. 11/22/78. Date Frwd. 11/22/78. ACTION: Approved ☒ Disapproved ☐ Signature: Bob Sons
3. City or County Engineer: Date Rec'd. 11-22-78. Date Frwd. 11-22-78. ACTION: Approved ☒ Disapproved ☐ Signature: Henry Graff

REMARKS OR REASONS FOR DISAPPROVAL _____

Site Visits:
Date: 9-11-79 by: jmr half rounds being placed in latrines
Date: _____ by: _____
Date: _____ by: _____

INSTALLATION FINAL WRITTEN APPROVAL
Date: 9-28-79 By: James Newerka

White: Health Dept. Copy
Yellow: Engineers Copy
Pink: Bldg. Inspector's Copy

7747 Waverly Rd.

FORM 20105-0477
SOIL ABSORPTION TEST DATA REPORT
(Annex to Application)
(Reference: City Ordinance No. 9150 and County Resolution No. 2832)

LINCOLN-LANCASTER COUNTY HEALTH DEPARTMENT
Division of Environmental Health
2200 St. Marys Avenue
Lincoln, Nebraska 68502
Phone: 474-1541

B

FILE NO. 1471-C

PROPERTY WHERE SOIL TESTED:

Location: Township_____; Range_____; Section & ¼ Section_____.
Property Dimensions: _____ft. x _____ft. Area:_____acres. (Attach Sheet C with sketch of property).
Soil Type: Silty Clay ☐ ; Silty Clay Loam ☒ ; Sandy Loam ☐ ; Silt Loam ☐ ; Clay Loam ☐.
Dates of Tests: 11-4-78 to 11-5-78. Weather: Precip. 0 Temp. 40s.

OWNER:_____

Address:_____

PERCOLATION TEST DATA TABLE

a.	b.	c.	d.	e.	f.	g.	h.	i.	j.	k.	l.	m.	n.
		Pre-Saturation Period				Percolation Readings						Results	
		Start		End		Start			End				
Hold No.	Hole Depth (in.)	Date (Mo./ Day)	Time (Hr./ Min.)	Date (Mo./ Day)	Time (Hr./ Min.)	Date (Mo./ Day)	Time (Hr./ Min.)	Water Level (in.)	Time (Hr./ Day)	Water Level (in.)	Elapsed Time (Min.)	Water Level Drop (in.)	Percolation Rates (Min./in.)
1	32"	11/4	12 30 PM	11/5	1 PM	11/5	1 PM	12"	4 30 PM	7 1/4	30M	1/2	
2										2 1/2		1 3/4	
3										4 1/2			
4										9 1/2		1/4	
5										9 1/4		1/4	
6										4 3/4		3/4	

Robert D Johnson
Signature of Person Conducting Test

Address 2618 No 3rd Phone 432 3595

Sum of Percolation Rates: _____
Average of Rates: _____
Mean of Rates: _____

(Do not write below this line)

REVIEWING ACTION

Remarks:_____
Soil Type (SCS): Shorthorn Silty Clay Loam
Date: November 21, 1978

Approved Percolation Rate (a)
A. 53 min./inch
B._____ min./inch
C._____ min./inch

Gerald C. Hood
Signature of Reviewing Official

FORM 20102-0477
PRELIMINARY PLANS & SPECIFICATIONS FOR SEWAGE DISPOSAL SYSTEM (Annex to Application)
City Ordinance No. 9150 ☐
County Resolution No. 2832 ☐


LINCOLN-LANCASTER COUNTY HEALTH DEPARTMENT
Division of Environmental Health
2200 St. Marys Avenue
Lincoln, Nebraska 68502
Phone: 474-1541

C

Sketch of property showing Percolation Test hole locations, well, residence, direction and property line.

FILE NO. 1472-C

Indicate on sketch if residence and well are exisiting or proposed.

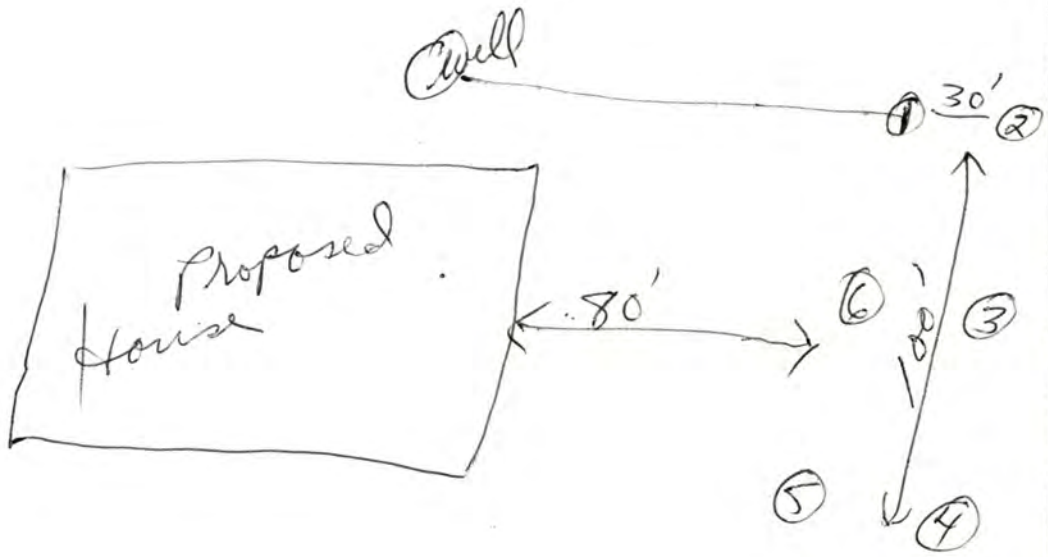

REVIEWING ACTION

Remarks: _____

Date: November 21, 1978

Minimum Design Requirement
1. Capacity of Septic Tank 1000 gals.
2. Total Length of Laterals 234 ft.
3. With a Trench Width of 48 in.
4. Total Area of Lateral needed 938 sq.ft.

Jerrold C. Hood
Signature of Reviewing Official

FORM 20104-0477
PLANS & SPECIFICATIONS FOR SEWAGE DISPOSAL SYSTEM (Annex to Application)
City Ordinance No. 9150 ☐
County Resolution No. 2832 ☐

LINCOLN-LANCASTER COUNTY HEALTH DEPARTMENT
Division of Environmental Health
2200 St. Marys Avenue
Lincoln, Nebraska 68502
Phone: 474-1541

D

DATE: _____

FILE NO. 1472-C


SPECIFICATIONS AS BUILT

A. BUILDING SEWER:
1. Material _____; Diameter _____ in.
2. Distance above basement floor _____ in., or below basement floor _____ in.
3. Distance between dwelling and septic tank _____ ft.
4. Number of clean-outs _____.
5. Distances to:
Well or Suction Line _____ ft.; Stream _____ ft.; Pressure Line _____ ft.; Property Line _____ ft.

B. SEPTIC TANK:
1. Material Concrete; No. of compartments 1.
2. Capacity 1000 gals.;
3. Factory Built: Yes ☒ No ☐
(Company Pre Cast Step Co)
4. Manholes: Over Inlet; diam. 6 in.
Over Outlet; diam. 4 in.
Riser Above ☐ Below ☐ Grade ___ in.
5. Inlet: Baffle ☒ ; or Tee ☐
6. Outlet: Baffle ☒ ; or Tee ☐
7. Depth of top of tank below finished grade _____ in.
8. Distances to:
Well or Suction Line 100 + ft.; Stream _____ ft.; Pressure Line _____ ft.; Property Line _____ ft.

C. DISTRIBUTION BOX:
1. Material Concrete; Number - available outlets 5.
2. Factory Built: Yes ☒ No ☐
(Company Pre Cast Step)
3. Distance from Septic Tank 1 ft.

D. ABSORPTION FIELD: (Provide as built drawings on back of this form)
1. Type: Half Rounds ☒ Perforated Pipe ☐
Diameter of Half Round 20" or Perforated Pipe _____.
Material: fiberglass ☐ ; plastic ☐ ; concrete ☒ ; other _____.
2. Lateral Lines:
Number ___ ; Length of each line _____, _____, _____, _____, _____ ft.;
Total length of laterals _____ ft.;
Distance between lateral lines ___ ft.
3. Trench dimensions: Width _____ ft.;
Slope _____ in/100 ft.; Average Depth _____ in.
4. Filter Material: Road Gravel
Depth of Material _____ in.
5. Distances to:
Well or Suction Line 100 + ft.; Stream _____ ft.; Pressure Line _____ ft.; Property Line _____ ft.

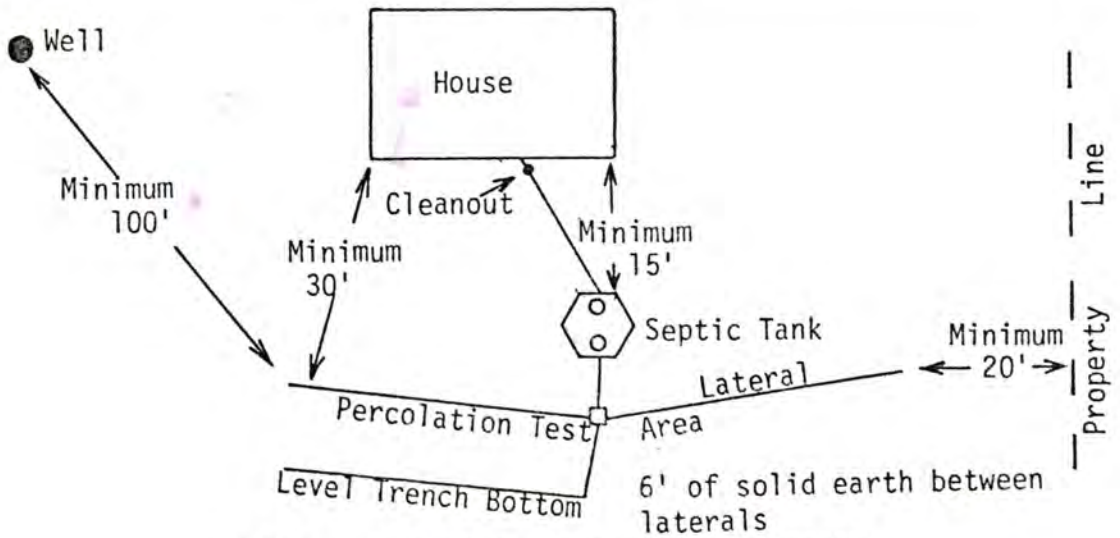


TYPICAL INDIVIDUAL SEWAGE SYSTEM DESIGN

AS BUILT DRAWING OF SYSTEM

DATE 9-11-22 INSTALLER Vogt Trenching & Trucking

Roy Foster
4900 Waverly Road

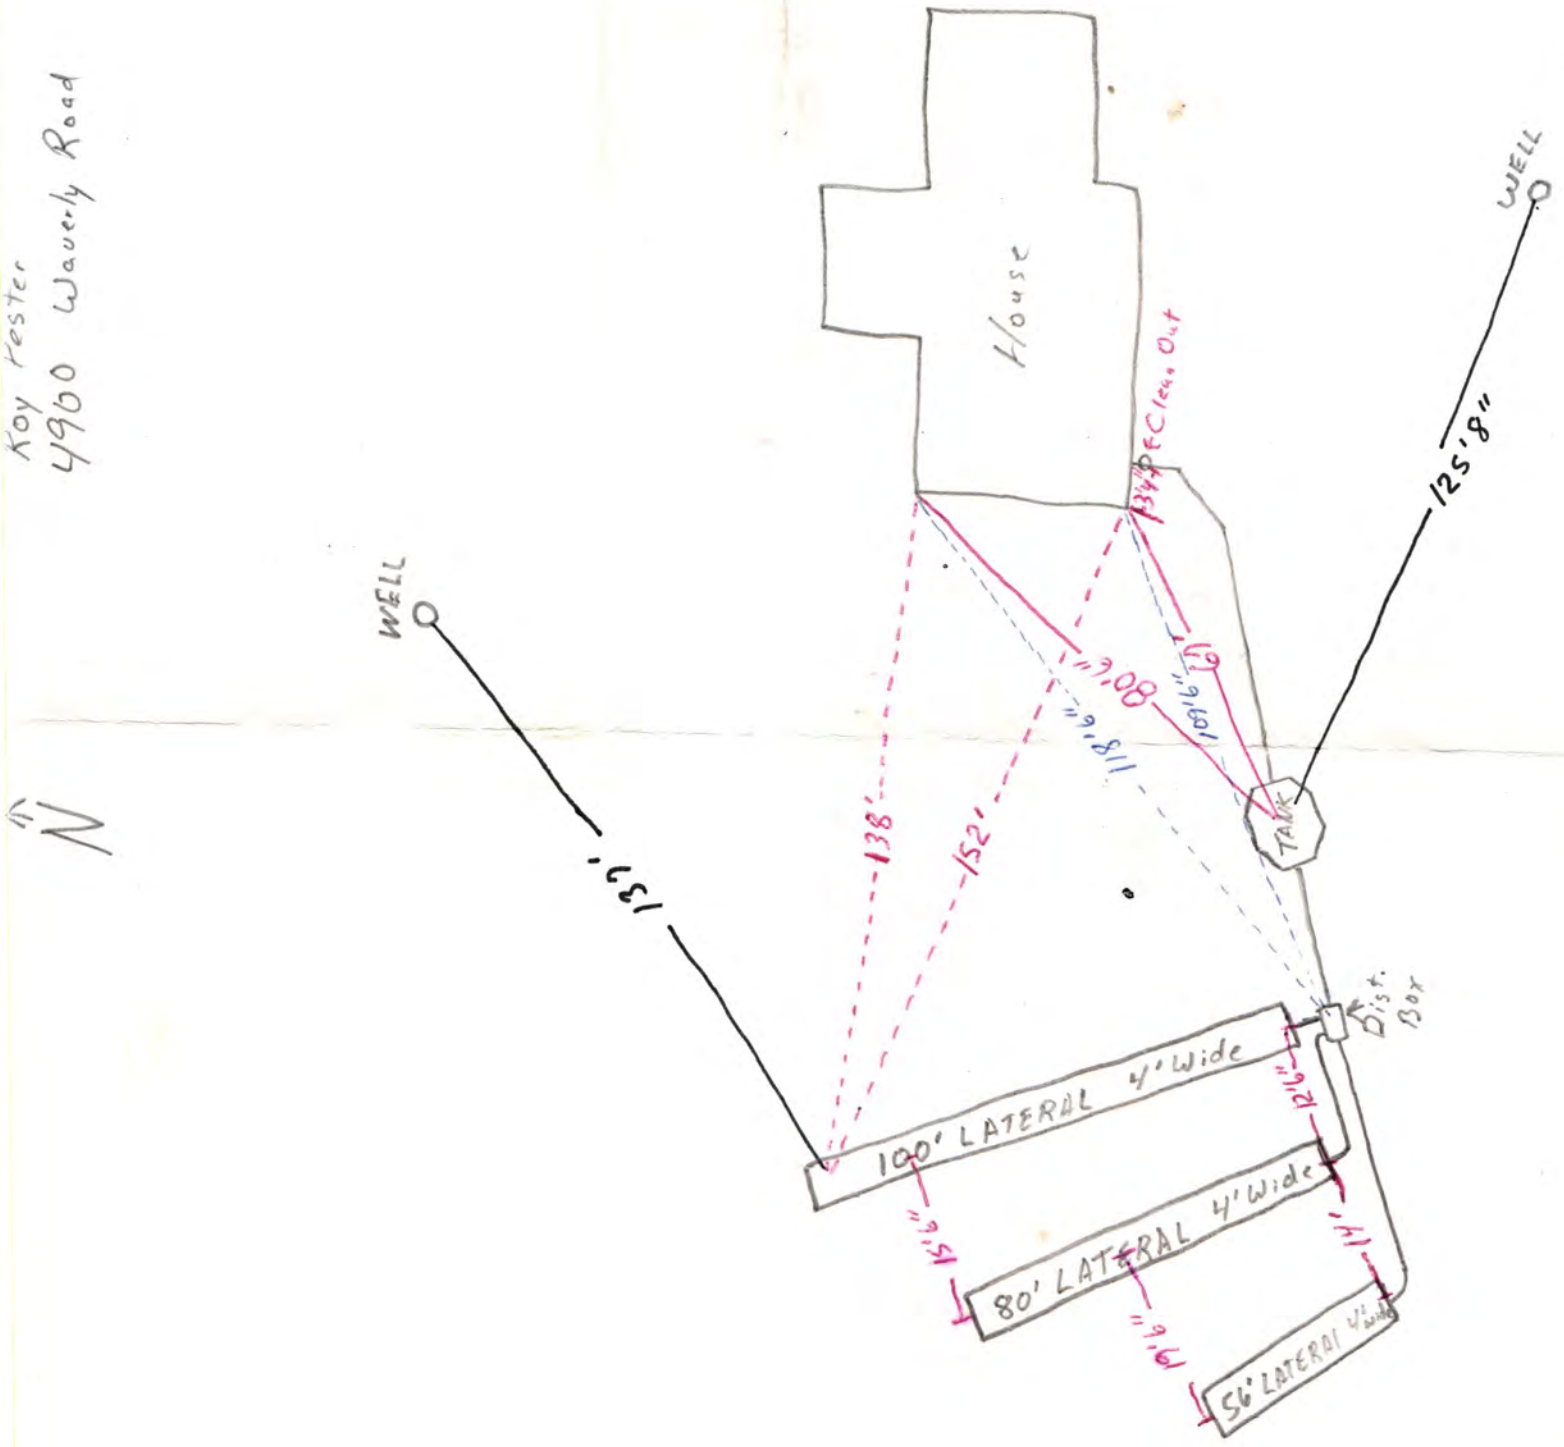

Survey Record


78- 172
JOB NO.

LANCASTER COUNTY, NEBRASKA

BATES AND ASSOCIATES
911 ADAMS – LINCOLN, NEBRASKA

PHONE 432-3724

Survey of: AN IRREG TRACT SITUATED IN SW¼ SE¼ **Section** 8 **T.** 11 **N, R.** 7 **E of 6th P.M.**

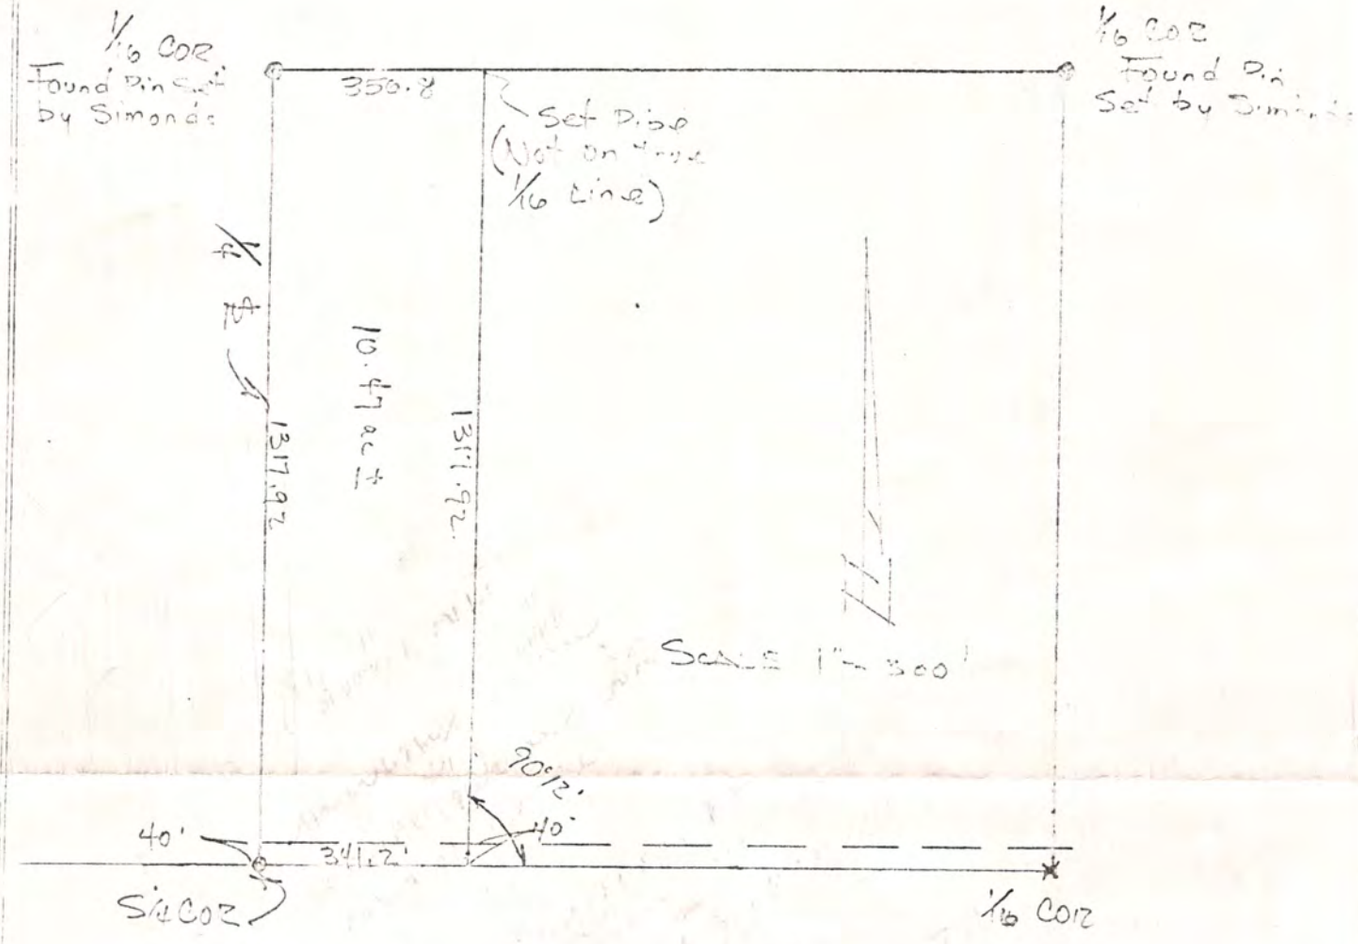

An Irregular tract of land situated in the southwest ¼ of the southeast ¼ of sec. 8, T11N R7E of the 6th. P.M., Lancaster County Nebr., more particularly described as follows;
Beginning at the south ¼ corner of sec. 8, thence east along the south line of the said sec., a dist. of 341.2'; thence north on a line deflecting 90°12' to the left, a dist. of 1317.92': thence west on a line parallel to the south line of the said sec., a dist. of 350.8' to a point on the west line of the SE ¼; thence south along the west line of the SE ¼, a dist. of 1317.92' to the point of beginning, the said tract containing 10.47 acres of which 0.31 acres is county road right of way.

I hereby certify that I have accurately surveyed each lot as shown hereon and each lot corner has been well and accurately staked and marked with metal stakes.

LS-252

Signed this 31 day of May 19 78

Name: [signature]

Surveyor's license No. L.S. 252