LINCOLN-LANCASTER COUNTY HEALTH DEPARTMENT

Division of Environmental Health

2200 St. Marys Ave Lincoln, NE 68502 (402) 471-8000

NON TRANSFERABLE

PERMIT

SEWAGE INSTALLATION

No. 89380006701

Issued 11/03/89

Expires 05/03/90

ESTABLISHMENT

JEANNE HANSEN
T11N R6E SEC 21 QTR SW
SW 1/4

FEES: Permit 018754 $60.00

Total $60.00

Issued By COUNTY HEALTH

PERMITTEE

JEANNE HANSEN
4317 BALWIN AV
LINCOLN NE 68504

VALID RECEIPT ONLY IF RECEIPTED IN THIS SPACE	
DATE	AMOUNT

THIS LICENSE OR PERMIT IS ISSUED SUBJECT TO REVOCATION AS PROVIDED BY LAW

8938000067

FORM 20103-0477
REQUEST FOR SITE CLEARANCE AND PERMIT
FOR INDIVIDUAL SEWAGE DISPOSAL SYSTEM
City Ordinance No. 9150 ☐
County Resolution No. 2832 ☒

LINCOLN-LANCASTER COUNTY HEALTH DEPARTMENT
Division of Environmental Health
2200 St. Marys Avenue
Lincoln, Nebraska 68502
Phone: 471-7800

A

FILING FEE: $ 60.00

FILE NO. _____

DATE: Sept. 29, 1989

The undersigned hereby requests SITE CLEARANCE and PERMIT to construct an Individual Sewage Disposal System in conformance with appropriate resolution or ordinance, as described herein:

1. Legal description of property: Twp. 11 north ; Range 6 east ; Section SW ¼ of 21;
   Block _____ : Lot _____ : Addition _____
   Street Address 2000 W. McKelvie Rd. Lincoln, NE 68524

2. Property Use: Residential ☒ ; Commercial ☐ Other Use ☐
   No. of Bedrooms 3 . Describe _____

3. Type of Individual Sewage Disposal System: Septic Tank ☒ ; Other ☐

4. Distance to public sewer: _____ ft.

Jeanne M. Hansen
Signature of Applicant (Owner or Lessee)

4317 Baldwin Ave
Address

(Do not write below this double line)

1. Health Department: Date Rec'd. 11/3/89. Date Frwd. 11/6/89. ACTION: Approved ☒ Disapproved ☐ Signature: Jerrold C. Wood

2. Supt. Bldg. Insp.: or Village Clerk: Date Rec'd. 11-6-89. Date Frwd. 11-6-89. ACTION: Approved ☒ Disapproved ☐ Signature: Paul Baesso

3. City or County Engineer: Date Rec'd. 11/6/89. Date Frwd. 11/6/89. ACTION: Approved ☒ Disapproved ☐ Signature: Dan Thomas

REMARKS OR REASONS FOR DISAPPROVAL HAS WELL PERMIT

Site Visits:
Date: 5-22-90 by: ~~~ need dump
Date: 9-24-96 by: ~~~ sewer line to house
Date: _____ by: _____

INSTALLATION FINAL WRITTEN APPROVAL
Date: 11-19-96 By: Ron Maynard

White: Health Dept. Copy
Yellow: Engineers Copy
Pink: Bldg. Inspector's Copy

FORM 23-43

FORM 20105-0477
SOIL ABSORPTION TEST DATA REPORT
(Annex to Application)
(Reference: City Ordinance No. 9150 and County Resolution No. 2832)

LINCOLN-LANCASTER COUNTY HEALTH DEPARTMENT
Division of Environmental Health
2200 St. Marys Avenue
Lincoln, Nebraska 68502
Phone: 471-7800

B

FILE NO. _____

PROPERTY WHERE SOIL TESTED:

Location: Township 11 North ; Range 6 East ; Section & ¼ Section SW¼ of 21.
Property Dimensions: 784' ft. x 1325 ft. Area: 20.876 acres. (Attach Sheet C with sketch of property).
Soil Type: Silty Clay ☐ ; Silty Clay Loam ☐ ; Sandy Loam ☒ ; Silt Loam ☐ ; Clay Loam ☐ .
Dates of Tests: 9-29-89 to 9-29-89 . Weather: Precip. 0 Temp. 80 .

OWNER: Joanne Hansen

Address: 4317 Baldwin Ave

PERCOLATION TEST DATA TABLE

a.	b.	c.	d.	e.	f.	g.	h.	i.	j.	k.	l.	m.	n.
		Pre-Saturation Period				Percolation Readings						Results	
		Start		End		Start			End				
Hold No.	Hole Depth (in.)	Date (Mo./ Day)	Time (Hr./ Min.)	Date (Mo./ Day)	Time (Hr./ Min.)	Date (Mo./ Day)	Time (Hr./ Min.)	Water Level (in.)	Time (Hr./ Day)	Water Level (in.)	Elapsed Time (Min.)	Water Level Drop (in.)	Percolation Rates (Min./in.)
*	36"	9-29-89	12:00	9-29-89	1:55	9-29-89	2:00	6½"	3:00	0	10 m	6½"	
2	36"	9-29-89	12:00	9-29-89	1:55	9-29-89	2:00	7½"	3:00	0	10 m	7½"	
3	36"	9-29-89	12:00	9-29-89	1:55	9-29-89	2:00	10"	3:00	3"	10 m	7"	
4	36"	9-29-89	12:00	9-29-89	1:55	9-29-89	2:00	6¼"	3:00	0	10 m	6¼"	
5	36"	9-29-89	12:00	9-29-89	1:55	9-29-89	2:00	6"	3:00	0	10 m	6"	
6	36"	9-29-89	12:00	9-29-89	1:55	9-29-89	2:00	7"	3:00	3¼"	10 m	3¾"	

Sum of Percolation Rates: _____
Average of Rates: _____
Mean of Rates: _____

Joanne Hansen
Signature of Person Conducting Test

Address 4317 Baldwin Phone 467-2034

(Do not write below this line)

REVIEWING ACTION

Remarks: _____

Soil Type (SCS): MORRILL CLAY LOAM

Date: NOVEMBER 3, 1989

Approved Percolation Rate (a)
A. 2 min./inch
B. _____ min./inch
C. _____ min./inch

Jerrold C. Hood
Signature of Reviewing Official

FORM 20102-0477
PRELIMINARY PLANS & SPECIFICATIONS FOR SEWAGE DISPOSAL SYSTEM (Annex to Application)
City Ordinance No. 9150 ☐
County Resolution No. 2832 ☒


LINCOLN-LANCASTER COUNTY HEALTH DEPARTMENT
Division of Environmental Health
2200 St. Marys Avenue
Lincoln, Nebraska 68502
Phone: 471-7800

C

Sketch of property showing Percolation Test hole locations, well, residence, direction and property line.

FILE NO._____

Indicate on sketch if residence and well are exisiting or proposed.

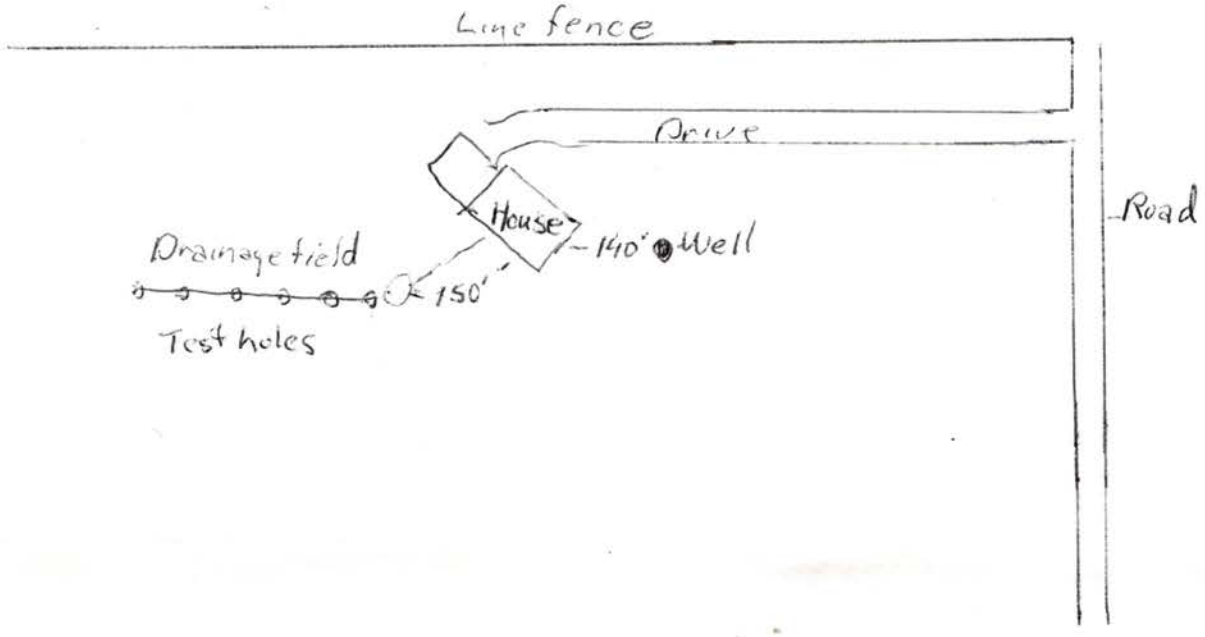

REVIEWING ACTION

Remarks:_____

Date: NOVEMBER 3, 1989

Minimum Design Requirement
1. Capacity of Septic Tank 1000 gals.
2. Total Length of Laterals 64 ft.
3. With a Trench Width of 48 in.
4. Total Area of Lateral needed 255 sq.ft.

Jerrold C. Hood
Signature of Reviewing Official

NOV 1 8 1996

FORM 20104-0477
PLANS & SPECIFICATIONS FOR SEWAGE DISPOSAL SYSTEM (Annex to Application)
City Ordinance No. 9150 ☐
County Resolution No. 2832 ☐

Lincoln-Lancaster County Health Dept.
3140 "N" Street
Lincoln, NE 68510

D

DATE: Oct 30

FILE NO: _____


SPECIFICATIONS AS BUILT

A. BUILDING SEWER:
1. Material PVC; Diameter 4" in.
2. Distance above basement floor _____ in., or below basement floor 8"-18" in.
3. Distance between dwelling and septic tank 110 ft.
4. Number of clean-outs 1.
5. Distances to: Well or Suction Line 112 ft.; Stream N/A ft.; Pressure Line _____ ft.; Property Line 170 ft.

B. SEPTIC TANK:
1. Material Concrete; No. of compartments 1.
2. Capacity 1000 gals.;
3. Factory Built: Yes ☑ No ☐ (Company Pre Cast)
4. Manholes: Over Inlet; diam. NA in. No Risers Over Outlet; diam. NA in. No Riser Above ☐ Below ☑ Grade 6" in.
5. Inlet: Baffle ☐ ; or Tee ☐
6. Outlet: Baffle ☐ ; or Tee ☐
7. Depth of top of tank below finished grade 6" in.
8. Distances to: Well or Suction Line 255 ft.; Stream N/A ft.; Pressure Line 170 ft.; Property Line 180 ft.


C. DISTRIBUTION BOX:
1. Material Concrete; Number - available outlets 5.
2. Factory Built: Yes ☑ No ☐ (Company Pre Cast)
3. Distance from Septic Tank 4' ft.

D. ABSORPTION FIELD: (Provide as built drawings on back of this form)
1. Type: Half Rounds ☑ Perforated Pipe ☐ Diameter of Half Round 20" or Perforated Pipe _____. Material: fiberglass ☐ ; plastic ☐ ; concrete ☑ ; other _____.
2. Lateral Lines: Number 1 ; Length of each line 60, _____, _____, _____, _____ ft.; Total length of laterals 60 ft.; Distance between lateral lines NA ft.
3. Trench dimensions: Width 4' ft.; Slope 3" in/100 ft.; Average Depth 40 in.
4. Filter Material: Gravel Depth of Material 32" in.
5. Distances to: Well or Suction Line 260 ft.; Stream NA ft.; Pressure Line 175 ft.; Property Line 185 ft.

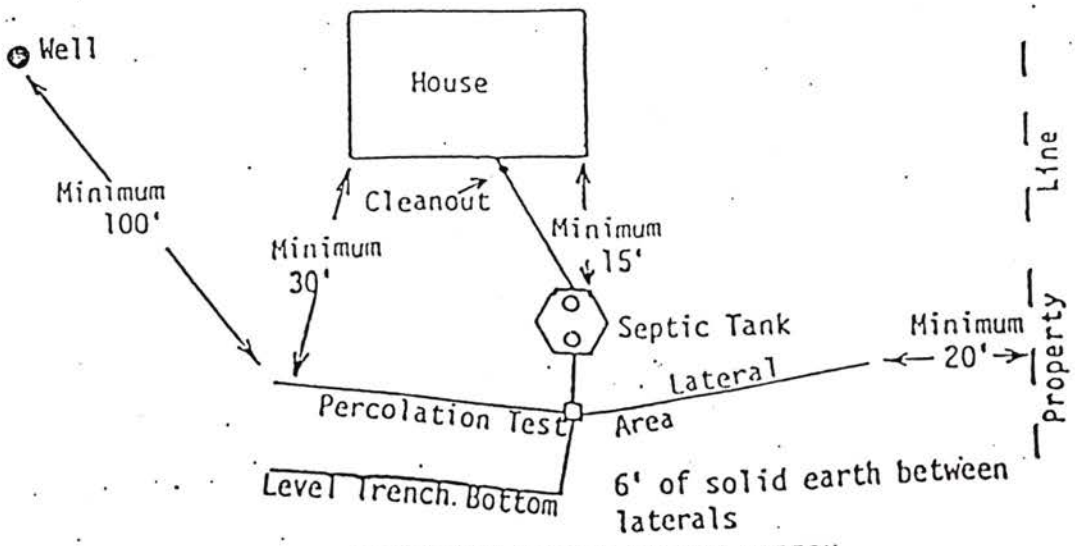


TYPICAL INDIVIDUAL SEWAGE SYSTEM DESIGN

Jeanne Hensen 2000 W McKelvie, Lincoln Ne

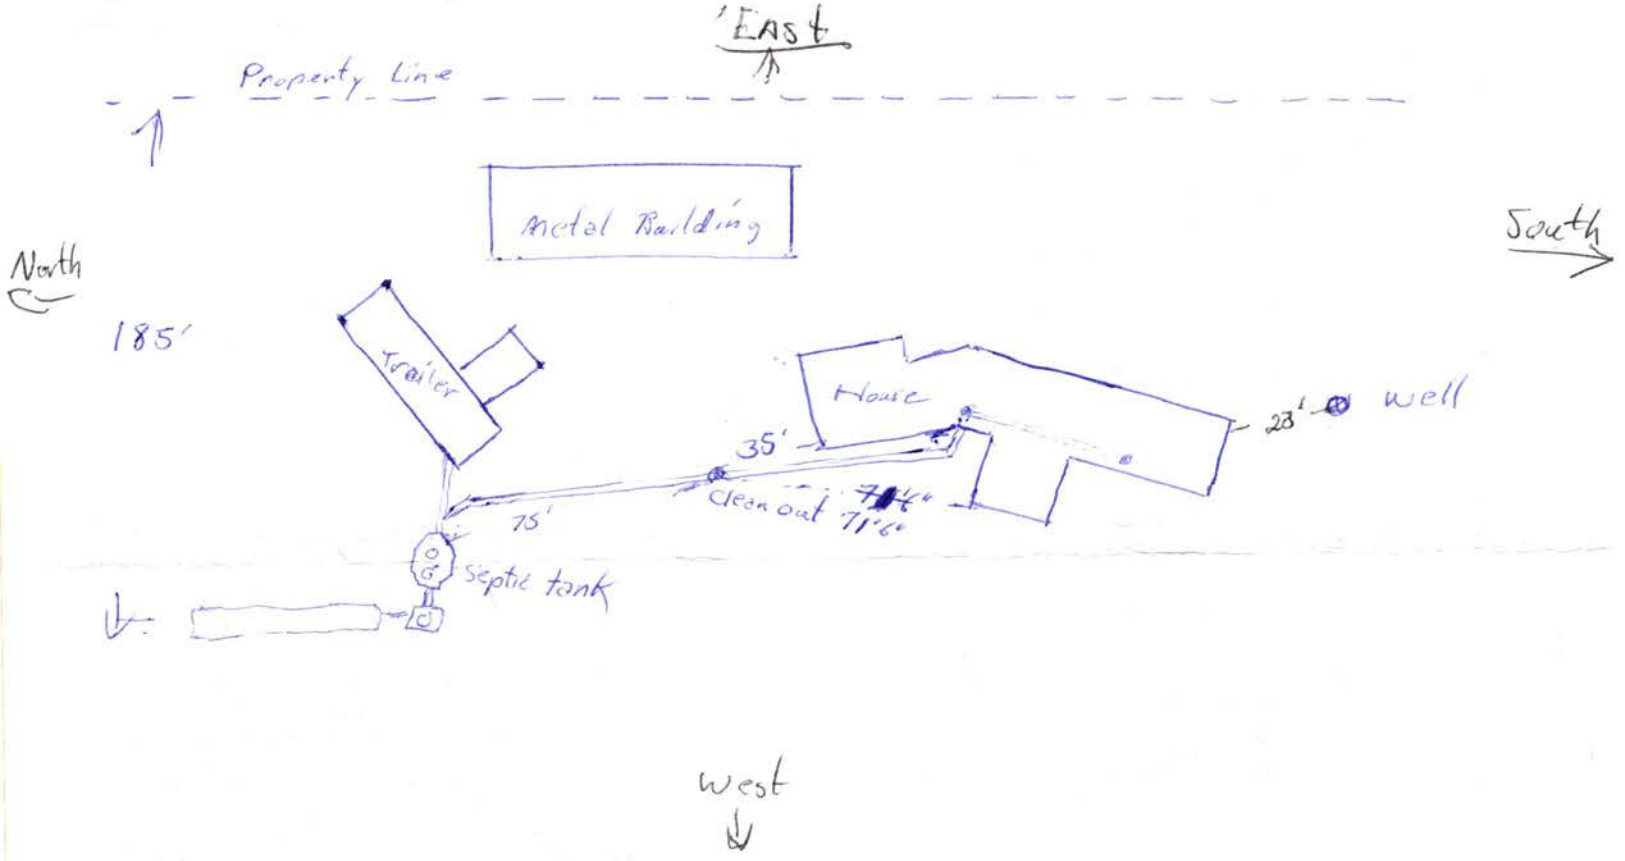

west

Oo

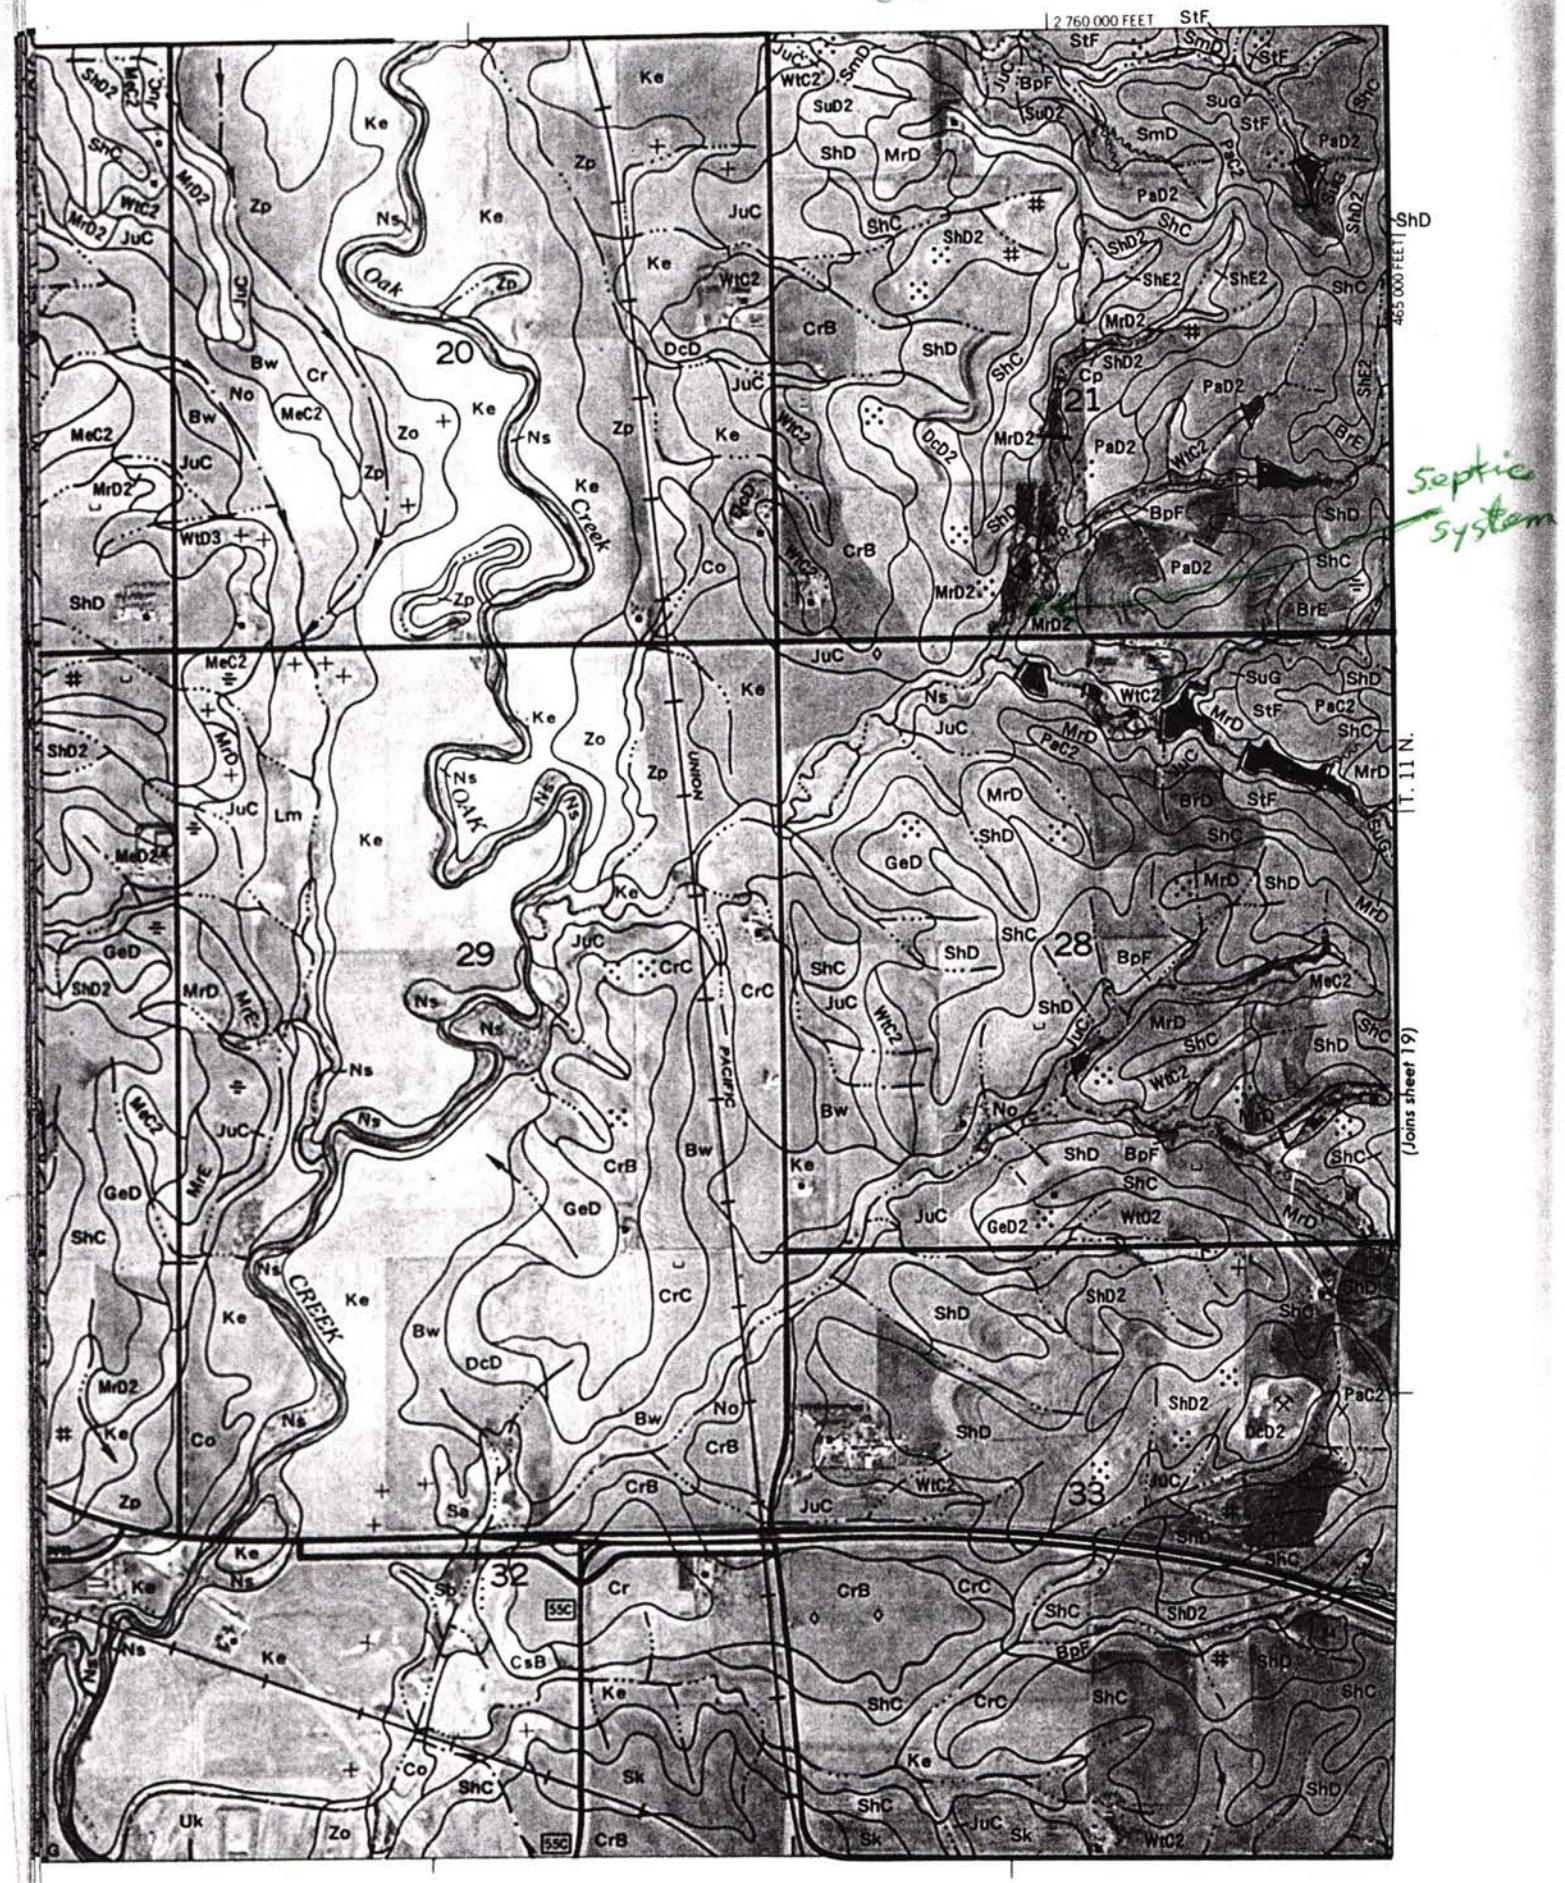

septic system