LINCOLN-LANCASTER COUNTY HEALTH DEPARTMENT

ENVIRONMENTAL HEALTH DIVISION

3140 "N" STREET
Lincoln, NE 68510-1514
(402) 441-8000

NON TRANSFERABLE

PERMIT

Permit
SEWAGE INSTALLATION
LAGOON

No. 98380174101

Issued 04/17/98
Expires 10/17/98
Revenue Code 3157

FEES: $150.00

PAID

Establishment
JERRY L HOSTETLER
T11N R6E SEC 2 QTR SE
LOT 11
14003 N 14 ST-RAYMOND

Permittee
JERRY L HOSTETLER
14003 N 14 ST
RAYMOND NE 68428

TOTAL $150.00

Issued By Health Director
Lincoln-Lancaster County Health Department

007208

THIS LICENSE OR PERMIT IS ISSUED SUBJECT TO REVOCATION AS PROVIDED BY LAW "POST IN A PROMINENT PLACE"

Lincoln-Lancaster County Health Department
Environmental Health Division
3140 "N" Street • Lincoln, NE 68510-1514
Phone: 402-441-8022

A

Permit Number:

Sewage Disposal System

Request for Site Clearance and Permit

Include Form B, Form C and Applicable Fees with this Application.

☐ Septic System ☒ Lagoon ☐ Other (Refer to Form C)

The undersigned hereby requests site clearance and permit to construct a Sewage Disposal System in conformance with appropriate resolution or ordinance, as described herein:

PLEASE PRINT OR TYPE

A. System Location (Indicate correct number and street)

Address 14003 N 14TH (no rural route) City LINCOLN-LANCASTER NE, Zip 68528

Legal Description SE 1/4 2 11N 6E — — Lot 11
1/4 1/4 Section Township Range Subdivision Addition Block Lot

Geographical Location (if known): Longitude _____ Latitude _____

☐ Check if system mail address is not the same as the owner's address

B. Owner

Name JERRY L HOSTETLER Signature _____

Address 14003 N 14TH City/State/Zip _____

☐ Check if owner designed system Home Phone _____ Work Phone New Residence

C. Contractor

Name MANN Custom Homes INC Company Name _____

Address 3121 South 6TH City/State/Zip Lincoln NE 68502

☐ Check if contractor designed system Work Phone 402 423 5384

D. Engineer/Installer ☐ Check and complete if engineer designed system

Designer Name Larry Schwarck SCHWARCK Firm LARRY SCHWARCK TECHNICIAN 8200 Old Cheney Rd. Work Phone 489 7294

E. This System Will Serve a

☑ Residential Dwelling Number of Bedrooms 3 Plan 4 Is there a Whirlpool Bathtub (YES) NO

☐ Commercial Establishment/Other Facility Specify _____

Design flow in gallons per day _____ Type of Wastewater: ☑ Domestic ☐ Non-Domestic.

DO NOT WRITE BELOW THIS LINE

Approval Process ☐ Municipal Code 24.38 ☒ County Resolution No. 2832

1. **Health Department** Date rec'd 4/16/98 Date frwd 4/17/98 ACTION ☒ Approved ☐ Disapproved Signature Jerrold C. Hool
2. **Supt. Bldg. Insp. or Village Clerk** Date rec'd 4.17.98 Date frwd 4.17.98 ACTION ☒ Approved ☐ Disapproved Signature _____
3. **City or County Engineer** Date rec'd 4-17-98 Date frwd 4-17-98 ACTION ☐ Approved ☐ Disapproved Signature _____

4-21-98 mm 15x48 sq. lagoon, need fence + levering
10-16-98 mm. no fence D.C. to call fence up.

Installation Final Written Approval

By Ron Mangus

Date 10-21-98

Business Office Use Only

Date Rec'd 4/16/98
Amt Paid $150.00
Rec'd By _____ Cash/Check No. 16769

FORM 23-100 10-96 White - Health Dept. Yellow - Engineer Pink - Bldg. Inspector

B

Lincoln-Lancaster County Health Department
Environmental Health Division
3140 "N" Street • Lincoln, NE 68510-1514
Phone: 402-441-8022

Permit Number:

Sewage Disposal System
Soil Absorption Test Data Report
Annex to Application

PLEASE PRINT OR TYPE

System Location (Indicate correct number and street)

Address 14003 N 14th (no rural route) City Lincoln/Lancaster NE. Zip 68528

Owner Jerry Hostetler Address Same New Residence

Soil Type (SCS) Clay Percolation Rate: _____ min./inch

Date of Tests 9-28-97 to 9-29-97 Weather: Precipitation 0 Temperature _____

Percolation Test Data Table

A.	B.	C. D. E. F. Pre-Saturation Period				G. H. I. J. K. Percolation Readings					L. M. N. Results		
		Start		End		Start			End				
Hole No.	Hole Depth (in)	Date (Mo/Da)	Time (Hr/Min)	Date (Mo/Da)	Time (Hr/Min)	Date (Mo/Da)	Time (Hr/Min)	Water Lev (in.)	Date (Mo/Da)	Time (Hr/Min)	Elapsed Time (Min)	Water Level Drop (in)	Percolation Rates (Min/in)
1	36	9-28	340P	9-29	750P	9-29	750P	6"	9-29	8:20P	30min	1/8	
2	36	9-28	340P	9-29	750P	9-29	750P	6"	9-29	820P	30	1/8	
3	36	9-28	340P	9-29	750P	9-29	750P	6"	9-29	820P	30	1/4	
4	36	9-28	340P	9-29	750P	9-29	750P	6"	9-29	820P	30	1/8	
5	36	9-28	340P	9-29	750P	9-29	750P	6"	9-29	820P	30	1/8	
6	36	9-28	340P	9-29	750P	9-29	750P	6"	9-29	820P	30	1/8	

Sum of Percolation Rates: _____

Average of Rates: _____

Rate Used for Calculation: _____

Person Conducting Percolation Tests

Name: Brian Shafer

Phone: 464-0638

Address 2200 Dan Ave.

DO NOT WRITE BELOW THIS LINE

Reviewing Action

Remarks _____

Signature of Reviewing Official _____ Date _____

EHD 33.101 10-97

Lincoln-Lancaster County Health Department
Environmental Health Division
3140 "N" Street • Lincoln, NE 68510-1514
Phone: 402-441-8022


C

Permit Number:

MANN

Sewage Disposal System
Preliminary Plan Specifications

Draw a plot plan showing system location, lines, distribution box, tank and laterals, percolation test hole locations, well, residence, compass direction and property lines. Indicate on drawing if residence and well are existing or proposed.

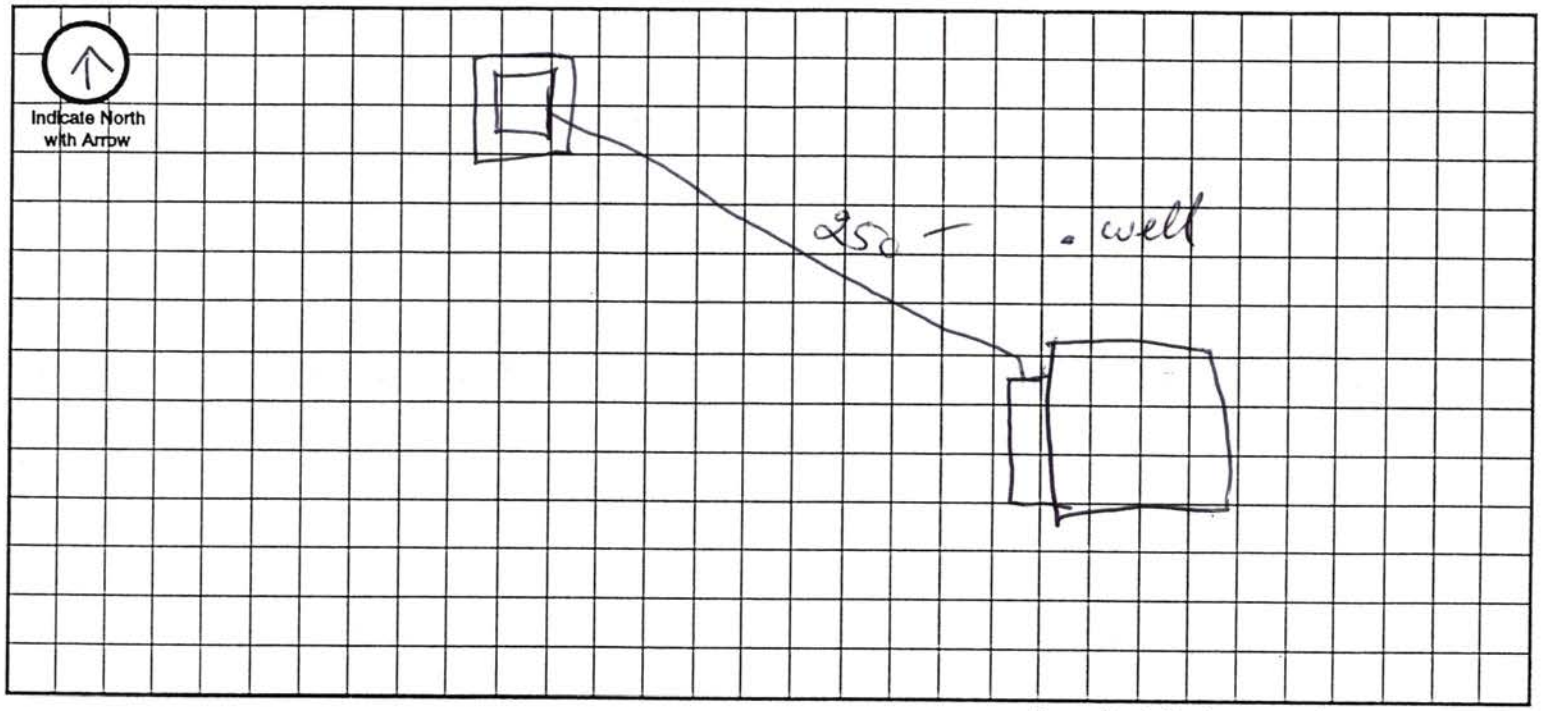

Approximate Scale: _____ ft. = _____ grid line/s

A. System Location (Indicate correct number and street)

Address (no rural route) 1403 N 14th City _____ NE, Zip _____

B. Proposed Septic Tank/s

Tank Material: ☐ Concrete ☐ Plastic ☐ Other Lagoon

C. Proposed Absorption System (See Form B for Percolation Information)

Percolation Rate _____ (min. per inch) Soil Type: _____ Land Slope: _____ %

Type of Absorption System: ☐ Trench ☐ Bed ☐ Other _____

Total Square Feet of Field Required: _____ sq. ft.

Type of Lateral: ☐ Half-Moon ☐ Perforated Pipe ☐ Other Lateral Material: _____

Capacity of Septic Tank _____ gals Number of Absorption Beds: _____ Number of Distribution Laterals per Bed _____

Total Length of Laterals _____ ft. Number of Trenches _____ Trench Width _____

D. Setbacks Check the Boxes Below if the Required Setback has been Satisfied

Distance From	Private Well	Public Well	Surface Water	Gound Water	Pressure Water Lines	Property Lines	Foundations Yours	Foundations Neighbors	All Other Setbacks
Tank (ft)	50 ☐	500 ☐	50 ☐	NA ☐	25 ☐	20 ☐	15 ☐	25 ☐	☐
Field (ft)	100 ☐	500 ☐	50 ☐	4 ☐	30 ☐	20 ☐	30 ☐	40 ☐	☐
Lagoon (ft)	100 ☒	500 ☒	50 ☒	N/A ☒	30 ☒	50 ☒	100 ☒	200 ☒	☒

E. Required Signatures

Home Building Contractor _____ Date _____

Installer Larry Schwank Date 4-15-98

FORM 23-102 10-96


Lincoln-Lancaster County Health Department
Environmental Health Division
3140 "N" Street • Lincoln, NE 68510-1514
Phone: 402-441-8022

C

Permit Number:

Sewage Disposal System
Preliminary Plan Specifications

Draw a plot plan showing system location, lines, distribution box, tank and laterals, percolation test hole locations, well, residence, compass direction and property lines. Indicate on drawing if residence and well are existing or proposed.

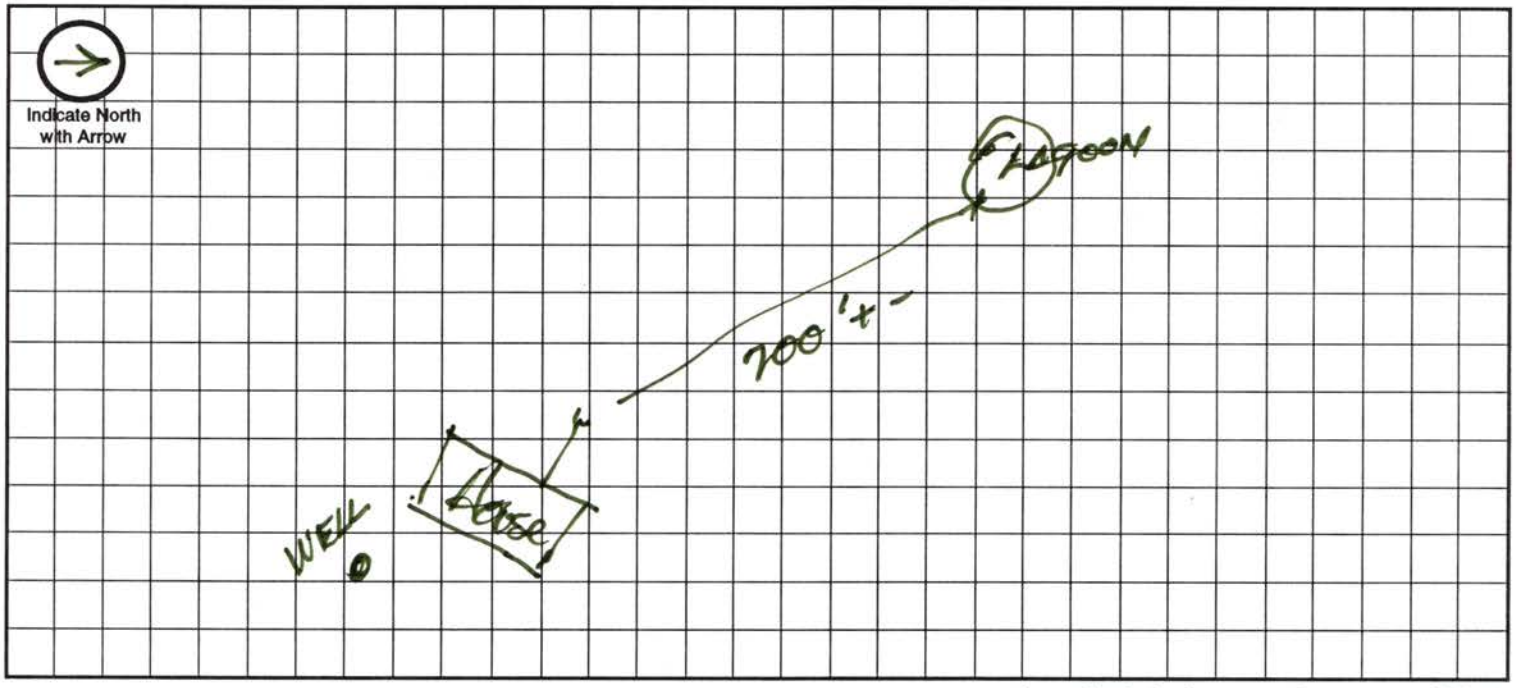

Approximate Scale: _____ ft. = _____ grid line/s

A. System Location (Indicate correct number and street)

Address (no rural route) 14003 N 14th City Lincoln/Lancaster NE, Zip 68428

B. Proposed Septic Tank/s

Tank Material: ☐ Concrete ☐ Plastic ☐ Other LAGOON

C. Proposed Absorption System (See Form B for Percolation Information)

Percolation Rate _____ (min. per inch) Soil Type: Clay Land Slope: ~ %

Type of Absorption System: ☐ Trench ☐ Bed ☐ Other _____

Total Square Feet of Field Required: _____ sq. ft.

Type of Lateral: ☐ Half-Moon ☐ Perforated Pipe ☐ Other Lateral Material: None

Capacity of Septic Tank _____ gals Number of Absorption Beds: _____ Number of Distribution Laterals per Bed _____

Total Length of Laterals _____ ft. Number of Trenches 1 Trench Width _____

D. Setbacks Check the Boxes Below if the Required Setback has been Satisfied

Distance From	Private Well	Public Well	Surface Water	Gound Water	Pressure Water Lines	Property Lines	Foundations Yours	Foundations Neighbors	All Other Setbacks
Tank (ft)	50 ☐	500 ☐	50 ☐	NA ☐	25 ☐	20 ☐	15 ☐	25 ☐	☐
Field (ft)	100 ☐	500 ☐	50 ☐	4 ☐	30 ☐	20 ☐	30 ☐	40 ☐	☐
Lagoon (ft)	100 ☐	500 ☐	50 ☐	N/A ☐	30 ☐	50 ☐	100 ☐	200 ☐	☐

E. Required Signatures

Home Building Contractor Mann Systems Inc Tom R Mann Date 4/16/98

Installer _____ Date _____

FORM 23-102 10-96

Lincoln-Lancaster County Health Department
Environmental Health Division
3140 "N" Street • Lincoln, NE 68510-1514
Phone: 402-441-8022

D

Permit Number:

Sewage Disposal System

As Built Plans & Specifications

Date 4/16/98

System Location (Indicate correct number and street)

Address 14003 N 14th (no rural route) City Lincoln/Lancaster NE, Zip 68428

A. Building Sewer

LAQ604

1. Material: _____
   Diameter: _____ in.
2. Distance above basement floor: _____ in.
   or distance below basement floor: _____ in.
3. Distance between dwelling and septic tank: _____ ft.
4. Number of clean-outs: _____
5. Distances to: well or suction line _____ ft.
   stream _____ ft.
   pressure line _____ ft.
   property line _____ ft.

B. Septic Tank

1. Material: _____
   Number of compartments: _____
2. Capacity: _____ gal.
3. Factory built: ❑ Yes ❑ No
4. Manholes: Over inlet, diameter _____ in.
   Over outlet, diameter _____ in.
   Riser: ❑ above ❑ below grade _____ in.
5. Inlet: ❑ baffle ❑ tee
6. Outlet: ❑ baffle ❑ tee
7. Depth to top of tank, below unfinished grade: _____ in.
8. Distances to: Well or suction line _____ ft.
   Stream _____ ft.
   Pressure line _____ ft.
   Property line _____ ft.

C. Distribution Box

1. Material: _____
   Number available outlets: _____
2. Factory built: ❑ Yes ❑ No
3. Distance from septic tank: _____ ft.

D. Absorption Field


(Provide as-built drawings on back of this form)

1. Type: ❑ Half rounds ❑ Perforated pipe
   Diameter of half round: _____
   or perforated pipe: _____
   Material: ❑ fiberglass ❑ plastic ❑ concrete
   ❑ other _____
2. Lateral lines: Number _____
   Length of each line: _____ ft. _____ ft.
   _____ ft. _____ ft., _____ ft.
3. Trench dimensions: Width _____ ft.
   Slope _____ in/100 ft.
   Average depth _____ in
4. Filter material: _____
   Depth of material _____ in.
5. Distances to: Well or suction line _____ ft.
   Stream _____ ft.
   Pressure line _____ ft.
   Property line _____ ft.

Indicate North with Arrow

Complete "As Built" drawing on back of this form.

Individual Sewage System Design (Example)

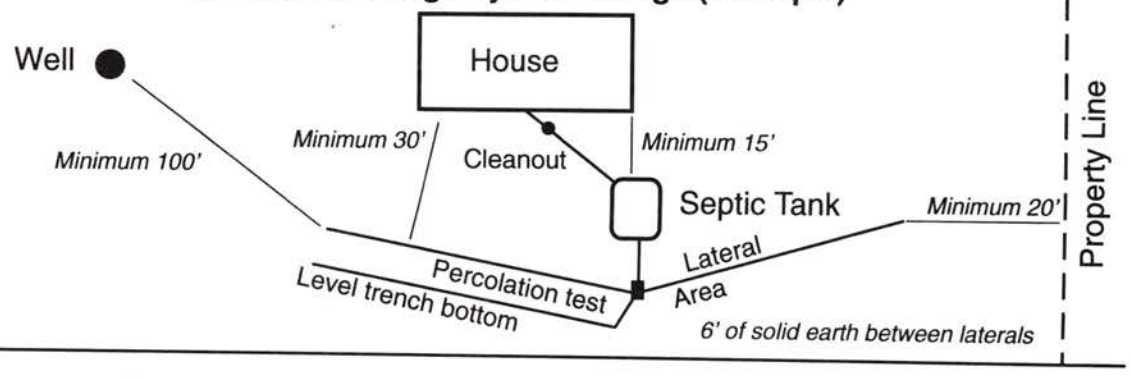

FORM 23-103 10-96

Lincoln-Lancaster County Health Department
Environmental Health Division
3140 "N" Street • Lincoln, NE 68510-1514
Phone: 402-441-8022

D

Permit Number:

Sewage Disposal System

As Built Plans & Specifications

Date 4-16-98

System Location (Indicate correct number and street)

Address 14003 No 14th (no rural route) City Lincoln NE, Zip

A. Building Sewer

1. Material: Class 160
   Diameter: 4" in.
2. Distance above basement floor: _____ in.
   or distance below basement floor: 16 in.
3. Distance between dwelling and ~~septic tank~~ Lagoon: 231 ft.
4. Number of clean-outs: _____
5. Distances to: well or suction line _____ ft.
   stream _____ ft.
   pressure line _____ ft.
   property line _____ ft.

~~B. Septic Tank~~ Lagoon

1. Material: _____
   Number of compartments: _____
2. Capacity: _____ gal.
3. Factory built: ❑ Yes ❑ No
4. Manholes: Over inlet, diameter _____ in.
   Over outlet, diameter _____ in.
   Riser: ❑ above ❑ below grade _____ in.
5. Inlet: ❑ baffle ❑ tee
6. Outlet: ❑ baffle ❑ tee
7. Depth to top of tank, below unfinished grade: _____ in.
8. Distances to: Well or suction line _____ ft.
   Stream _____ ft.
   Pressure line _____ ft.
   Property line _____ ft.

C. Distribution Box

1. Material: _____
   Number available outlets: _____
2. Factory built: ❑ Yes ❑ No
3. Distance from septic tank: _____ ft.

D. Absorption Field


(Provide as-built drawings on back of this form)

1. Type: ❑ Half rounds ❑ Perforated pipe
   Diameter of half round: _____
   or perforated pipe: _____
   Material: ❑ fiberglass ❑ plastic ❑ concrete
   ❑ other _____
2. Lateral lines: Number _____
   Length of each line: _____ ft. _____ ft.
   _____ ft. _____ ft., _____ ft.
3. Trench dimensions: Width _____ ft.
   Slope _____ in/100 ft.
   Average depth _____ in
4. Filter material: _____
   Depth of material _____ in.
5. Distances to: Well or suction line _____ ft.
   Stream _____ ft.
   Pressure line _____ ft.
   Property line _____ ft.

Indicate North with Arrow

Complete "As Built" drawing on back of this form.

Individual Sewage System Design (Example)

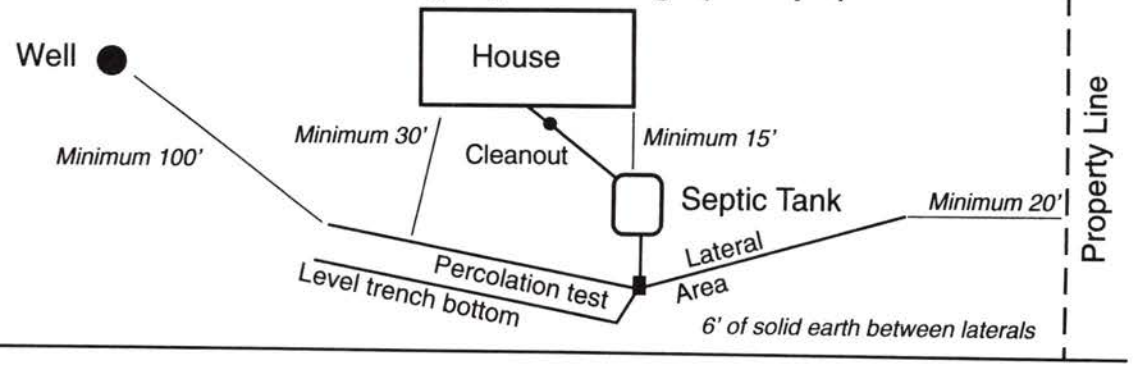


FORM 23-103 10-96

As Built Drawing by Larry Schwank

14 Ht Mound 4-11-6

14003 No 14th Mann Court

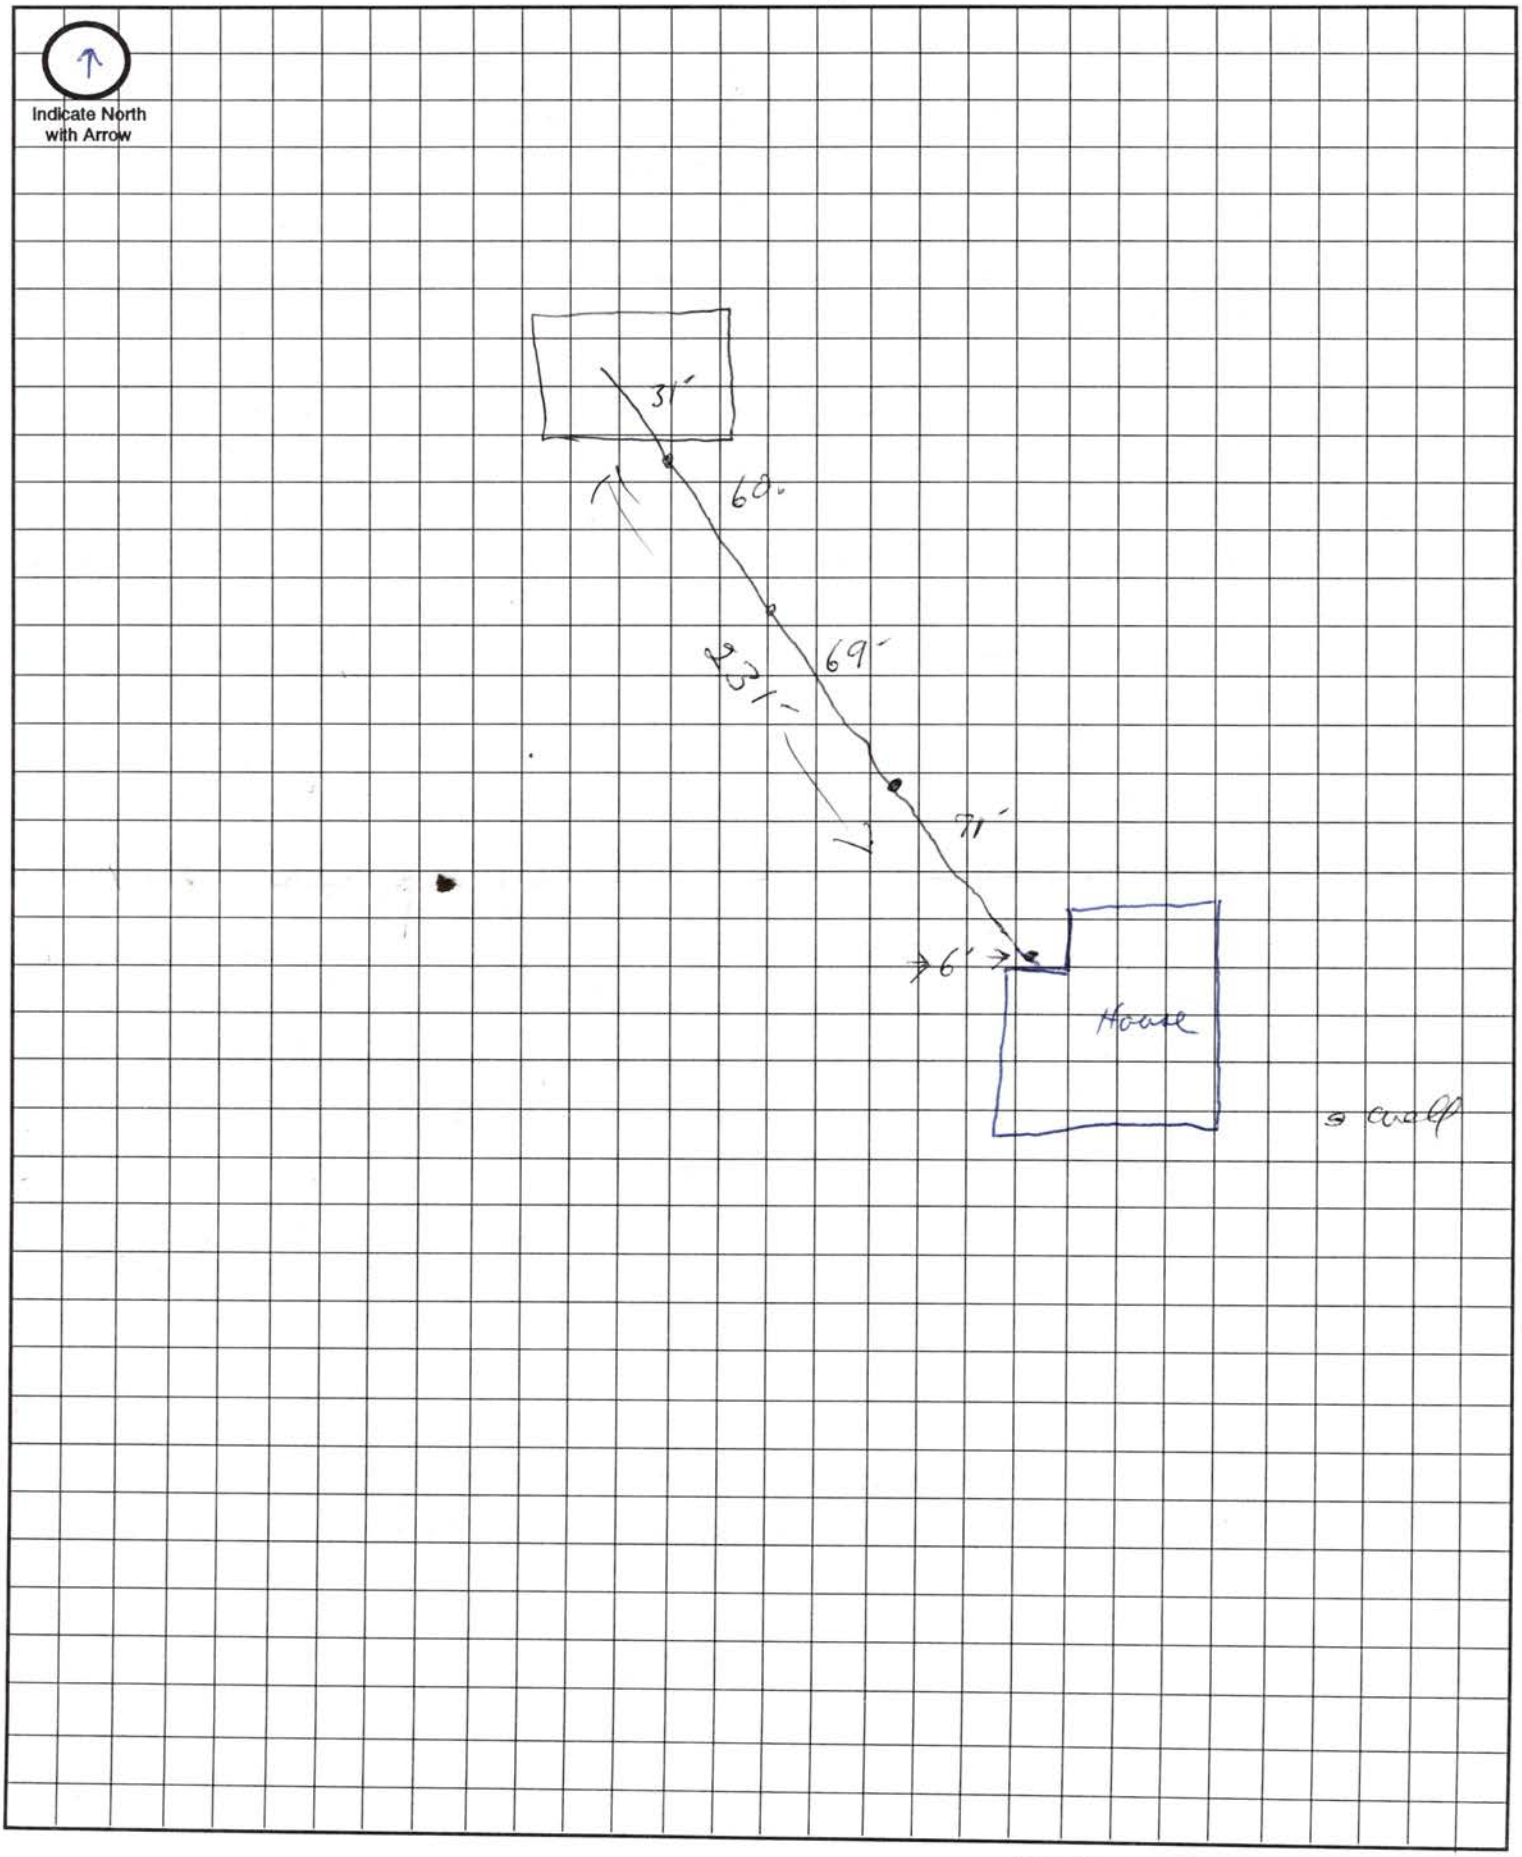

Approximate Scale: _____ ft. = _____ grid line/s


