Lincoln-Lancaster County Health Department

ENVIRONMENTAL HEALTH DIVISION
3140 N STREET · LINCOLN, NE 68510-1514 (402) 441-8000

Permit

SEWAGE INSTALLATION
SEPTIC SYSTEM

Permit # 013802356S01

Issued 08/27/01
Expires 02/27/02
Revenue Code 3157

Establishment

DAVID WOOD
T11N R5E SEC 32 QTR SW
LOT 46
12100 W FLETCHER AVE

FEES: $200.00

Permittee

DAVID & SUSAN WOOD DBA DAVID WOOD CONSTR
383 S 47 ST
LINCOLN NE 68510

TOTAL: $200.00

Bruce D. Dart
[redacted] Health Director

• POST IN A PROMINENT PLACE • NOT TRANSFERABLE

016260

Original not located
System approved 9-14-01
Paul Dostrom 10-3-01


Lincoln-Lancaster County Health Department
Environmental Health Division
3140 "N" Street • Lincoln, NE 68510-1514
Phone: 402-441-8022

C

Permit Number:

Sewage Disposal System
Preliminary Plan Specifications

Draw a plot plan showing system location, lines, distribution box, tank and laterals, percolation test hole locations, well, residence, compass direction and property lines. Indicate on drawing if residence and well are existing or proposed.

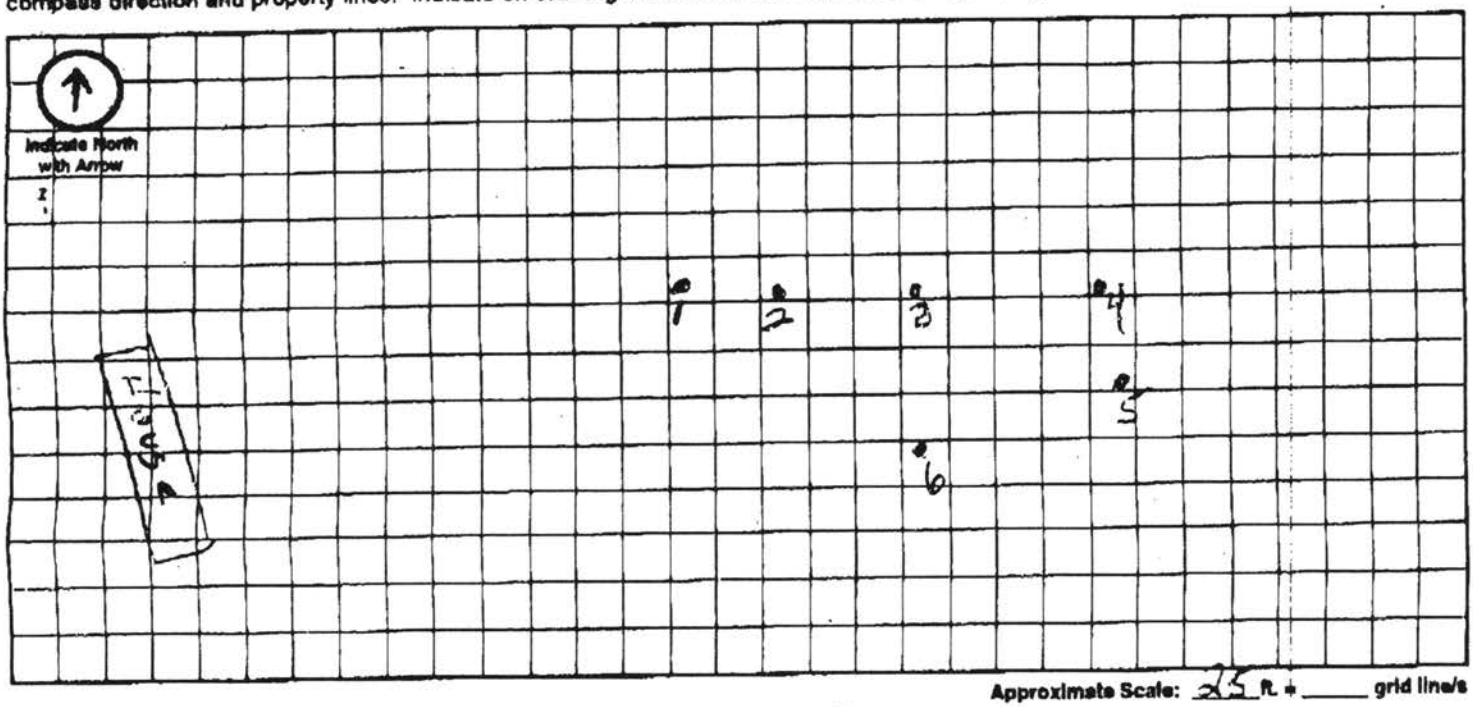

Approximate Scale: 25 ft. = ____ grid line/s

A. System Location (Indicate correct number and street)

Address (no rural route) 12100 Fletcher Ave. City Lincoln NE. Zip 68524

B. Proposed Septic Tank/s

Tank Material: ☒ Concrete ☐ Plastic ☐ Other ____

C. Proposed Absorption System (See Form B for Percolation Information)

Percolation Rate ____ (min. per inch) Soil Type: ____ Land Slope: ____ %

Type of Absorption System: ☒ Trench ☐ Bed ☐ Other ____

Total Square Feet of Field Required: ____ sq. ft.

Type of Lateral: ☐ Half-Moon ☒ Perforated Pipe ☐ Other Lateral Material: ____

Capacity of Septic Tank 1000 gals Number of Absorption Beds: ____ Number of Distribution Laterals per Bed ____

Total Length of Laterals ____ ft. Number of Trenches ____ Trench Width 36

D. Setbacks Check the Boxes Below if the Required Setback has been Satisfied

Distance From	Private Well	Public Well	Surface Water	Gound Water	Pressure Water Lines	Property Lines	Foundations Yours	Foundations Neighbors	All Other Setbacks
Tank (ft)	50 ☐	500 ☐	50 ☐	NA ☐	25 ☐	20 ☐	15 ☐	25 ☐	☐
Field (ft)	100 ☐	500 ☐	50 ☐	4 ☐	30 ☐	20 ☐	30 ☐	40 ☐	☐
Lagoon (ft)	100 ☐	500 ☐	50 ☐	N/A ☐	30 ☐	50 ☐	100 ☐	200 ☐	☐

E. Required Signatures

Home Building Contractor ____ Date 8/20/01

Installer ____ Date 8/20/01

FORM 23-102 10-96

Lincoln-Lancaster County Health Department
Environmental Health Division
3140 "N" Street • Lincoln, NE 68510-1514
Phone: 402-441-8022

D

Permit Number:

Sewage Disposal System

As Built Plans & Specifications

Date 9-13-01

System Location (Indicate correct number and street)

Address 12100 W Fletcher City Lincoln NE, Zip 68524
(no rural route)

A. Building Sewer

1. Material: PVC
   Diameter: 4 in.
2. Distance above basement floor: NA in.
   or distance below basement floor: _____ in.
3. Distance between dwelling and septic tank: 218 ft.
4. Number of clean-outs: 5
5. Distances to: well or suction line 400 ft.
   stream NA ft.
   pressure line 50 ft.
   property line 200 ft.

B. Septic Tank

1. Material: CEMENT
   Number of compartments: _____
2. Capacity: 1000 gal.
3. Factory built: ☒ Yes ☐ No
4. Manholes: Over inlet, diameter _____ in.
   Over outlet, diameter _____ in.
   Riser: ☐ above ☐ below grade _____ in.
5. Inlet: ☒ baffle ☐ tee
6. Outlet: ☒ baffle ☐ tee
7. Depth to top of tank, below unfinished grade: 6 in.
8. Distances to: Well or suction line 500 ft.
   Stream NA ft.
   Pressure line 240 ft.
   Property line 200 ft.

C. Distribution Box

1. Material: PLASTIC
   Number available outlets: 7
2. Factory built: ☒ Yes ☐ No
3. Distance from septic tank: 7 ft.

D. Absorption Field


(Provide as-built drawings on back of this form)

1. Type: ☐ Half rounds ☒ Perforated pipe
   Diameter of half round: _____
   or perforated pipe: 4 inch
   Material: ☐ fiberglass ☒ plastic ☐ concrete
   ☐ other _____
2. Lateral lines: Number 3
   Length of each line: 100 ft. 100 ft.
   100 ft. _____ ft., _____ ft.
3. Trench dimensions: Width 36 ft.
   Slope 3 in/100 ft.
   Average depth 18 in
4. Filter material: GRAVEL
   Depth of material 12 in.
5. Distances to: Well or suction line 500 ft.
   Stream NA ft.
   Pressure line 250 ft.
   Property line 100 ft.

Indicate North with Arrow


Complete "As Built" drawing on back of this form.

Individual Sewage System Design (Example)

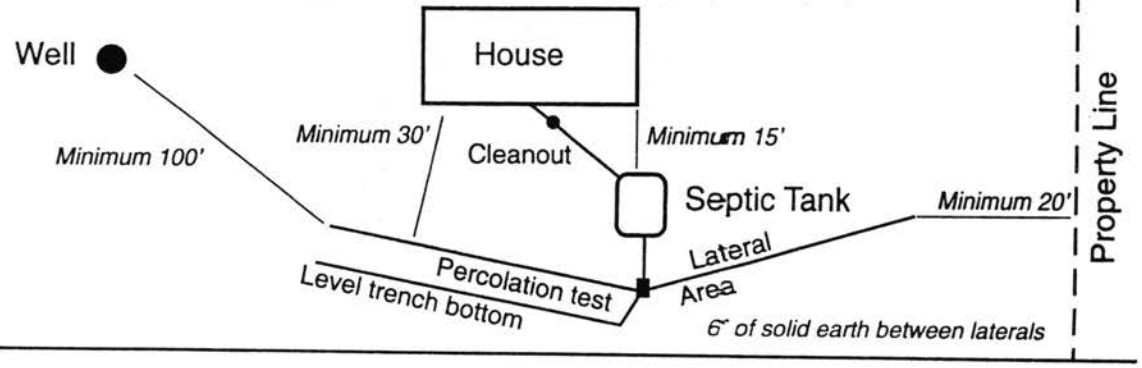


FORM 23-103 10-96

NORTH

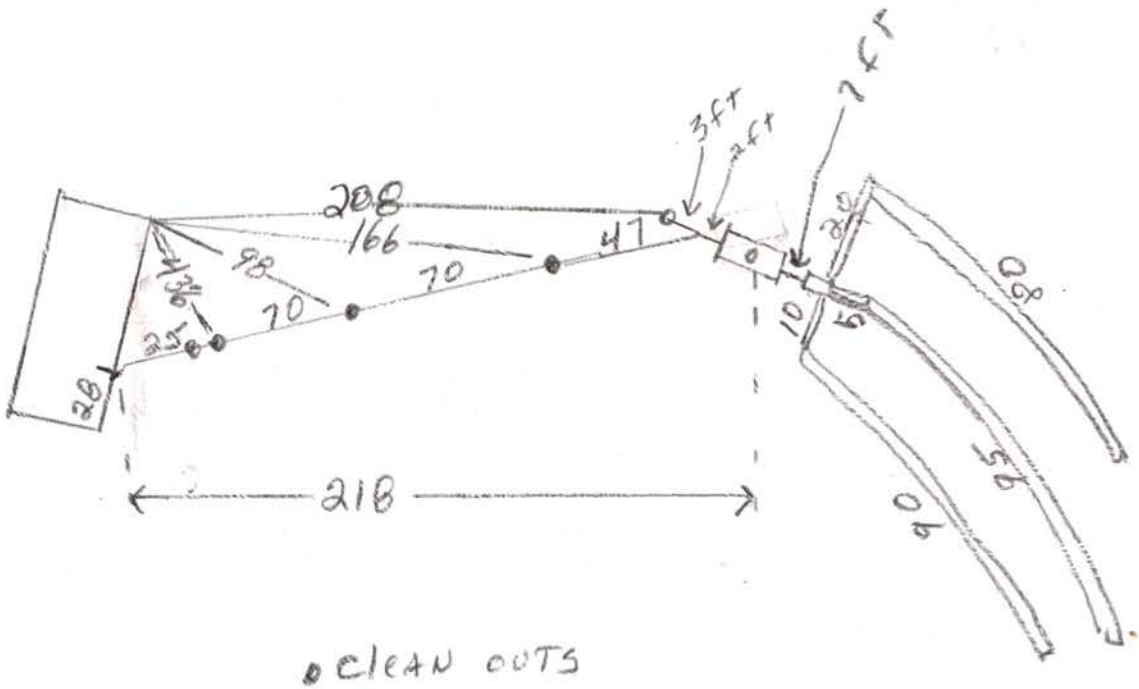

• CLEAN OUTS

12100 West Fletcher

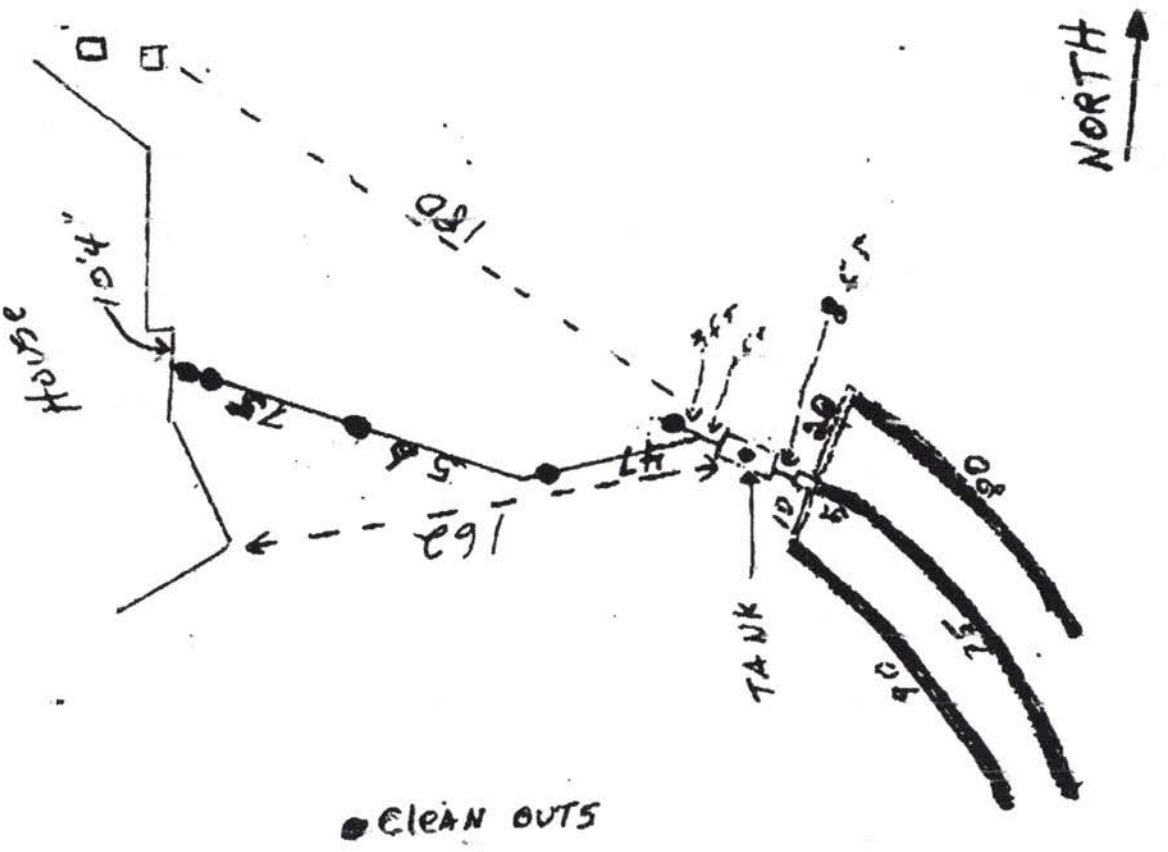

Post-it™ brand fax transmittal memo 7671 | # of pages ▸ 1

To County Health	From Wagner Const
Co.	Co. Melvin
Dept.	Phone 432-5698
Fax # 441-6206	Fax # 797-7475

TOTAL P.02