LINCOLN-LANCASTER COUNTY HEALTH DEPARTMENT

3140 "N" STREET
NON TRANSFERABLE

ENVIRONMENTAL HEALTH DIVISION
Lincoln, NE 68510-1514
PERMIT

(402) 441-8000

Permit

SEWAGE INSTALLATION
LAGOON

No. 99380192701

Issued 01/29/99
Expires 07/29/99
Revenue Code 3157

FEES: $150.00

PAID

Establishment

CAROL BOZARTH
T10N R8E SEC 16 QTR NE
W 1/2
13901 ADAMS ST

TOTAL $150.00

Permittee

CAROL BOZARTH
13901 ADAMS ST
LINCOLN NE 68527

Issued By Health Director
Lincoln-Lancaster County Health Department

008657

THIS LICENSE OR PERMIT IS ISSUED SUBJECT TO REVOCATION AS PROVIDED BY LAW "POST IN A PROMINENT PLACE"

Lincoln-Lancaster County Health Department
Environmental Health Division
3140 "N" Street • Lincoln, NE 68510-1514
Phone: 402-441-8022

A

Permit Number:

Sewage Disposal System

Request for Site Clearance and Permit

Include Form B, Form C and Applicable Fees with this Application.

☐ Septic System ☒ Lagoon ☐ Other (Refer to Form C)

The undersigned hereby requests site clearance and permit to construct a Sewage Disposal System in conformance with appropriate resolution or ordinance, as described herein:

PLEASE PRINT OR TYPE

A. System Location (Indicate correct number and street)

Address 13901 Adams (no rural route) City Lincoln NE, Zip 68522

Legal Description W/2 of NE 16 10N 8E 6
1/4 1/4 Section Township Range Subdivision Addition Block Lot

Geographical Location (if known): Longitude _____ Latitude _____

☐ Check if system mail address is not the same as the owner's address

B. Owner

Name Carol Bozarth Signature _____

Address 13901 Adams City/State/Zip Lincoln Ne 68527

☐ Check if owner designed system Home Phone _____ Work Phone 432-1540

C. Contractor

Name Southwick Sewer Company Name Brad Southwick

Address 17201 So 72 City/State/Zip Hickman, Ne 68372

☐ Check if contractor designed system Work Phone 430-7606

D. Engineer/Installer ☐ Check and complete if engineer designed system

Designer Name _____ Firm _____ Work Phone _____

E. This System Will Serve a

☒ Residential Dwelling Number of Bedrooms 3 Is there a Whirlpool Bathtub YES (NO)

☐ Commercial Establishment/Other Facility Specify _____

Design flow in gallons per day _____ Type of Wastewater: ☐ Domestic ☐ Non-Domestic.

DO NOT WRITE BELOW THIS LINE

Approval Process ☐ Municipal Code 24.38 ☒ County Resolution No. 2832

1. **Health Department** Date rec'd 1/28/99 Date frwd 1/29/99 ACTION ☒ Approved ☐ Disapproved Signature Jerold C. Wood
2. **Supt. Bldg. Insp. or Village Clerk** Date rec'd 1-29-99 Date frwd 1-29-99 ACTION ☒ Approved ☐ Disapproved Signature
3. **City or County Engineer** Date rec'd 2-1-99 Date frwd 2-1-99 ACTION ☒ Approved ☐ Disapproved Signature

2-3-99, mm Need Cover & drain ok
4-16-99 fence up

Installation Final Written Approval

By Ron Moyer

Date 8-19-99

Business Office Use Only

Date Rec'd 01/29/99
Amt Paid 150 ck
Rec'd By _____ Cash/Check No. 3347

FORM 23-100 10-96 White - Health Dept. Yellow - Engineer Pink - Bldg. Inspector


Lincoln-Lancaster County Health Department
Environmental Health Division
3140 "N" Street • Lincoln, NE 68510-1514
Phone: 402-441-8022

C

Permit Number:

Sewage Disposal System
Preliminary Plan Specifications

Draw a plot plan showing system location, lines, distribution box, tank and laterals, percolation test hole locations, well, residence, compass direction and property lines. Indicate on drawing if residence and well are existing or proposed.

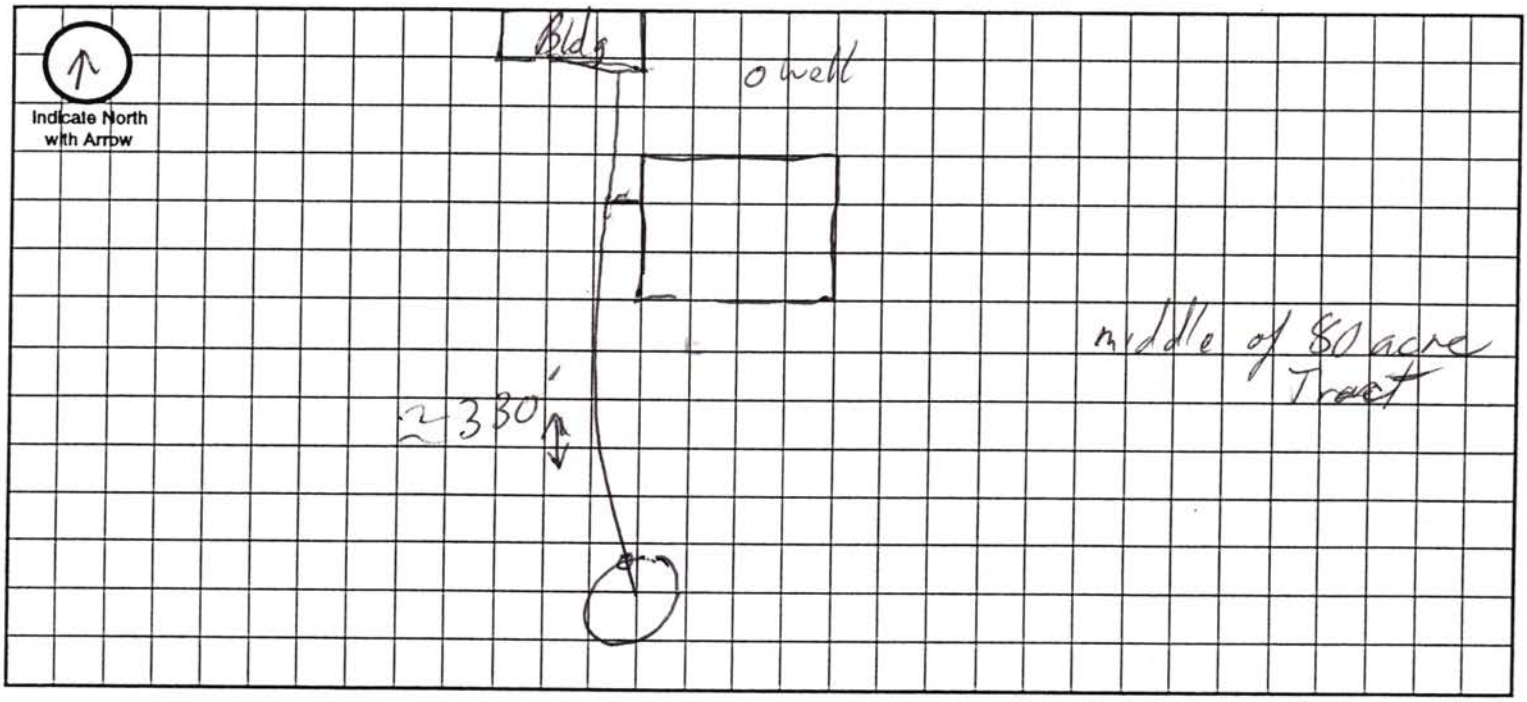

Approximate Scale: _____ ft. = _____ grid line/s

A. System Location (Indicate correct number and street)

Address (no rural route) 13901 Adams City Lincoln NE, Zip 68527

B. Proposed Septic Tank/s

Tank Material: ☐ Concrete ☐ Plastic ☐ Other _____

C. Proposed Absorption System (See Form B for Percolation Information) Need to seal lagoon

Percolation Rate _____ (min. per inch) Soil Type: Sharpsburg soil Land Slope: _____ %

Type of Absorption System: ☐ Trench ☐ Bed ☐ Other _____

Total Square Feet of Field Required: _____ sq. ft.

Type of Lateral: ☐ Half-Moon ☐ Perforated Pipe ☐ Other Lateral Material: _____

Capacity of Septic Tank _____ gals Number of Absorption Beds: _____ Number of Distribution Laterals per Bed _____

Total Length of Laterals _____ ft. Number of Trenches _____ Trench Width _____

D. Setbacks Check the Boxes Below if the Required Setback has been Satisfied

Distance From	Private Well	Public Well	Surface Water	Gound Water	Pressure Water Lines	Property Lines	Foundations Yours	Foundations Neighbors	All Other Setbacks
Tank (ft)	50 ☐	500 ☐	50 ☐	NA ☐	25 ☐	20 ☐	15 ☐	25 ☐	☐
Field (ft)	100 ☐	500 ☐	50 ☐	4 ☐	30 ☐	20 ☐	30 ☐	40 ☐	☐
Lagoon (ft)	100 ☒	500 ☒	50 ☒	N/A ☐	30 ☒	50 ☒	100 ☒	200 ☒	☒

E. Required Signatures

Home Building Contractor MOVED IN Date _____

Installer Brad Southard Date 1-28-99

FORM 23-102 10-96

AUG 1 8 1999

D

Permit Number: 98380192 7

Lincoln-Lancaster County Health Department
Environmental Health Division
3140 "N" Street • Lincoln, NE 68510-1514
Phone: 402-441-8022

Sewage Disposal System

As Built Plans & Specifications

Date August 1999

System Location (Indicate correct number and street)

Address 13901 Adams (no rural route) City Lincoln NE, Zip 68527

A. Building Sewer

1. Material: SCH 40
   Diameter: _____ in.
2. Distance above basement floor: _____ in.
   or distance below basement floor: _____ in.
3. Distance between dwelling and septic tank: _____ ft.
4. Number of clean-outs: _____
5. Distances to: well or suction line _____ ft.
   stream _____ ft.
   pressure line _____ ft.
   property line _____ ft.

B. Septic Tank

1. Material: _____
   Number of compartments: _____
2. Capacity: _____ gal.
3. Factory built: ☐ Yes ☐ No
4. Manholes: Over inlet, diameter _____ in.
   Over outlet, diameter _____ in.
   Riser: ☐ above ☐ below grade _____ in.
5. Inlet: ☐ baffle ☐ tee
6. Outlet: ☐ baffle ☐ tee
7. Depth to top of tank, below unfinished grade: _____ in.
8. Distances to: Well or suction line _____ ft.
   Stream _____ ft.
   Pressure line _____ ft.
   Property line _____ ft.

C. Distribution Box

1. Material: _____
   Number available outlets: _____
2. Factory built: ☐ Yes ☐ No
3. Distance from septic tank: _____ ft.

D. Absorption Field


(Provide as-built drawings on back of this form)

1. Type: ☐ Half rounds ☐ Perforated pipe
   Diameter of half round: _____
   or perforated pipe: _____
   Material: ☐ fiberglass ☐ plastic ☐ concrete
   ☐ other _____
2. Lateral lines: Number _____
   Length of each line: _____ ft. _____ ft.
   _____ ft. _____ ft., _____ ft.
3. Trench dimensions: Width _____ ft.
   Slope _____ in/100 ft.
   Average depth _____ in
4. Filter material: _____
   Depth of material _____ in.
5. Distances to: Well or suction line _____ ft.
   Stream _____ ft.
   Pressure line _____ ft.
   Property line _____ ft.

Complete "As Built" drawing on back of this form.


Indicate North with Arrow

Individual Sewage System Design (Example)

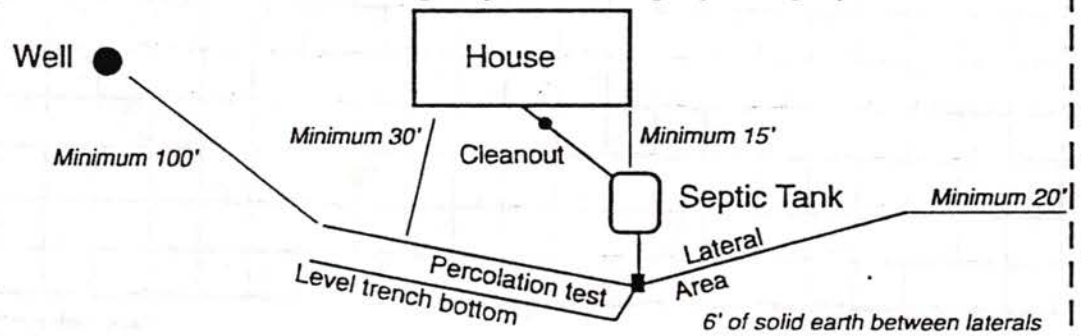


FORM 23-103 10-96

As Built Drawing

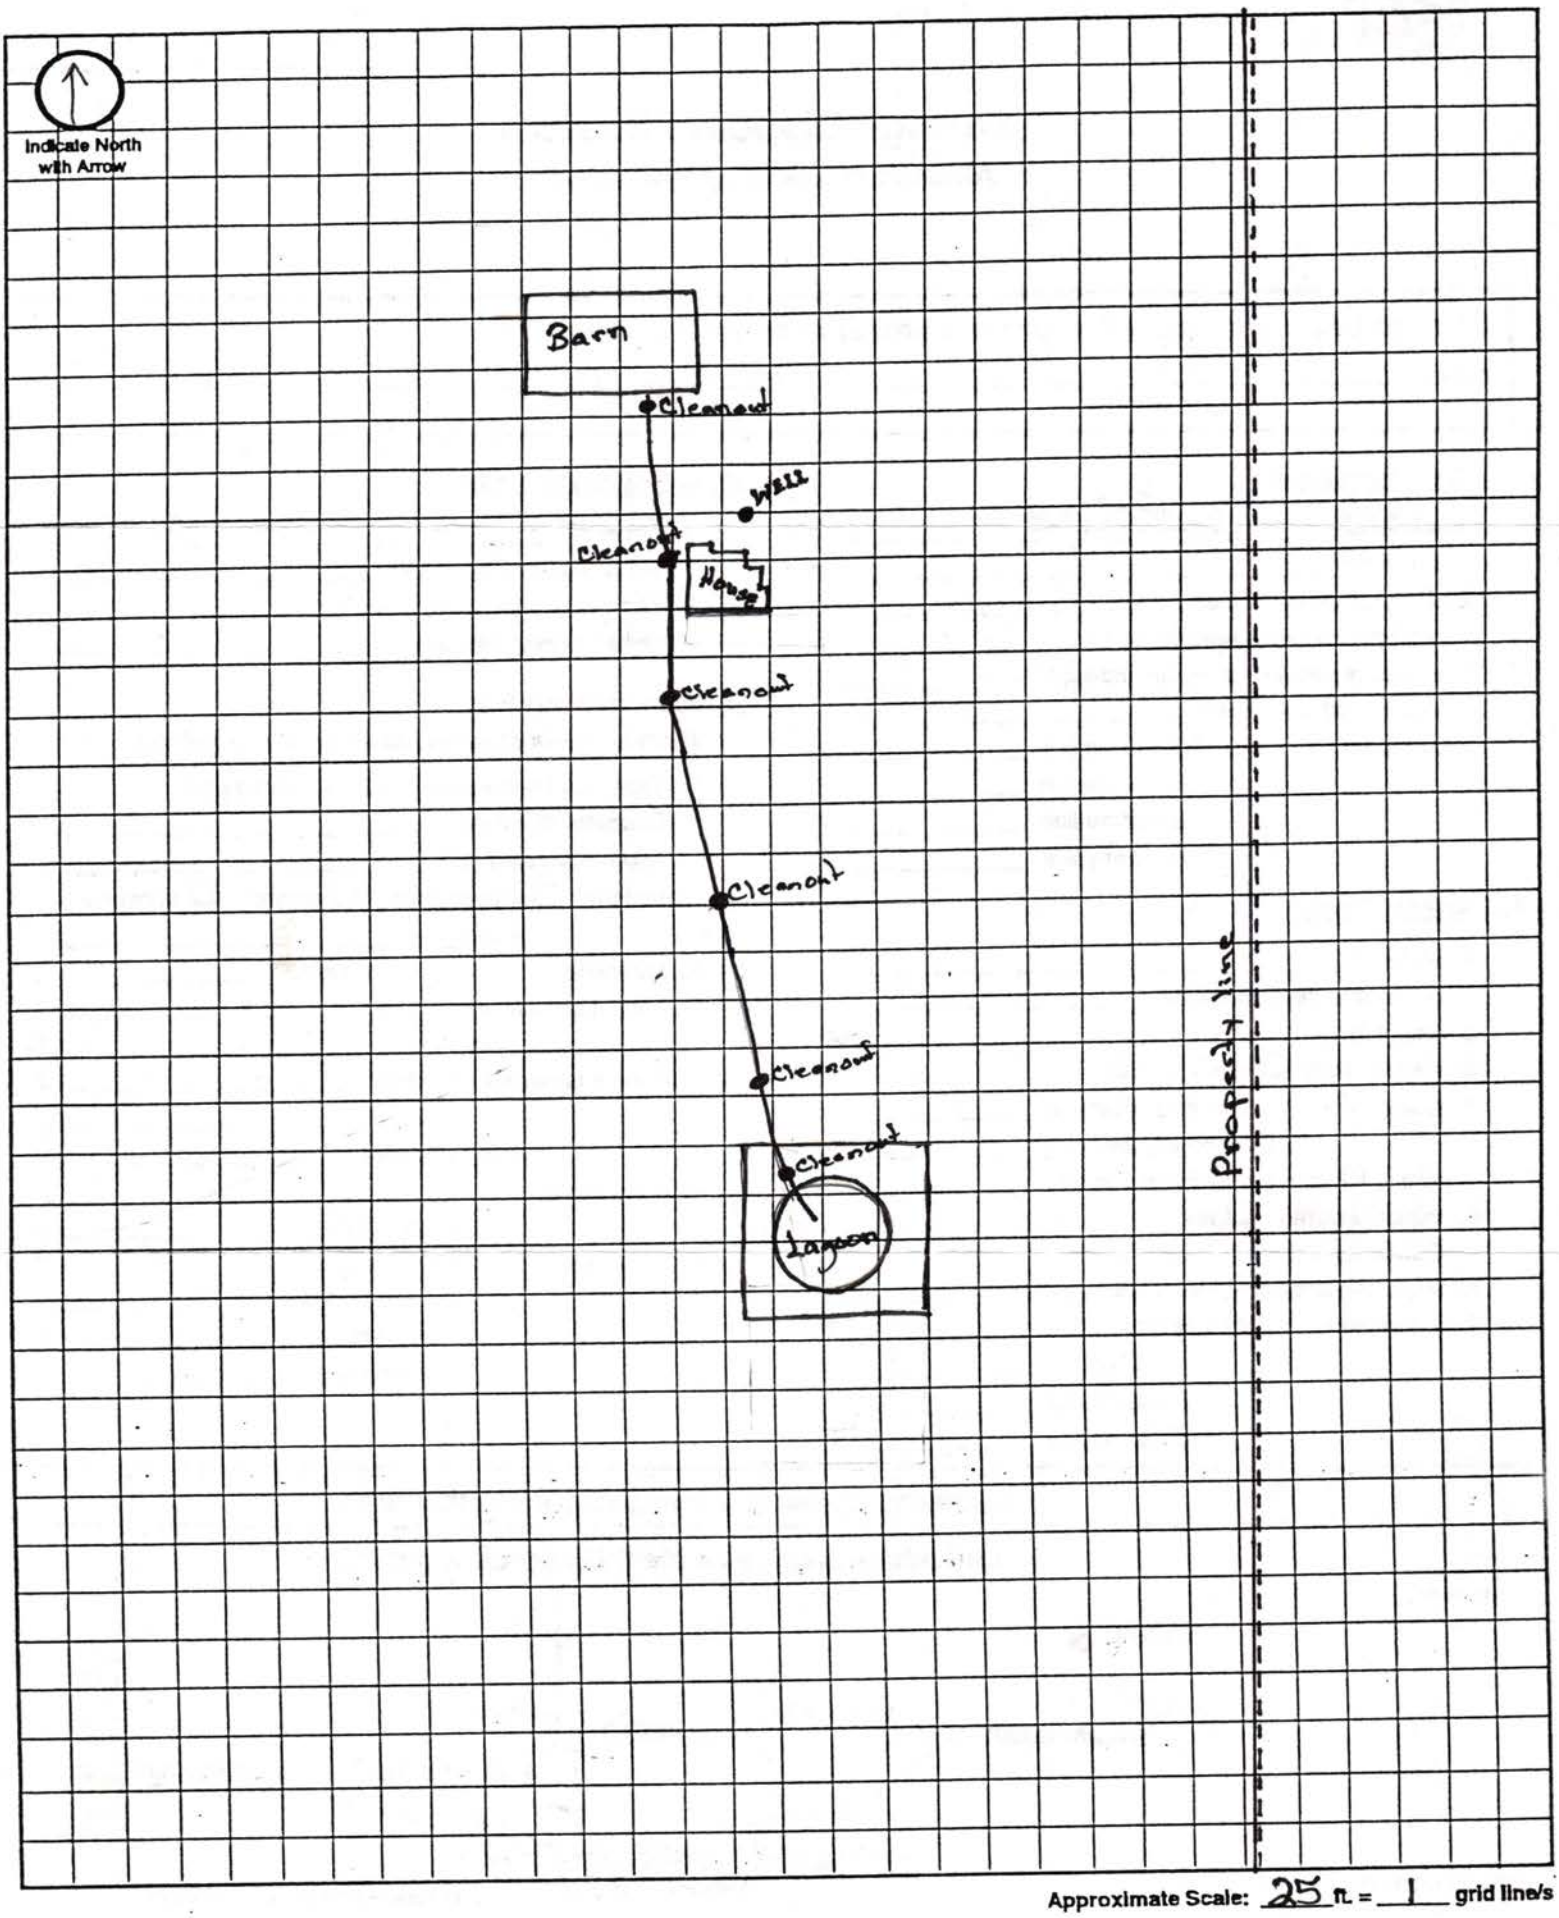

Approximate Scale: 25 ft. = 1 grid line/s

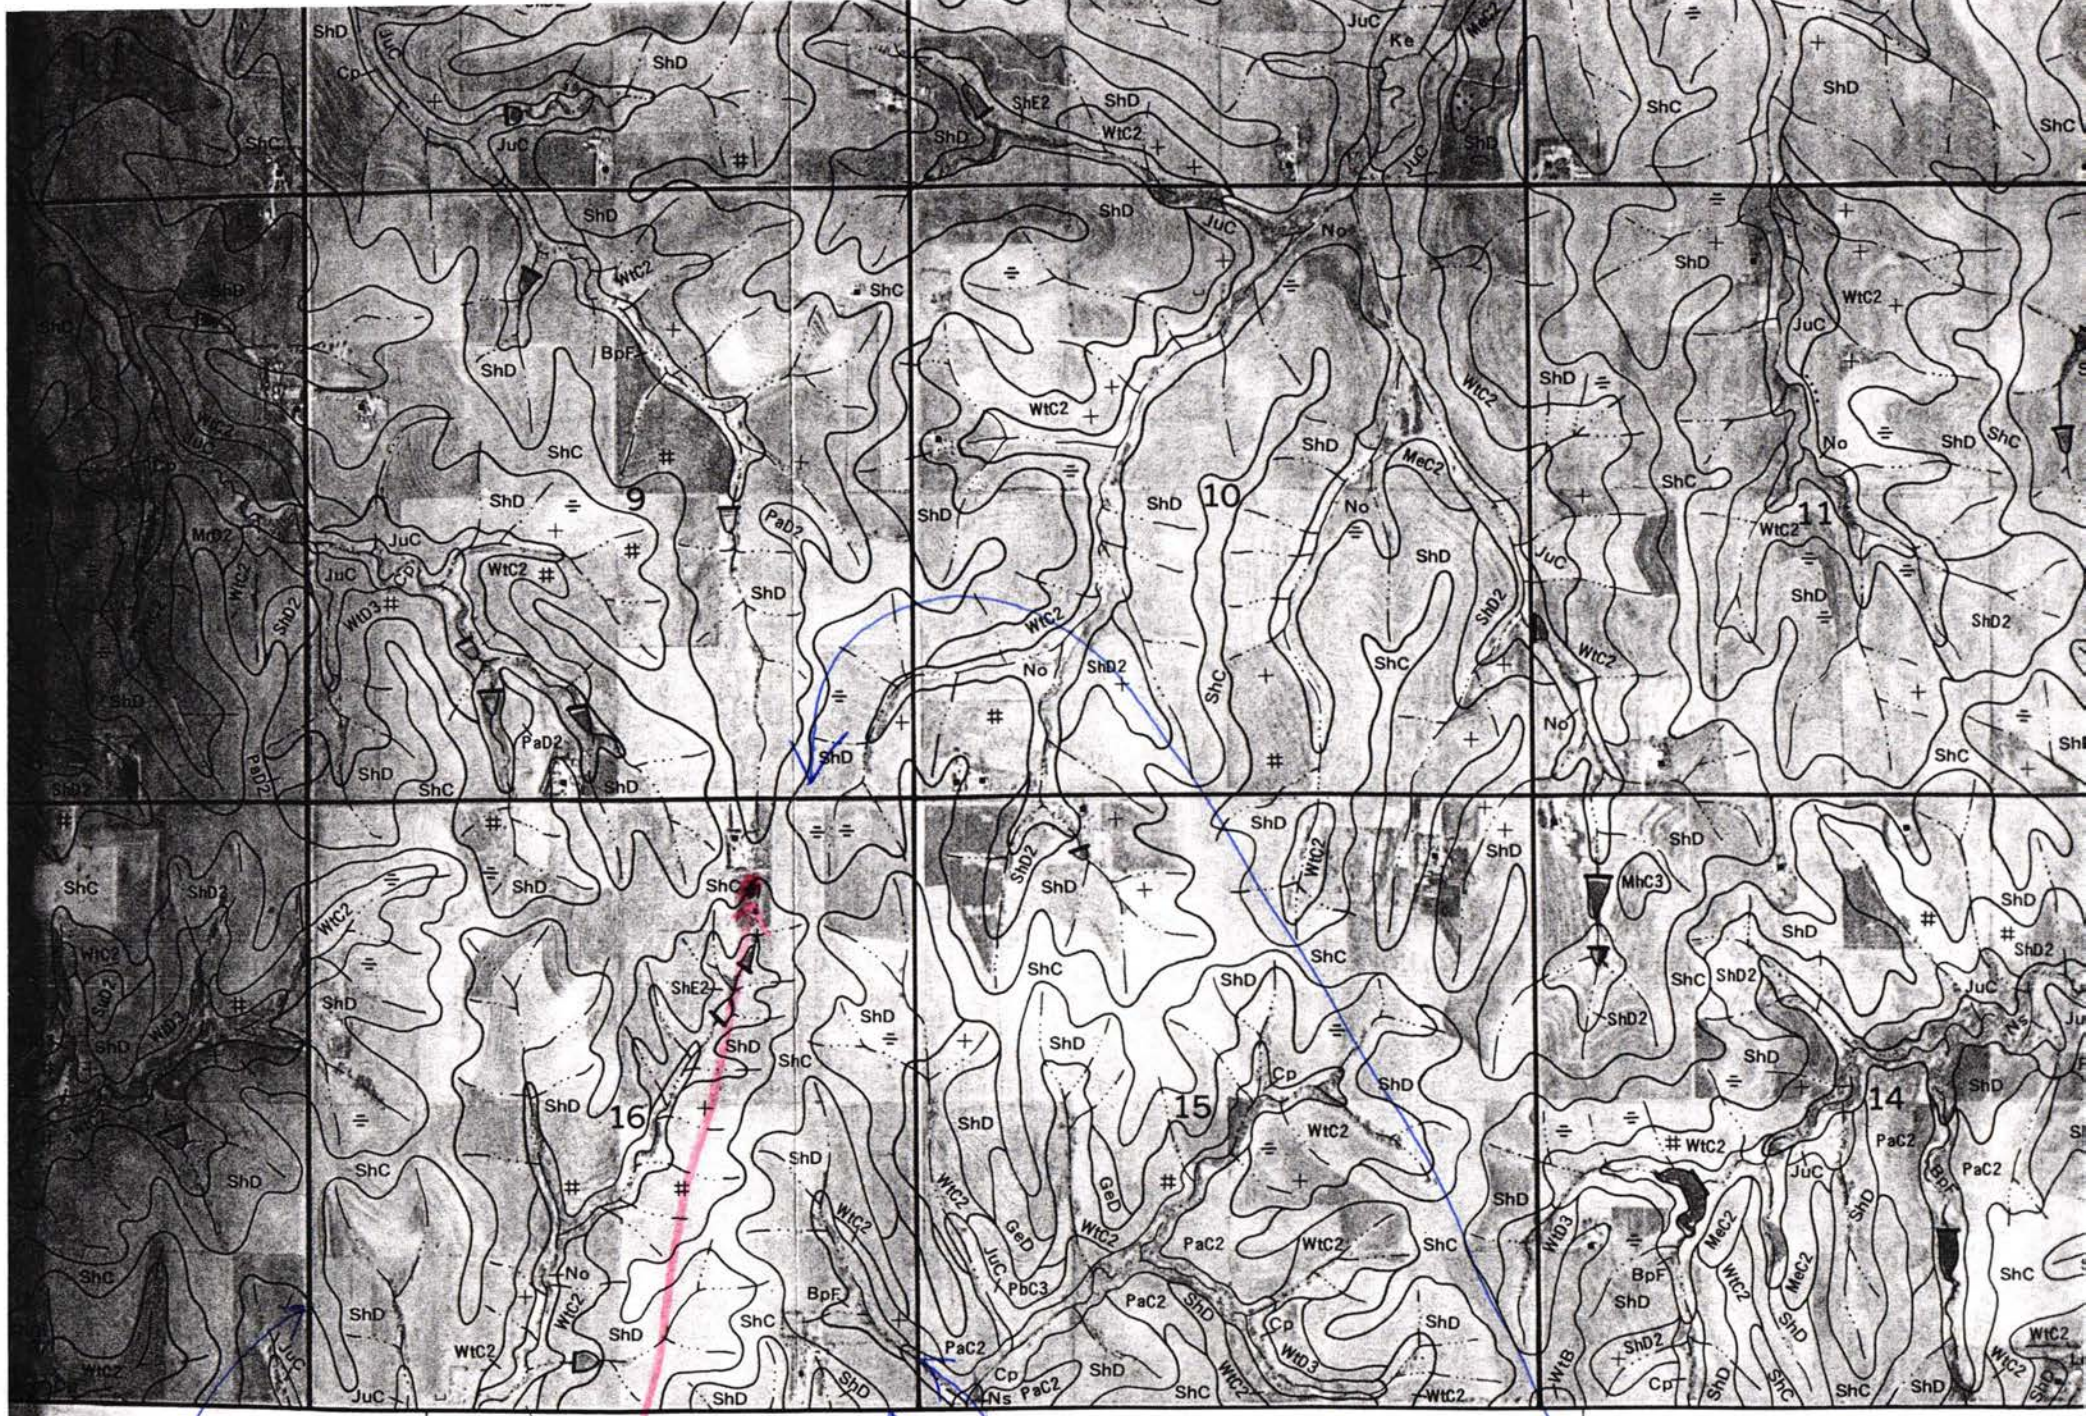
N. 134th
NAW Lagoon
Holmegee St.
N. 148th
Adams St.