Lincoln-Lancaster County Health Department

ENVIRONMENTAL HEALTH DIVISION

3140 N STREET · LINCOLN, NE 68510-1514 (402) 441-8000

Permit
SEWAGE INSTALLATION

Permit # 01380235901

Issued 09/04/01
Expires 03/04/02
Revenue Code 3157

Establishment
ERNEST CAJKA
T10N R8E SEC 16 QTR SE
~~E 1/2 LOT 111 I.T.~~
~~2700 N 148 ST~~

FEES: $200.00

Permittee
ERNEST CAJKA
8120 EASTWOOD D/R
LINCOLN NE 68506

TOTAL: $200.00

Bruce D. Dart

Bruce D. Dart, Health Director

• POST IN A PROMINENT PLACE • NOT TRANSFERABLE

000006

Lincoln-Lancaster County Health Department
Environmental Health Division
3140 "N" Street • Lincoln, NE 68510-1514
Phone: 402-441-8022

A

Permit Number: 01380235 9

Sewage Disposal System

Request for Site Clearance and Permit

Include Form B, Form C and Applicable Fees with this Application.

☐ Septic System ☒ Lagoon ☐ Other (Refer to Form C)

The undersigned hereby requests site clearance and permit to construct a Sewage Disposal System in conformance with appropriate resolution or ordinance, as described herein:

PLEASE PRINT OR TYPE

A. System Location (Indicate correct number and street)

Address 2700 N. 148th 2025 N. Mer City Lincoln NE, Zip Ne

PARCEL #1 (no rural route)

Legal Description East half of Southeast quarter 10N 8E I.T.
1/4 1/4 Section Township Range Subdivision Addition Block Lot

Geographical Location (if known): Longitude _____ Latitude _____

☒ Check if system mail address is not the same as the owner's address

B. Owner

Name Ernest Cajka Signature _____

Address 8120 Eastwood Dr. City/State/Zip Lincoln, Ne 68506

☐ Check if owner designed system Home Phone 489-6546 Work Phone 467-8901

C. Contractor

Name Ernest Well Drilling Inc. (Ben Earnest) Company Name _____

Address RFD 1 City/State/Zip Milford, Ne

☐ Check if contractor designed system Work Phone 475-3276

D. Engineer/Installer ☐ Check and complete if engineer designed system

Designer Name Earnest Well Drilling Firm Earnest Well Drilling Work Phone 475-3276

E. This System Will Serve a

☒ Residential Dwelling Number of Bedrooms 4 Is there a Whirlpool Bathtub (YES) NO

☐ Commercial Establishment/Other Facility Specify _____

Design flow in gallons per day _____ Type of Wastewater: ☒ Domestic ☐ Non-Domestic.

DO NOT WRITE BELOW THIS LINE

Approval Process ☐ Municipal Code 24.38 ☒ County Resolution No. 2832

1. **Health Department** Date rec'd 9/4/01 Date frwd 9/4/01 ACTION ☒ Approved ☐ Disapproved Signature Jerrold C. Hood
2. **Supt. Bldg. Insp. or Village Clerk** Date rec'd 9/7/01 Date frwd _____ ACTION ☒ Approved ☐ Disapproved Signature MW
3. **City or County Engineer** Date rec'd 9/7/01 Date frwd 9/7/01 ACTION ☒ Approved ☐ Disapproved Signature _____

5-5-05 rm neck gate, seems to be working OK
10-9-01, rm new fence + [illegible] 5-3602 rm cut drainage ditch East side

Installation Final Written Approval

By Ron Magnuson

Date 10-13-05

Business Office Use Only

Date Rec'd 9/4/01
Amt Paid $200.00
Rec'd By CW Cash/Check No. 5292

FORM 23-100 10-96 White - Health Dept. Yellow - Engineer Pink - Bldg. Inspector


Lincoln-Lancaster County Health Department
Environmental Health Division
3140 "N" Street • Lincoln, NE 68510-1514
Phone: 402-441-8022

C

Permit Number: 013802359

Sewage Disposal System
Preliminary Plan Specifications

Draw a plot plan showing system location, lines, distribution box, tank and laterals, percolation test hole locations, well, residence, compass direction and property lines. Indicate on drawing if residence and well are existing or proposed.

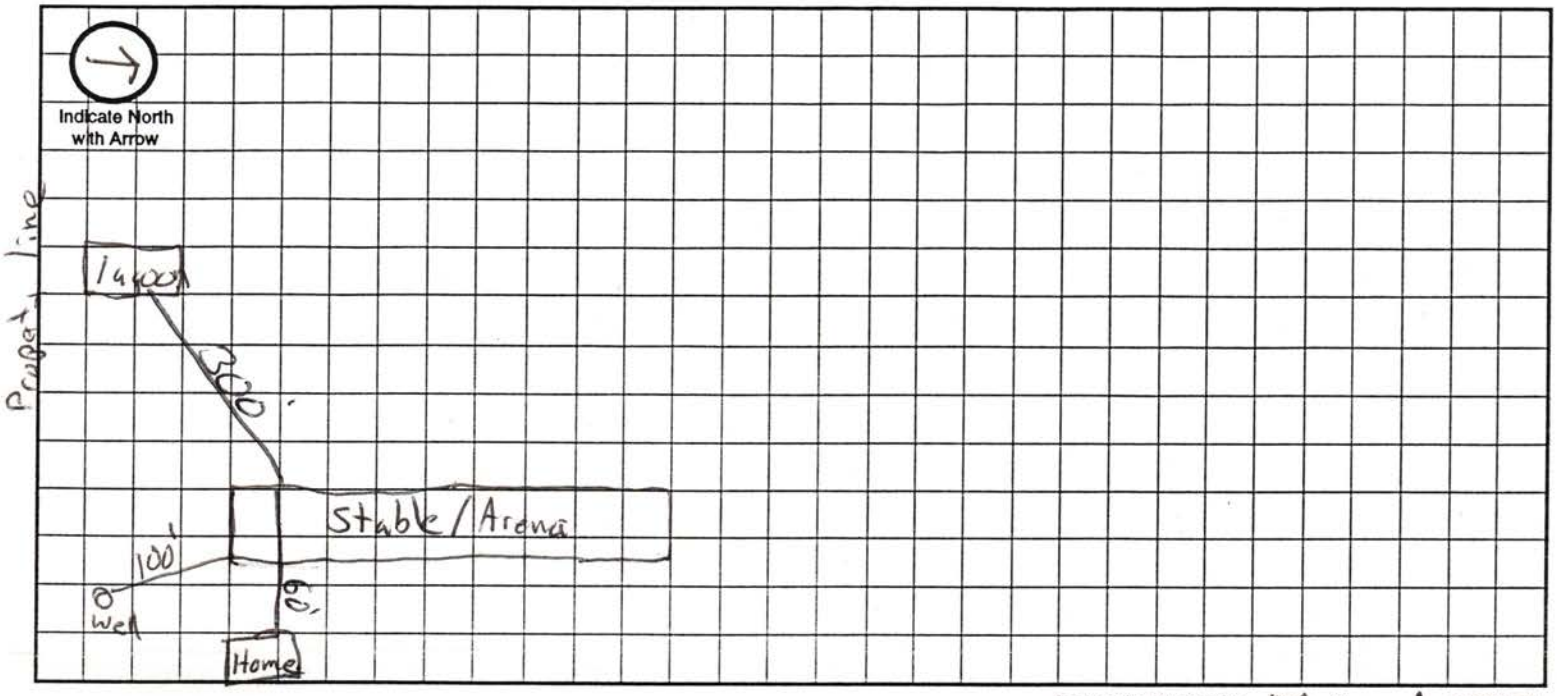

Approximate Scale: 50 ft. = 1 grid line/s

A. System Location (Indicate correct number and street)

Address (no rural route) _____ City _____ NE, Zip _____

B. Proposed Septic Tank/s

Tank Material: ☐ Concrete ☐ Plastic ☐ Other _____

C. Proposed Absorption System (See Form B for Percolation Information)

Percolation Rate _____ (min. per inch) Soil Type: _____ Land Slope: _____ %

Type of Absorption System: ☐ Trench ☐ Bed ☐ Other _____

Total Square Feet of Field Required: _____ sq. ft.

Type of Lateral: ☐ Half-Moon ☐ Perforated Pipe ☐ Other Lateral Material: _____

Capacity of Septic Tank _____ gals Number of Absorption Beds: _____ Number of Distribution Laterals per Bed _____

Total Length of Laterals _____ ft. Number of Trenches _____ Trench Width _____

D. Setbacks Check the Boxes Below if the Required Setback has been Satisfied

Distance From	Private Well	Public Well	Surface Water	Gound Water	Pressure Water Lines	Property Lines	Foundations Yours	Foundations Neighbors	All Other Setbacks
Tank (ft)	50 ☐	500 ☐	50 ☐	NA ☐	25 ☐	20 ☐	15 ☐	25 ☐	☐
Field (ft)	100 ☐	500 ☐	50 ☐	4 ☐	30 ☐	20 ☐	30 ☐	40 ☐	☐
Lagoon (ft)	100 ☐	500 ☐	50 ☐	N/A ☐	30 ☐	50 ☐	100 ☐	200 ☐	☐

E. Required Signatures

Home Building Contractor _____ Date _____

Installer ERNEST WELL DRILLING Date 8-28-01

FORM 23-102 10-96

Lincoln-Lancaster County Health Department
Environmental Health Division
3140 "N" Street • Lincoln, NE 68510-1514
Phone: 402-441-8022

D OCT 1 2 2001

Permit Number:

Sewage Disposal System
As Built Plans & Specifications

Ernie Cjaka
148th + Holdrege
3/8 mile North west Side

Date 10/9/01

System Location (Indicate correct number and street)

Address _____ City _____ NE, Zip _____
(no rural route)

A. Building Sewer

Lagoon

1. Material: SDR 26
   Diameter: 4 in.
2. Distance above basement floor: _____ in.
   or distance below basement floor: _____ in.
3. Distance between dwelling and septic tank: _____ ft.
4. Number of clean-outs: _____
5. Distances to: well or suction line _____ ft.
   stream _____ ft.
   pressure line _____ ft.
   property line _____ ft.

B. Septic Tank

1. Material: _____
   Number of compartments: _____
2. Capacity: _____ gal.
3. Factory built: ☐ Yes ☐ No
4. Manholes: Over inlet, diameter _____ in.
   Over outlet, diameter _____ in.
   Riser: ☐ above ☐ below grade _____ in.
5. Inlet: ☐ baffle ☐ tee
6. Outlet: ☐ baffle ☐ tee
7. Depth to top of tank, below unfinished grade: _____ in.
8. Distances to: Well or suction line _____ ft.
   Stream _____ ft.
   Pressure line _____ ft.
   Property line _____ ft.

C. Distribution Box

1. Material: _____
   Number available outlets: _____
2. Factory built: ☐ Yes ☐ No
3. Distance from septic tank: _____ ft.

D. Absorption Field


(Provide as-built drawings on back of this form)

1. Type: ☐ Half rounds ☐ Perforated pipe
   Diameter of half round: _____
   or perforated pipe: _____
   Material: ☐ fiberglass ☐ plastic ☐ concrete
   ☐ other _____
2. Lateral lines: Number _____
   Length of each line: _____ ft. _____ ft.
   _____ ft. _____ ft., _____ ft.
3. Trench dimensions: Width _____ ft.
   Slope _____ in/100 ft.
   Average depth _____ in
4. Filter material: _____
   Depth of material _____ in.
5. Distances to: Well or suction line _____ ft.
   Stream _____ ft.
   Pressure line _____ ft.
   Property line _____ ft.

Indicate North with Arrow


Complete "As Built" drawing on back of this form.

Individual Sewage System Design (Example)

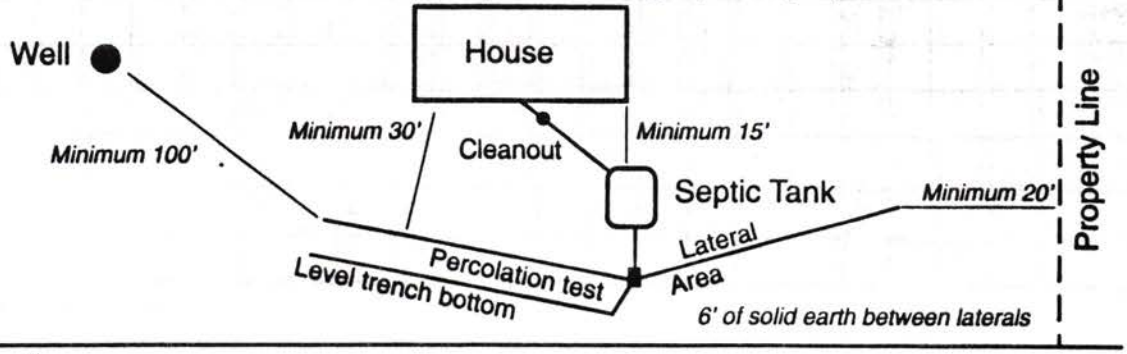

FORM 23-103 10-96

As Built Drawing

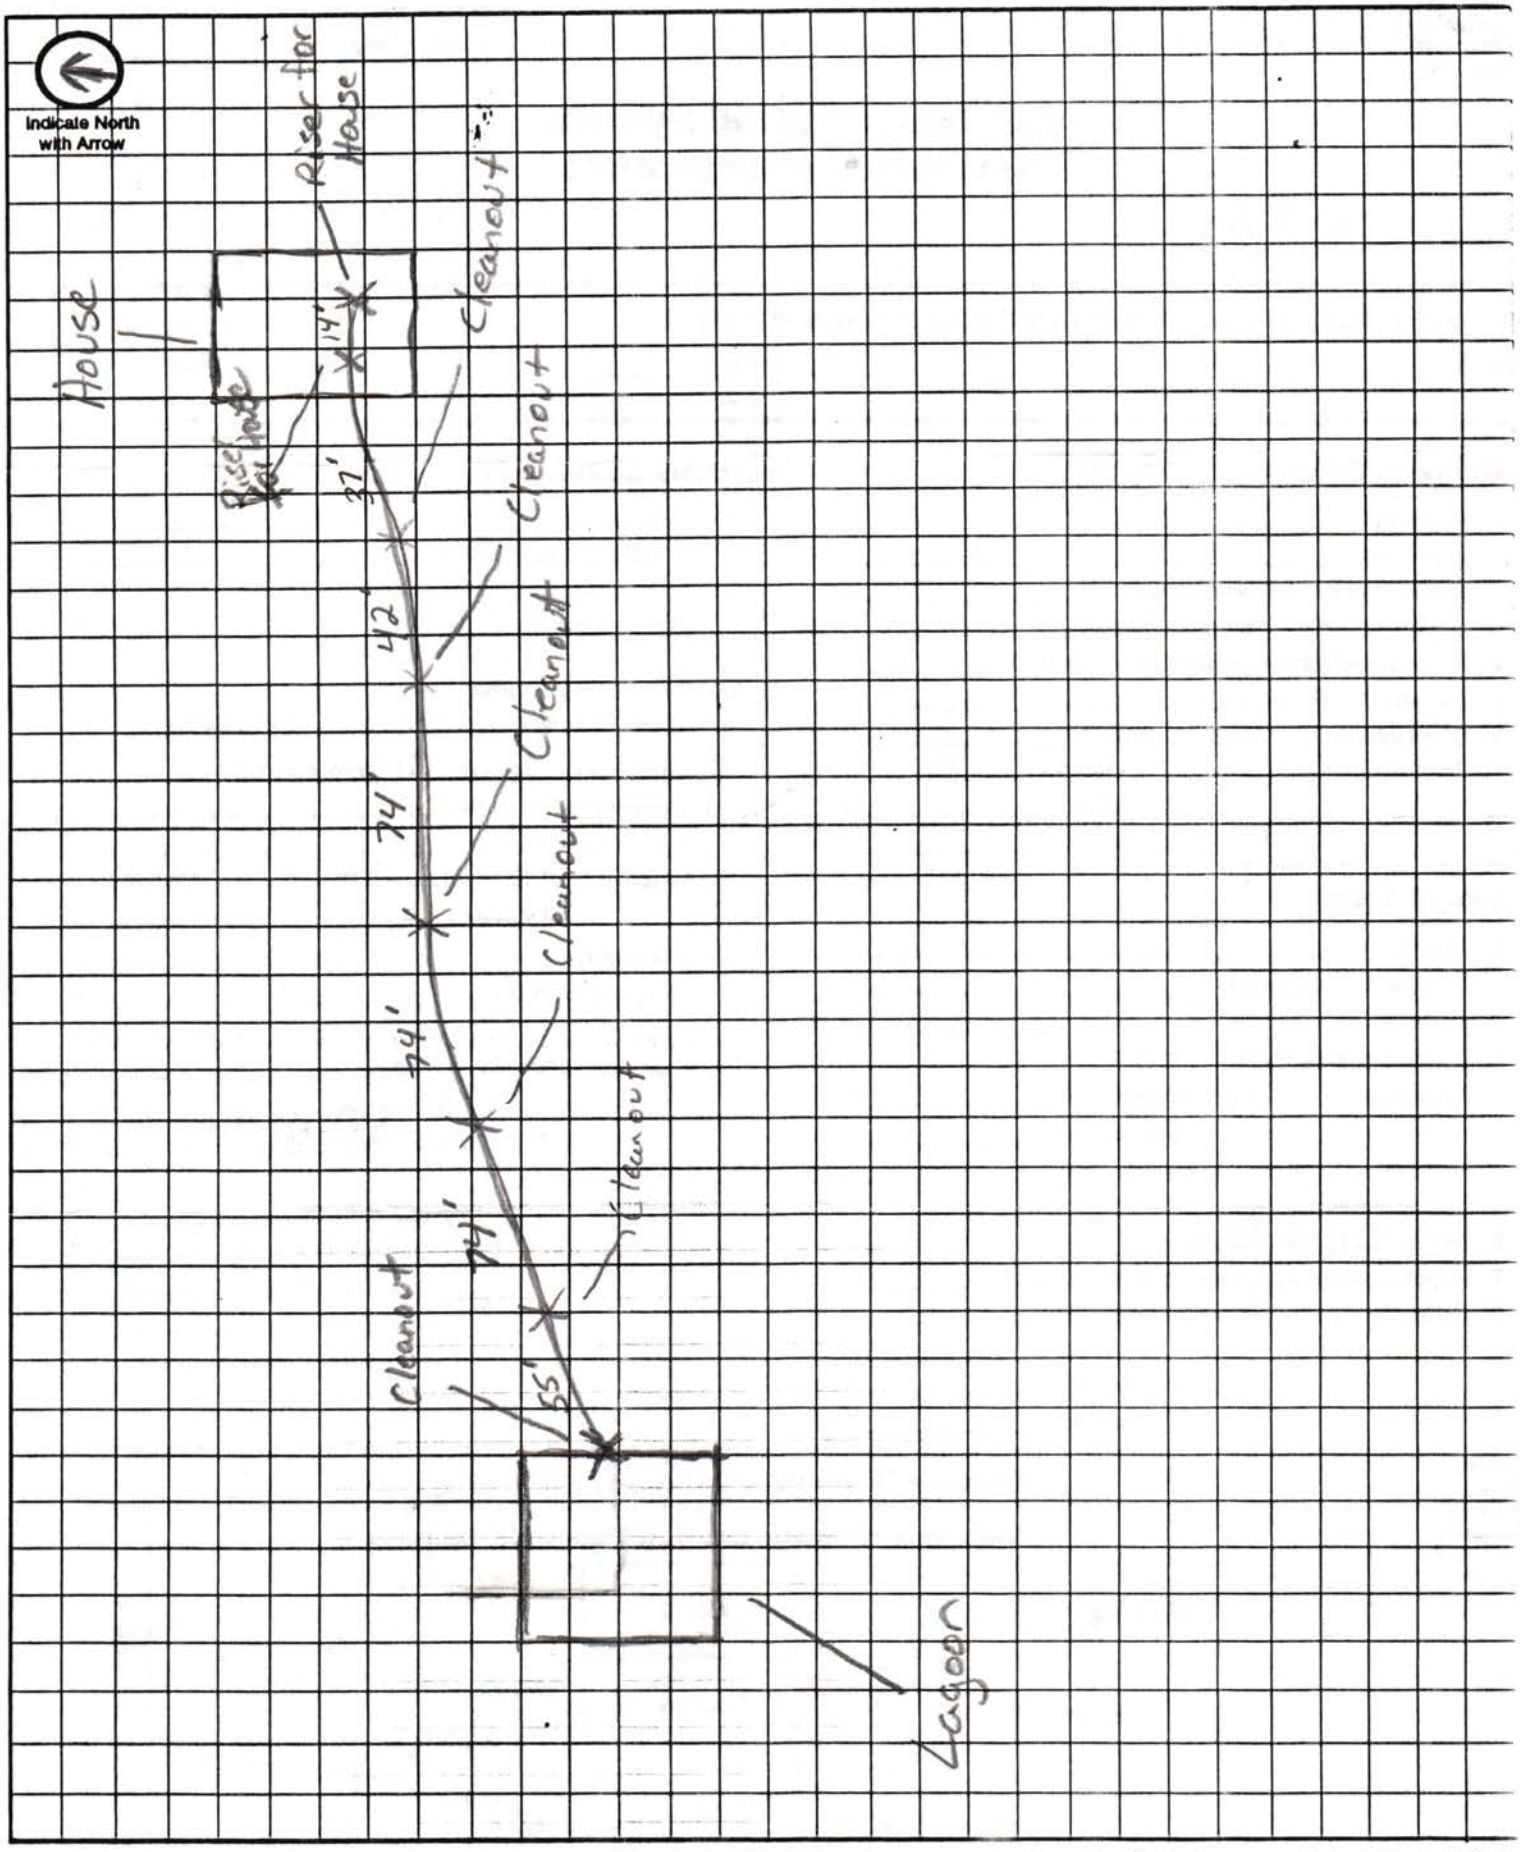

Approximate Scale: _____ ft. = _____ grid line/s