Lincoln-Lancaster County Health Department

ENVIRONMENTAL HEALTH DIVISION
3140 N STREET · LINCOLN, NE 68510-1514 (402) 441-8000

Permit

SEWAGE INSTALLATION
LAGOON

Establishment

DAVID L KUBERT
T11N R5E SEC 10 QTR SE
S 1/2 OF SE 1/4 LOT 3IT
8800 W WAVERLY RD-MALCOLM

Permittee

DAVID L KUBERT
BOX 65
MALCOLM NE 68402

Permit # 01380239701

Issued 10/23/01
Expires 04/23/02
Revenue Code 3157

FEES: $200.00

TOTAL: $200.00

Bruce D. Dart

Bruce D. Dart, Health Director

• POST IN A PROMINENT PLACE • NOT TRANSFERABLE

000250

Lincoln-Lancaster County Health Department
Environmental Health Division
3140 "N" Street • Lincoln, NE 68510-1514
Phone: 402-441-8022

A

Permit Number: 013802397

Sewage Disposal System

Request for Site Clearance and Permit

Include Form B, Form C and Applicable Fees with this Application.

☐ Septic System ☒ Lagoon ☐ Other (Refer to Form C)

The undersigned hereby requests site clearance and permit to construct a Sewage Disposal System in conformance with appropriate resolution or ordinance, as described herein:

PLEASE PRINT OR TYPE

A. System Location (Indicate correct number and street)

Address 8800 West Waverly Road (no rural route) City Malcolm NE, Zip 68402

Legal Description S 1/2 (1/4) SE (1/4) 10 (Section) 11N (Township) 5E (Range) 35 ACRES (Subdivision) (Addition) (Block) I.T. (Lot)

Geographical Location (if known): Longitude _____ Latitude _____

☒ Check if system mail address is not the same as the owner's address

B. Owner

Name David L./Kathryn M. Kubert Signature David L. Kubert

Address 222 East Street, BOX 65 City/State/Zip Malcolm, NE 68402

☐ Check if owner designed system Home Phone (402) 796-2231 Work Phone (402) 467-8144

C. Contractor

Name Lon Vanderkolk Company Name VANDERKOLK

Address 9800 West Bluff Rd City/State/Zip Malcolm Ne. 68402

☐ Check if contractor designed system Work Phone _____

D. Engineer/Installer ☐ Check and complete if engineer designed system

Designer Name _____ Firm _____ Work Phone _____

E. This System Will Serve a

☒ Residential Dwelling Number of Bedrooms 2 Is there a Whirlpool Bathtub (YES) NO

☐ Commercial Establishment/Other Facility Specify _____

Design flow in gallons per day_____ Type of Wastewater: ☐ Domestic ☐ Non-Domestic.

DO NOT WRITE BELOW THIS LINE

Approval Process ☐ Municipal Code 24.38 ☒ County Resolution No. 2832

1. **Health Department** Date rec'd 10/23/01 Date frwd 10/24/01 ACTION ☒ Approved ☐ Disapproved Signature Jerrold C. Hood
2. **Supt. Bldg. Insp. or Village Clerk** Date rec'd 10/24/01 Date frwd 10/24/01 ACTION ☒ Approved ☐ Disapproved Signature _____
3. **City or County Engineer** Date rec'd 10/24/01 Date frwd 10/24/01 ACTION ☒ Approved ☐ Disapproved Signature _____

Installation Final Written Approval

By Paul Dittman

Date 11-28-01

Business Office Use Only

Date Rec'd 10/23/01

Amt Paid 200.00

Rec'd By CW Cash/Check No. 3295

FORM 23-100 10-96 White - Health Dept. Yellow - Engineer Pink - Bldg. Inspector


Lincoln-Lancaster County Health Department
Environmental Health Division
3140 "N" Street • Lincoln, NE 68510-1514
Phone: 402-441-8022

C

Permit Number: 013802397

Sewage Disposal System
Preliminary Plan Specifications

Draw a plot plan showing system location, lines, distribution box, tank and laterals, percolation test hole locations, well, residence, compass direction and property lines. Indicate on drawing if residence and well are existing or proposed.

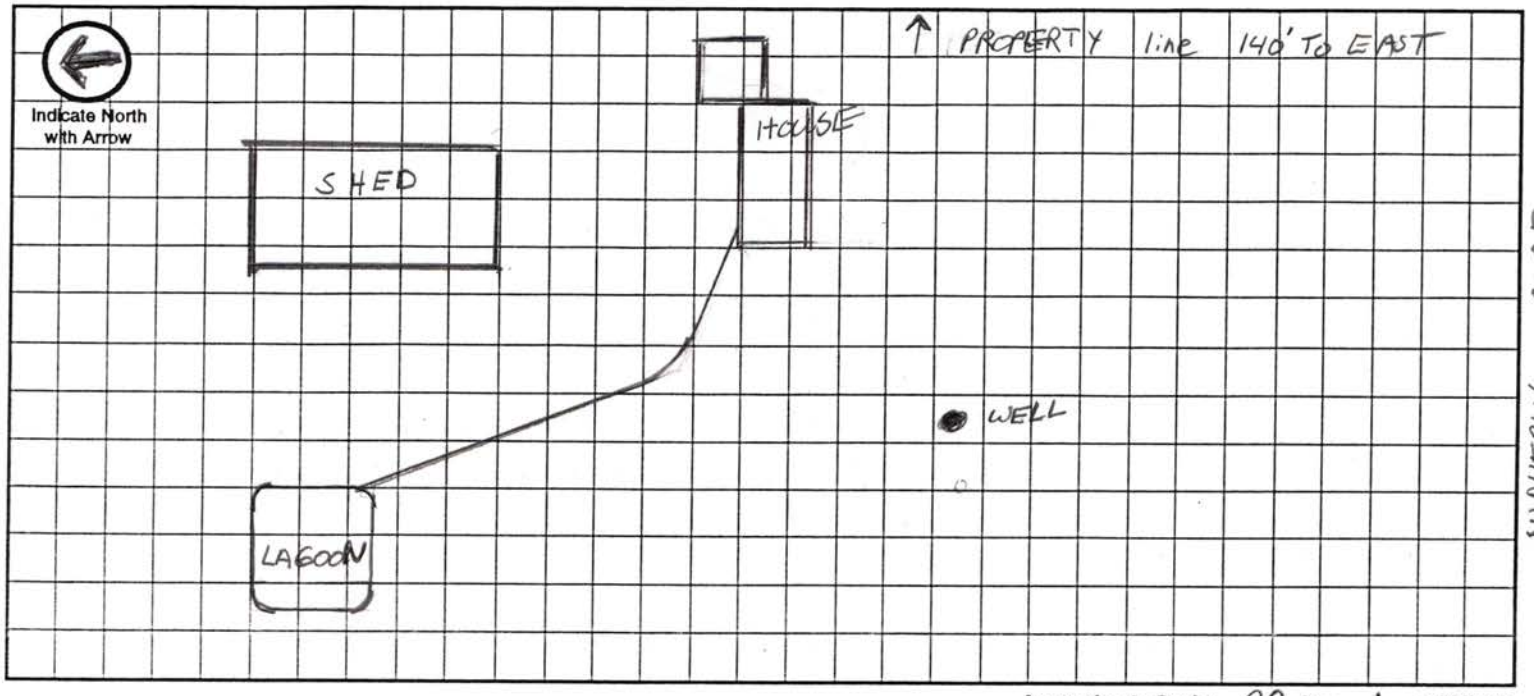

Approximate Scale: 20 ft. = 1 grid line/s

A. System Location (Indicate correct number and street)

Address (no rural route) 8800 West Waverly Road City Malcolm NE, Zip 68402

B. Proposed Septic Tank/s

Tank Material: ☐ Concrete ☐ Plastic ☐ Other _____

C. Proposed Absorption System (See Form B for Percolation Information)

Percolation Rate _____ (min. per inch) Soil Type: _____ Land Slope: _____ %

Type of Absorption System: ☐ Trench ☐ Bed ☐ Other _____

Total Square Feet of Field Required: _____ sq. ft.

Type of Lateral: ☐ Half-Moon ☐ Perforated Pipe ☐ Other Lateral Material: _____

Capacity of Septic Tank _____ gals Number of Absorption Beds: _____ Number of Distribution Laterals per Bed _____

Total Length of Laterals _____ ft. Number of Trenches _____ Trench Width _____

D. Setbacks Check the Boxes Below if the Required Setback has been Satisfied

Distance From	Private Well	Public Well	Surface Water	Gound Water	Pressure Water Lines	Property Lines	Foundations Yours	Foundations Neighbors	All Other Setbacks
Tank (ft)	50 ☐	500 ☐	50 ☐	NA ☐	25 ☐	20 ☐	15 ☐	25 ☐	☐
Field (ft)	100 ☐	500 ☐	50 ☐	4 ☐	30 ☐	20 ☐	30 ☐	40 ☐	☐
Lagoon (ft)	100 ☑	500 ☑	50 ☑	N/A ☐	30 ☑	50 ☑	100 ☑	200 ☑	☐

E. Required Signatures

Home Building Contractor Kim Kaufhold Date 10-22-01

Installer Ernest Well Drilling Date _____

FORM 23-102 10-96

Lincoln-Lancaster County Health Department
Environmental Health Division
3140 "N" Street • Lincoln, NE 68510-1514
Phone: 402-441-8022

D

Permit Number: 01380239701

Sewage Disposal System

As Built Plans & Specifications

Date 11-21-01

System Location (Indicate correct number and street)

Address 8800 WEST WAVERLY ROAD City MALCOLM NE, Zip 68402
(no rural route)

A. Building Sewer

1. Material: PLASTIC PIPE
   Diameter: 4" in.
2. Distance above basement floor: _____ in.
   or distance below basement floor: _____ in.
3. Distance between dwelling and septic tank: 180 ft.
4. Number of clean-outs: 4
5. Distances to: well or suction line 240 ft.
   stream _____ ft.
   pressure line _____ ft.
   property line _____ ft.

B. Septic Tank

1. Material: _____
   Number of compartments: _____
2. Capacity: _____ gal.
3. Factory built: ☐ Yes ☐ No
4. Manholes: Over inlet, diameter _____ in.
   Over outlet, diameter _____ in.
   Riser: ☐ above ☐ below grade _____ in.
5. Inlet: ☐ baffle ☐ tee
6. Outlet: ☐ baffle ☐ tee
7. Depth to top of tank, below unfinished grade: _____ in.
8. Distances to: Well or suction line _____ ft.
   Stream _____ ft.
   Pressure line _____ ft.
   Property line _____ ft.

C. Distribution Box

1. Material: _____
   Number available outlets: _____
2. Factory built: ☐ Yes ☐ No
3. Distance from septic tank: _____ ft.

D. Absorption Field


(Provide as-built drawings on back of this form)

1. Type: ☐ Half rounds ☐ Perforated pipe
   Diameter of half round: _____
   or perforated pipe: _____
   Material: ☐ fiberglass ☐ plastic ☐ concrete
   ☐ other _____
2. Lateral lines: Number _____
   Length of each line: _____ ft. _____ ft.
   _____ ft. _____ ft., _____ ft.
3. Trench dimensions: Width _____ ft.
   Slope _____ in/100 ft.
   Average depth _____ in
4. Filter material: _____
   Depth of material _____ in.
5. Distances to: Well or suction line _____ ft.
   Stream _____ ft.
   Pressure line _____ ft.
   Property line _____ ft.

Indicate North with Arrow


Complete "As Built" drawing on back of this form.

Individual Sewage System Design (Example)

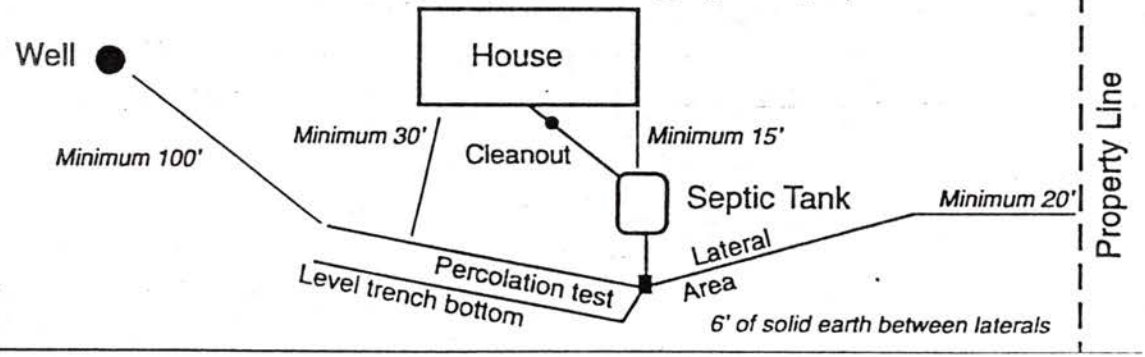

FORM 23-103 10-96

As Built Drawing

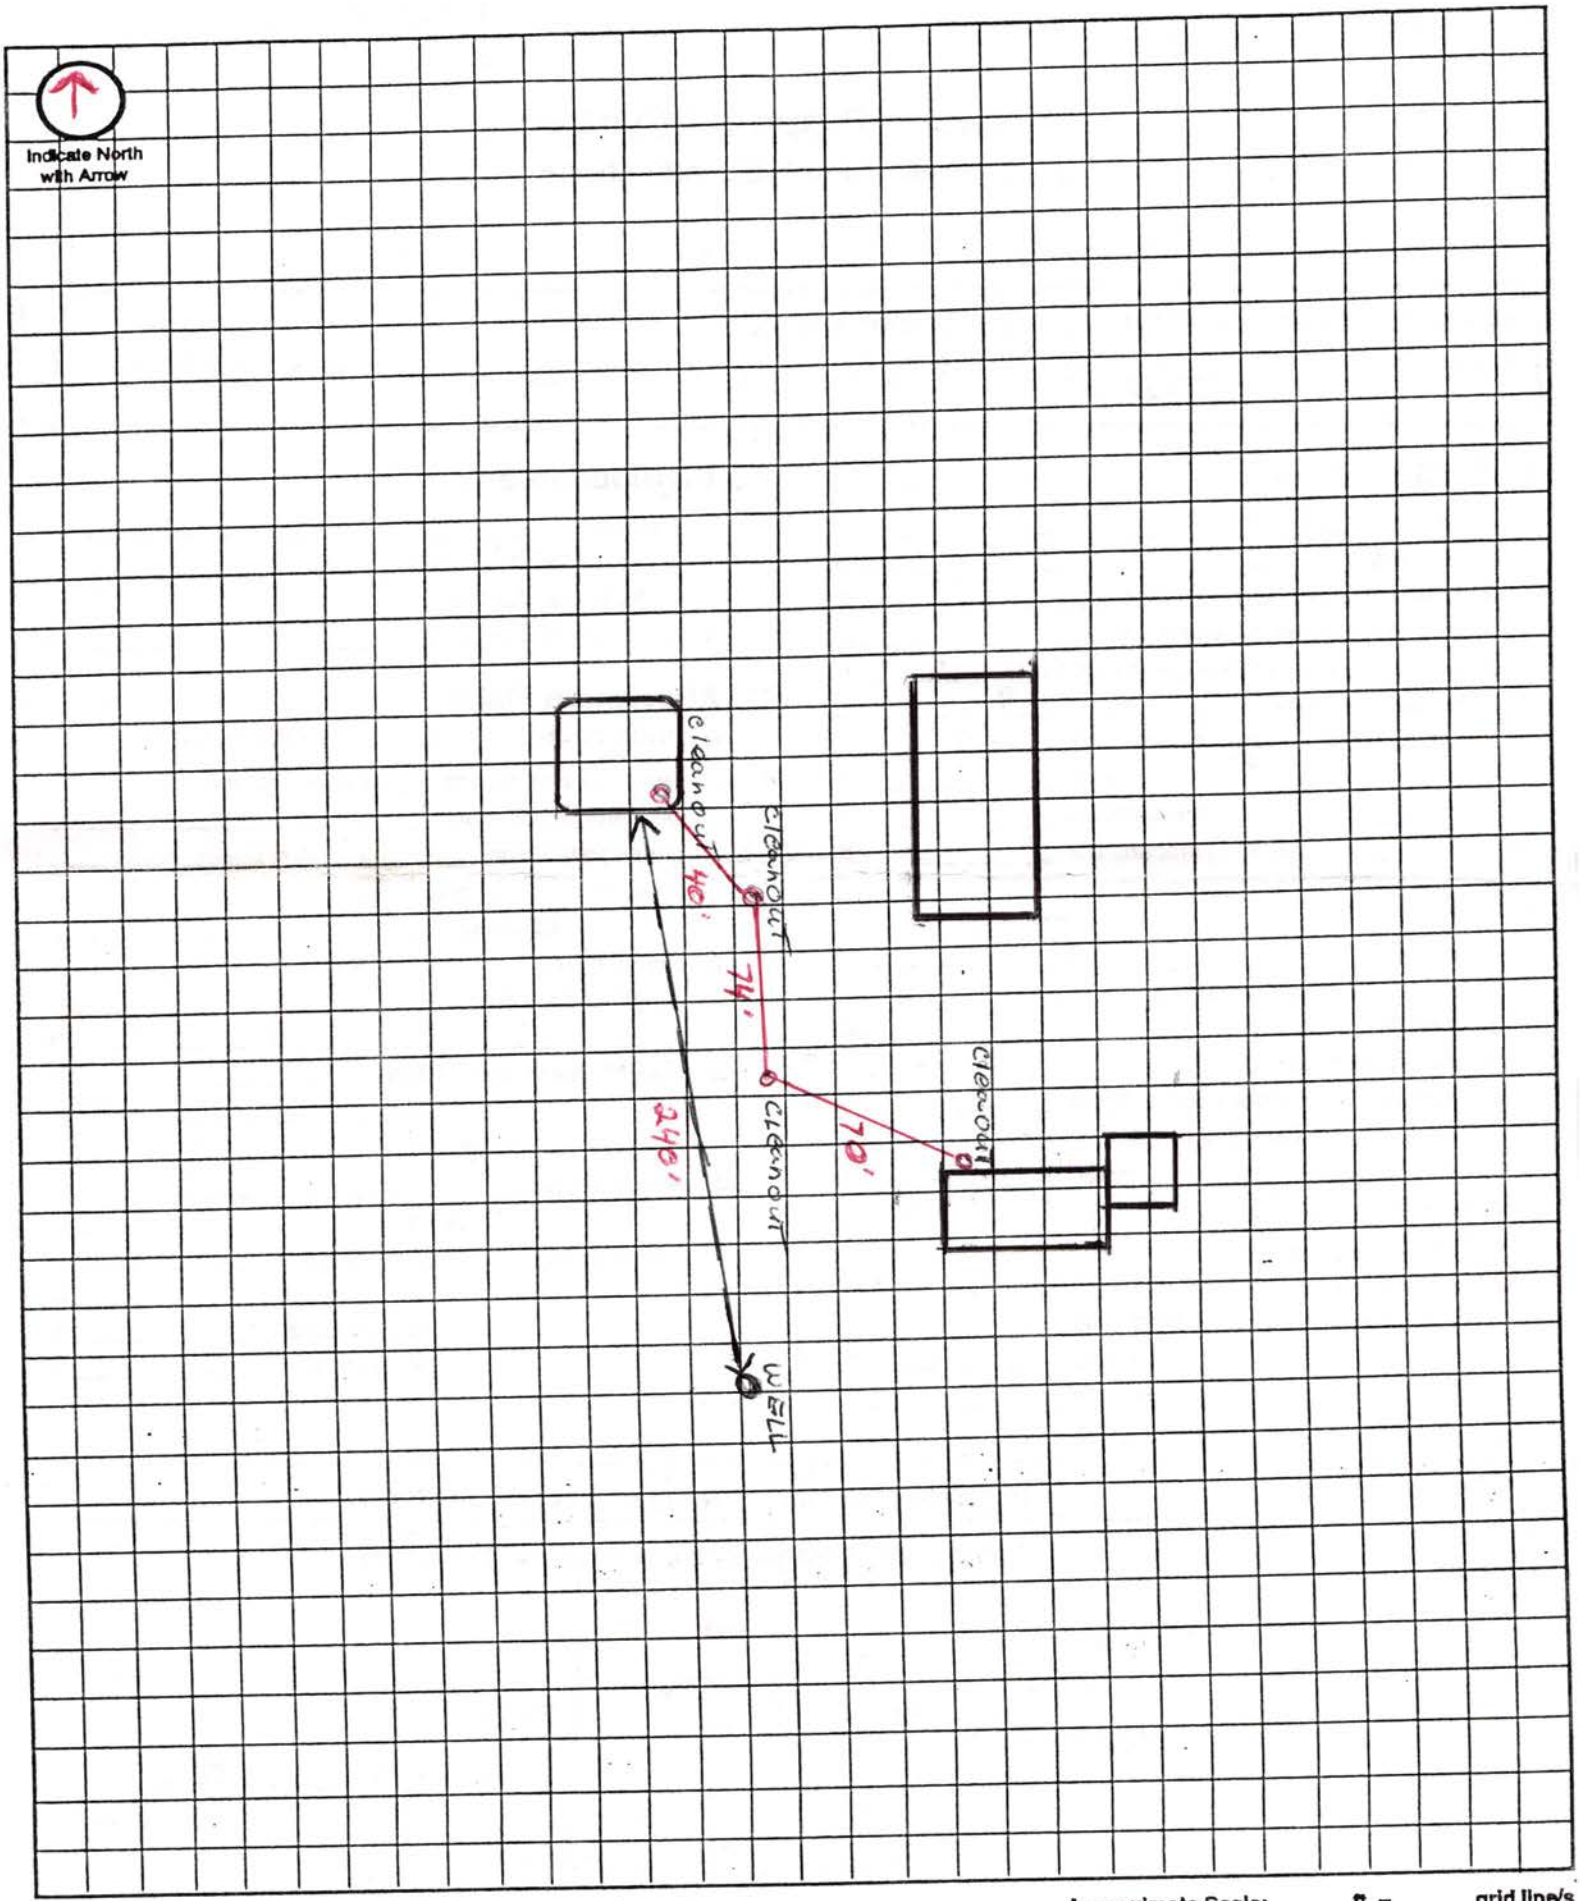

Approximate Scale: _____ ft. = _____ grid line/s

Lincoln-Lancaster County Health Department
Environmental Health Division
3140 "N" Street • Lincoln, NE 68510-1514
Phone: 402-441-8022

D OCT 2 9 2001

Permit Number: 013802397

Dave Kubert
NW 84th + West Waverly Rd 1/4 mile west

Sewage Disposal System
As Built Plans & Specifications

Date 10/24/01

System Location (Indicate correct number and street)
Address 8800 W. Waverly Rd (no rural route) City Malcolm NE, Zip 68402

A. Building Sewer

Lagoon

1. Material: 4" SDR 26
   Diameter: _____ in.
2. Distance above basement floor: _____ in.
   or distance below basement floor: _____ in.
3. Distance between dwelling and septic tank: _____ ft.
4. Number of clean-outs: _____
5. Distances to: well or suction line _____ ft.
   stream _____ ft.
   pressure line _____ ft.
   property line _____ ft.

B. Septic Tank

1. Material: _____
   Number of compartments: _____
2. Capacity: _____ gal.
3. Factory built: ☐ Yes ☐ No
4. Manholes: Over inlet, diameter _____ in.
   Over outlet, diameter _____ in.
   Riser: ☐ above ☐ below grade _____ in.
5. Inlet: ☐ baffle ☐ tee
6. Outlet: ☐ baffle ☐ tee
7. Depth to top of tank, below unfinished grade: _____ in.
8. Distances to: Well or suction line _____ ft.
   Stream _____ ft.
   Pressure line _____ ft.
   Property line _____ ft.

C. Distribution Box

1. Material: _____
   Number available outlets: _____
2. Factory built: ☐ Yes ☐ No
3. Distance from septic tank: _____ ft.

D. Absorption Field


(Provide as-built drawings on back of this form)

1. Type: ☐ Half rounds ☐ Perforated pipe
   Diameter of half round: _____
   or perforated pipe: _____
   Material: ☐ fiberglass ☐ plastic ☐ concrete
   ☐ other _____
2. Lateral lines: Number _____
   Length of each line: _____ ft. _____ ft.
   _____ ft. _____ ft., _____ ft.
3. Trench dimensions: Width _____ ft.
   Slope _____ in/100 ft.
   Average depth _____ in
4. Filter material: _____
   Depth of material _____ in.
5. Distances to: Well or suction line _____ ft.
   Stream _____ ft.
   Pressure line _____ ft.
   Property line _____ ft.

Indicate North with Arrow


Complete "As Built" drawing on back of this form.

Individual Sewage System Design (Example)

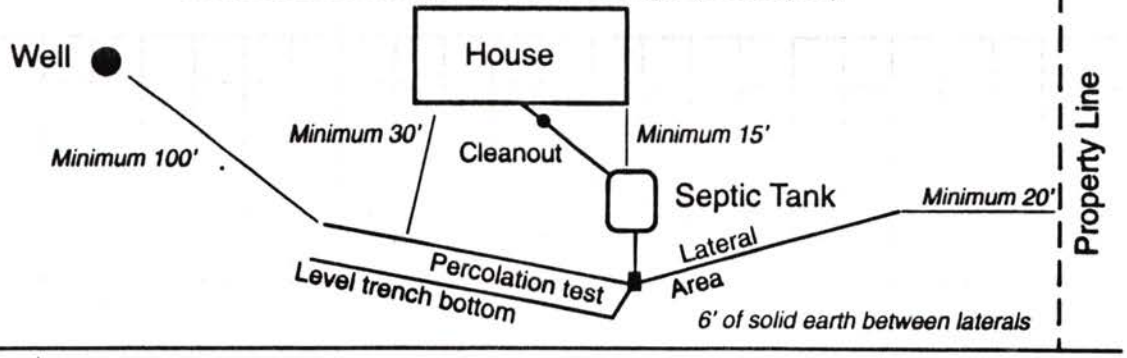

FORM 23-103 10-96

As Built Drawing

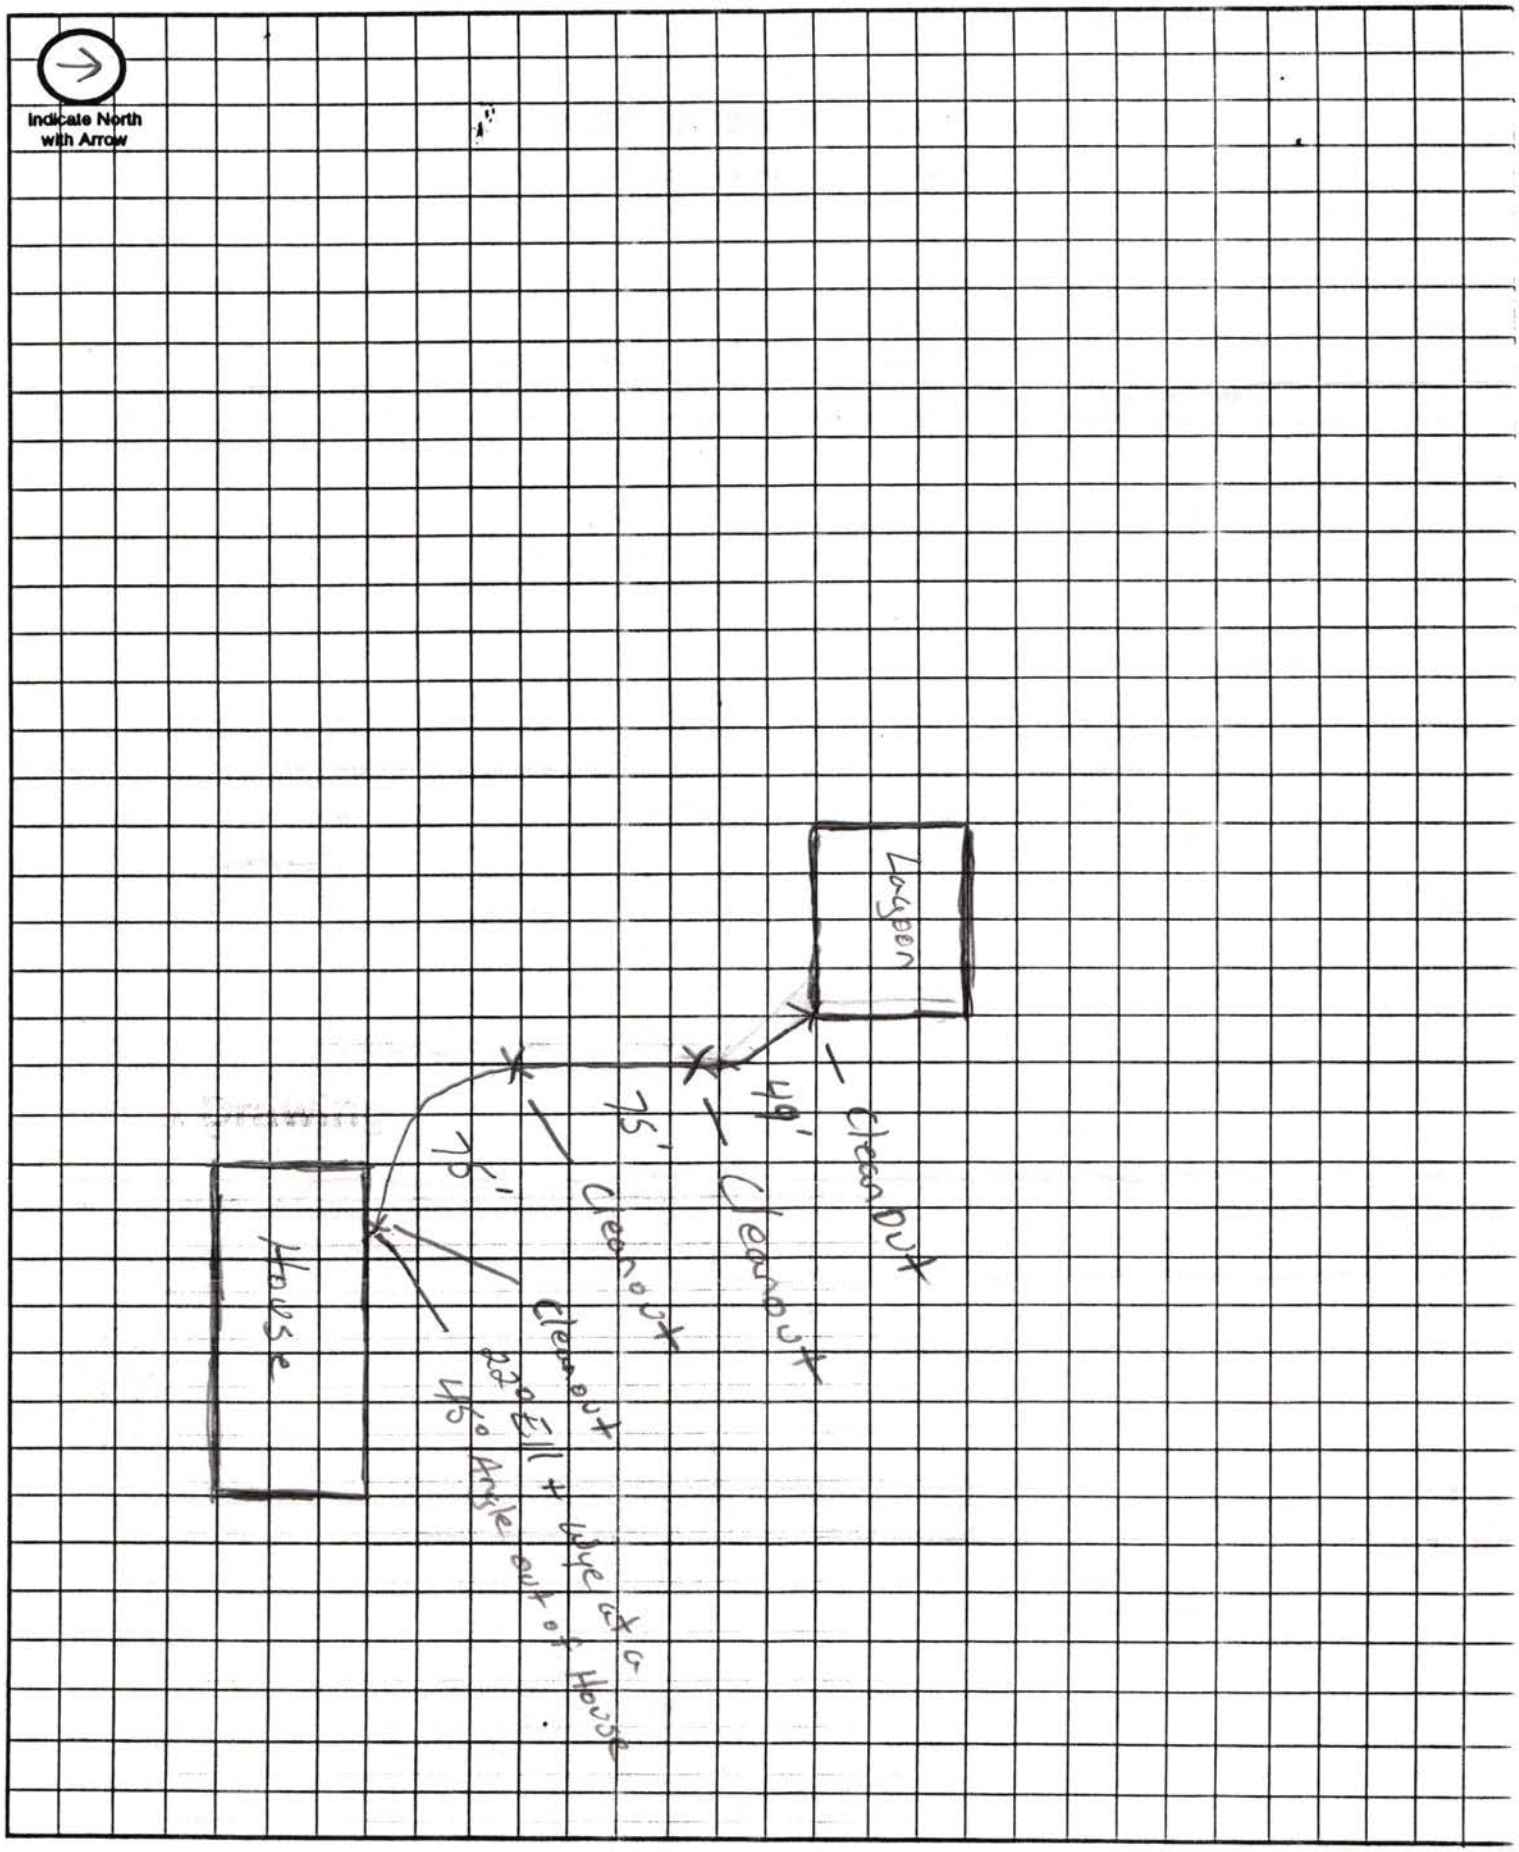

Approximate Scale: _____ ft. = _____ grid line/s