# LINCOLN-LANCASTER COUNTY HEALTH DEPARTMENT

ENVIRONMENTAL HEALTH DIVISION

3140 "N" STREET Lincoln, NE 68510-1514 (402) 441-8000

NON TRANSFERABLE

PERMIT

Permit
SEWAGE INSTALLATION

No. 94380122801

Issued 10/03/94
Expires 04/03/95
Revenue Code 18754

Establishment
GERALD FISHER
T10N R8E SEC 29
333 S 134 STREET

FEES: $150.00

TOTAL $150.00

Permittee
GERALD FISHER
3301 S 39 ST
LINCOLN NE 68506

Issued By M. Jane Ford
Health Director

**THIS LICENSE OR PERMIT IS ISSUED SUBJECT TO REVOCATION AS PROVIDED BY LAW "POST IN A PROMINENT PLACE"**

FORM 20103-0477
REQUEST FOR SITE CLEARANCE AND PERMIT
FOR INDIVIDUAL SEWAGE DISPOSAL SYSTEM
City Ordinance No. 9150 ☐
County Resolution No. 2832 ☐

LINCOLN-LANCASTER COUNTY HEALTH DEPARTMENT
Division of Environmental Health
2200 St. Marys Avenue
Lincoln, Nebraska 68502
Phone: 471-7800

A

FILING FEE: $_____

FILE NO. _____

DATE: _____

The undersigned hereby requests SITE CLEARANCE and PERMIT to construct an Individual Sewage Disposal System in conformance with appropriate resolution or ordinance, as described herein:

1. Legal description of property: Twp. 10N ; Range 8E ; Section 29 N¼;
   Block _____ : Lot _____ : Addition _____
   Street Address 333 So 134TH ST.

2. Property Use: Residential ☐ ; Commercial ☒ Other Use ☐
   No. of Bedrooms _____. Describe _____

3. Type of Individual Sewage Disposal System: Septic Tank ☒ ; Other ☐

4. Distance to public sewer: 15,000 ft.

Gerald L. Fisher
Signature of Applicant (Owner or Lessee)

3301 So. 39th Lincoln Ne 68506
Address Phone 474-6311 (Bob Lewis)

(Do not write below this double line)

1. Health Department: Date Rec'd. 10/3/94. Date Frwd. 10/3/94. ACTION: Approved ☒ Disapproved ☐ Signature: Jerrold C. Hood

2. Supt. Bldg. Insp.: or Village Clerk: Date Rec'd. 10/3/94. Date Frwd. 10/3/94. ACTION: Approved ☒ Disapproved ☐ Signature: Gary Spurr

3. City or County Engineer: Date Rec'd. 10-3-94. Date Frwd. 10-3-94. ACTION: Approved ☒ Disapproved ☐ Signature: Larry L. Worrell

REMARKS OR REASONS FOR DISAPPROVAL _____

3/24/95 by J.C.H.
3/28/95 by J.C.H.

Site Visits:
Date: _____ by: J.C.H. Sewer & tanks
Date: 11/28/94 by: J.C.H.
Date: 3/24/95 by: J.C.H. More Lateral

INSTALLATION FINAL WRITTEN APPROVAL
Date: 5/23/95 By: Jerrold C. Hood

White: Health Dept. Copy
Yellow: Engineers Copy
Pink: Bldg. Inspector's Copy

FORM 23-43

FORM 20104-0477
PLANS & SPECIFICATIONS FOR SEWAGE DISPOSAL SYSTEM (Annex to Application)
City Ordinance No. 9150 ☐
County Resolution No. 2832 ☐

LINCOLN-LANCASTER COUNTY HEALTH DEPARTMENT
Division of Environmental Health
2200 St. Marys Avenue
Lincoln, Nebraska 68502
Phone: 471-7800

D

DATE: _____

FILE NO. _____


SPECIFICATIONS AS BUILT

A. BUILDING SEWER:
1. Material _____; Diameter _____ in.
2. Distance above basement floor _____ in., or below basement floor _____ in.
3. Distance between dwelling and septic tank 80 ft.
4. Number of clean-outs 2.
5. Distances to:
Well or Suction Line 100+ ft.; Stream 100+ ft.; Pressure Line 100+ ft.; Property Line 100+ ft.


B. SEPTIC TANK:
1. Material Cement; No. of compartments 1.
2. Capacity 1850 gals.;
3. Factory Built: Yes ☒ No ☐
(Company PRE CAST)
4. Manholes: Over Inlet; diam. 6 in.
Over Outlet; diam. 6 in.
Riser Above ☒ Below ☒ Grade ___ in.
5. Inlet: Baffle ☒ ; or Tee ☐
6. Outlet: Baffle ☒ ; or Tee ☐
7. Depth of top of tank below finished grade 24 in.
8. Distances to:
Well or Suction Line 100+ ft.; Stream 100+ ft.; Pressure Line 100+ ft.; Property Line 100+ ft.


C. DISTRIBUTION BOX:
1. Material Cement; Number - available outlets 3+5.
2. Factory Built: Yes ☒ No ☐
(Company PRE CAST)
3. Distance from Septic Tank 56 6½ ft.

D. ABSORPTION FIELD: (Provide as built drawings on back of this form)
1. Type: Half Rounds ☒ Perforated Pipe ☐
Diameter of Half Round 20" or
Perforated Pipe _____.
Material: fiberglass ☐; plastic ☐; concrete ☒ ; other _____.
2. Lateral Lines:
Number 21; Length of each line _____, 44' to 52', _____, _____ ft.;
Total length of laterals 1052 ft.;
Distance between lateral lines 6 ft.
3. Trench dimensions: Width 4 ft.;
Slope 0-1 in/100 ft.; Average Depth 35 in.
4. Filter Material: Road Gravel
Depth of Material 22 in.
5. Distances to:
Well or Suction Line 100+ ft.; Stream 100+ ft.; Pressure Line 100+ ft.; Property Line 100+ ft.

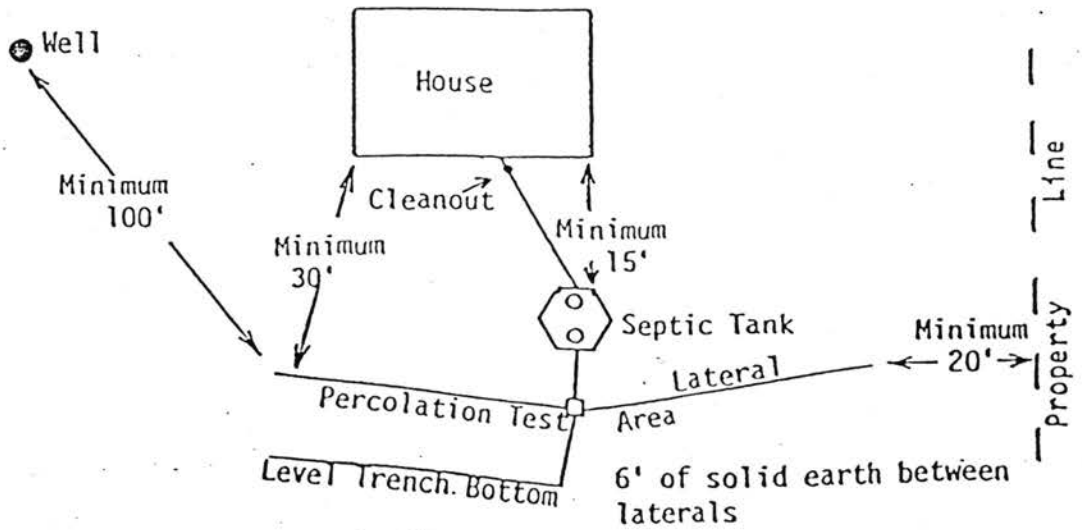


TYPICAL INDIVIDUAL SEWAGE SYSTEM DESIGN

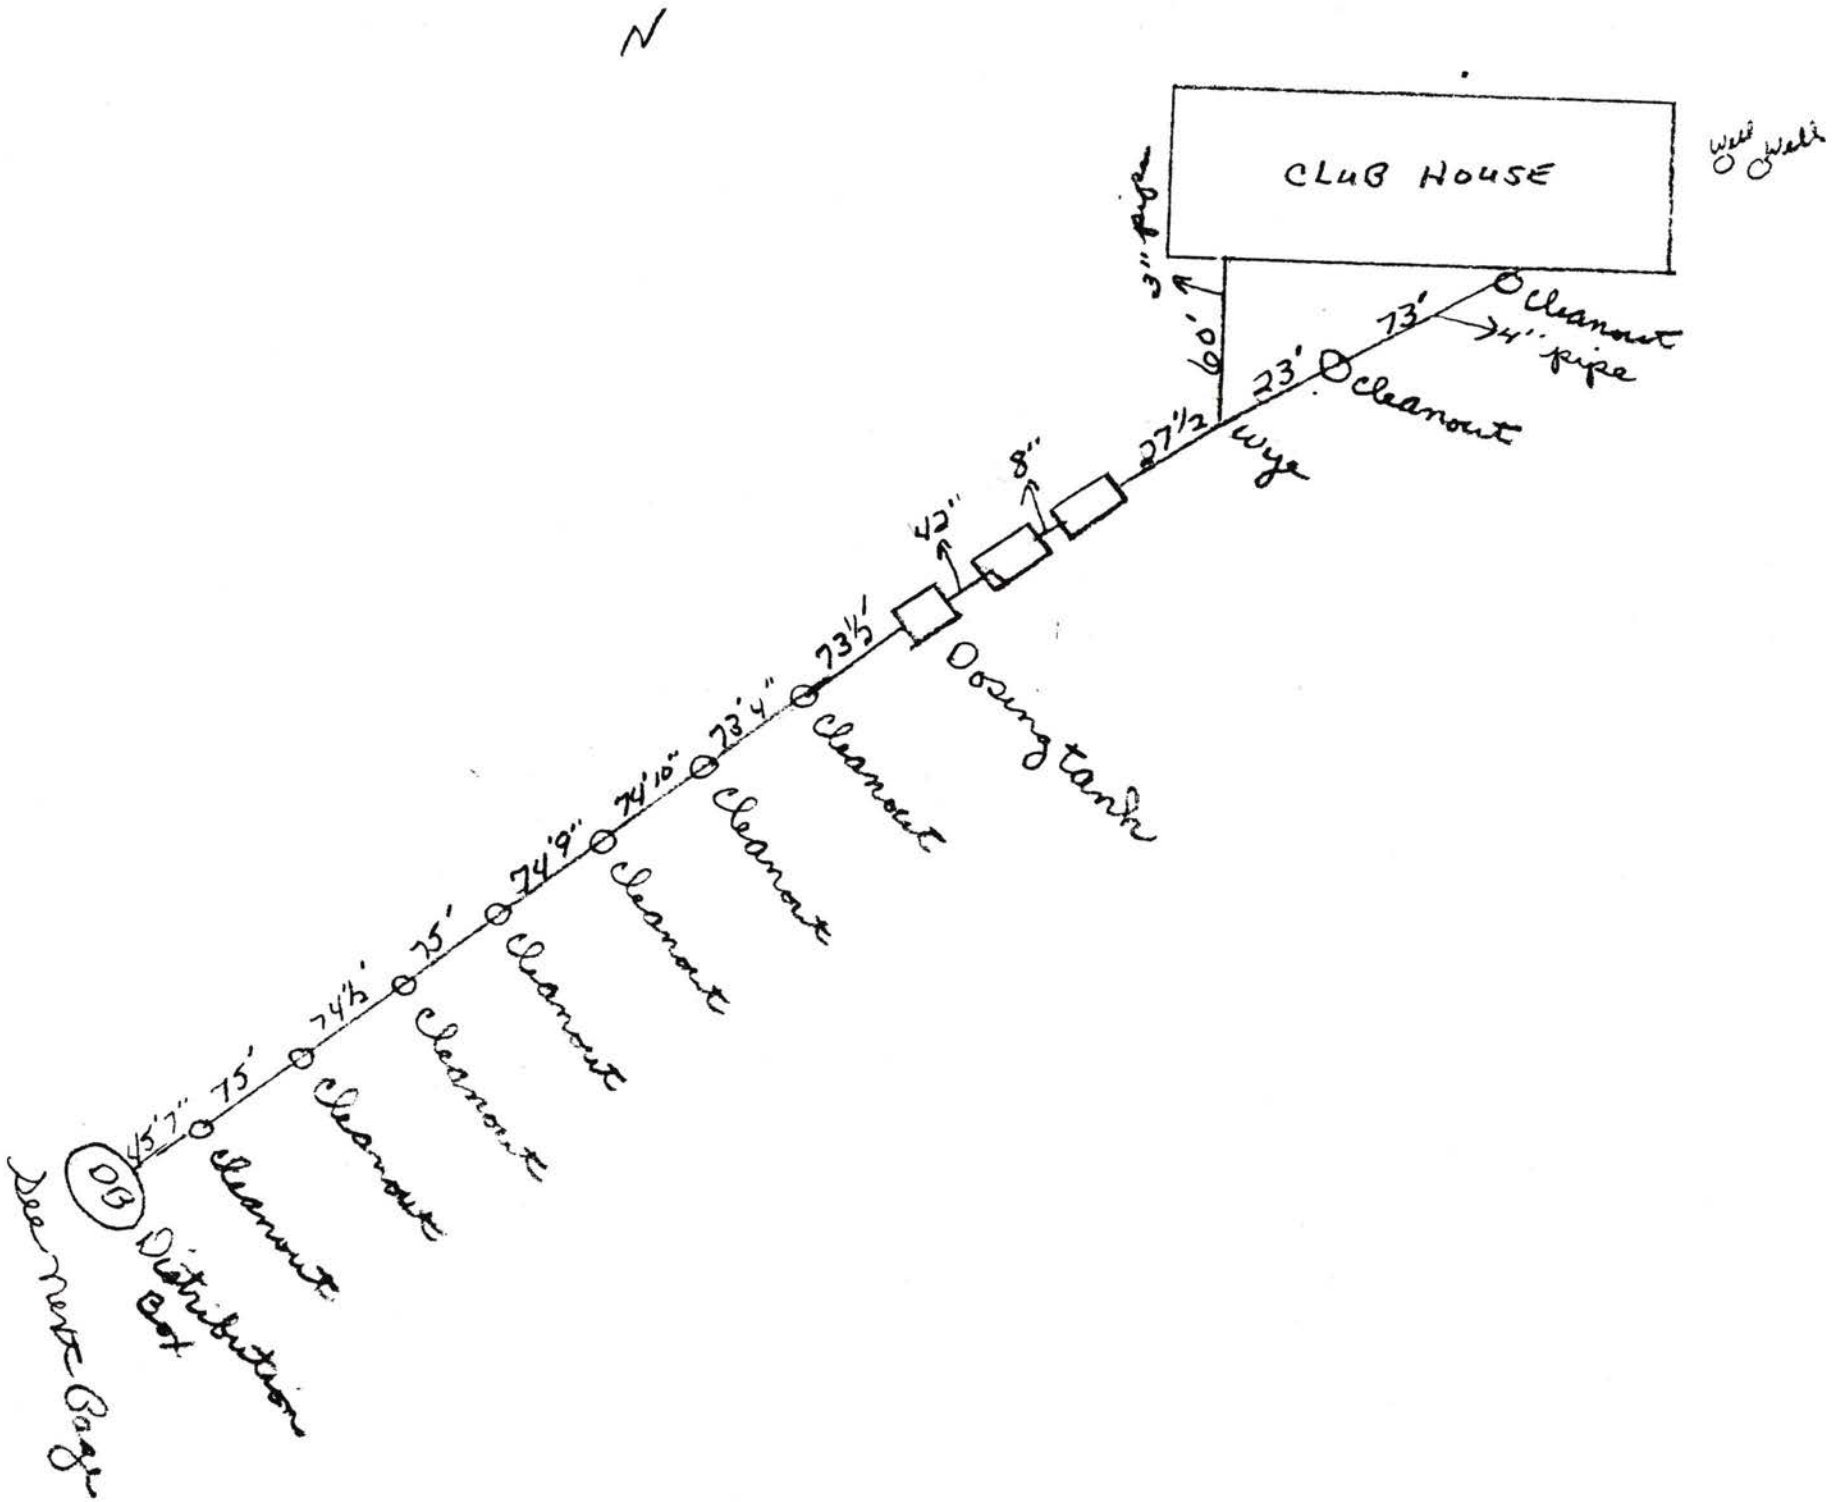
N
CLUB HOUSE
well
well
3" pipe
60'
73'
4" pipe
Cleanout
23'
Cleanout
27½
wye
8"
42"
73½'
Dosing tank
73'4"
Cleanout
74'10"
Cleanout
74'9"
Cleanout
75'
Cleanout
74½'
Cleanout
75'
Cleanout
45'7"
DB
Distribution Box
See next Page

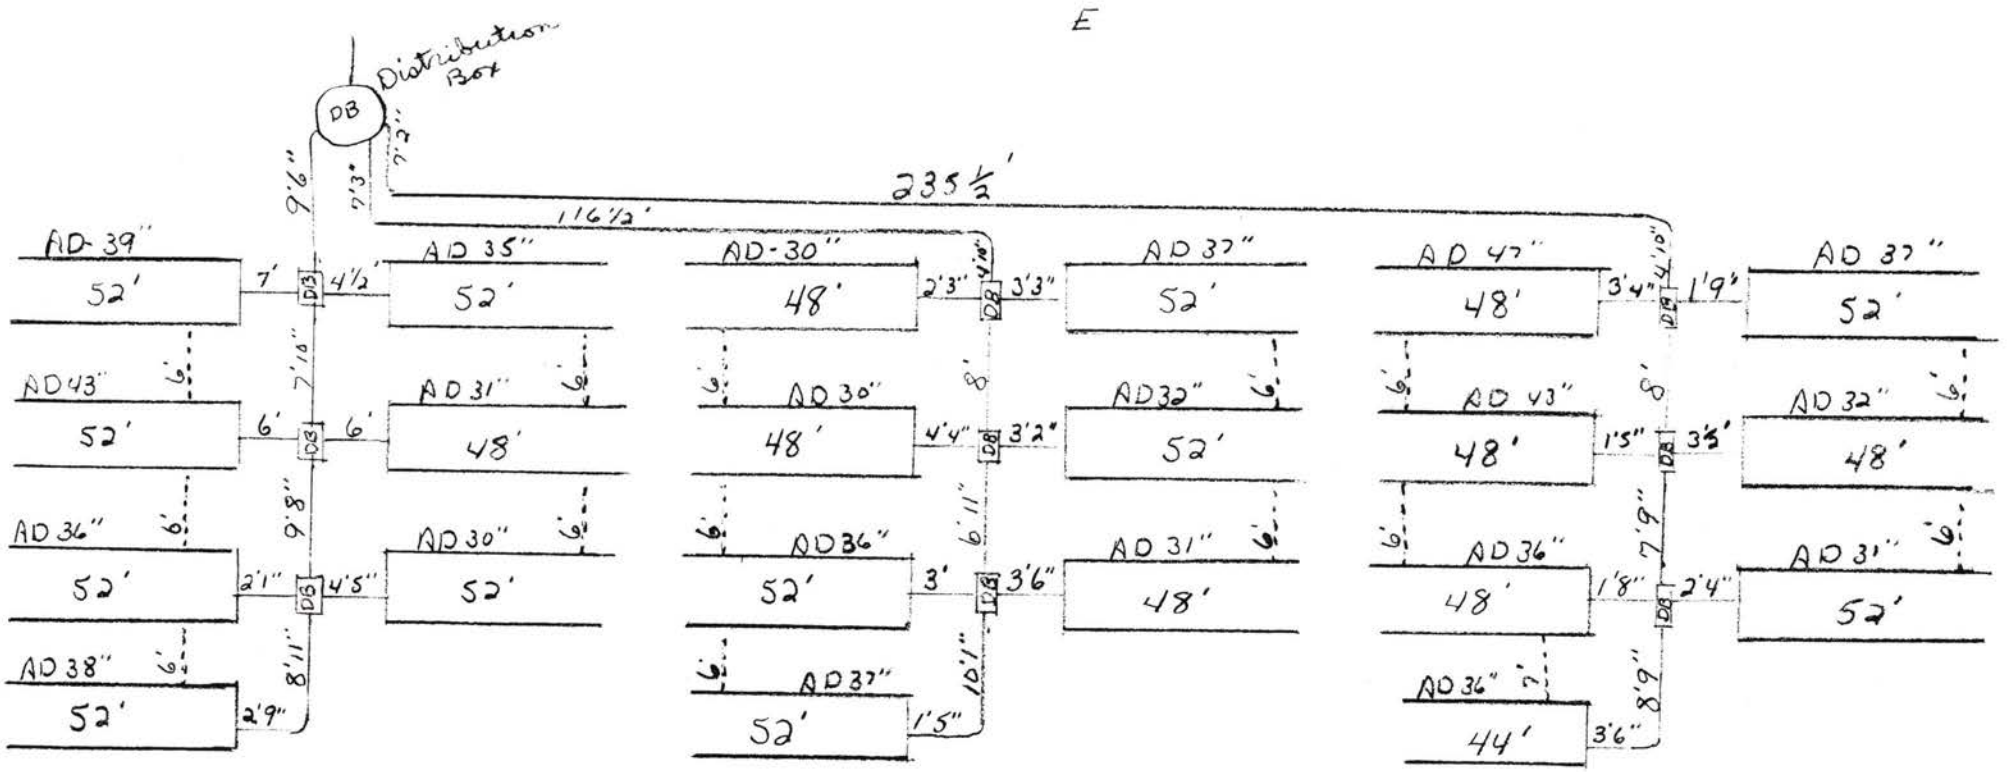


AD = avg Depth

DB= Distribution Box