LINCOLN-LANCASTER COUNTY HEALTH DEPARTMENT

3140 "N" STREET
NON TRANSFERABLE

ENVIRONMENTAL HEALTH DIVISION
Lincoln, NE 68510-1514

(402) 441-8000

PERMIT

Permit
SEWAGE INSTALLATION

No. 96380143901

Issued 06/24/96
Expires 12/24/96
Revenue Code 18754

Establishment
JEFF KRAMER
T11N R5E SEC 9
12600 NW 112 STREET

FEES: $150.00

TOTAL $150.00

Permittee
JEFF KRAMER
5211 NW 7 ST
LINCOLN NE 68521

Issued By M. Jane Ford
Health Director

THIS LICENSE OR PERMIT IS ISSUED SUBJECT TO REVOCATION AS PROVIDED BY LAW "POST IN A PROMINENT PLACE"

002156

FORM 20103-0477
REQUEST FOR SITE CLEARANCE AND PERMIT
FOR INDIVIDUAL SEWAGE DISPOSAL SYSTEM
City Ordinance No. 9150 ☑
County Resolution No. 2832 ☐

LINCOLN-LANCASTER COUNTY HEALTH DEPARTMENT
Division of Environmental Health
3140 N Street
Lincoln NE 68510
(402)-441-8022

A

FILING FEE: $ 150.00

FILE NO. _____

DATE: 6-4-96

The undersigned hereby requests SITE CLEARANCE and PERMIT to construct an Individual Sewage Disposal System in conformance with appropriate resolution or ordinance, as described herein:

1. Legal description of property: Twp. 11N ; Range 5E ; Section 9 NW¼SW¼;
   Block _____ : Lot _____ : Addition _____
   Street Address 12600 NW 112th ST.

2. Property Use: Residential ☒ ; Commercial ☐ Other Use ☐
   No. of Bedrooms 3 . Describe _____

3. Type of Individual Sewage Disposal System: Septic Tank ☒ ; Other ☐

4. Distance to public sewer: _____ ft.

Signature of Applicant (Owner or Lessee) Kramer Construction.

Address 520 NW 7th St.

(Do not write below this double line)

1. Health Department: Date Rec'd. 6/4/96. Date Frwd. 6/4/96. ACTION: Approved ☒ Disapproved ☐ Signature: Jerrold C. Hoe
2. Supt. Bldg. Insp.: or Village Clerk Date Rec'd. 6-21-96. Date Frwd. 6-21-96. ACTION: Approved ☒ Disapproved ☐ Signature:
3. City or County Engineer: Date Rec'd. 6-21-96. Date Frwd. 6-21-96. ACTION: Approved ☐ Disapproved ☐ Signature:

REMARKS OR REASONS FOR DISAPPROVAL _____

Site Visits:
Date: 9-5-96 by: um line & tank.
Date: 9-6-96 by: um reel drawing
Date: _____ by: _____

INSTALLATION FINAL WRITTEN APPROVAL
Date: 11-14-96 By:

White: Health Dept. Copy
Yellow: Engineers Copy
Pink: Bldg. Inspector's Copy

FORM 23-43

FORM 20105-0477
SOIL ABSORPTION TEST DATA REPORT
(Annex to Application)
(Reference: City Ordinance No. 9150 and County Resolution No. 2832)

LINCOLN-LANCASTER COUNTY HEALTH DEPARTMENT
Division of Environmental Health
~~2200 St. Marys Avenue~~ 3140 'N' St
Lincoln, Nebraska 68502
Phone: 471-7800 441-8333 FAX

B

FILE NO. _____

Kramer & Son's

PROPERTY WHERE SOIL TESTED: NW¼ SW¼ Sec 9 T11N R5E

Location: Township _____; Range _____; Section & ¼ Section _____.
Property Dimensions: 1286 ft. x 941 ft. Area: 28 acres. (Attach Sheet C with sketch of property).
Soil Type: Silty Clay ☐; Silty Clay Loam ☐; Sandy Loam ☐; Silt Loam ☐; Clay Loam ☒.
Dates of Tests: 5-21-96 to 5-22-96. Weather: Precip. _____ Temp. _____.

489-9209

OWNER: Craig & Shelley Everett
Address: 12600 NW 112th ST

PERCOLATION TEST DATA TABLE

a.	b.	c.	d.	e.	f.	g.	h.	i.	j.	k.	l.	m.	n.
		Pre-Saturation Period				Percolation Readings						Results	
		Start		End		Start			End				
Hold No.	Hole Depth (in.)	Date (Mo./Day)	Time (Hr./Min.)	Date (Mo./Day)	Time (Hr./Min.)	Date (Mo./Day)	Time (Hr./Min.)	Water Level (in.)	Time (Hr./Day)	Water Level (in.)	Elapsed Time (Min.)	Water Level Drop (in.)	Percolation Rates (Min./in)
1	36"	5-21	6:00P	5-22	5:00P	5-22	5:00P	6"	9:00P	5	30min	1	
2	36"	5-21	6:00P	5-22	6:00P	5-22	5:00P	6"	9:00P	5½	30min	1½	
3	36"	5-21	6:00P	5-22	5:00P	5-22	5:00P	6"	9:00P	5	30min	1	
4	36"	5-21	6:00P	5-22	5:00P	5-22	5:00P	6"	9:00P	5½	30min	1½	
5	36"	5-21	6:00P	5-22	5:00P	5-22	5:00P	6"	9:00P	5	30min	1	
6	36"	5-21	6:00P	5-22	5:00P	5-22	5:00P	6"	9:00P	5½	30min	1½	

Sum of Percolation Rates: _____
Average of Rates: _____
Mean of Rates: _____

Signature of Person Conducting Test

Address 2700 Dan Ave. Phone 1164-0638

(Do not write below this line)

REVIEWING ACTION

Approved Percolation Rate (a)
A. 60 min./inch
B. _____ min./inch
C. _____ min./inch

Remarks: There is a better Judson Soil in area
Soil Type (SCS): Sharpsburg Silty Clay Loam
Date: _____

FORM 20104-0477
PLANS & SPECIFICATIONS FOR SEWAGE DISPOSAL SYSTEM (Annex to Application)
City Ordinance No. 9150 ☐
County Resolution No. 2832 ☐

LINCOLN-LANCASTER COUNTY HEALTH DEPARTMENT
Division of Environmental Health
2200 St. Marys Avenue
Lincoln, Nebraska 68502
Phone: 471-7800

NOV 13 1996

D

DATE: 9-6-96

FILE NO. _____

12,600 S.W. 112th


SPECIFICATIONS AS BUILT

A. BUILDING SEWER:
1. Material PVC ; Diameter 4" in.
2. Distance above basement floor _____ in., or below basement floor 18 in.
3. Distance between dwelling and septic tank 200 ft.
4. Number of clean-outs 3.
5. Distances to: Well or Suction Line 40 + ft.; Stream 100 + ft.; Pressure Line 40 + ft.; Property Line 100 + ft.


B. SEPTIC TANK:
1. Material Concrete ; No. of compartments 1.
2. Capacity 1000 gals.;
3. Factory Built: Yes ☒ No ☐ (Company Precast)
4. Manholes: Over Inlet; diam. 12 in. Over Outlet; diam. 12 in. Riser Above ☒ Below ☐ Grade 2 in.
5. Inlet: Baffle ☒ ; or Tee ☐
6. Outlet: Baffle ☒ ; or Tee ☐
7. Depth of top of tank below finished grade 24 in.
8. Distances to: Well or Suction Line 100 + ft.; Stream 100 + ft.; Pressure Line 100 + ft.; Property Line 100 + ft.

C. DISTRIBUTION BOX:
1. Material Concrete ; Number available outlets 5.
2. Factory Built: Yes ☒ No ☐ (Company Precast)
3. Distance from Septic Tank _____ ft.

D. ABSORPTION FIELD: (Provide as built drawings on back of this form)
1. Type: Half Rounds ☒ Perforated Pipe ☐ Diameter of Half Round 12" or Perforated Pipe _____. Material: fiberglass ☐ ; plastic ☒ ; concrete ☐ ; other _____.
2. Lateral Lines: Number 3 ; Length of each line 85, 85, 79, _____, _____ ft.; Total length of laterals 249 ft.; Distance between lateral lines 21 ft.
3. Trench dimensions: Width 4 ft.; Slope 4 in/100 ft.; Average Depth 30 in.
4. Filter Material: gravel Depth of Material 16 in.
5. Distances to: Well or Suction Line 100 + ft.; Stream 100 + ft.; Pressure Line 100 + ft.; Property Line 100 + ft.

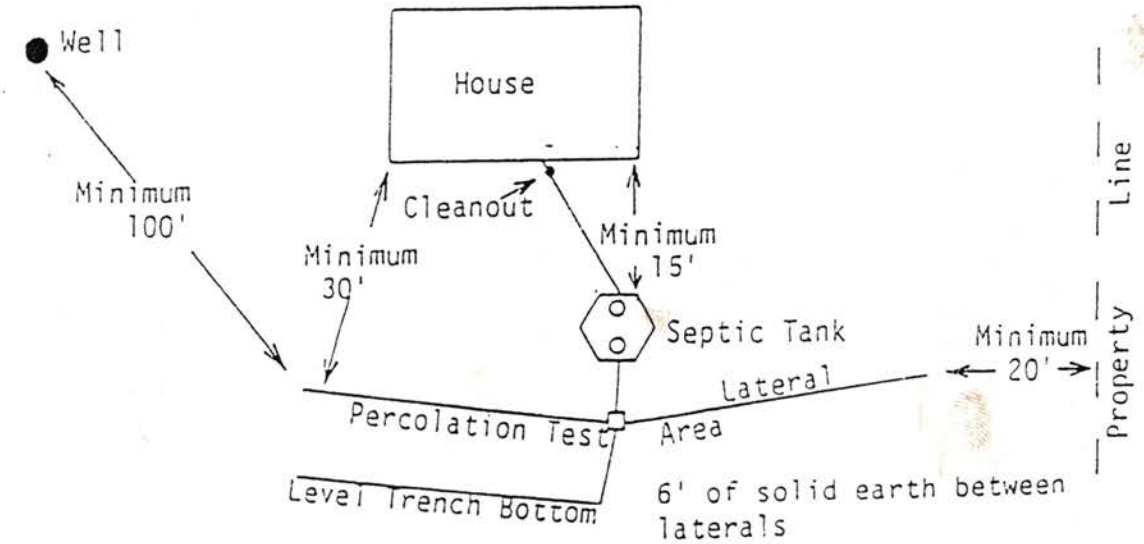

TYPICAL INDIVIDUAL SEWAGE SYSTEM DESIGN

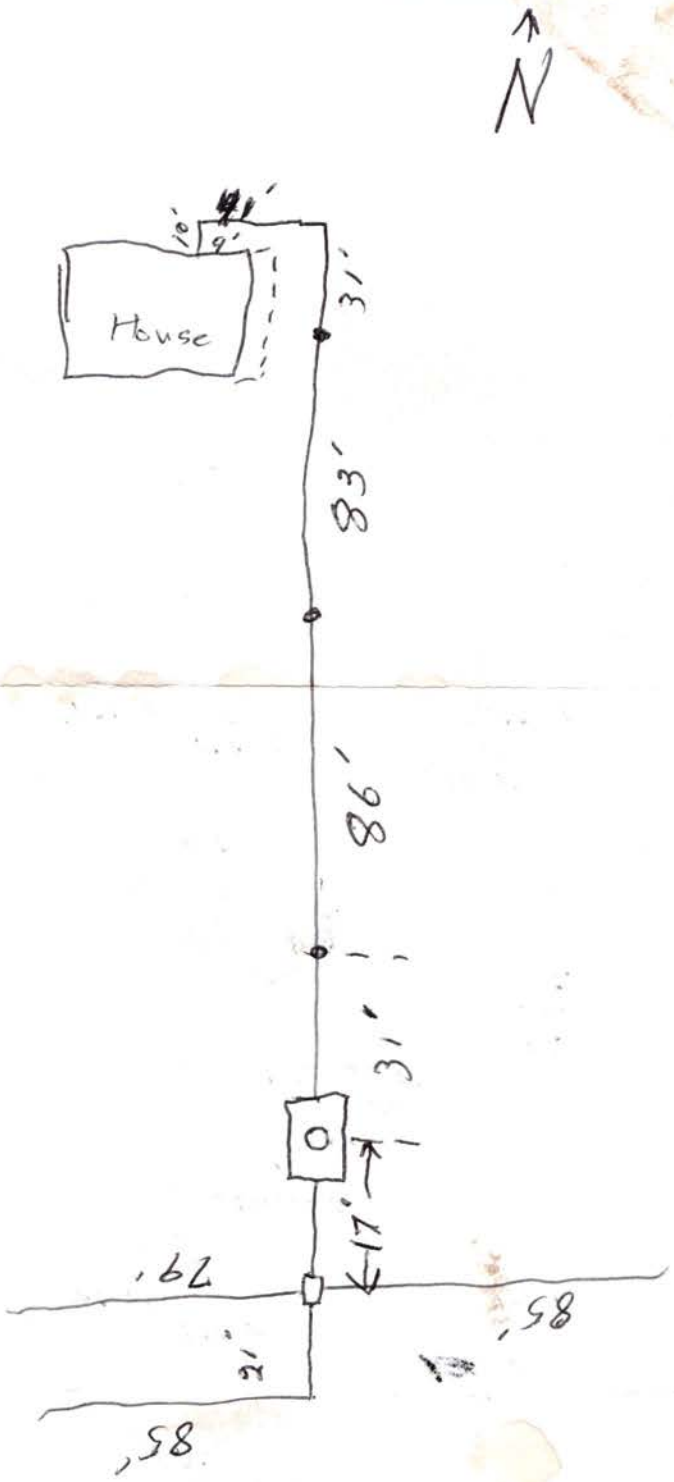
N
House
31'
83'
86'
3'
17'
79'
85'
2'
85'

SHELLY AND CRAIG EVERETT PROPERTY

N

1" = 200'


2/67


28 Acres

NW1/4 SW1/4 SEC 9 T11N R5E

OPTION I - FINALIZED

12605 NW 112th St

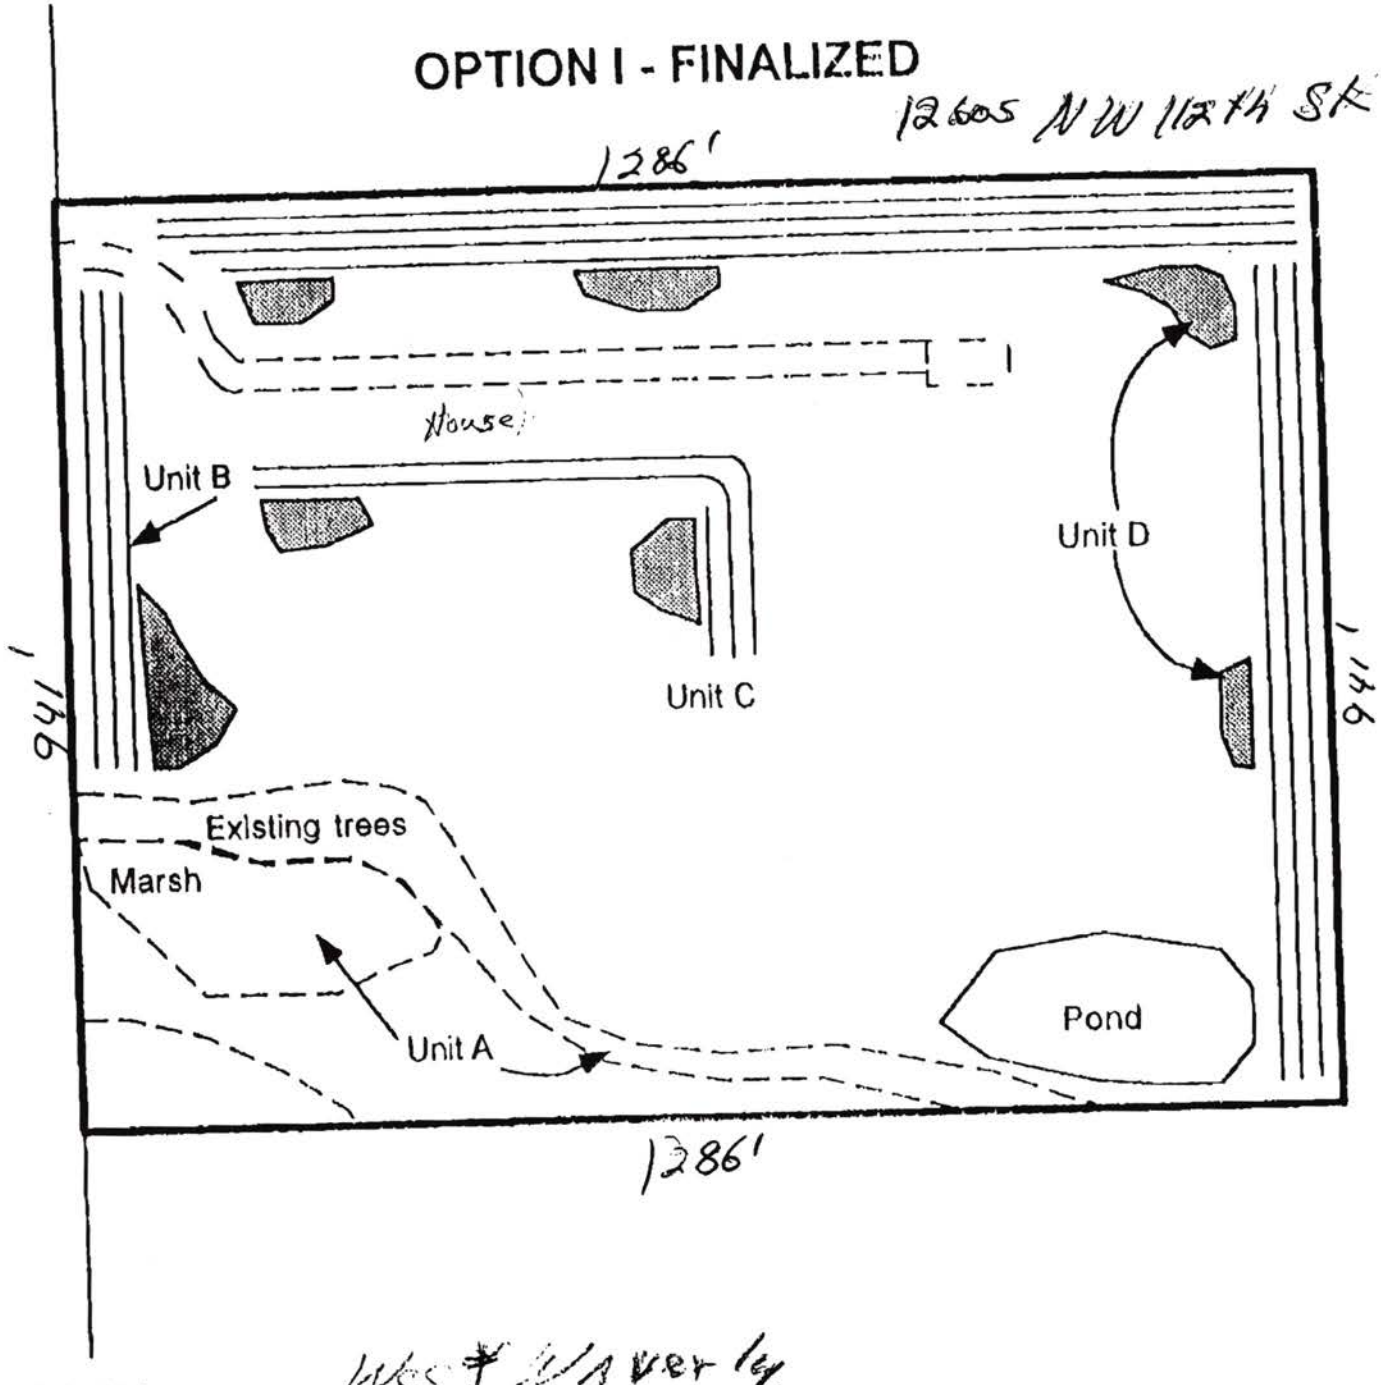

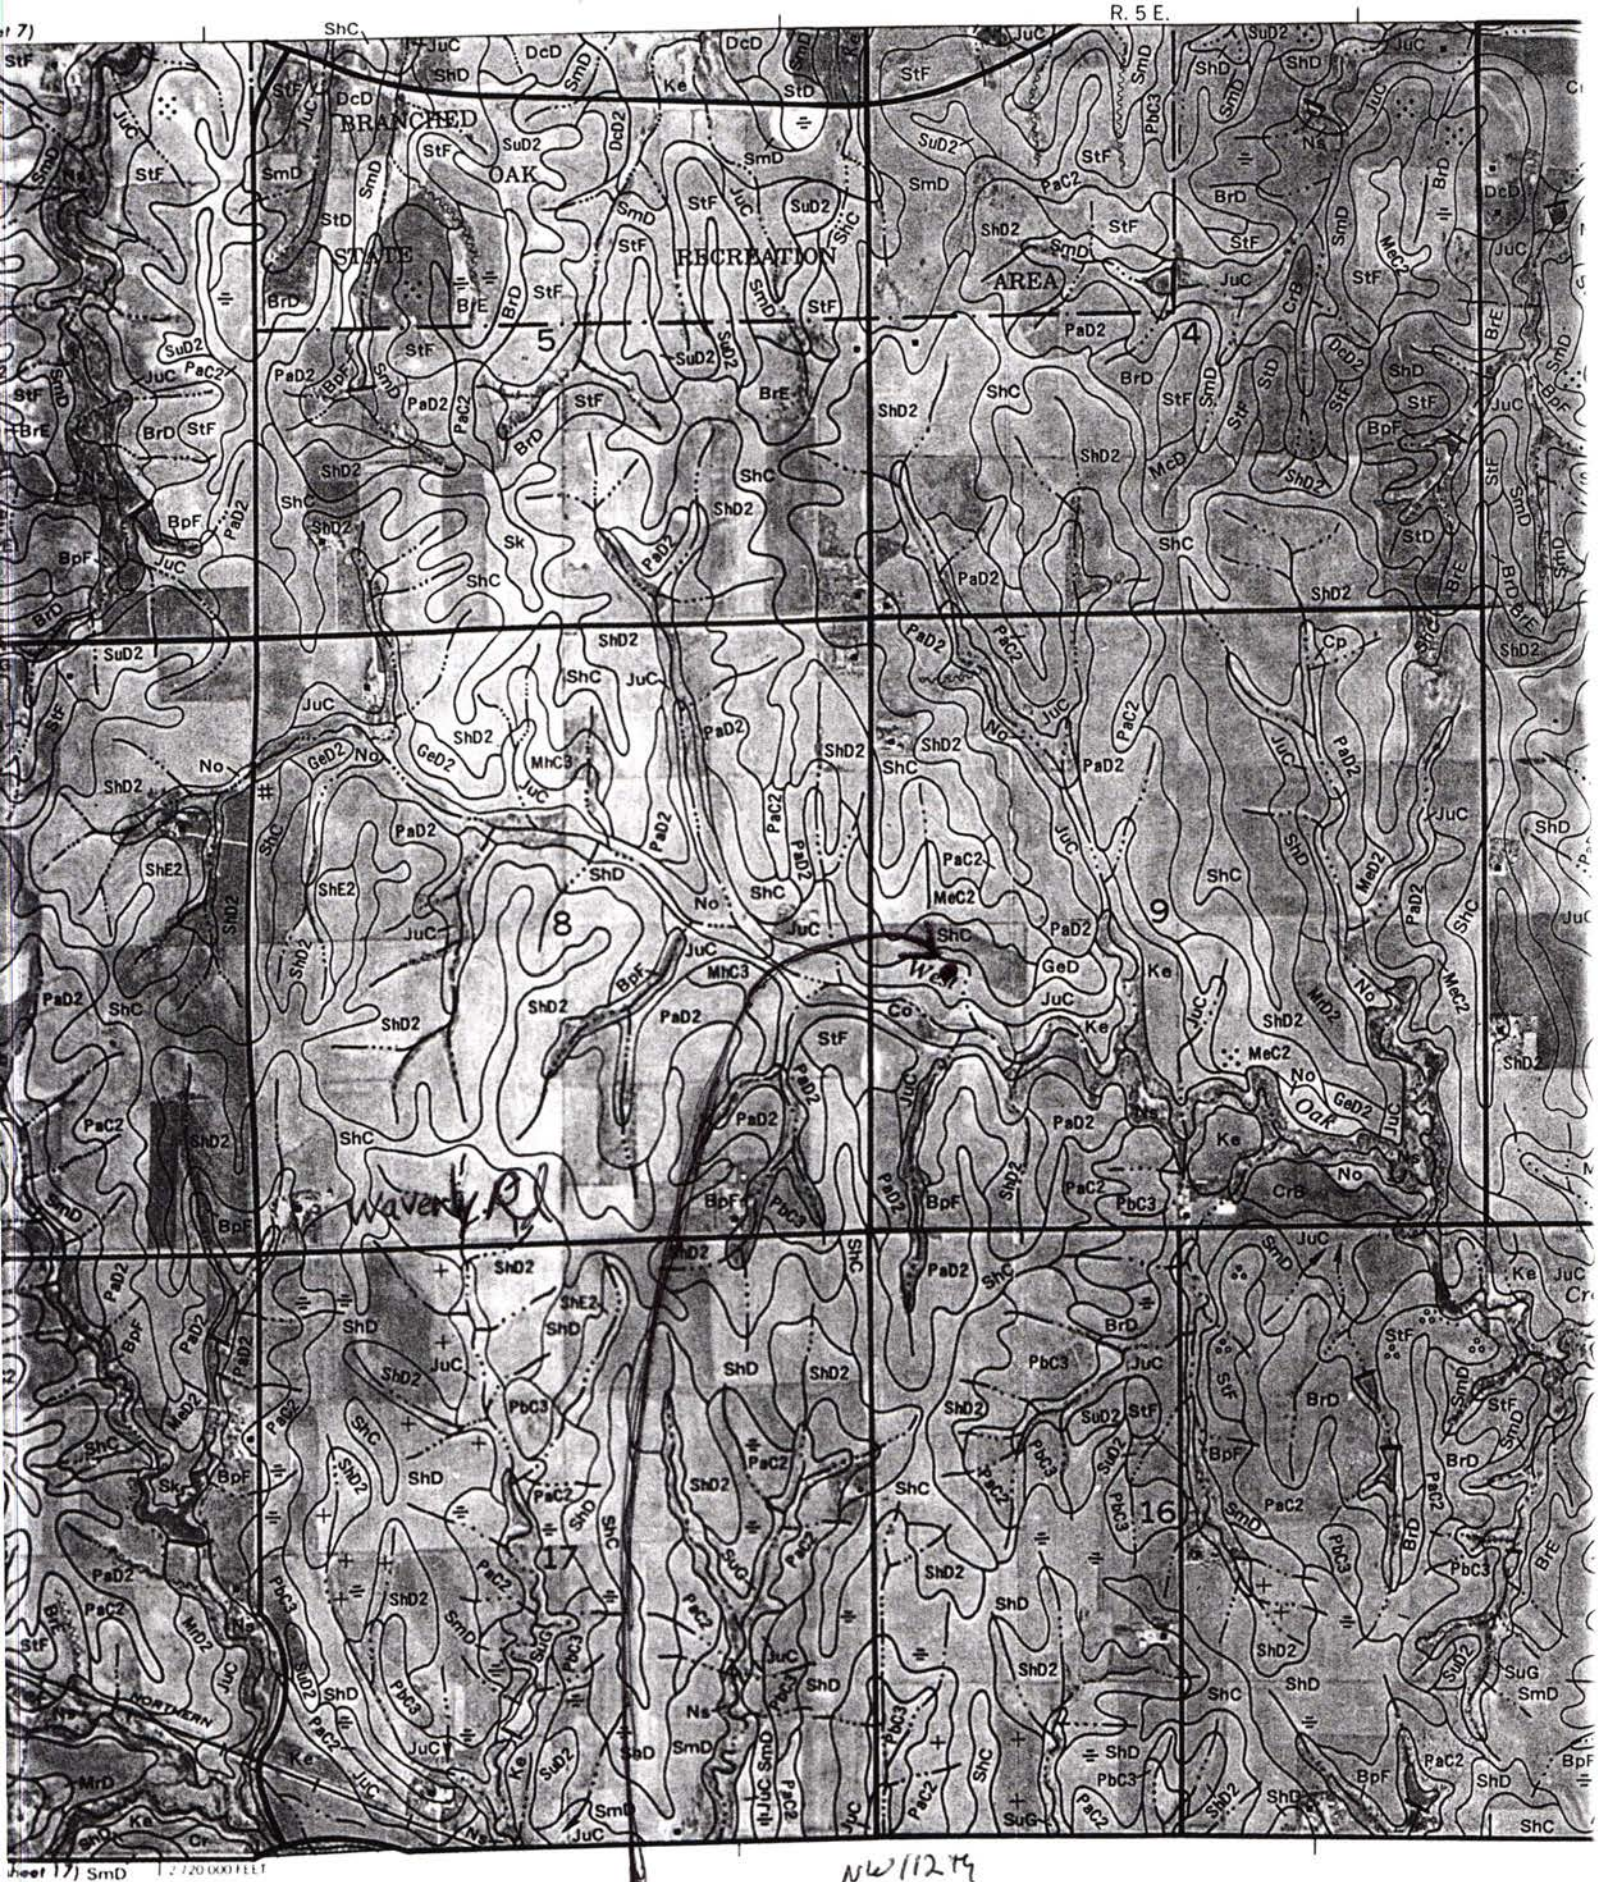
R. 5 E.
BRANCHED OAK STATE RECREATION AREA
Waverly Rd
Oak
NORTHERN
5
4
8
9
17
16
NW1/12TH
New septic